



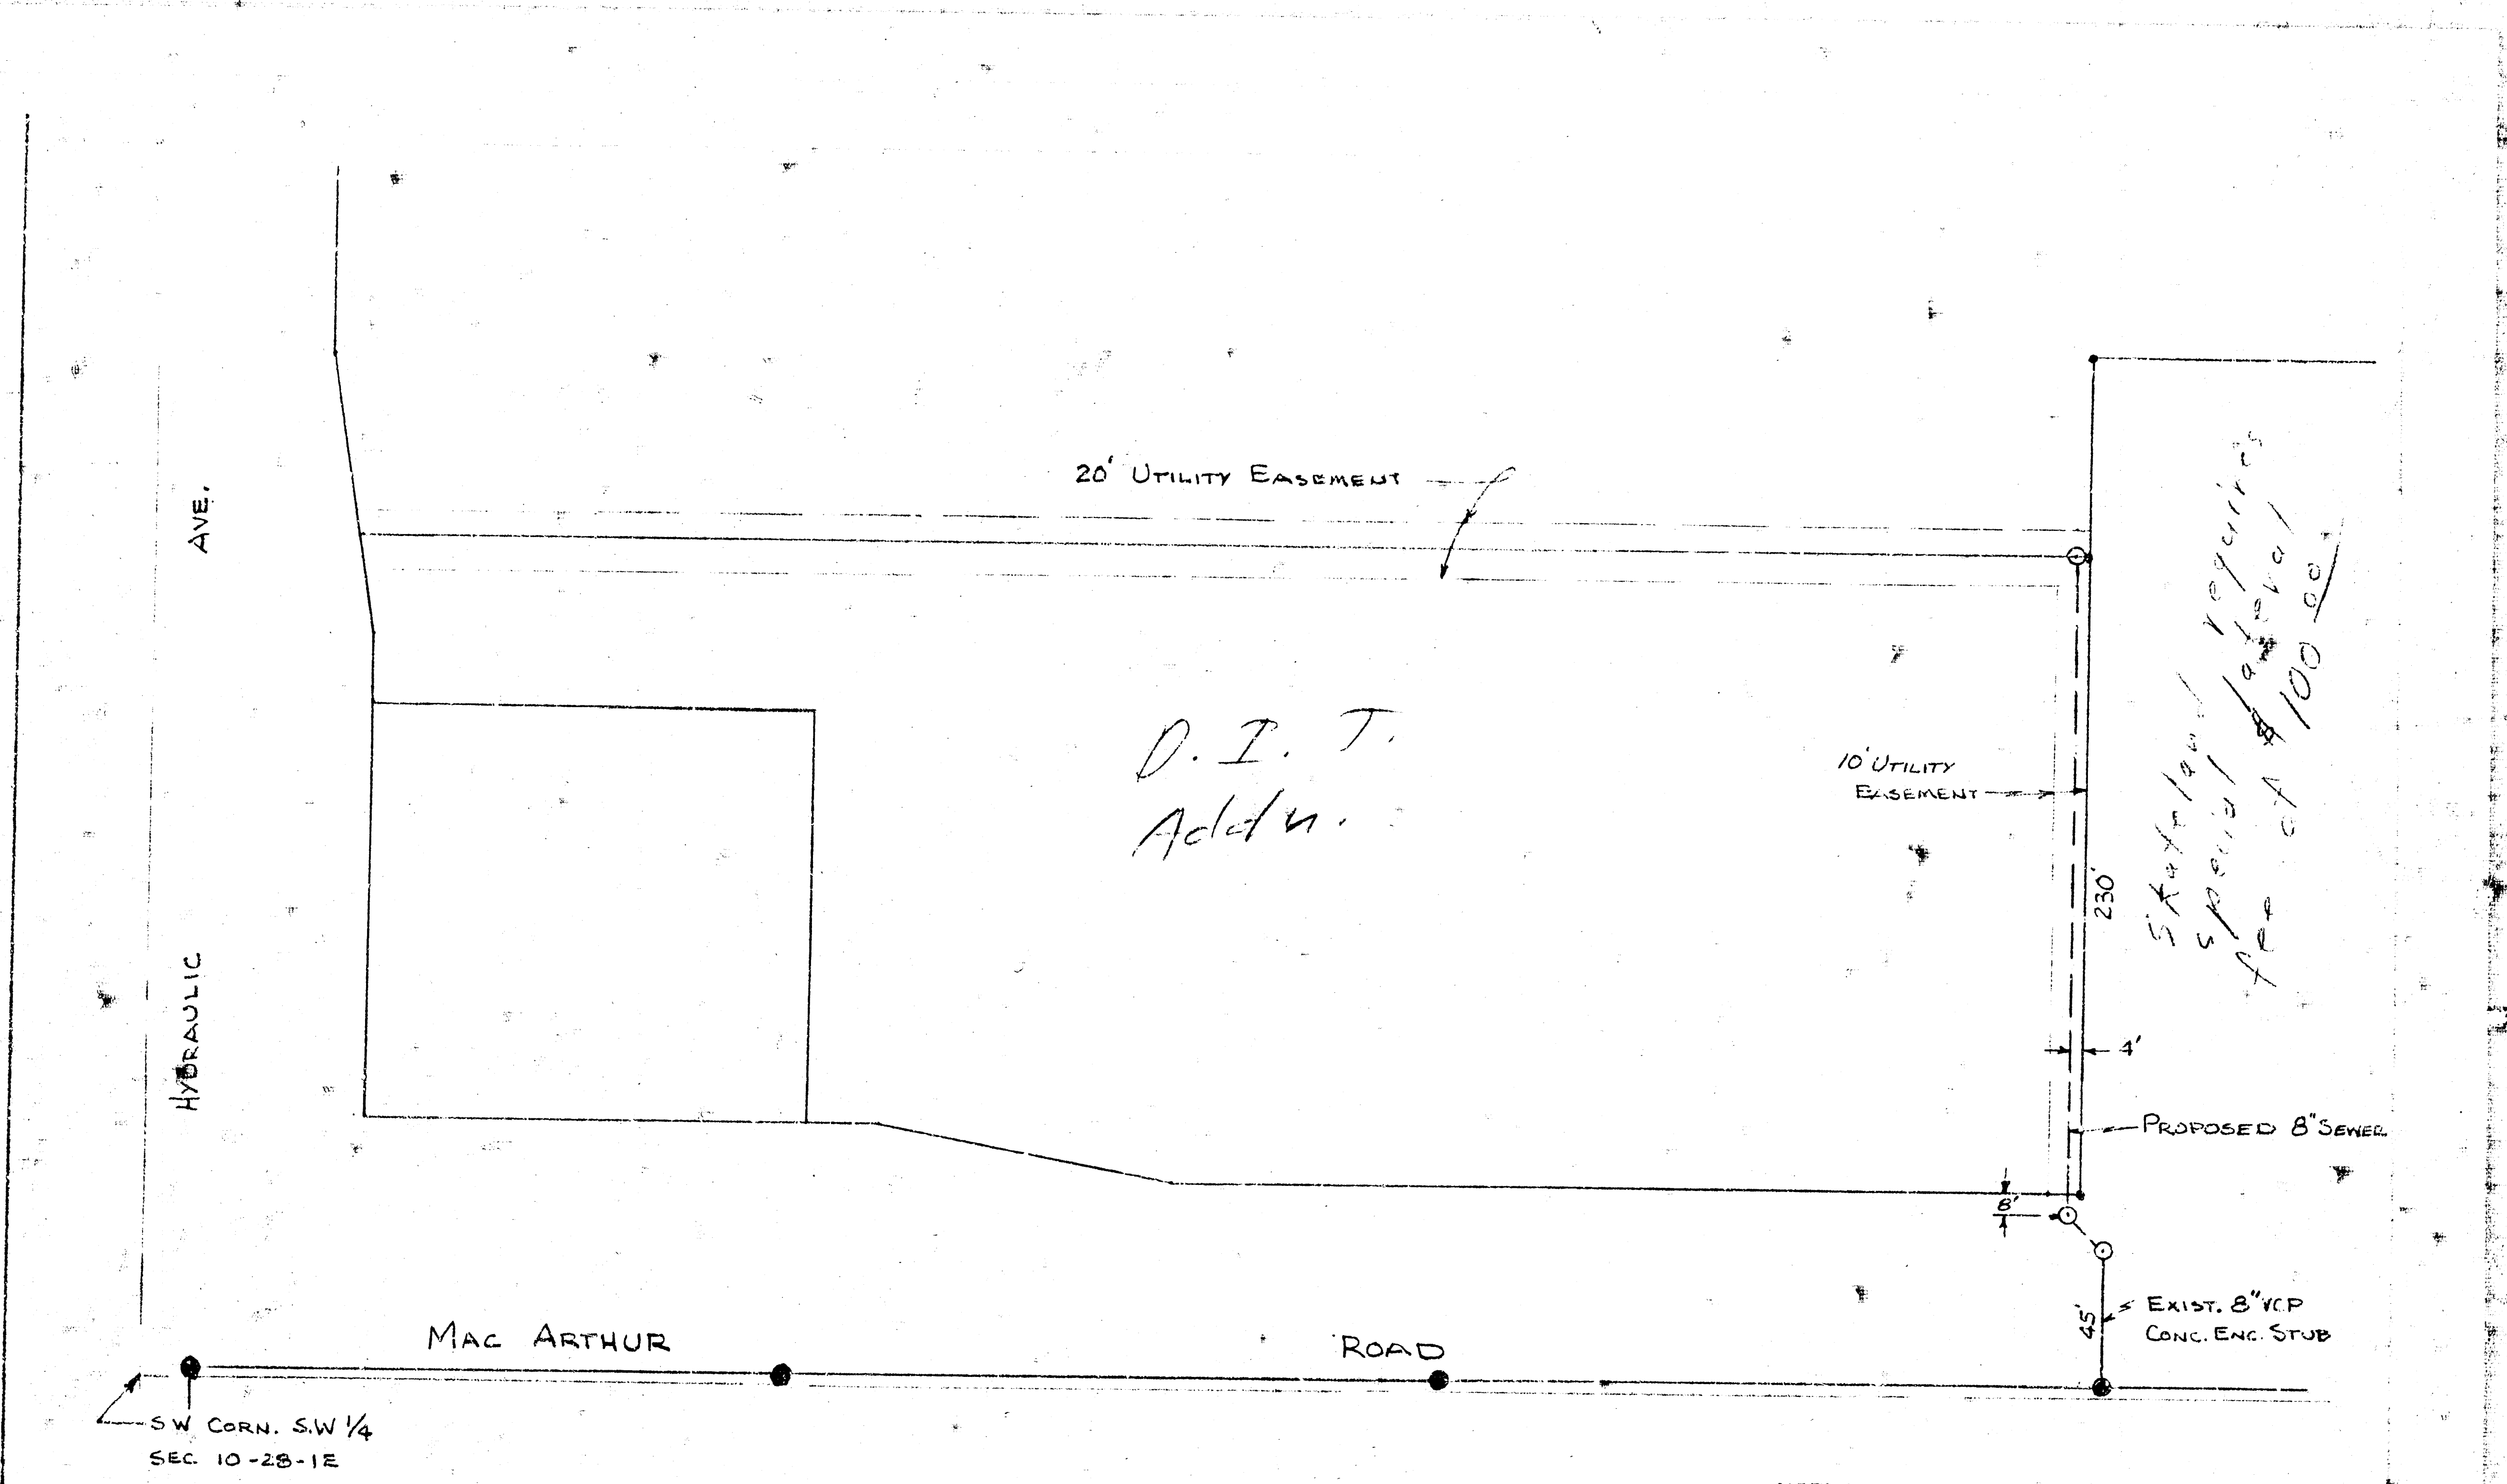

NOTE TO CONTRACTOR
 This project will be constructed under the supervision of the CITY ENGINEER and conforming to the SPECIFICATIONS of the CITY OF WICHITA. The CONTRACTOR will reimburse the City of Wichita for all cost of engineering, Plans and Inspection.

APPROVED AS NOTED
 By CITY ENGINEER OF WICHITA
 Sanitary Sewers DR 11-20-73
 Storm Sewers _____
 Driveway Approaches _____

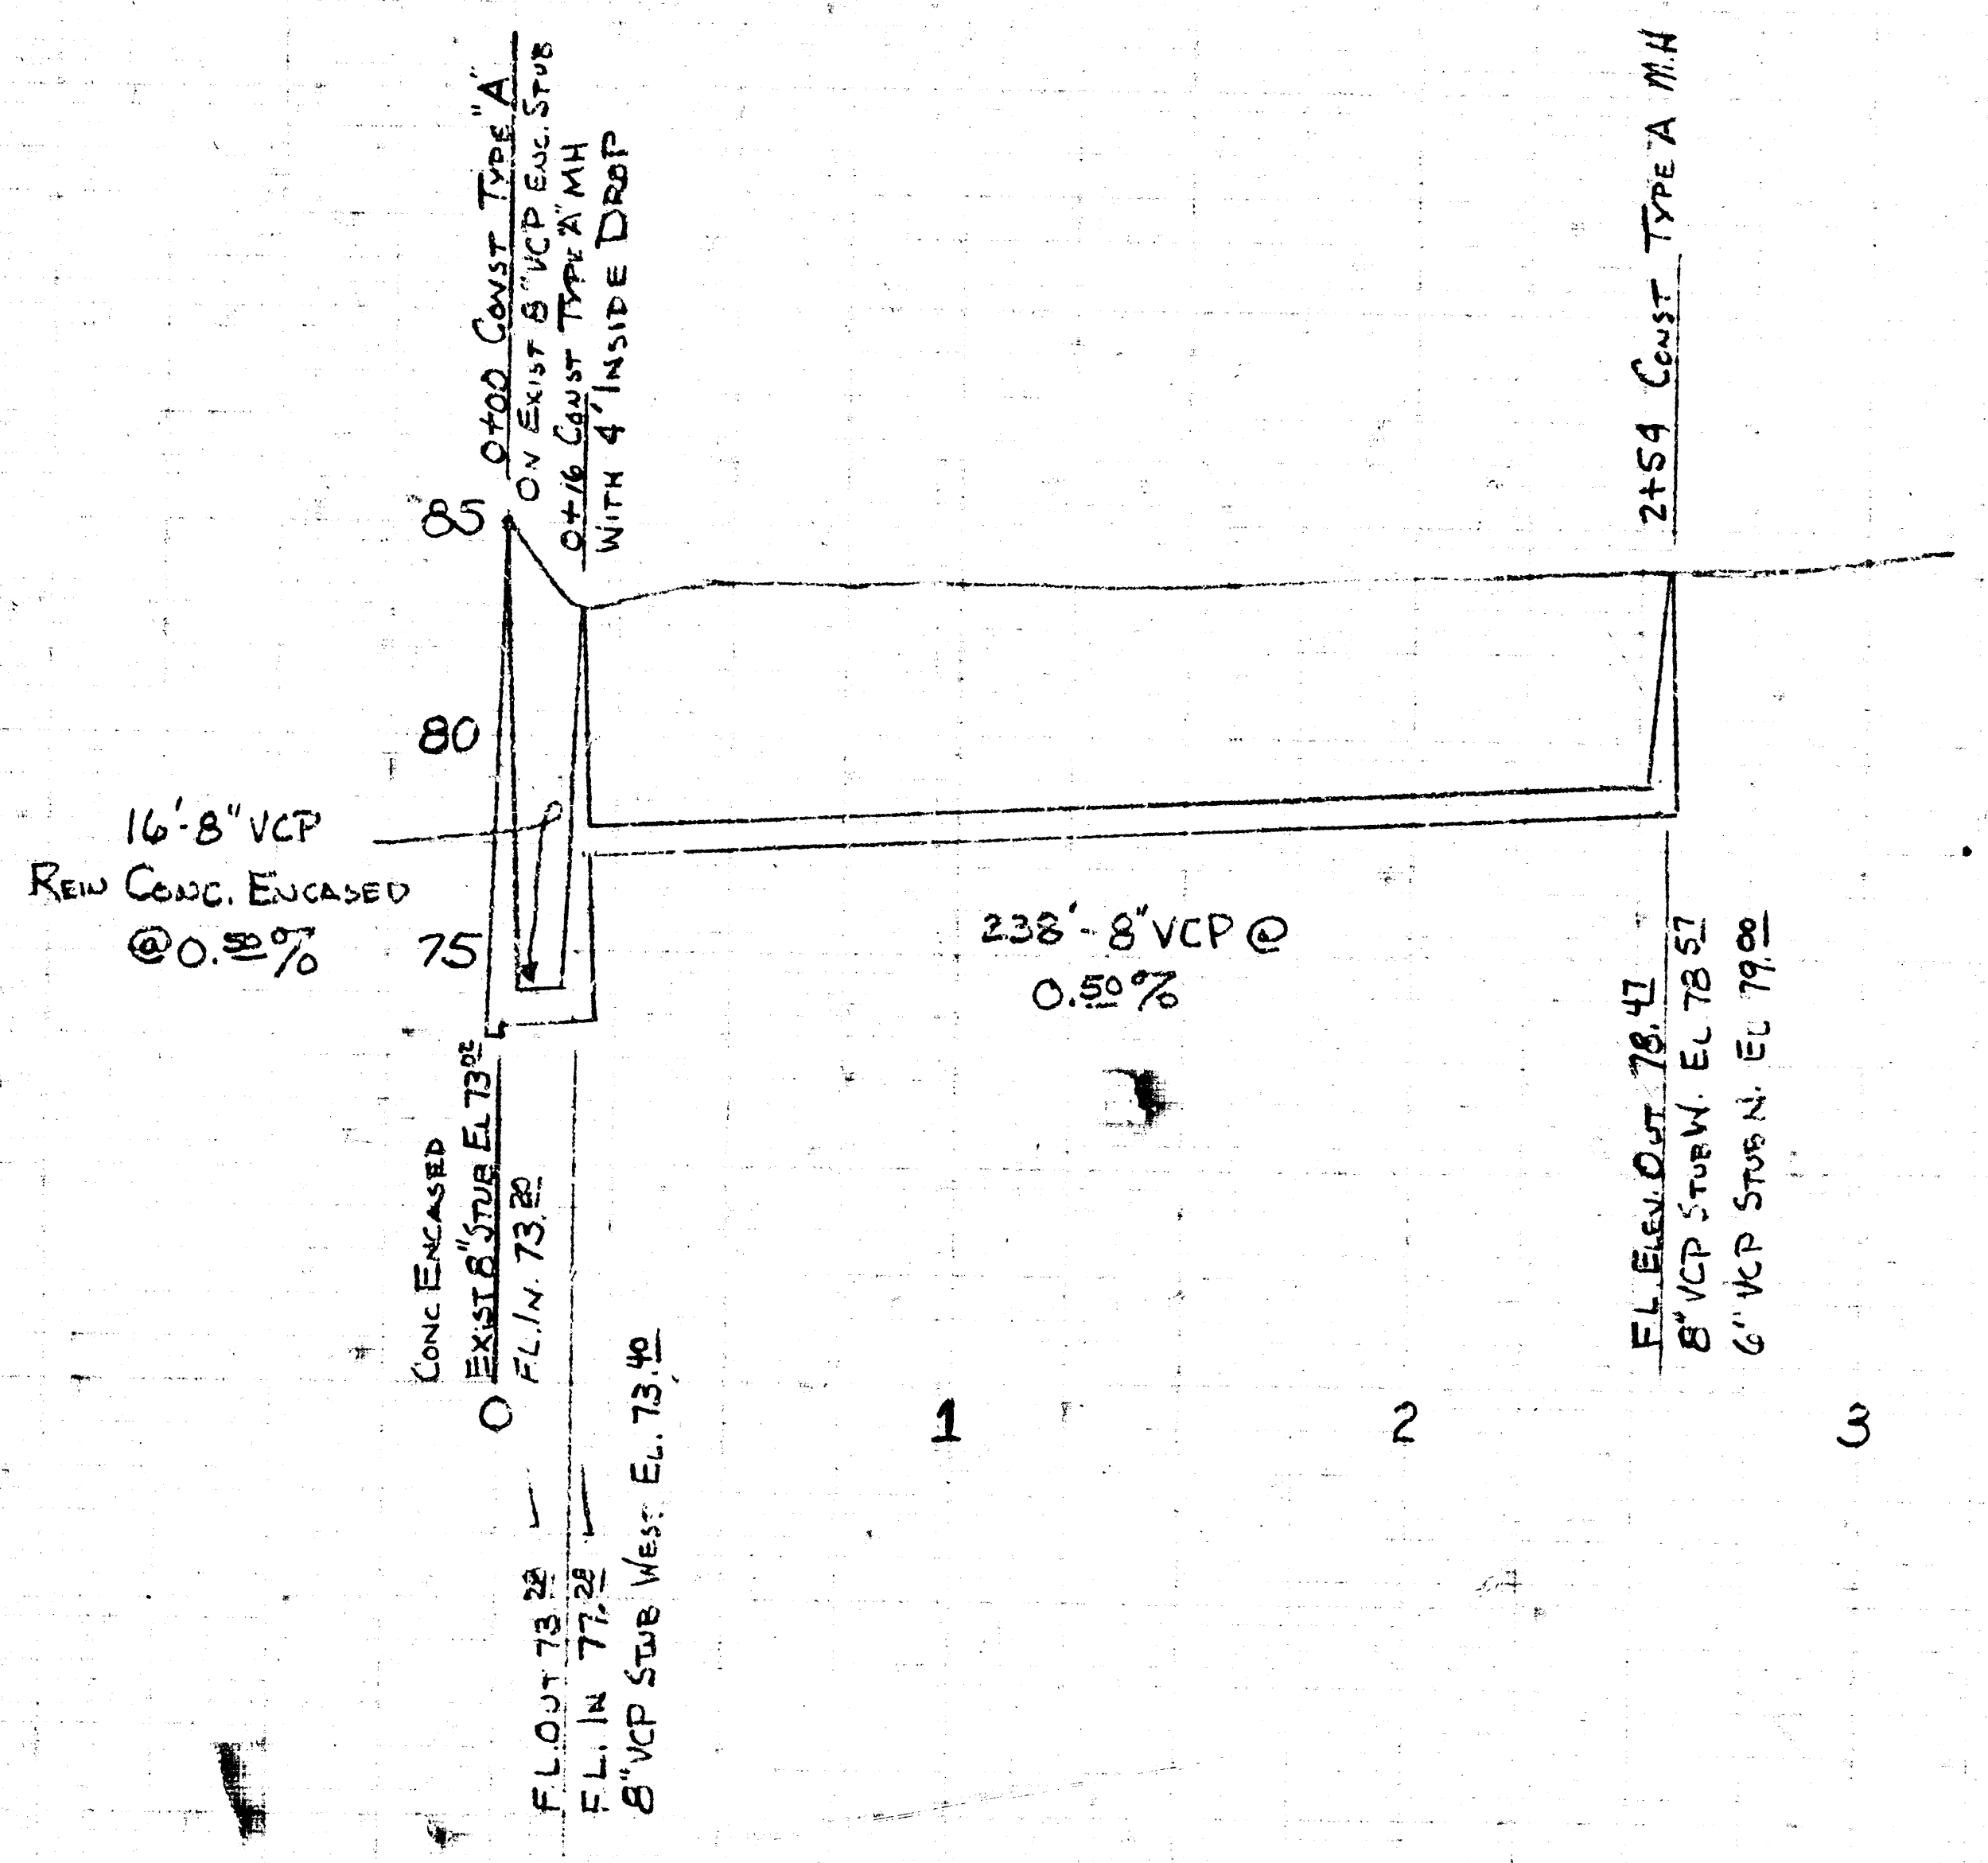

SANITARY SEWER EXTENSION
RAINBOW DRIVE IN
THEATER
 MID-STATES CONST. CO. INC.
 H.C.L.
 NOV. 1973