


PLAN
 200 W
 D.S. RAHLEY 10-78
 S.B. RAHLEY 10-78

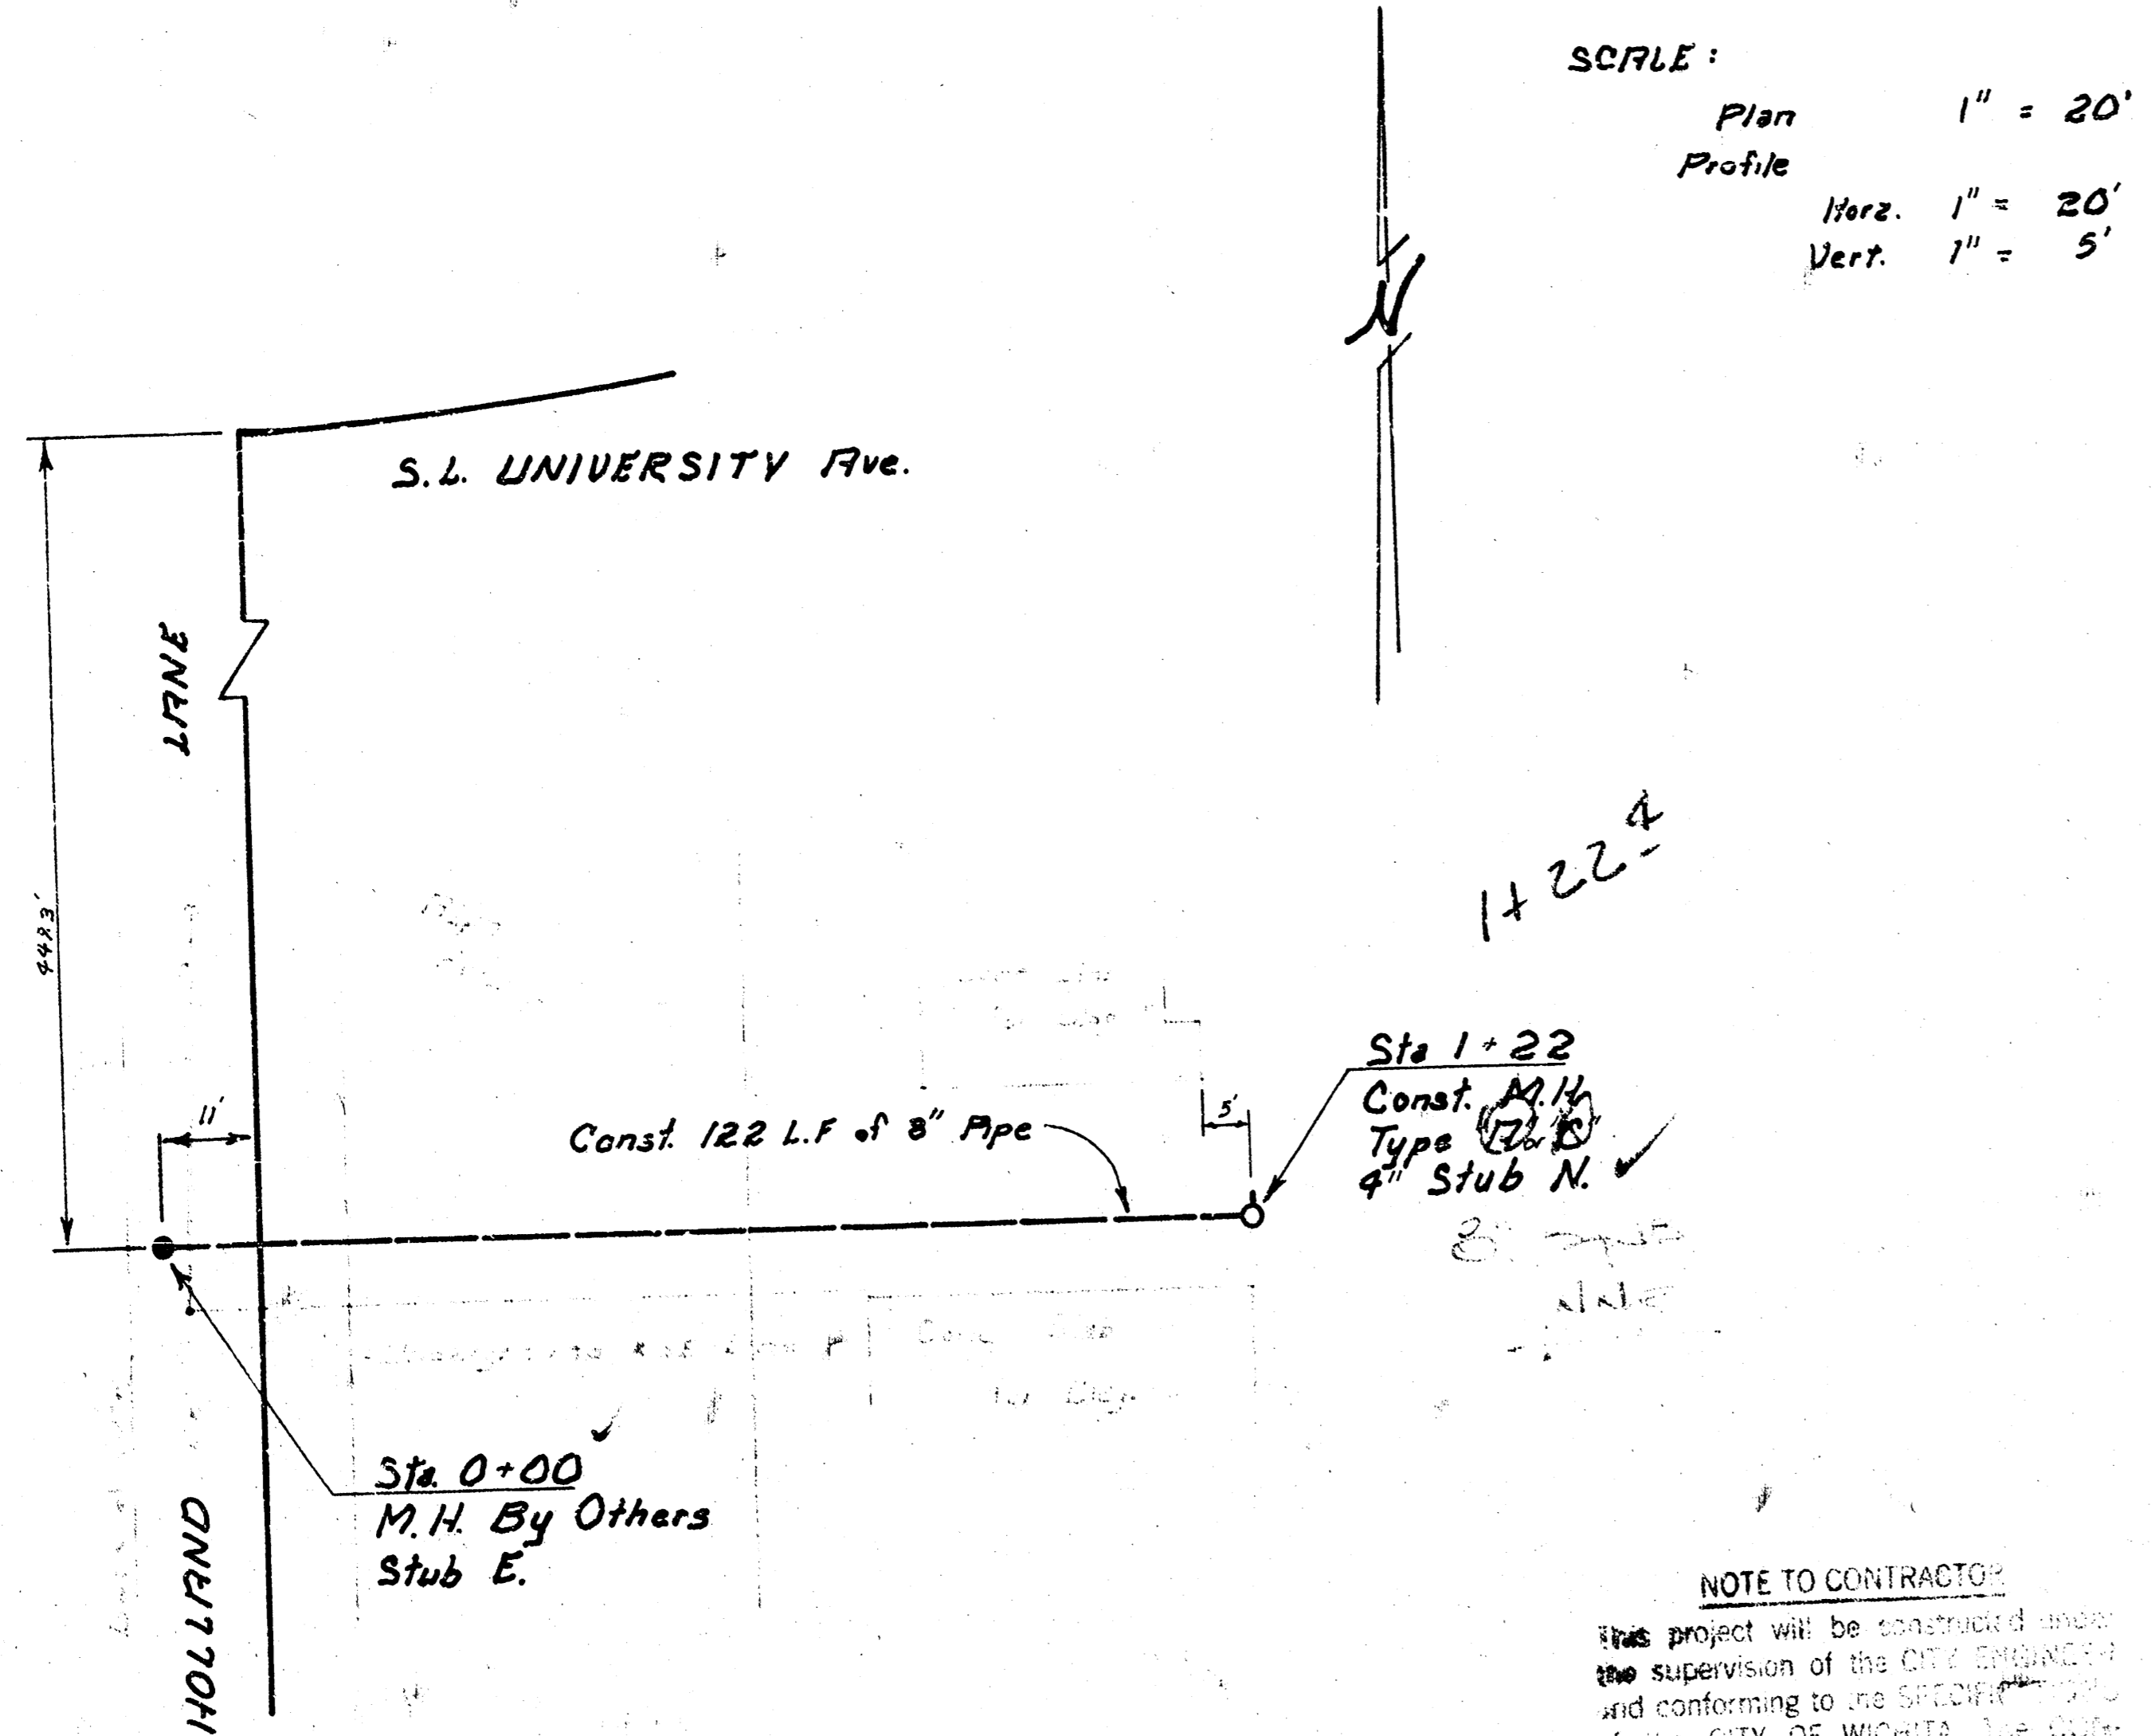


SCALE:
 Plan 1" = 20'
 Profile Horiz. 1" = 20'
 Profile Vert. 1" = 5'

1+22.4

Sta 1+22
 Const. M.H.
 Type (2) 4"
 Stub N.

Sta 0+00
 M.H. By Others
 Stub E.

NOTE TO CONTRACTOR:
 This project will be constructed under the supervision of the CITY ENGINEER and conforming to the SPECIFICATIONS of the CITY OF WICHITA. The CONTRACTOR will reimburse the City of Wichita for an cost of Engineering, Plans, and Inspection.

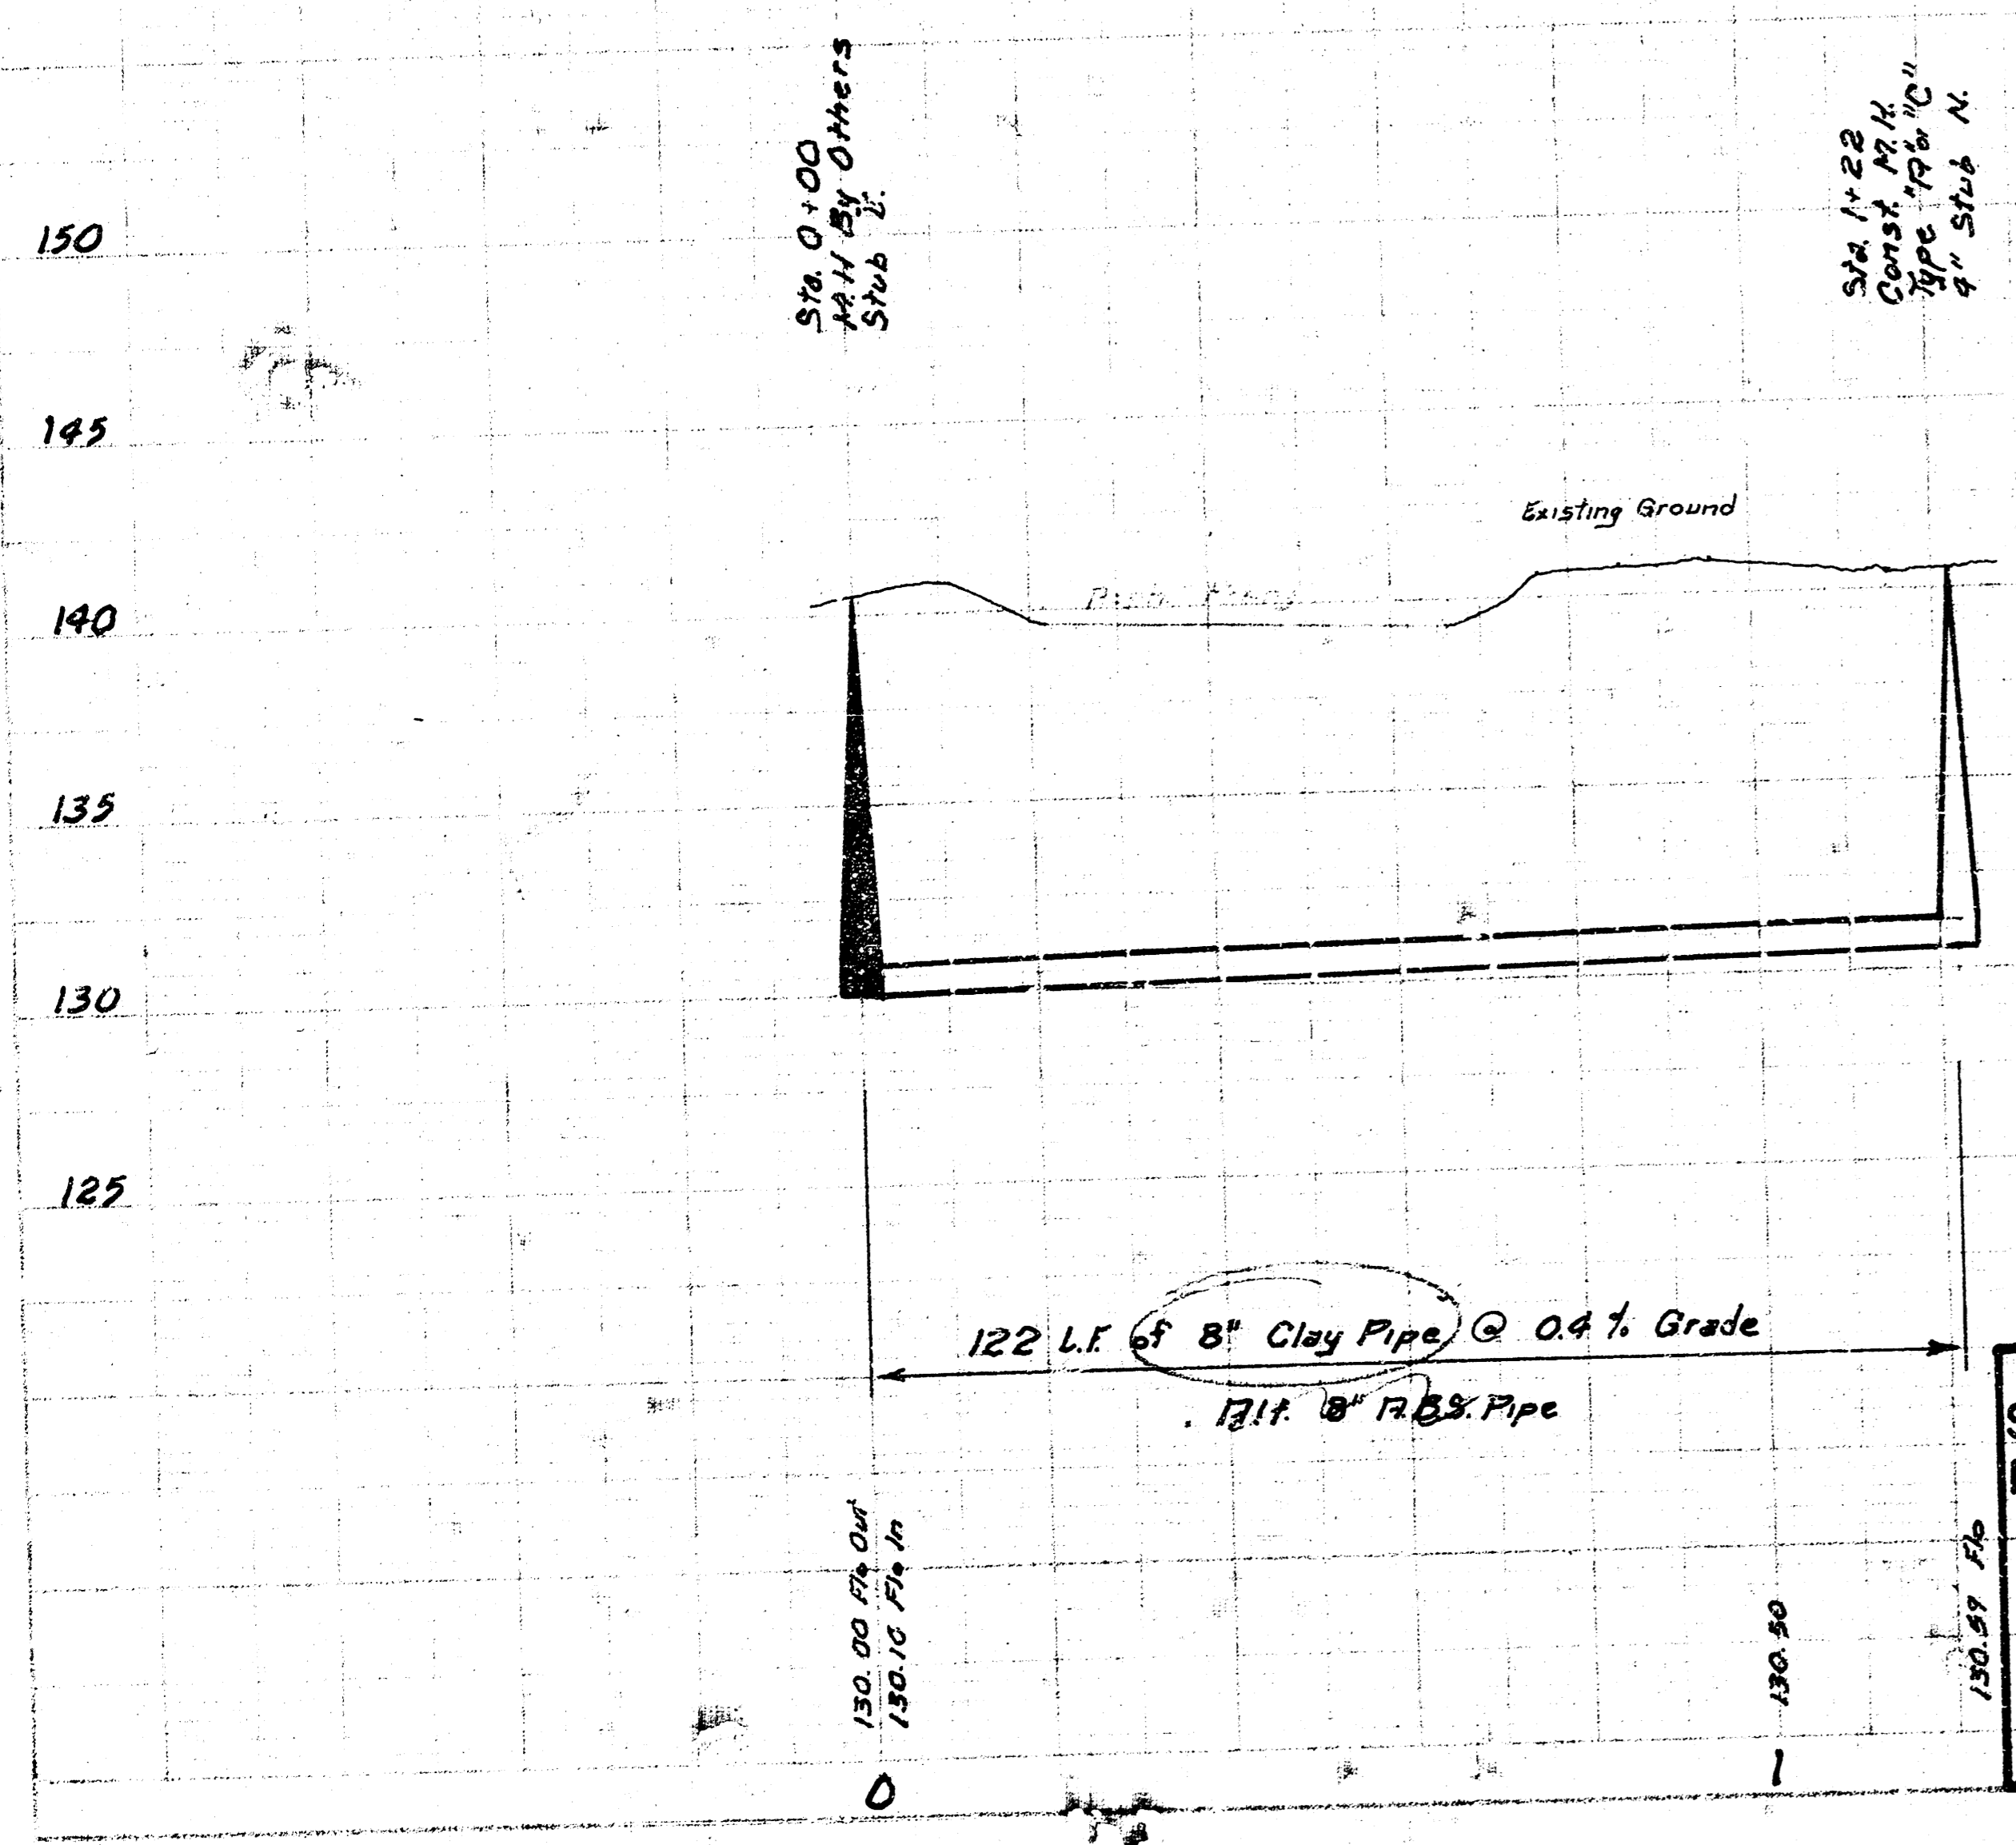

Sta 1+22
 Const. M.H.
 Type (2) 4"
 Stub N.

Sta 0+00
 M.H. By Others
 Stub E.

AD BUILT
~~Finished~~

D 34
 AR-8



SANITARY SEWER Extension to serve RIDGE PLAZA OFFICE PARK at 520 S. HOLLAND
 CITY of WICHITA, KANSAS
 R.W. LINN - CITY ENGINEER
 DATE: _____
 PROJECT No. 468-76-245-80626-000-000-008 1/1

1 2 3 4