
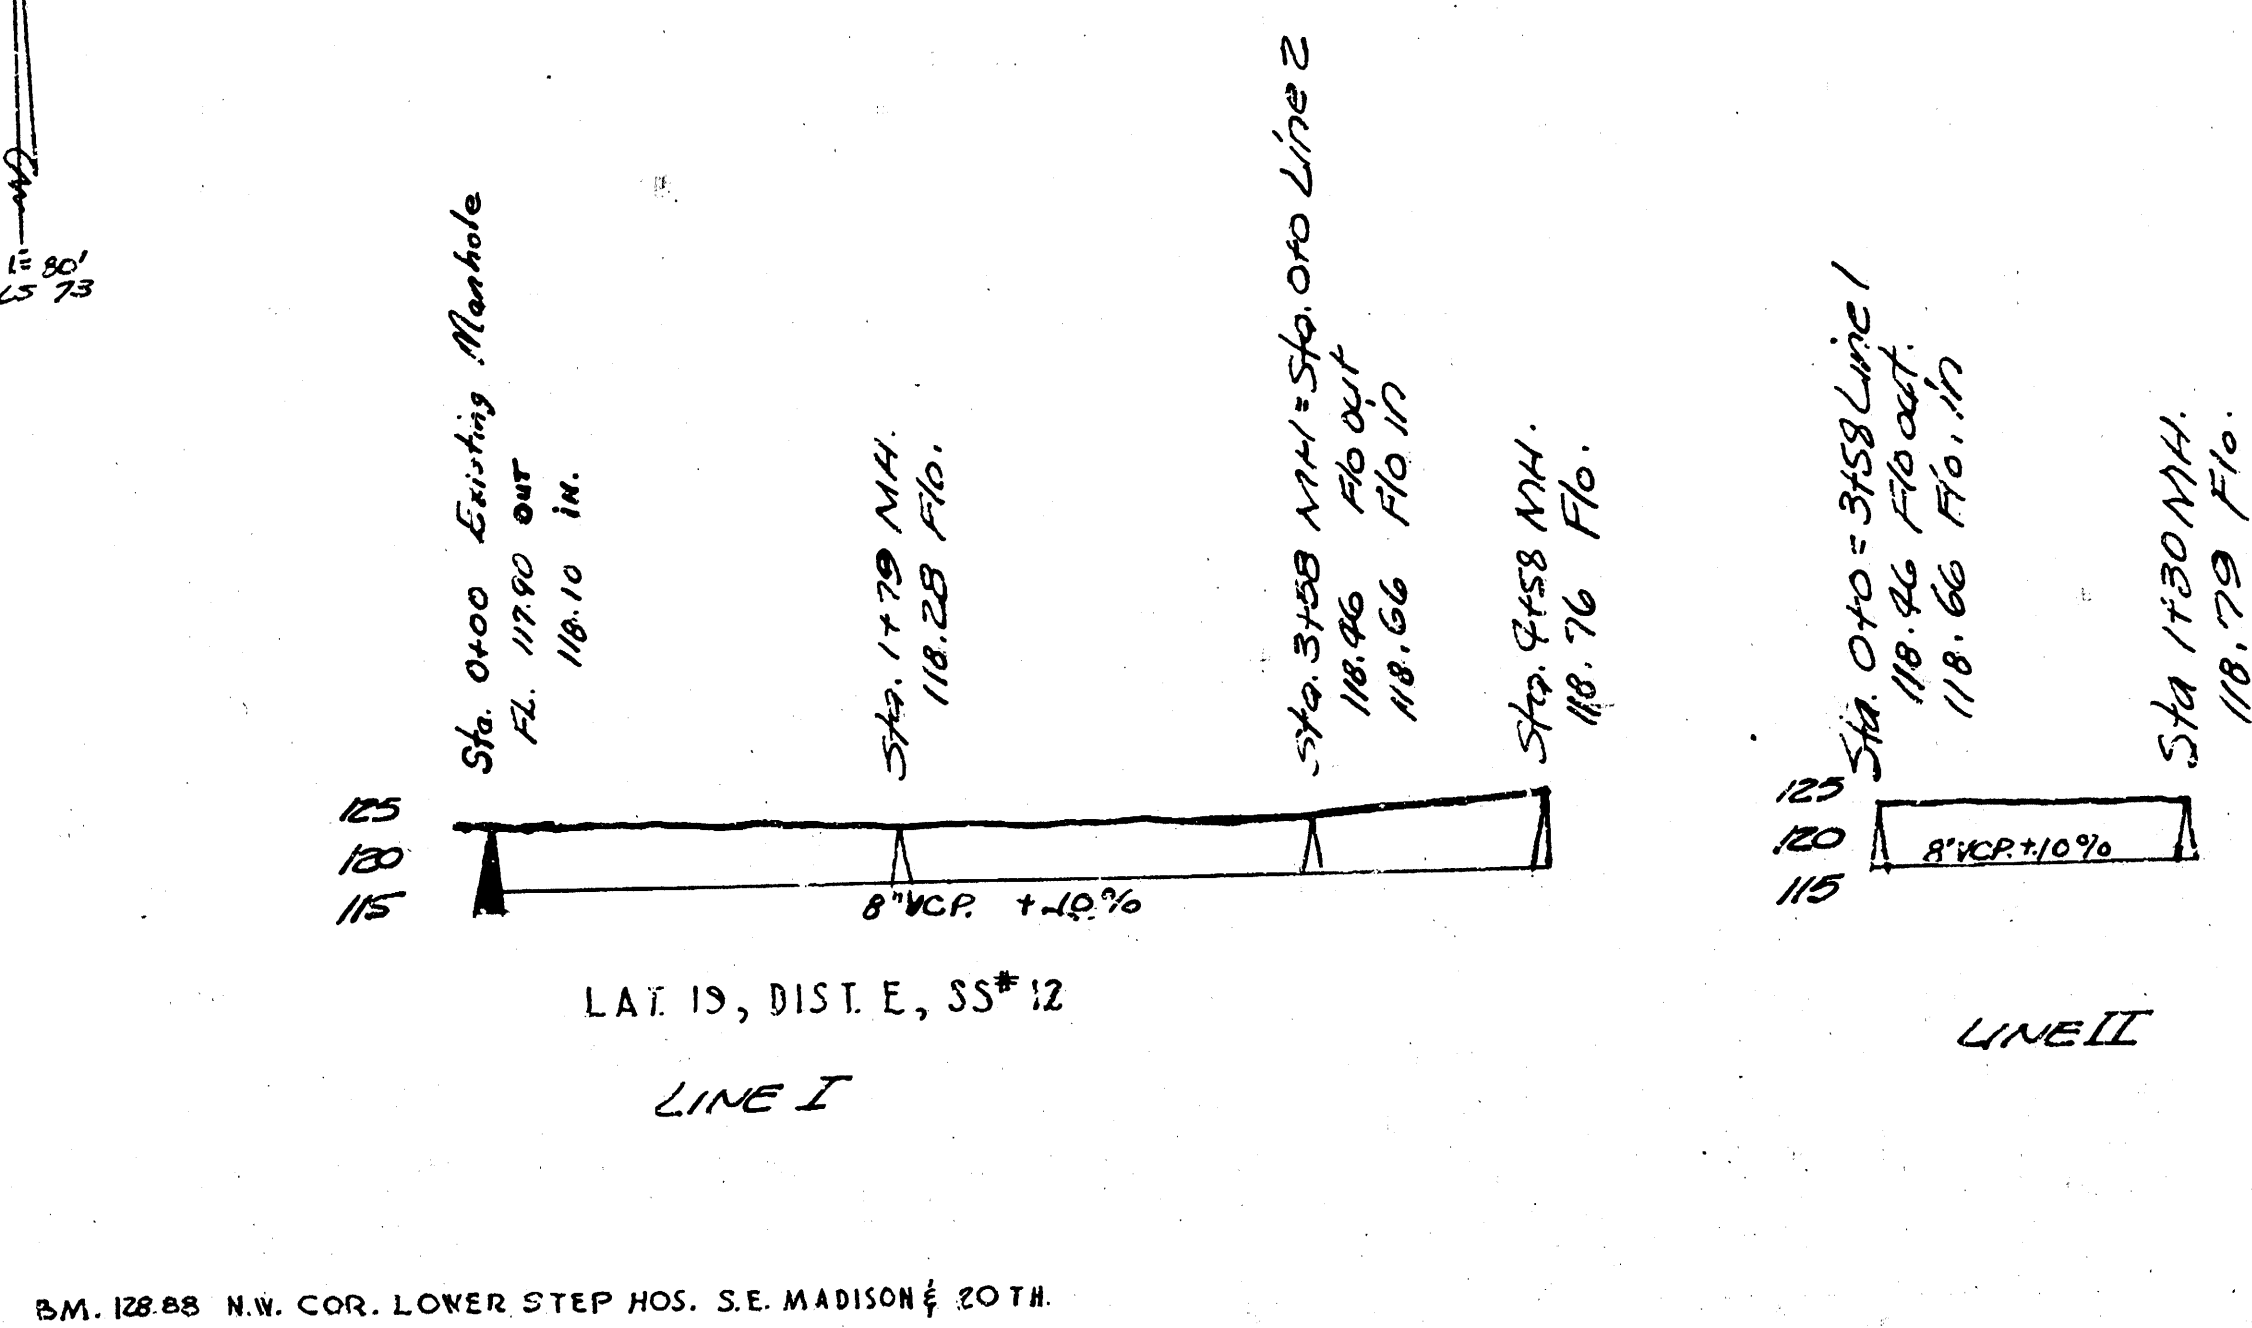


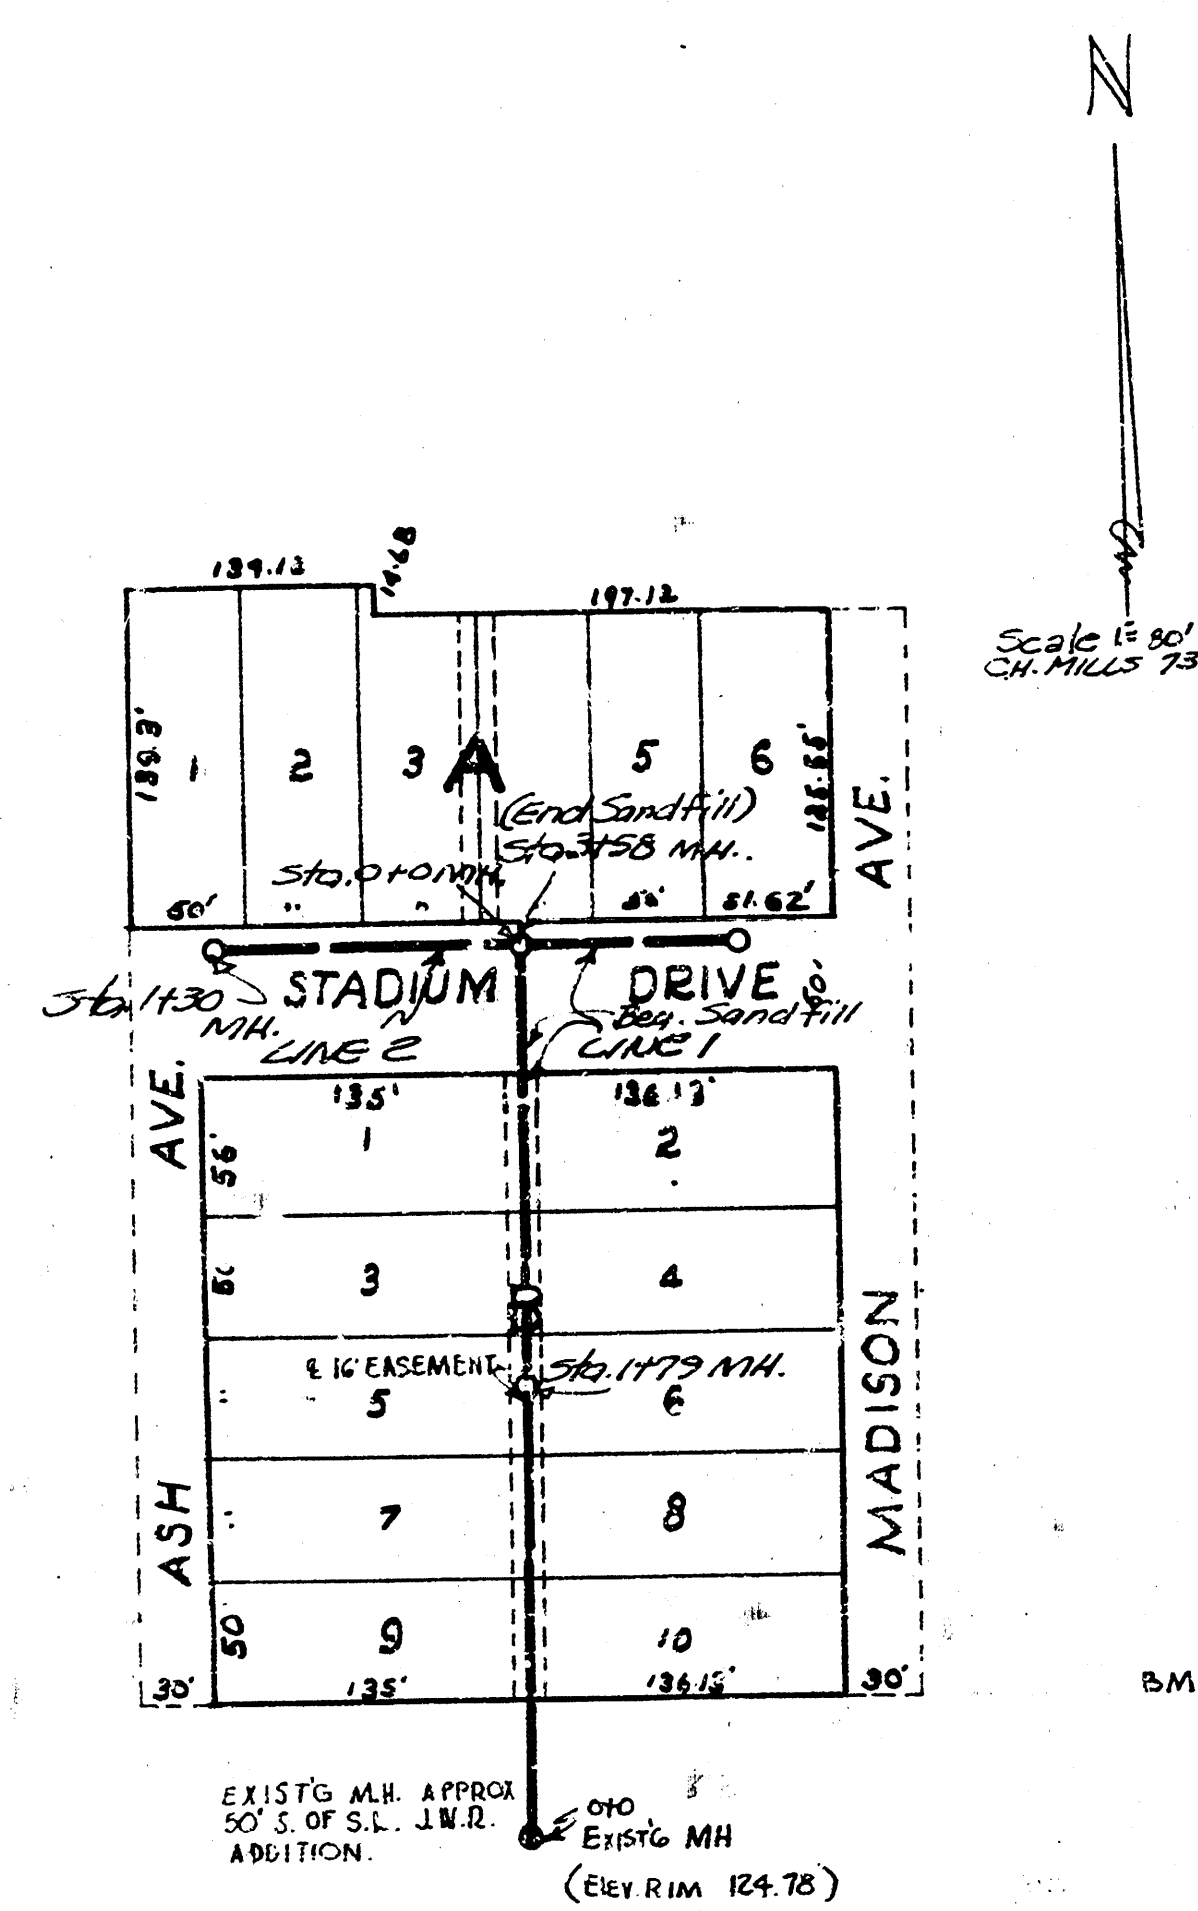

LAT. 19, DIST. E, SS# 12
PRIVATE SEWER CONTRACT - J. Walter Ross Second Addn.
CITY OF WICHITA, KANSAS
L. K. WHITE CITY ENGINEER
1950