



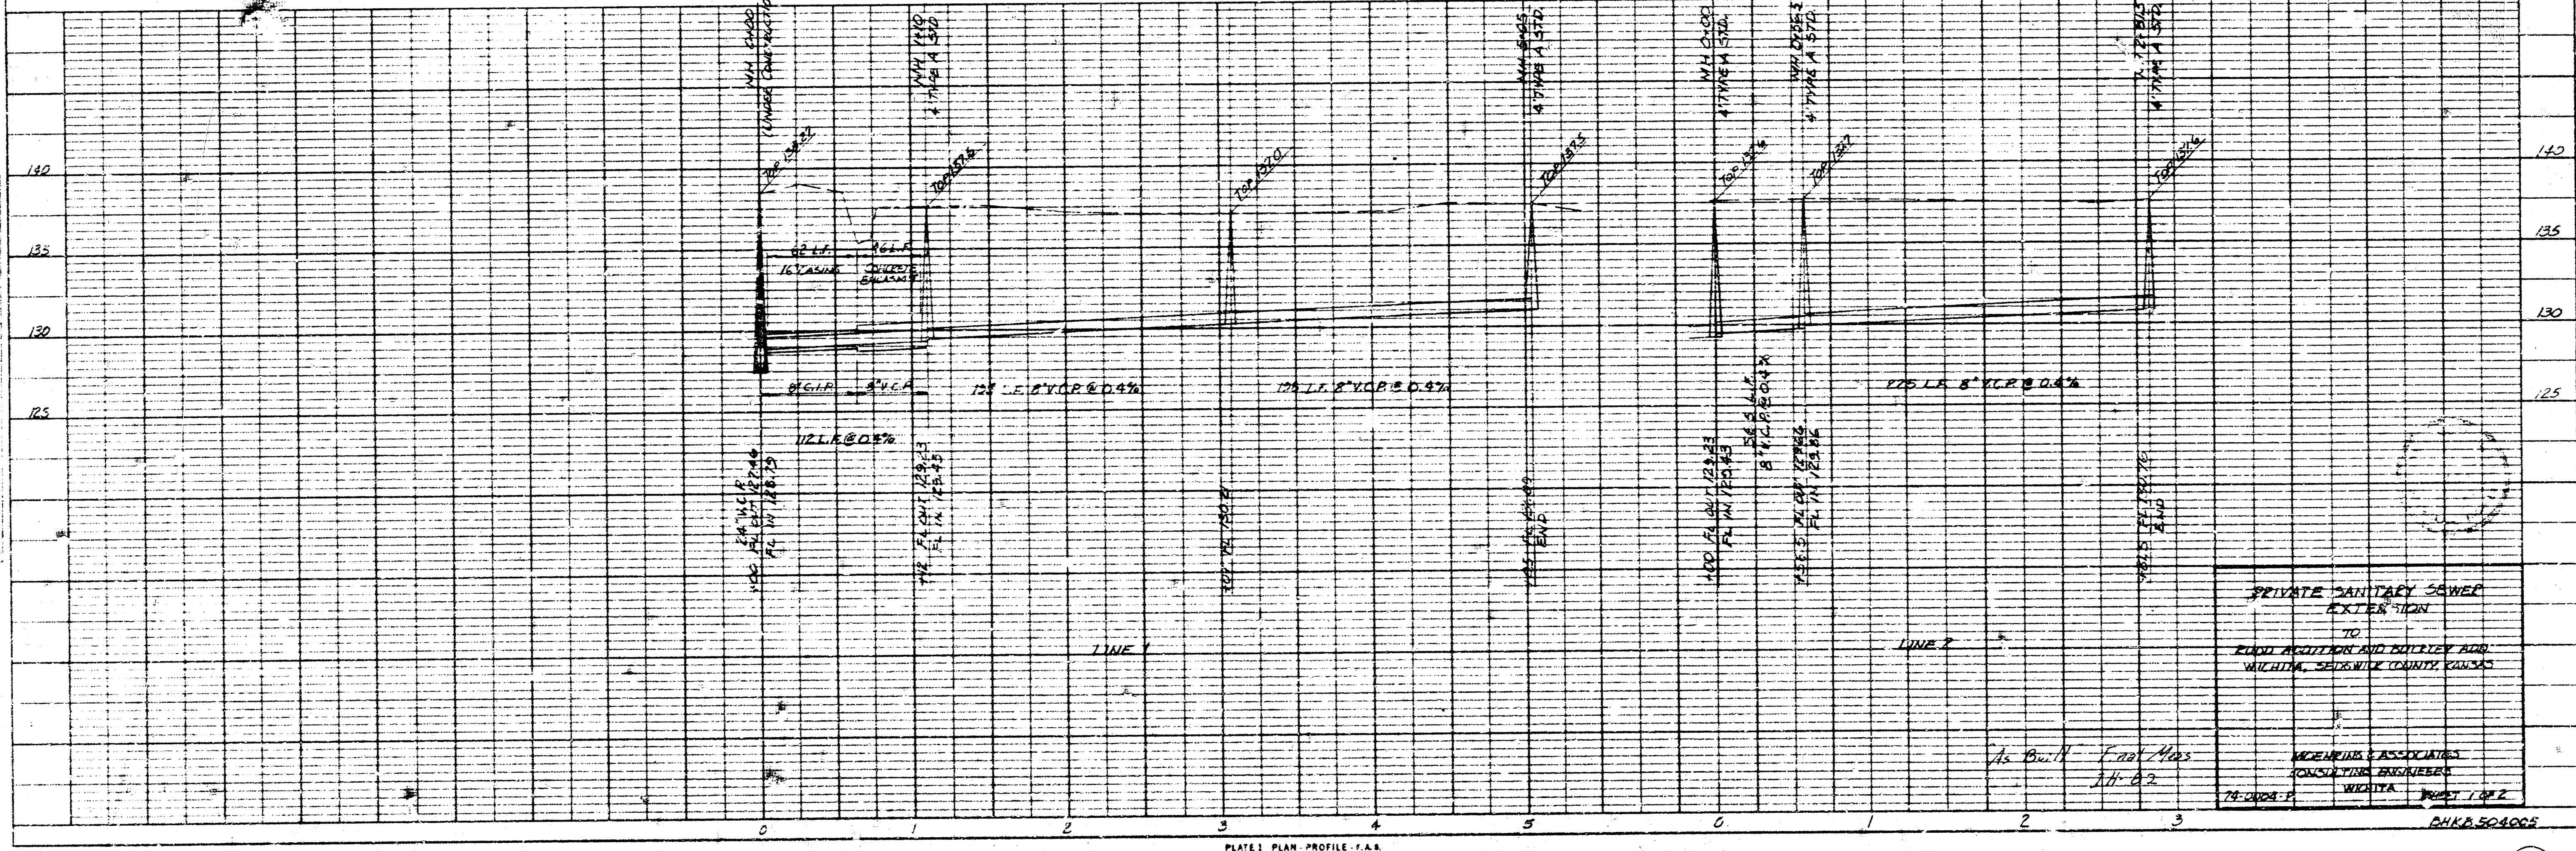
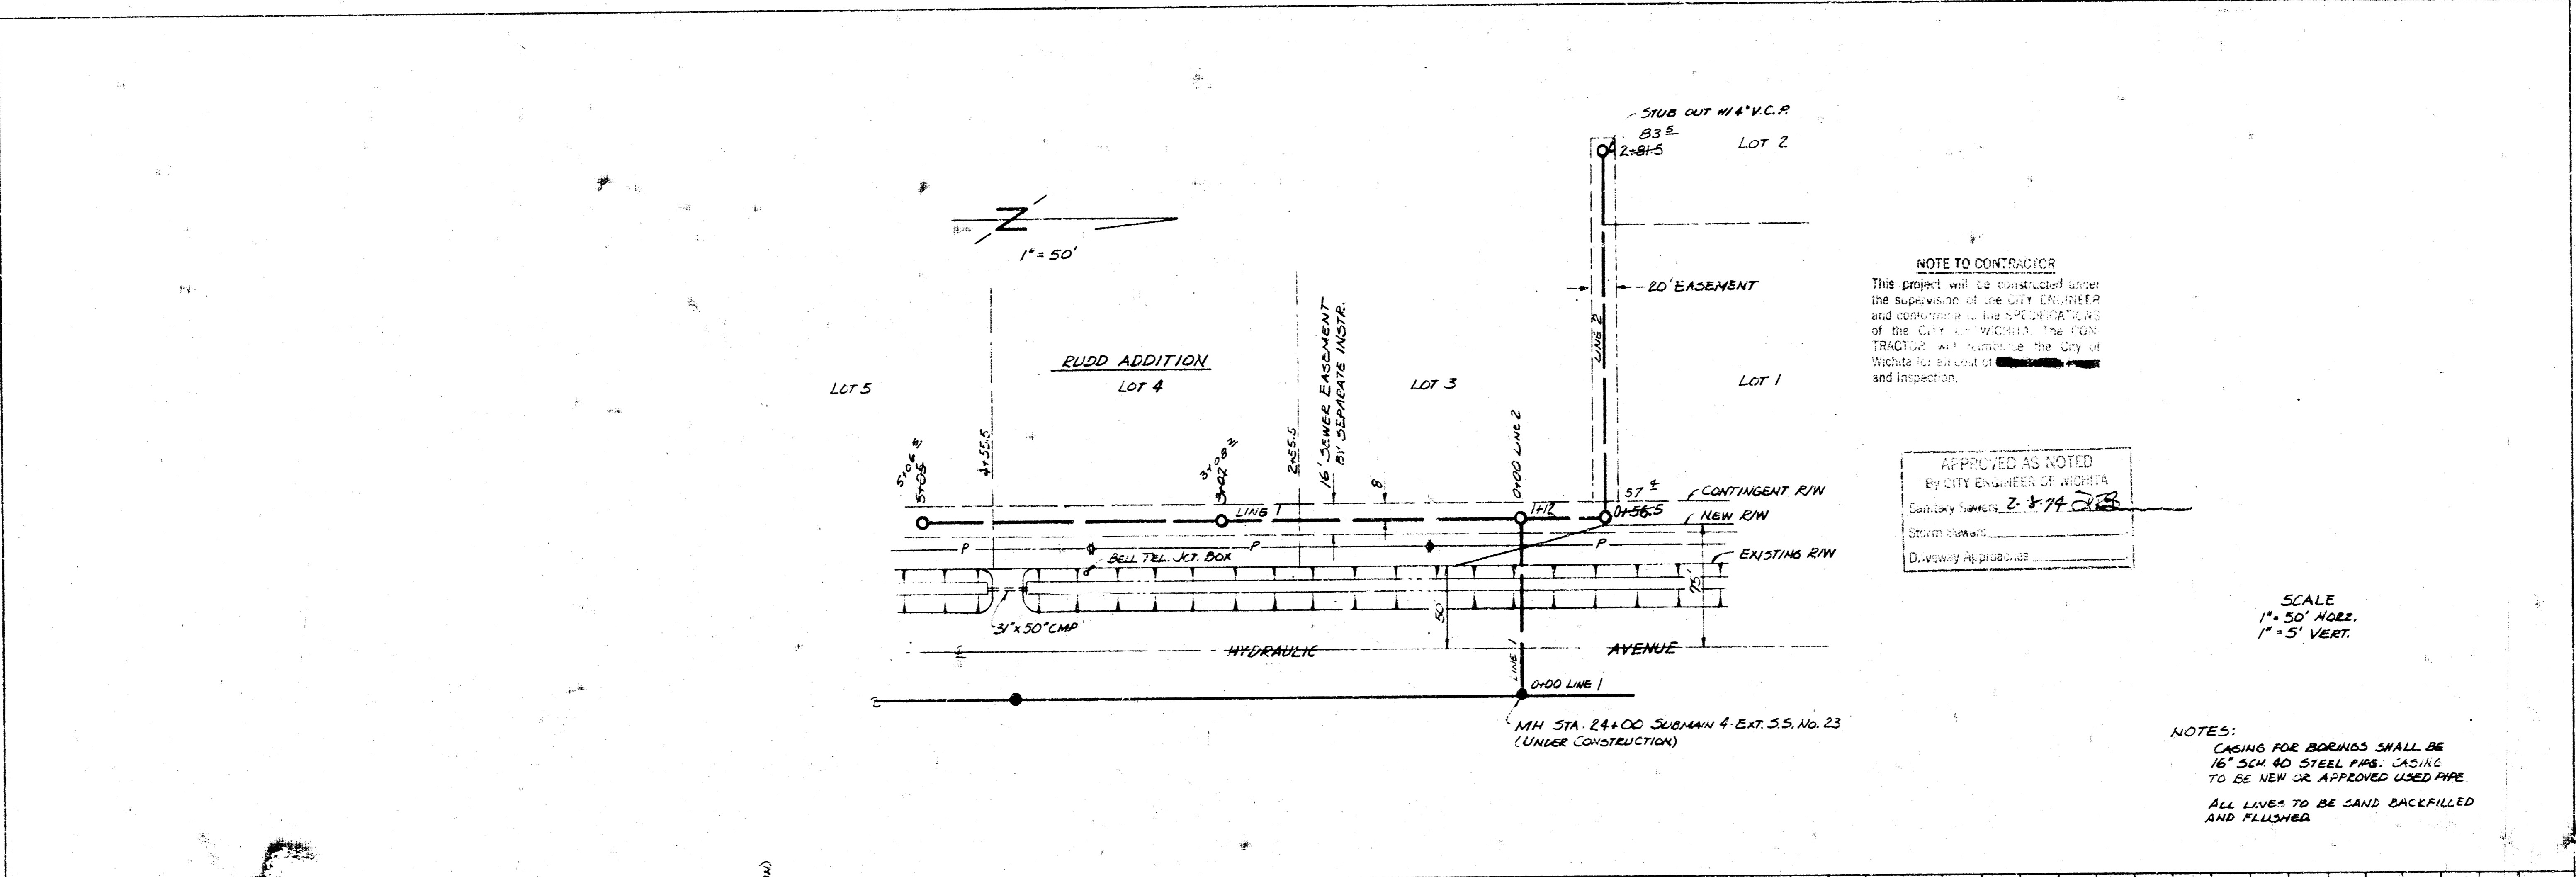


PLATE 1 PLAN PROFILE - F.A.R.
 CLEARPRINT PAPER 22 x 34 IN.
 10/20/22