


PUB. ROAD DIV. NO.	STATE	PROJECT NO.	FISCAL YEAR	SHEET NO.
5	KANSAS	87 RS 428(13)		

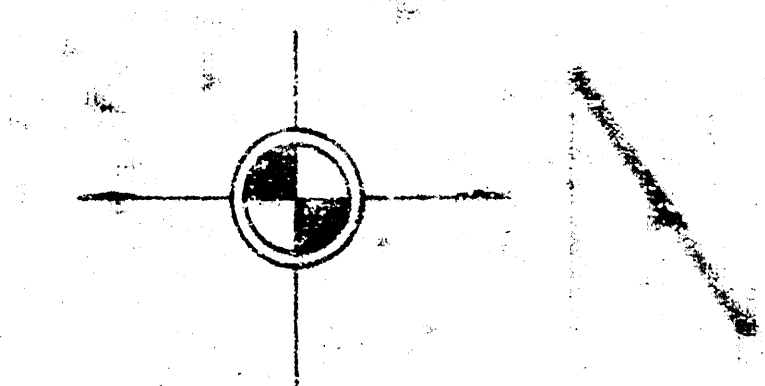

Plan Scale 1"=20'
Profile Scale 1"=20' HORIZ.
1"=5' VERT.

SEDGWICK

COUNTY



ZOO

lot 1

Block "A"

SECOND

ADDITION

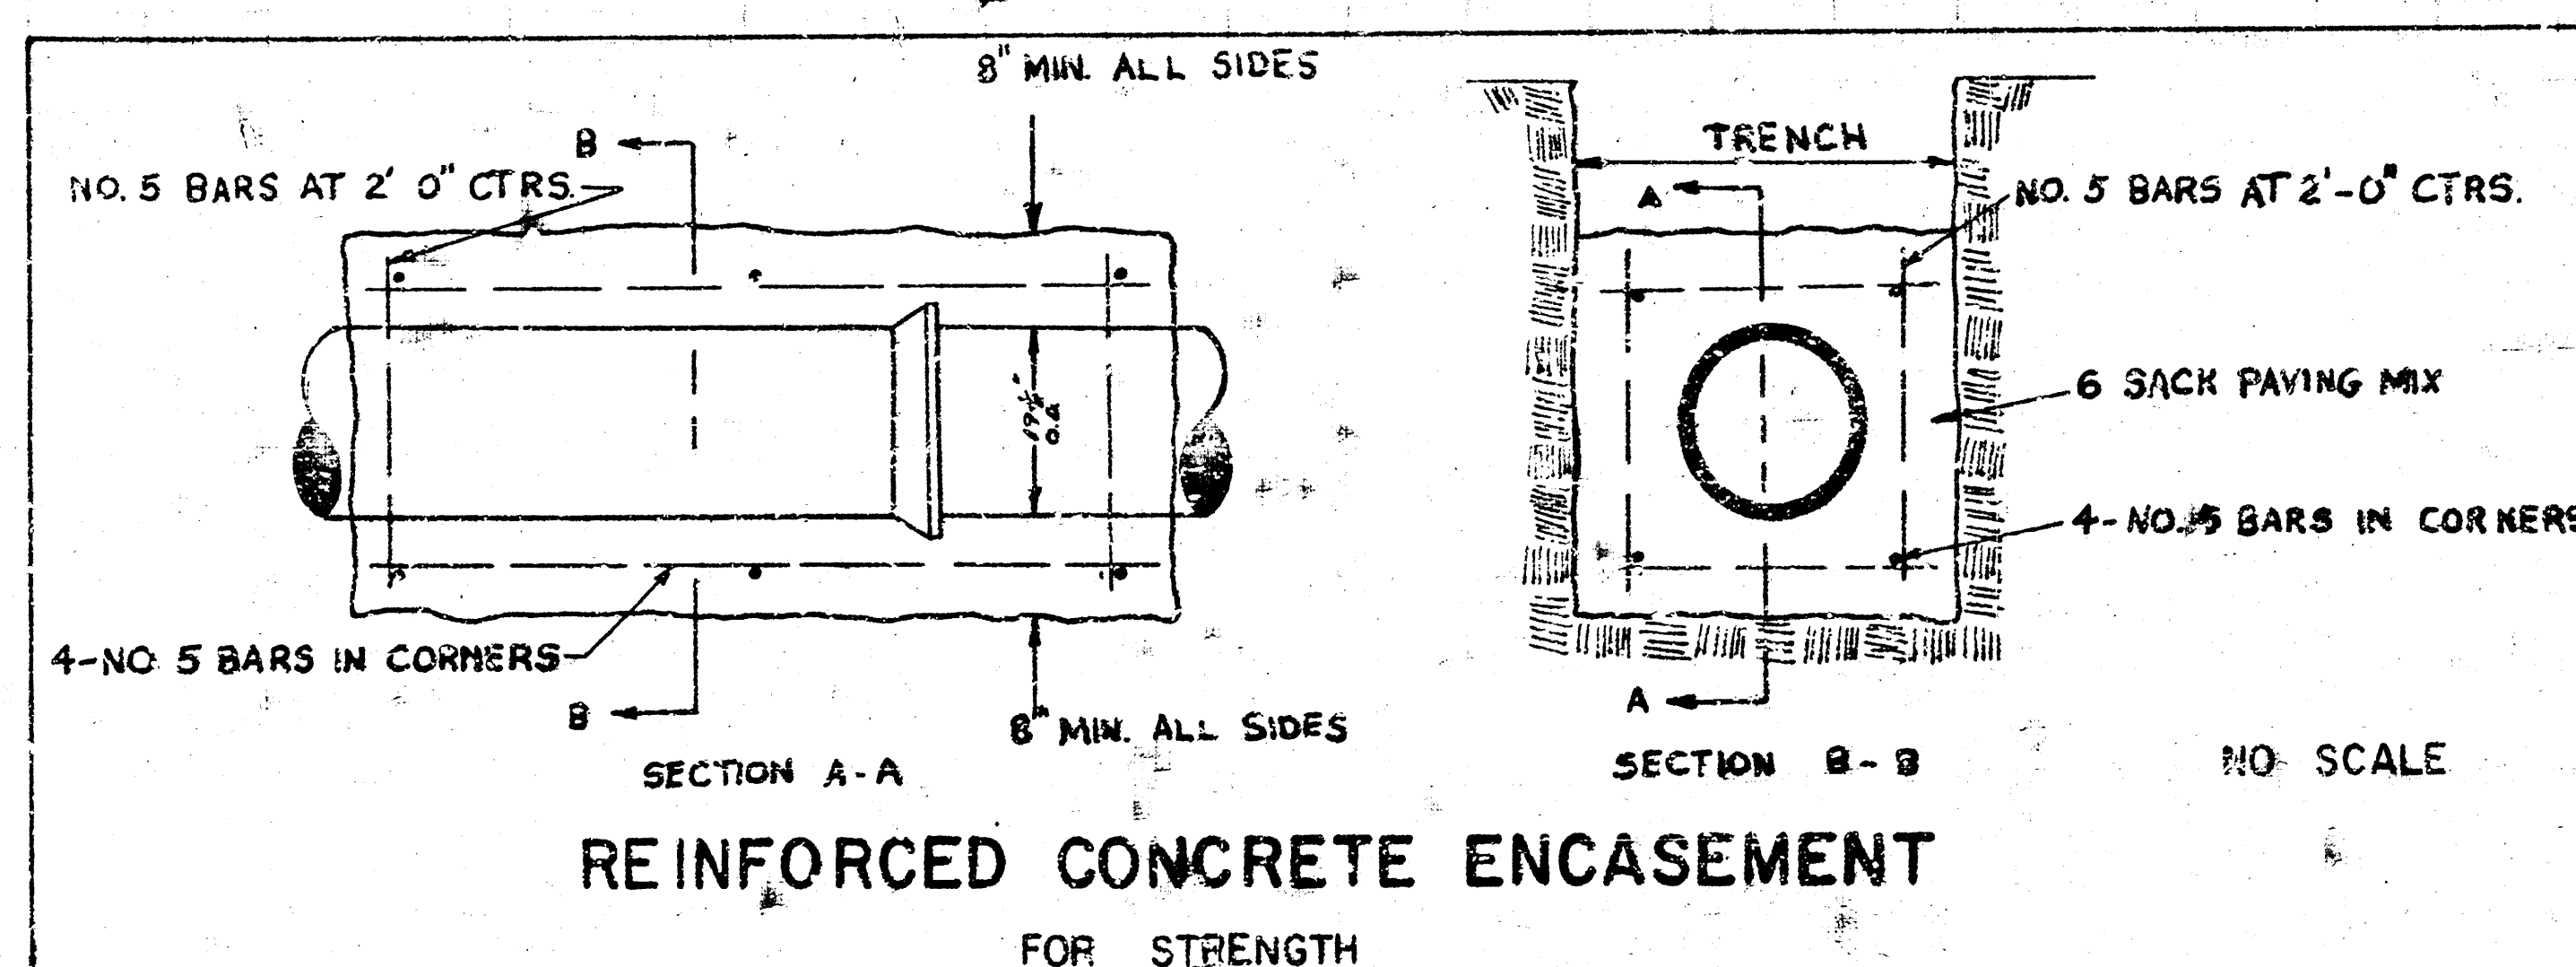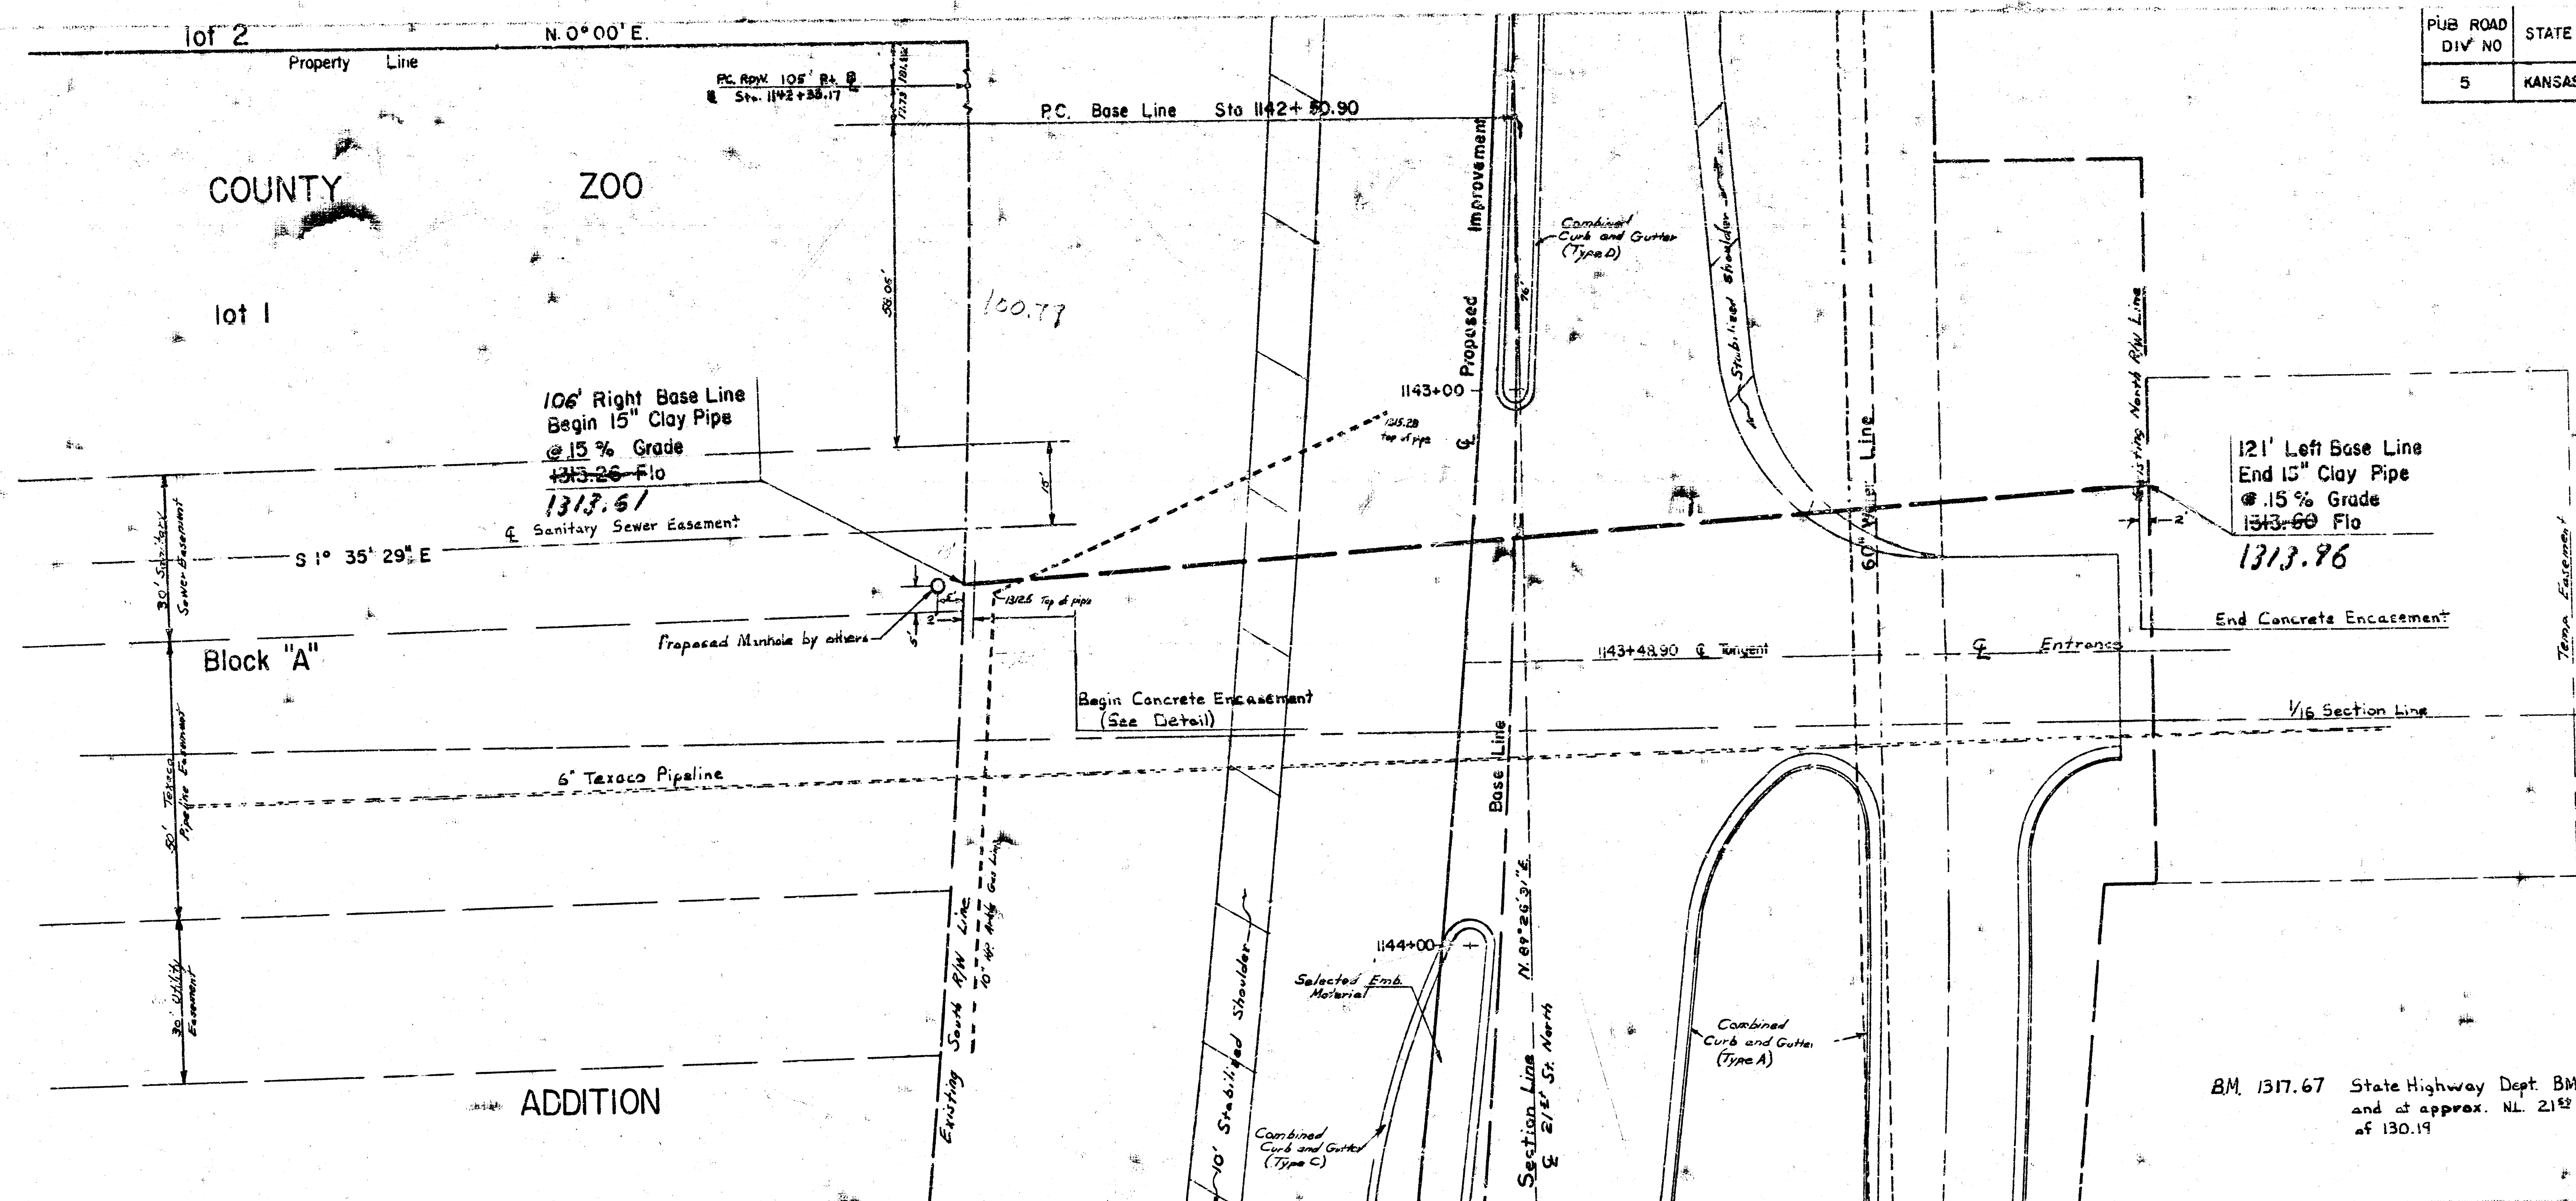


1325

1320

1315

1310

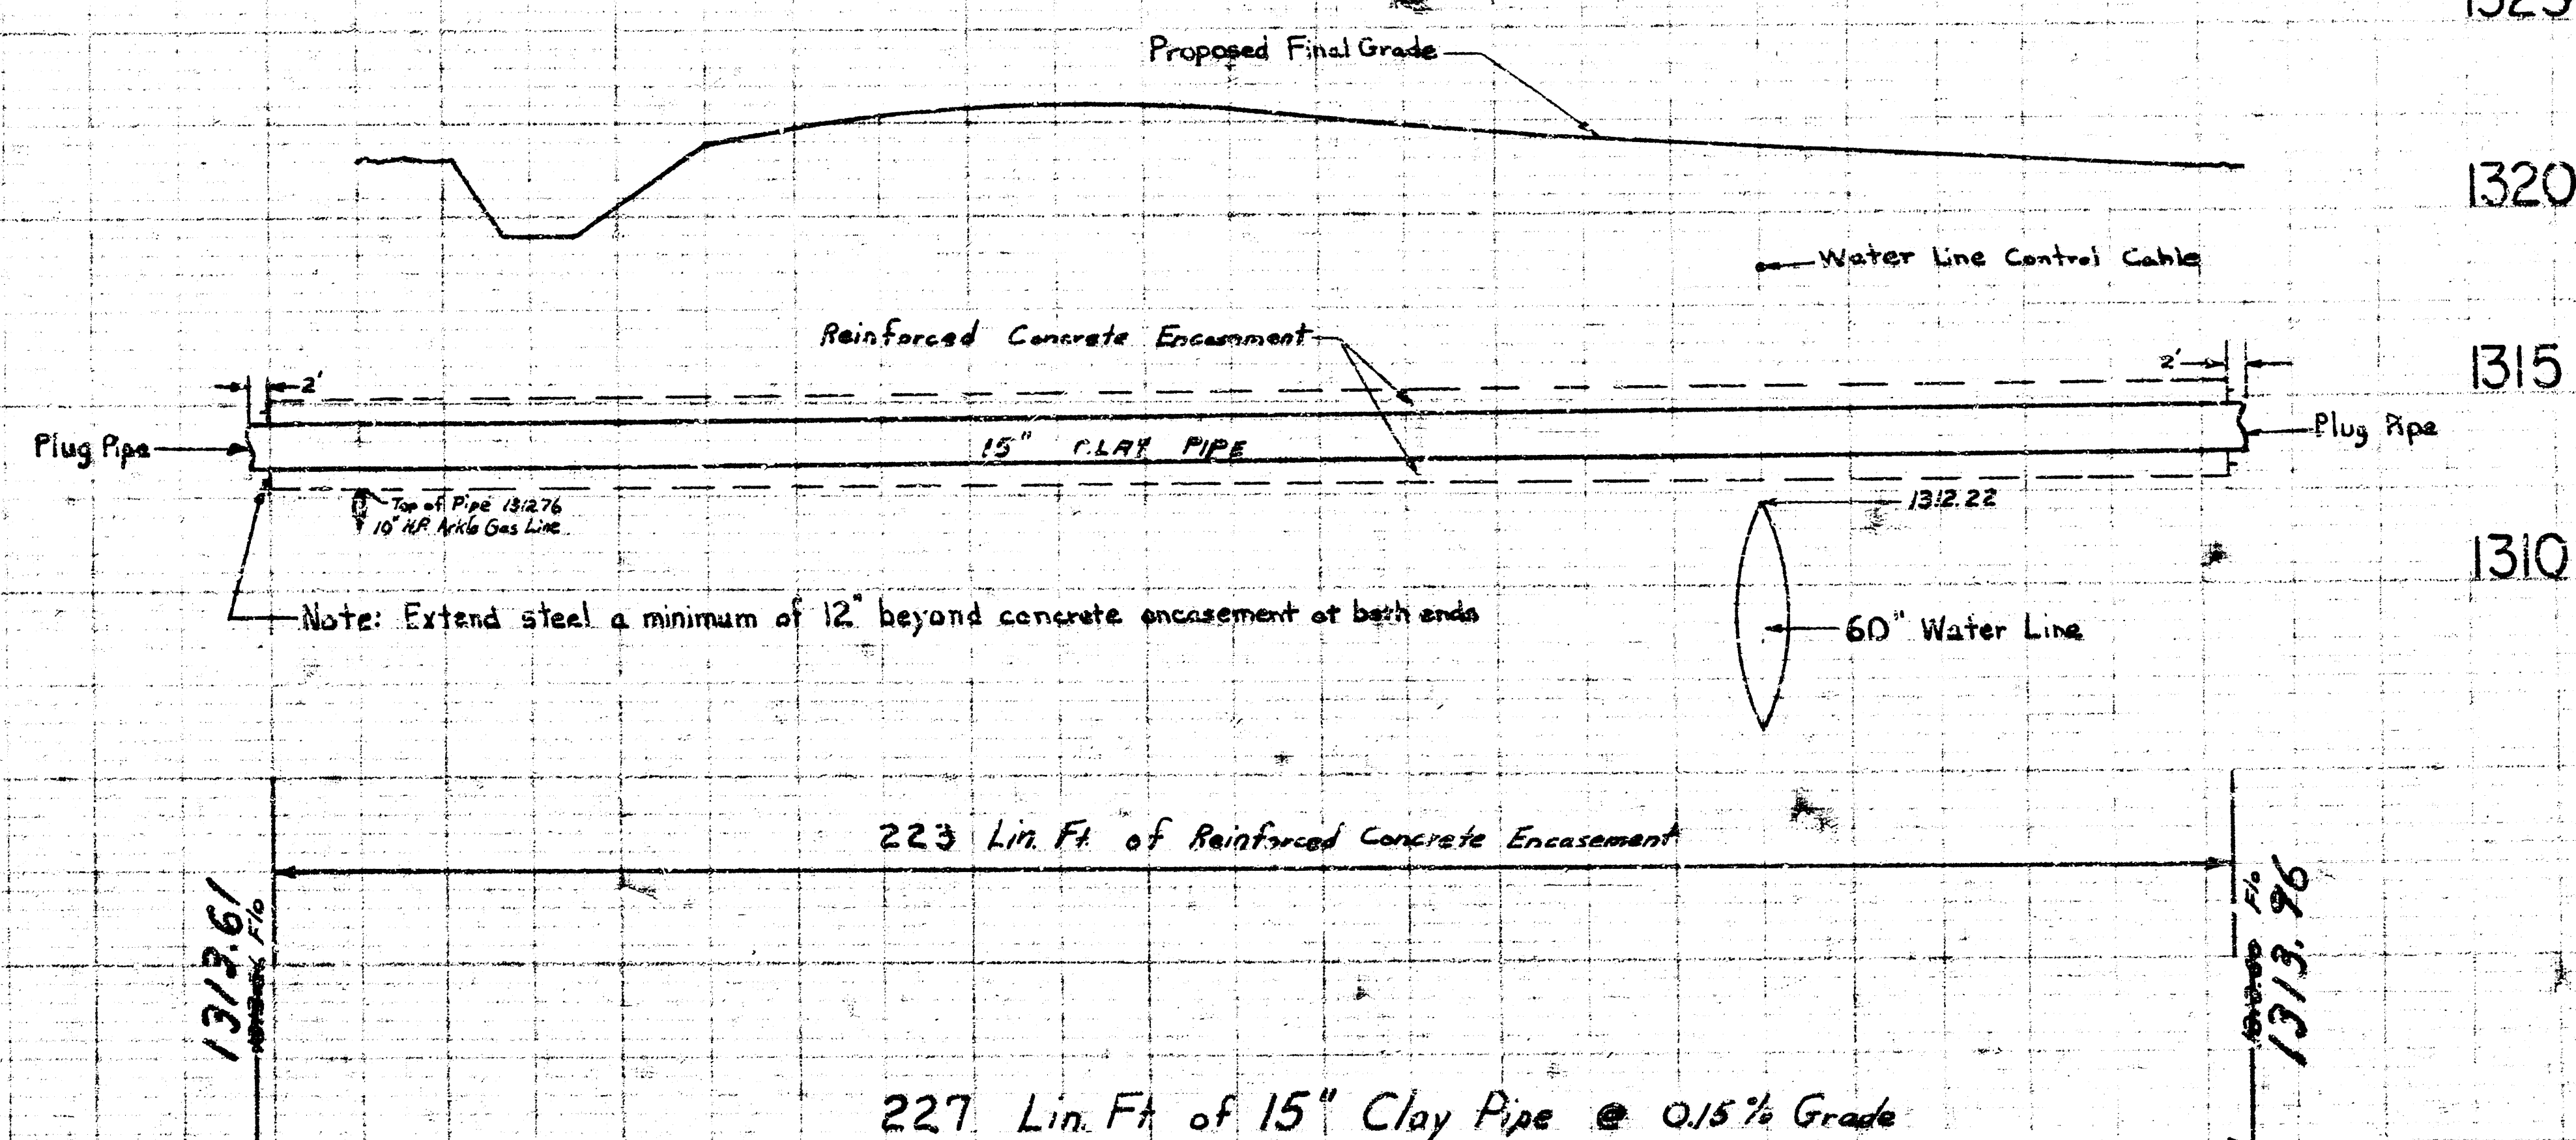

SANITARY SEWER CROSSING
TWENTY FIRST STREET
NORTH OF SEDGWICK CO.
ZOO

PRIVATE PROJECT DBKW705057