



• WILLIAM A. RALSTON W. R. CARLISLE • CIVIL ENGINEER •

SENECA VILLAGE TOWNHOUSES
 MULTI-FAMILY HOUSING PROJECT
 ELIZABETH AND MAY STREETS, WICHITA, KANSAS
 KANSAS CITY, MISSOURI

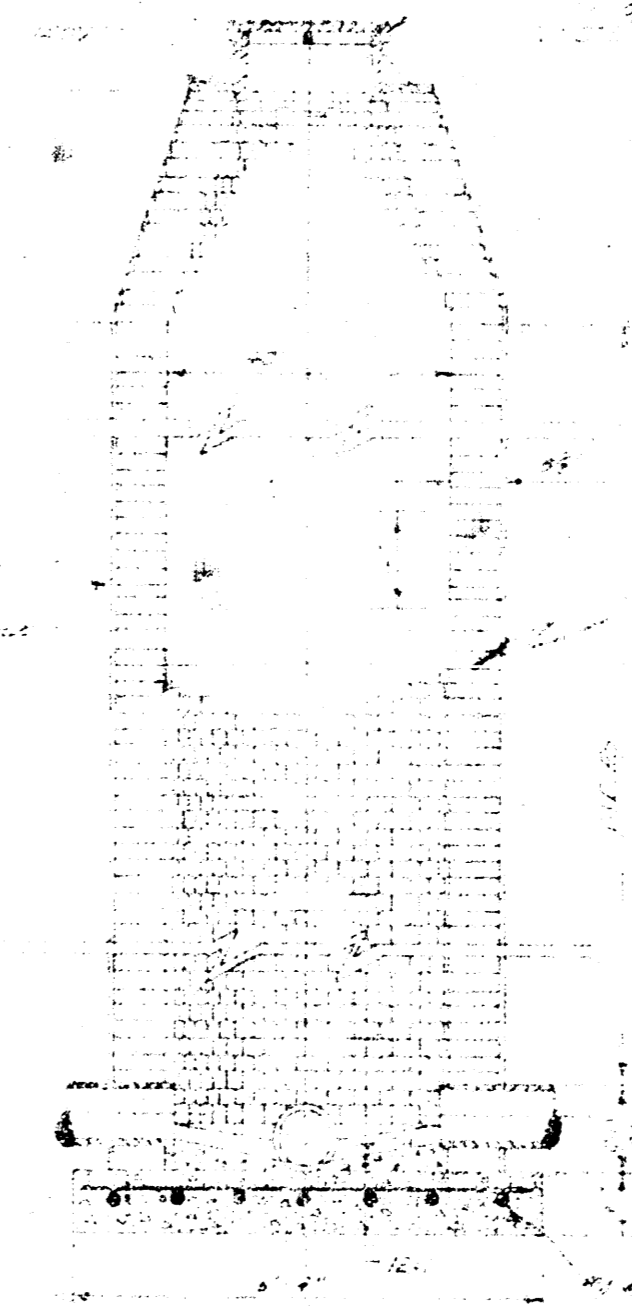

PRIVATE PROJ. # AALB500051

SHEET NUMBER
 6
 OF TWENTY SHEETS

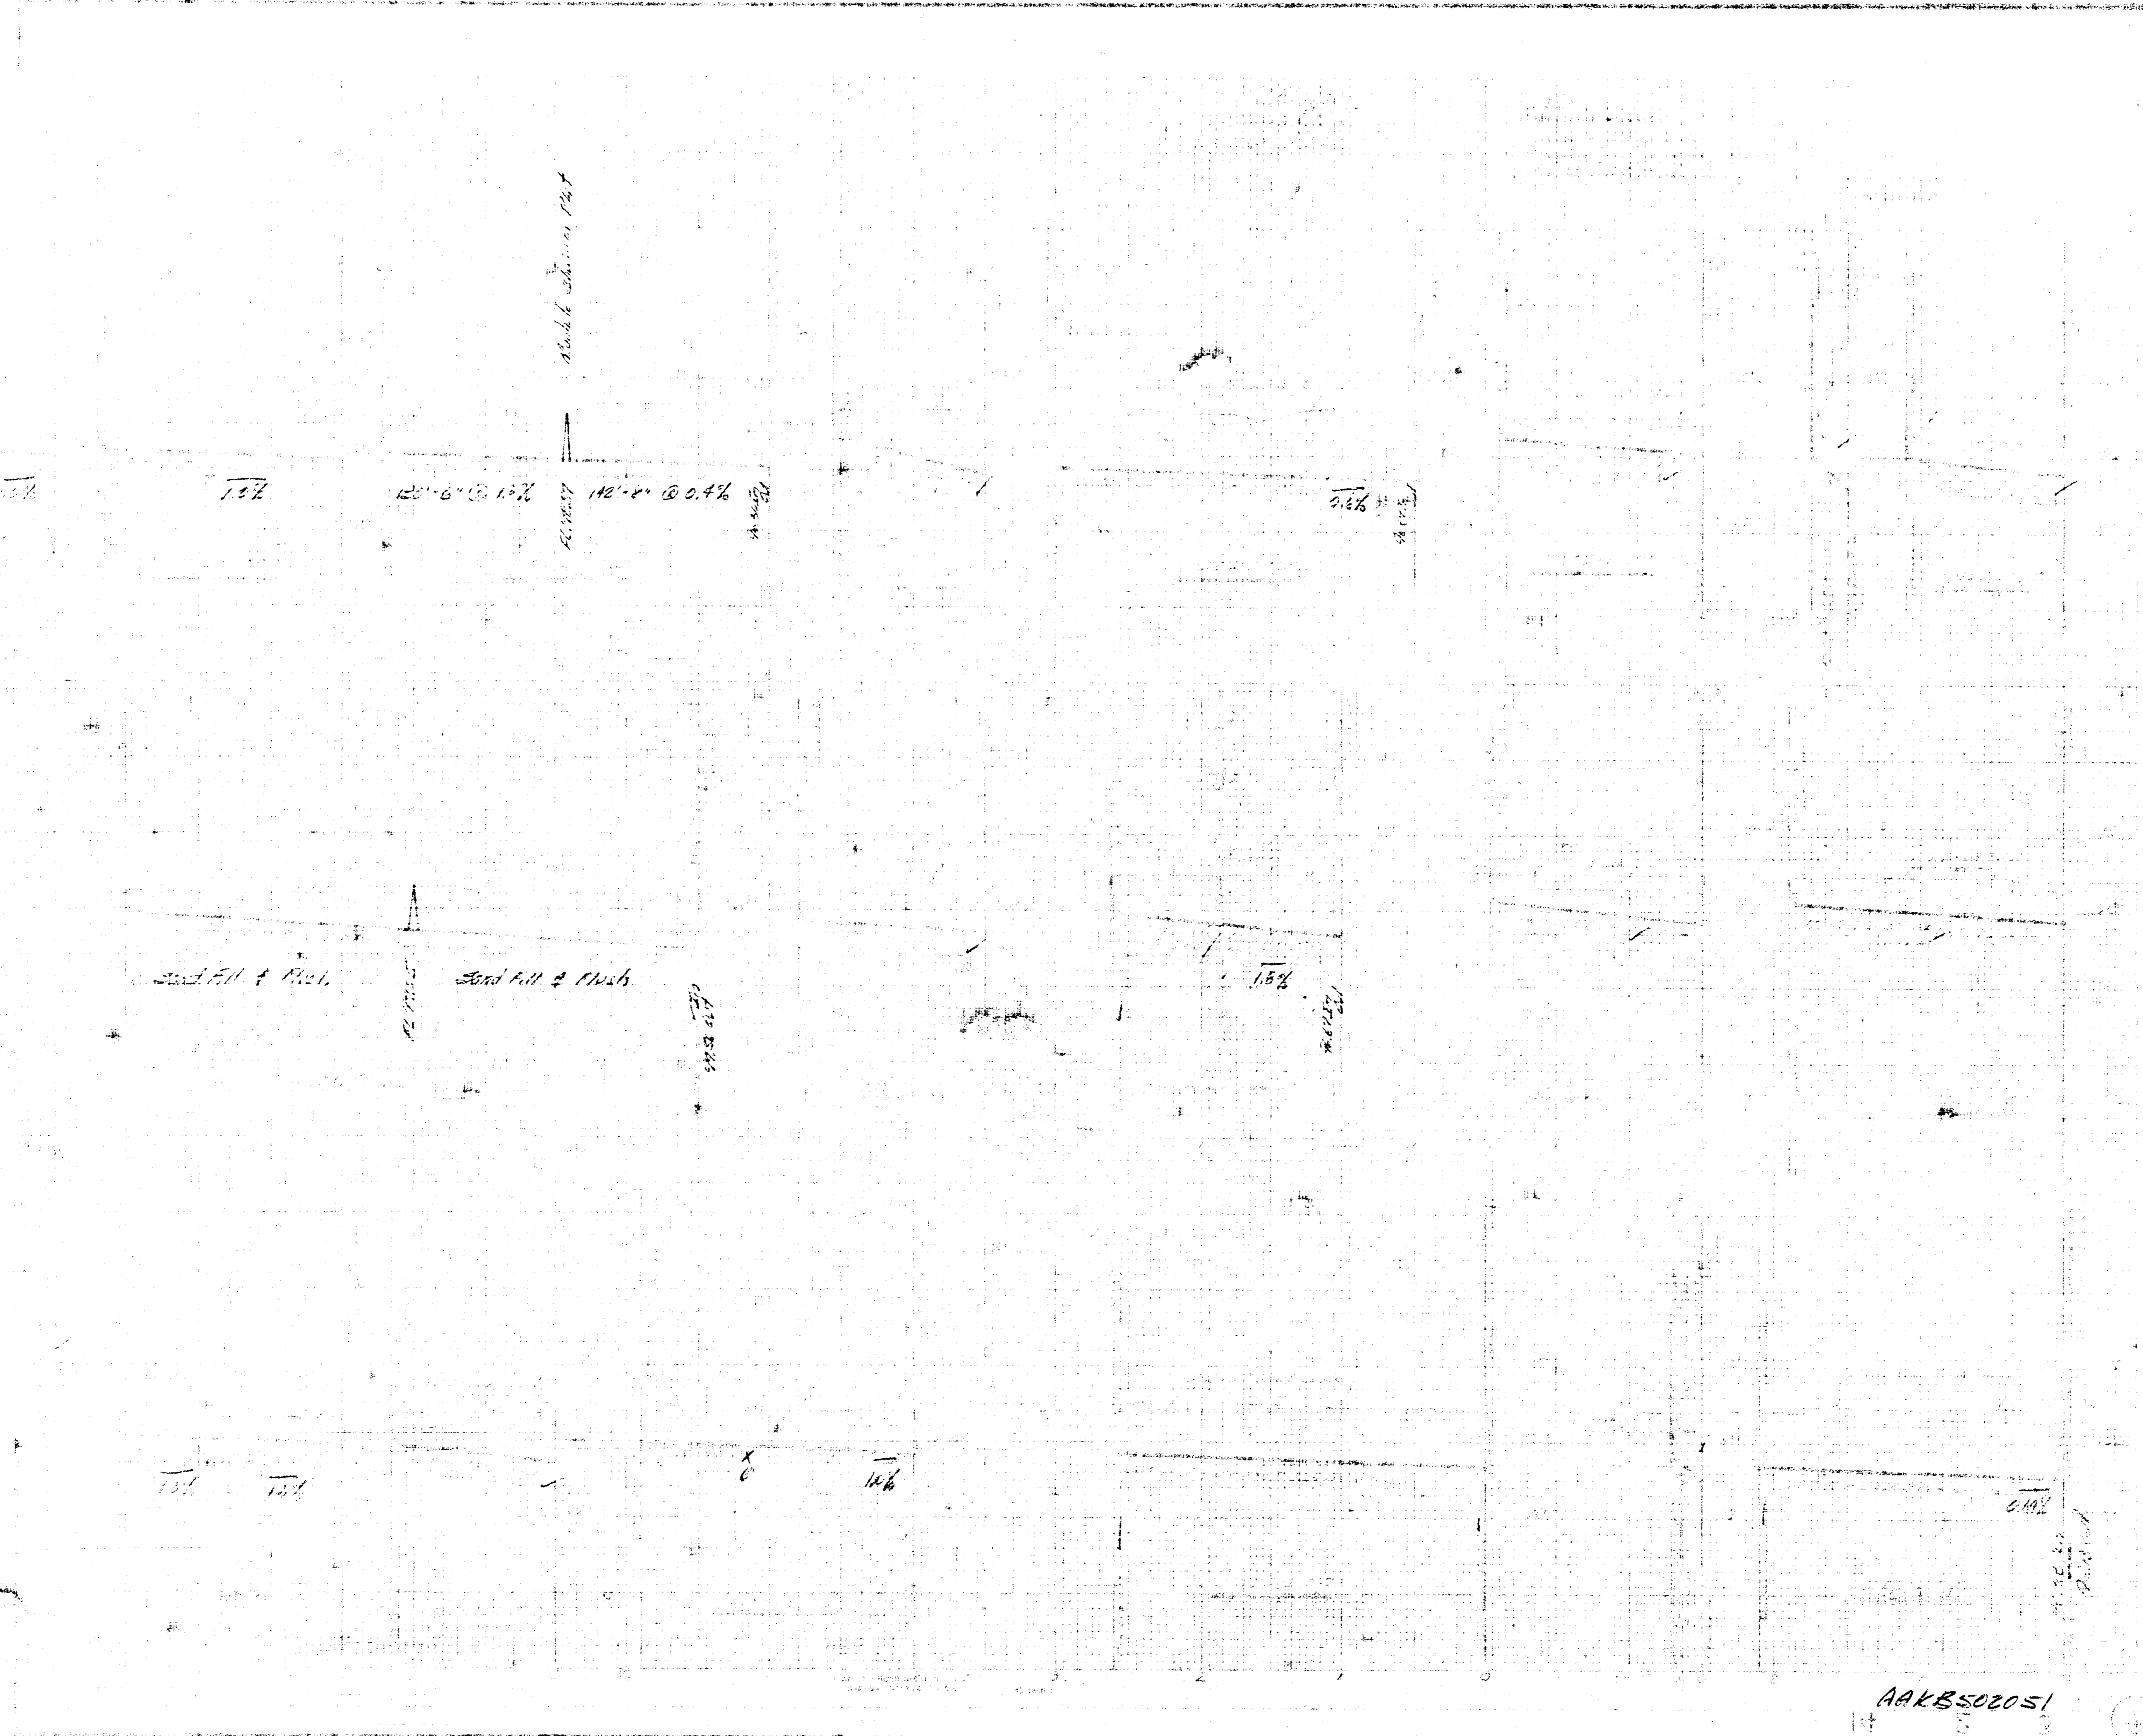

AAKBS02051

WILLIAM A. RAISTON W. R. CARLISE - CIVIL ENGINEER

SENECA VILLAGE TOWNHOUSES
 17 UNIT CO-OP MULTI-FAMILY HOUSING PROJECT
 LIEBLEY AND MAY STREETS, WICHITA, KANSAS
 WICHITA, KANSAS