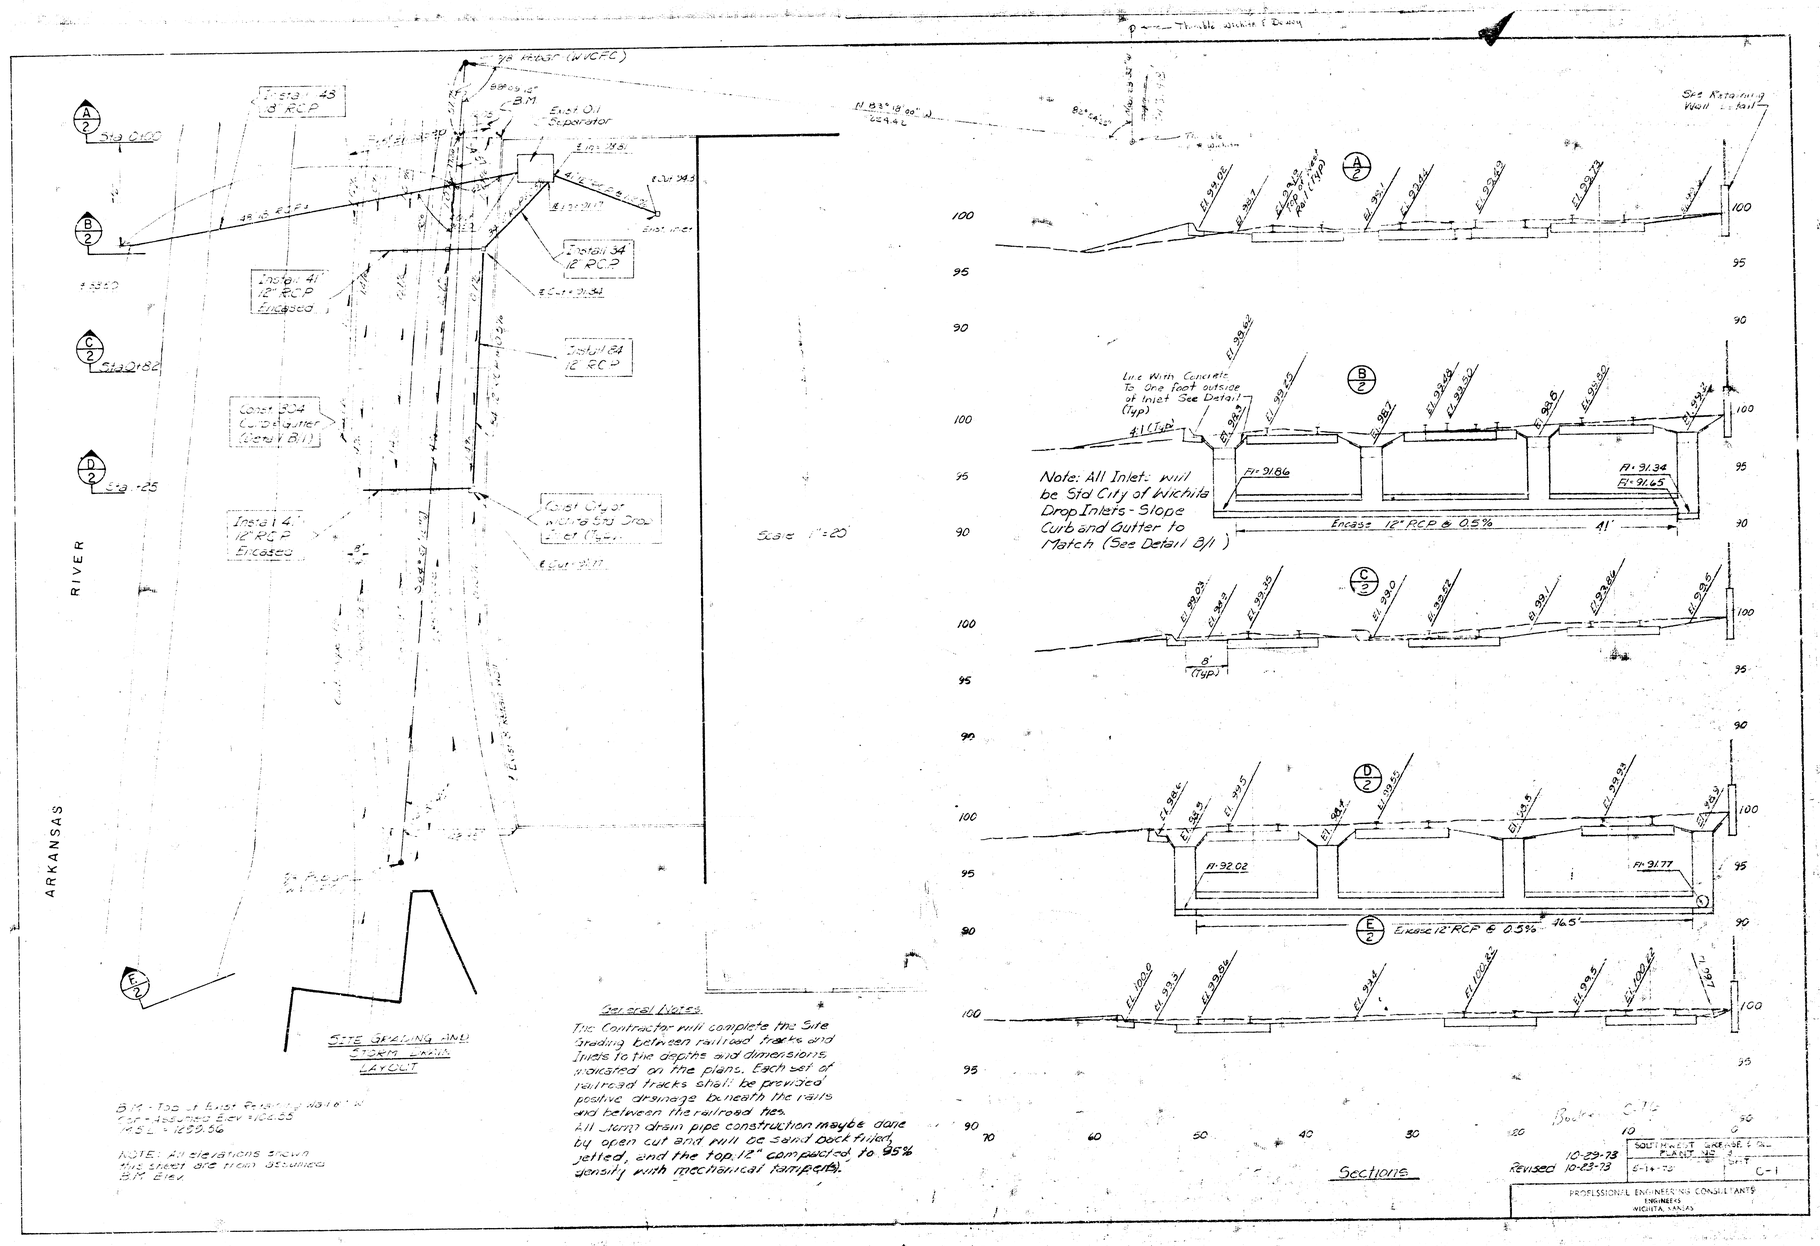
Sta 0+00
Install 48' 8" RCP
Install 41' 12" RCP Encased
Install 34' 12" RCP
Install 64' 12" RCP
Install 41' 12" RCP Encased
Install City of Wichita Std Drop Inlet (Typ.)
Exist. Oil Separator

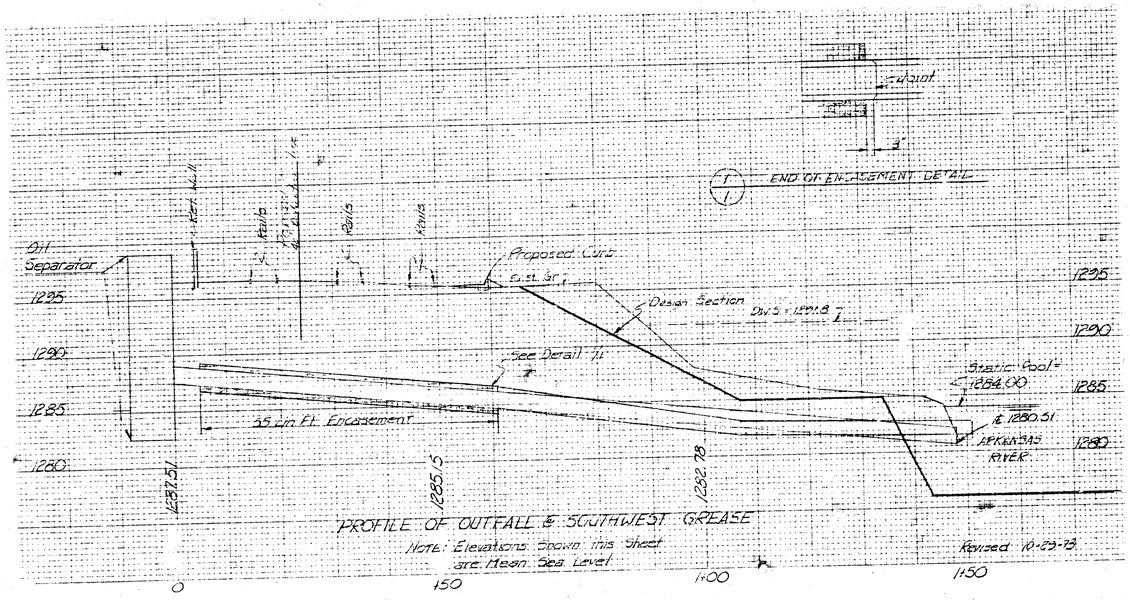

COPIES TO:

TO:

ATTN:

PROJECT:

DATE: Oct. 29, 1973

FROM:

REFERENCE:

PLEASE ADVISE IMMEDIATELY IF ANY MISCONCEPTIONS OR EXCEPTIONS YOU TAKE TO THE CONTAINED HEREIN.

Enclosed are Plan Sheets C-1 and C-2 and a Request for Contract 5 Revisions Sheets and Bid Sec.

APPROVED AS NOTED
N. SUPERINTENDENT OF WORKS

Submit As built Plans

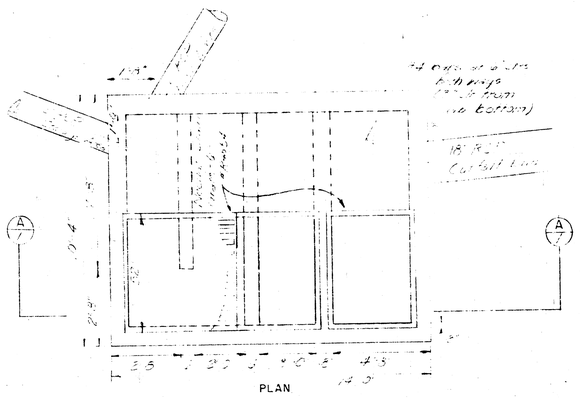

PLAN

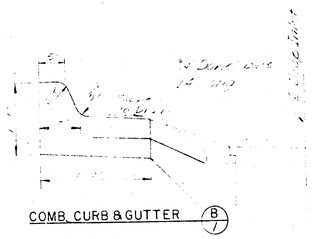

COMB. CURB & GUTTER (B/1)

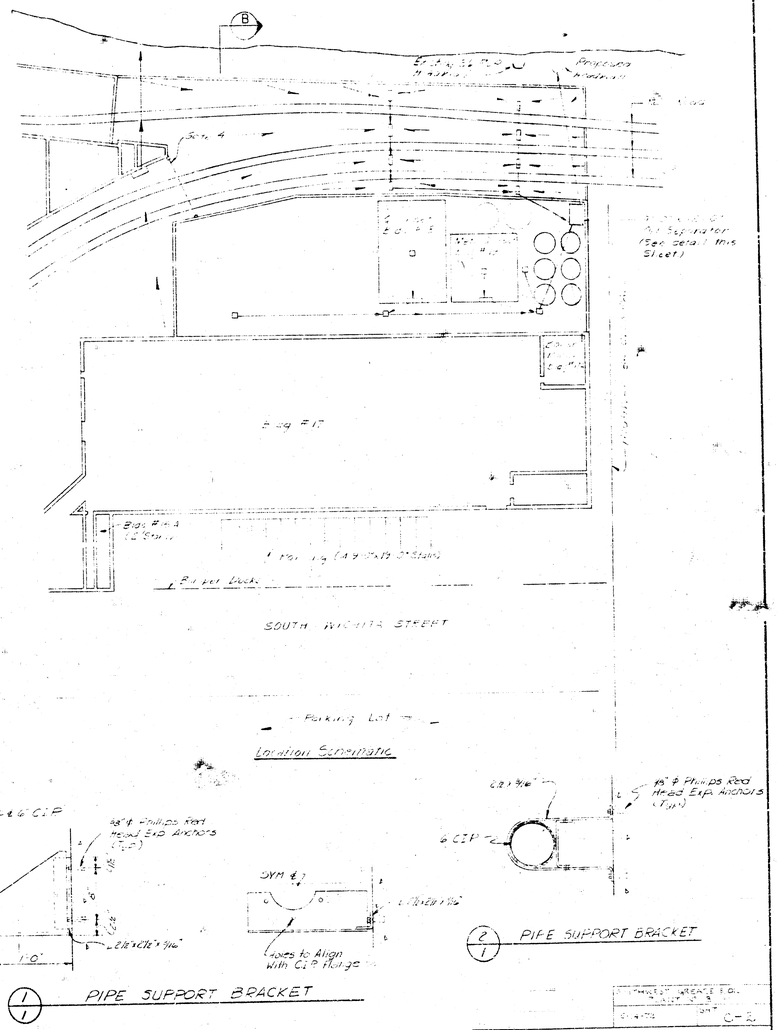

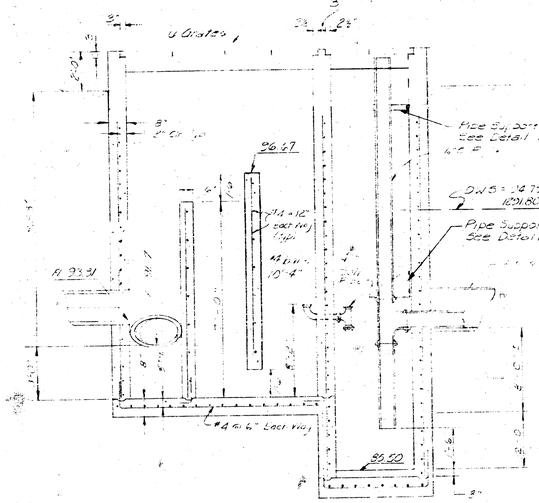

SECTION

OIL SEPARATOR (4/1)

M.C.P. Concrete Encasement

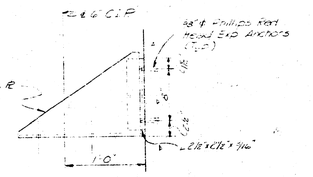

(1/1) PIPE SUPPORT BRACKET

(2/1) PIPE SUPPORT BRACKET

Revised 10-12-78
 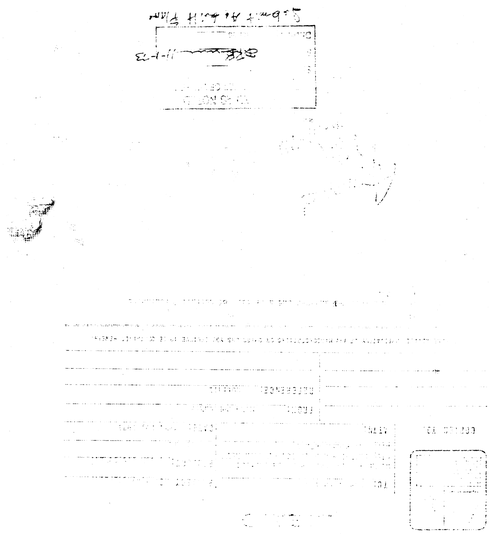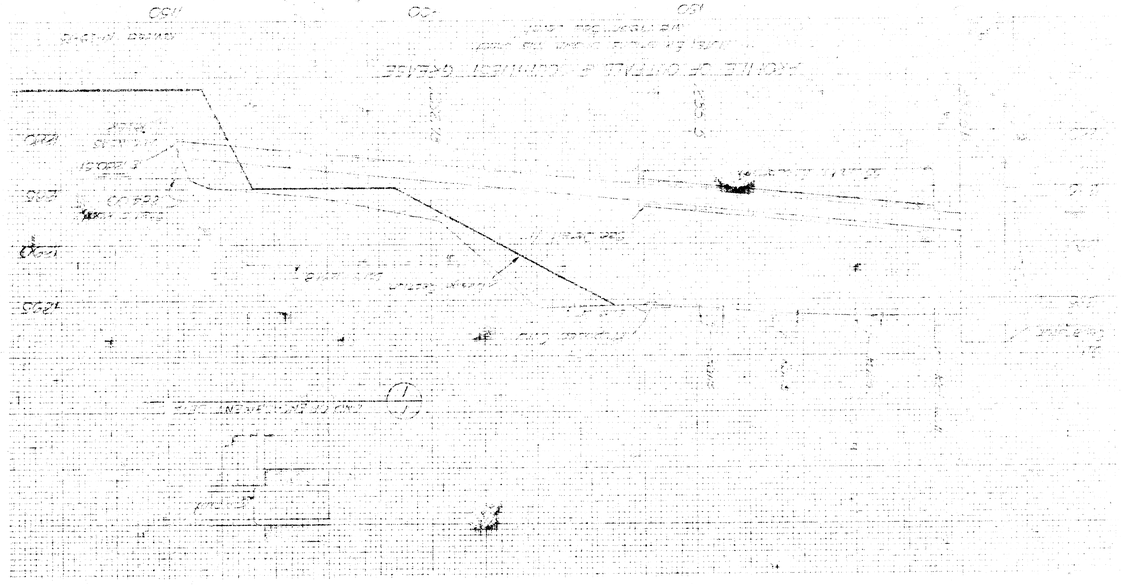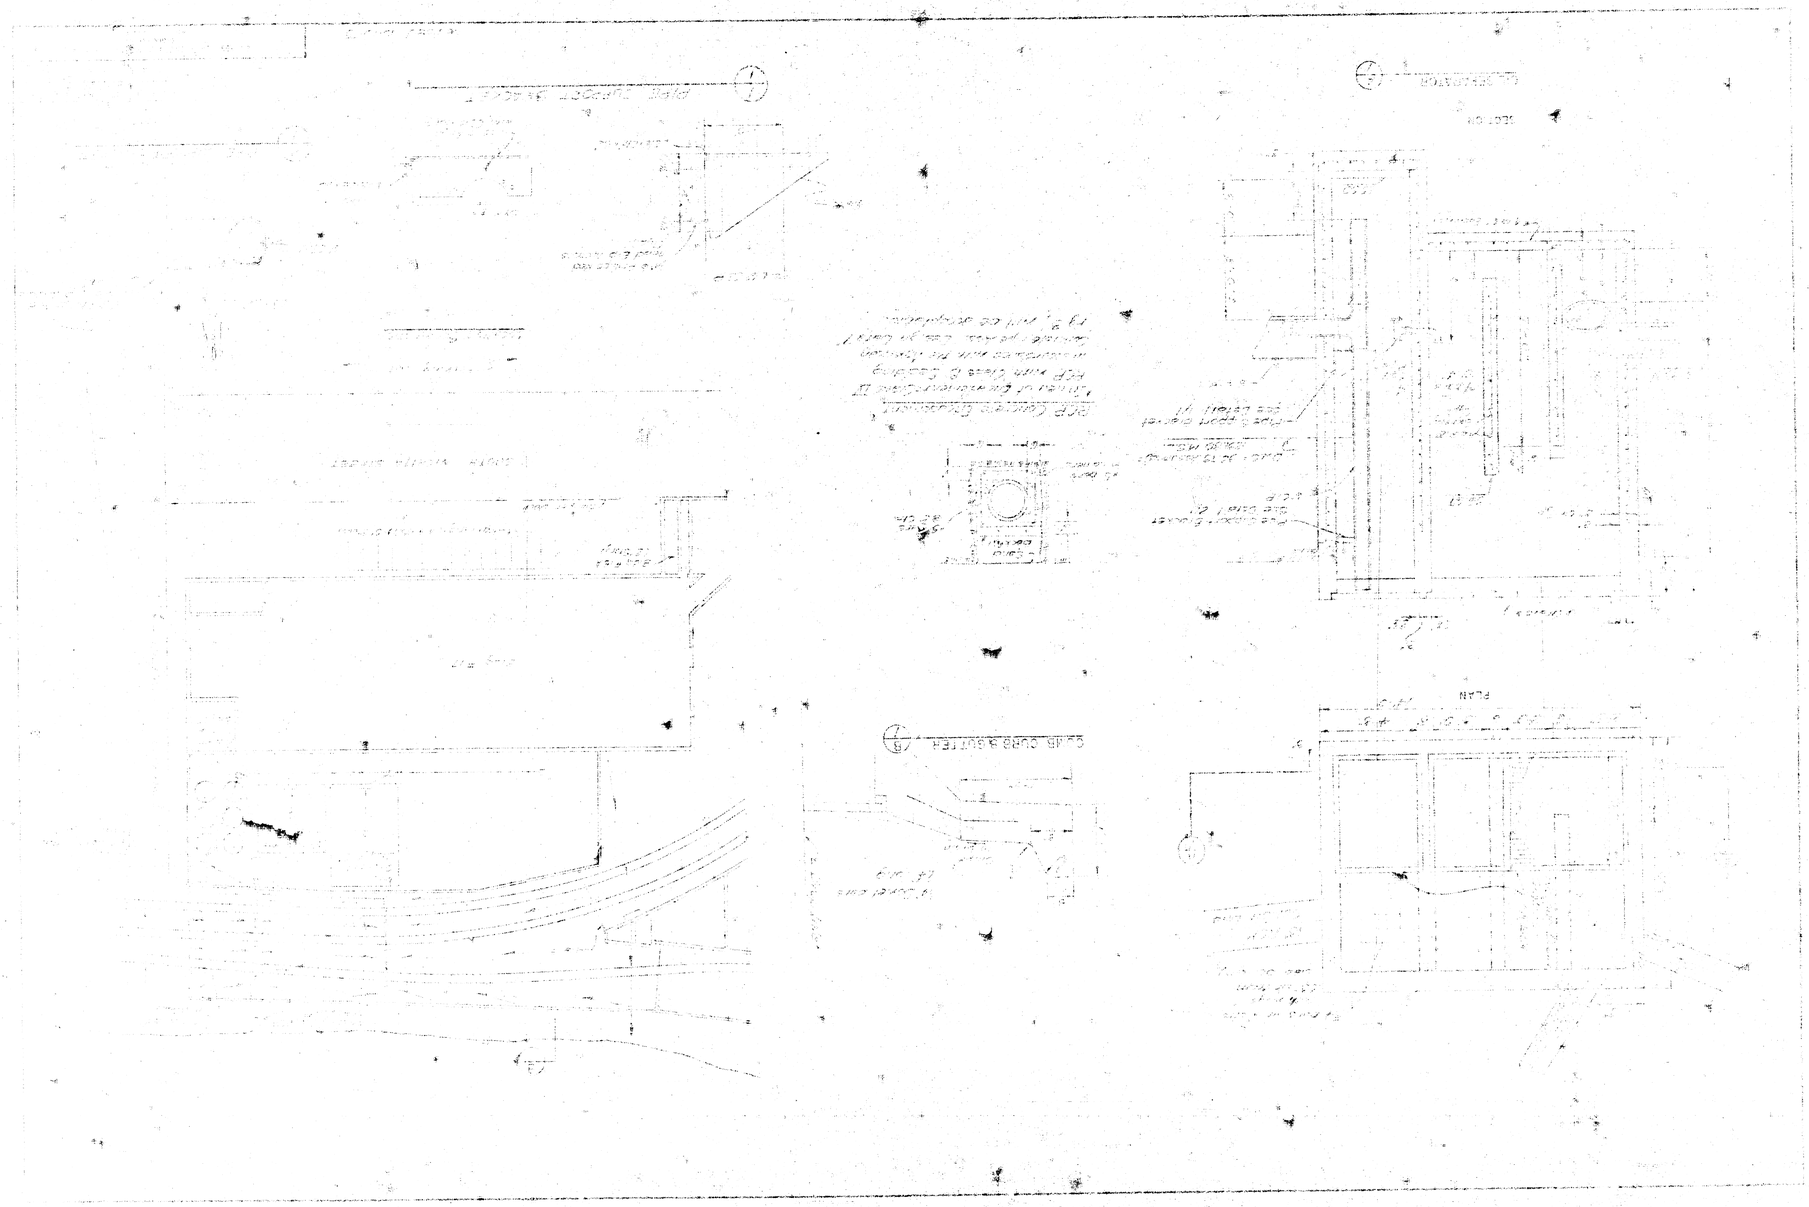
PROFESSIONAL ENGINEERING CONSULTANTS
ENGINEERS
WICHITA, KANSAS