


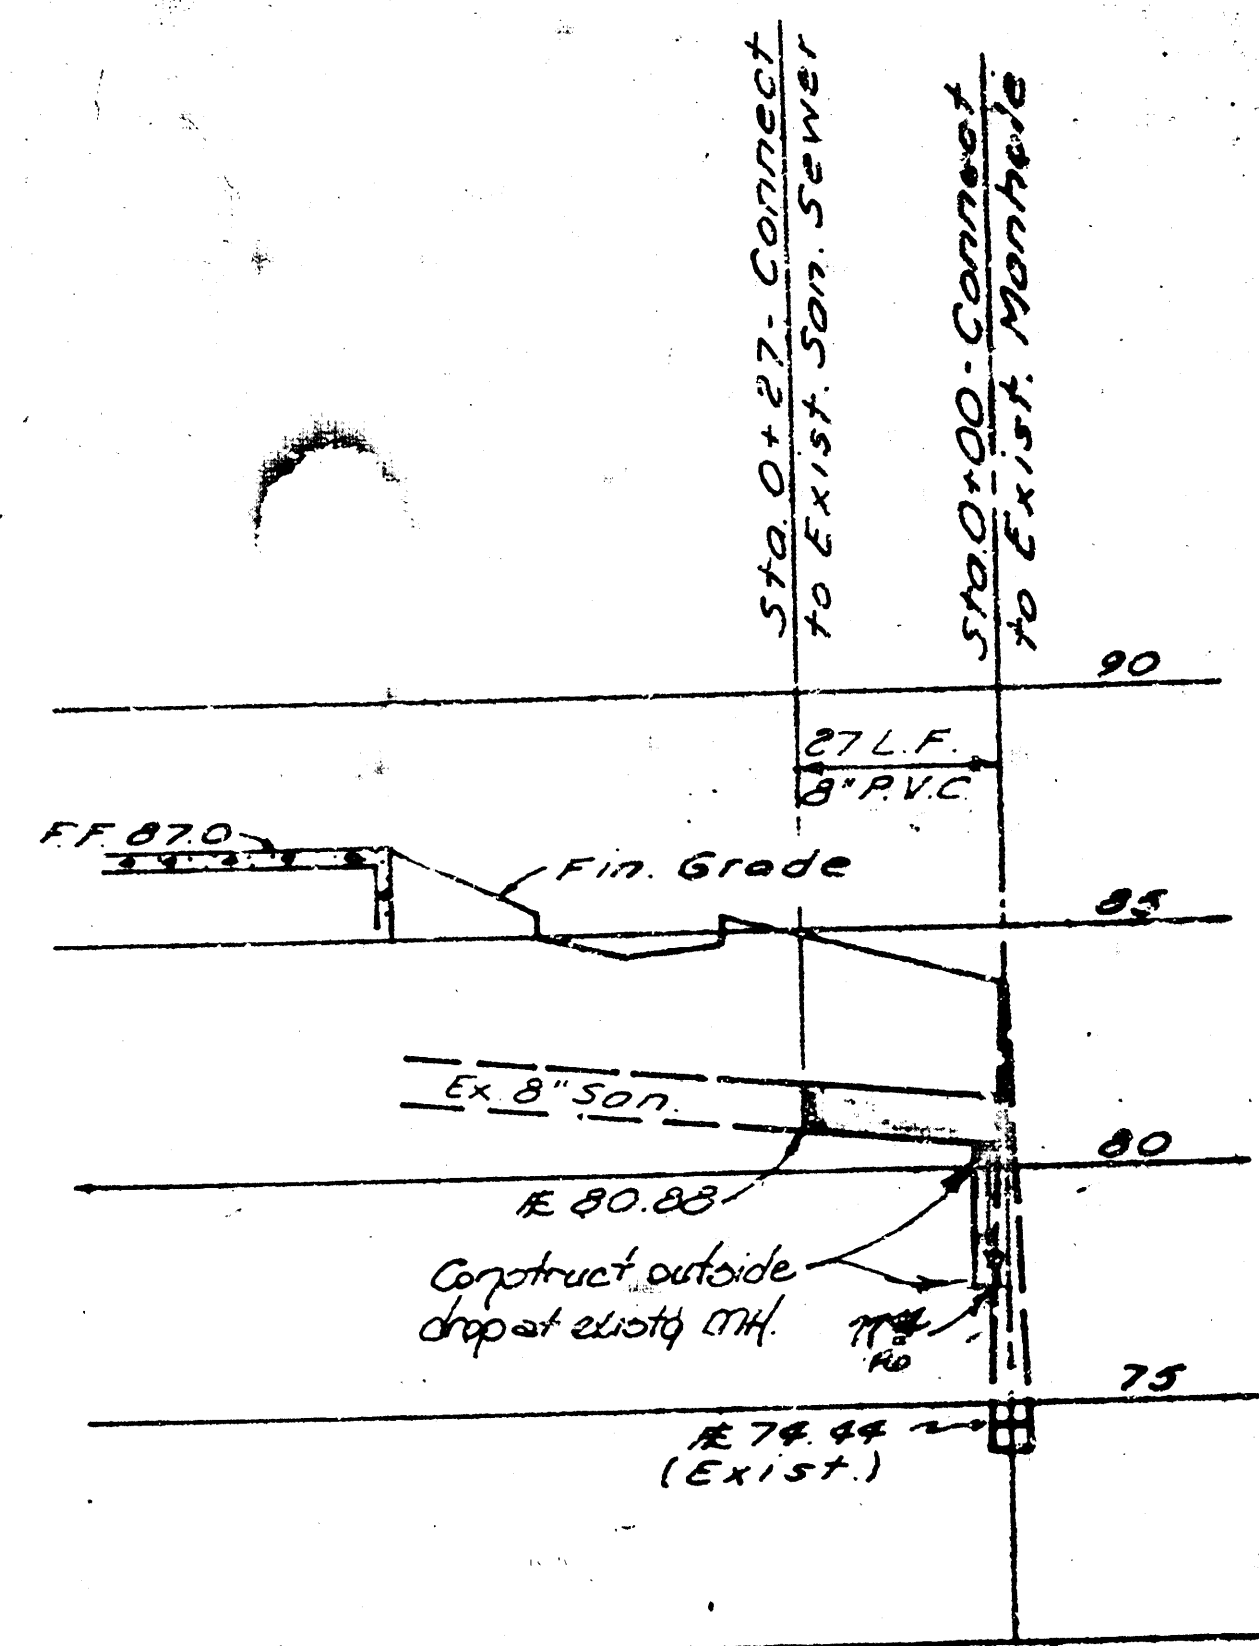

**SANITARY SEWER PROFILE**

**GENERAL NOTES**

Construction within 5' of the building shall be in compliance with the City Plumbing Code and will be inspected by Central Inspection. Televising and air testing will not be required.

APPROVED AS NOTED  
By CITY ENGINEER OF WICHITA  
Sanitary Sewers, *4/2/85*  
Storm Sewers  
Driveway Approaches

**NOTE TO CONTRACTOR**

This project will be constructed under the supervision of the CITY ENGINEER and conforming to the SPECIFICATIONS of the CITY OF WICHITA. The CONTRACTOR will pay the City of Wichita for all costs of plan review, inspection and booking per contract.

DATE REVIEWED 10-25-85  
BY 1-4-86  
TO 1-25-86  
revisions  
4-29-85 REV  
SEWER  
date drawn

**J4**  
JEFF KREHBIEL  
ASSOCIATES, P.C.  
architecture planning

1300 West 10th St. WICHITA, KANSAS 67211  
(316) 264-0000


**TURNPIKE INN**  
47th STREET SOUTH and LAURA  
WICHITA, KANSAS

sheet 2 of 2  
SITE GRADING PLAN

sheet

**SG-1**

of 1 sheets

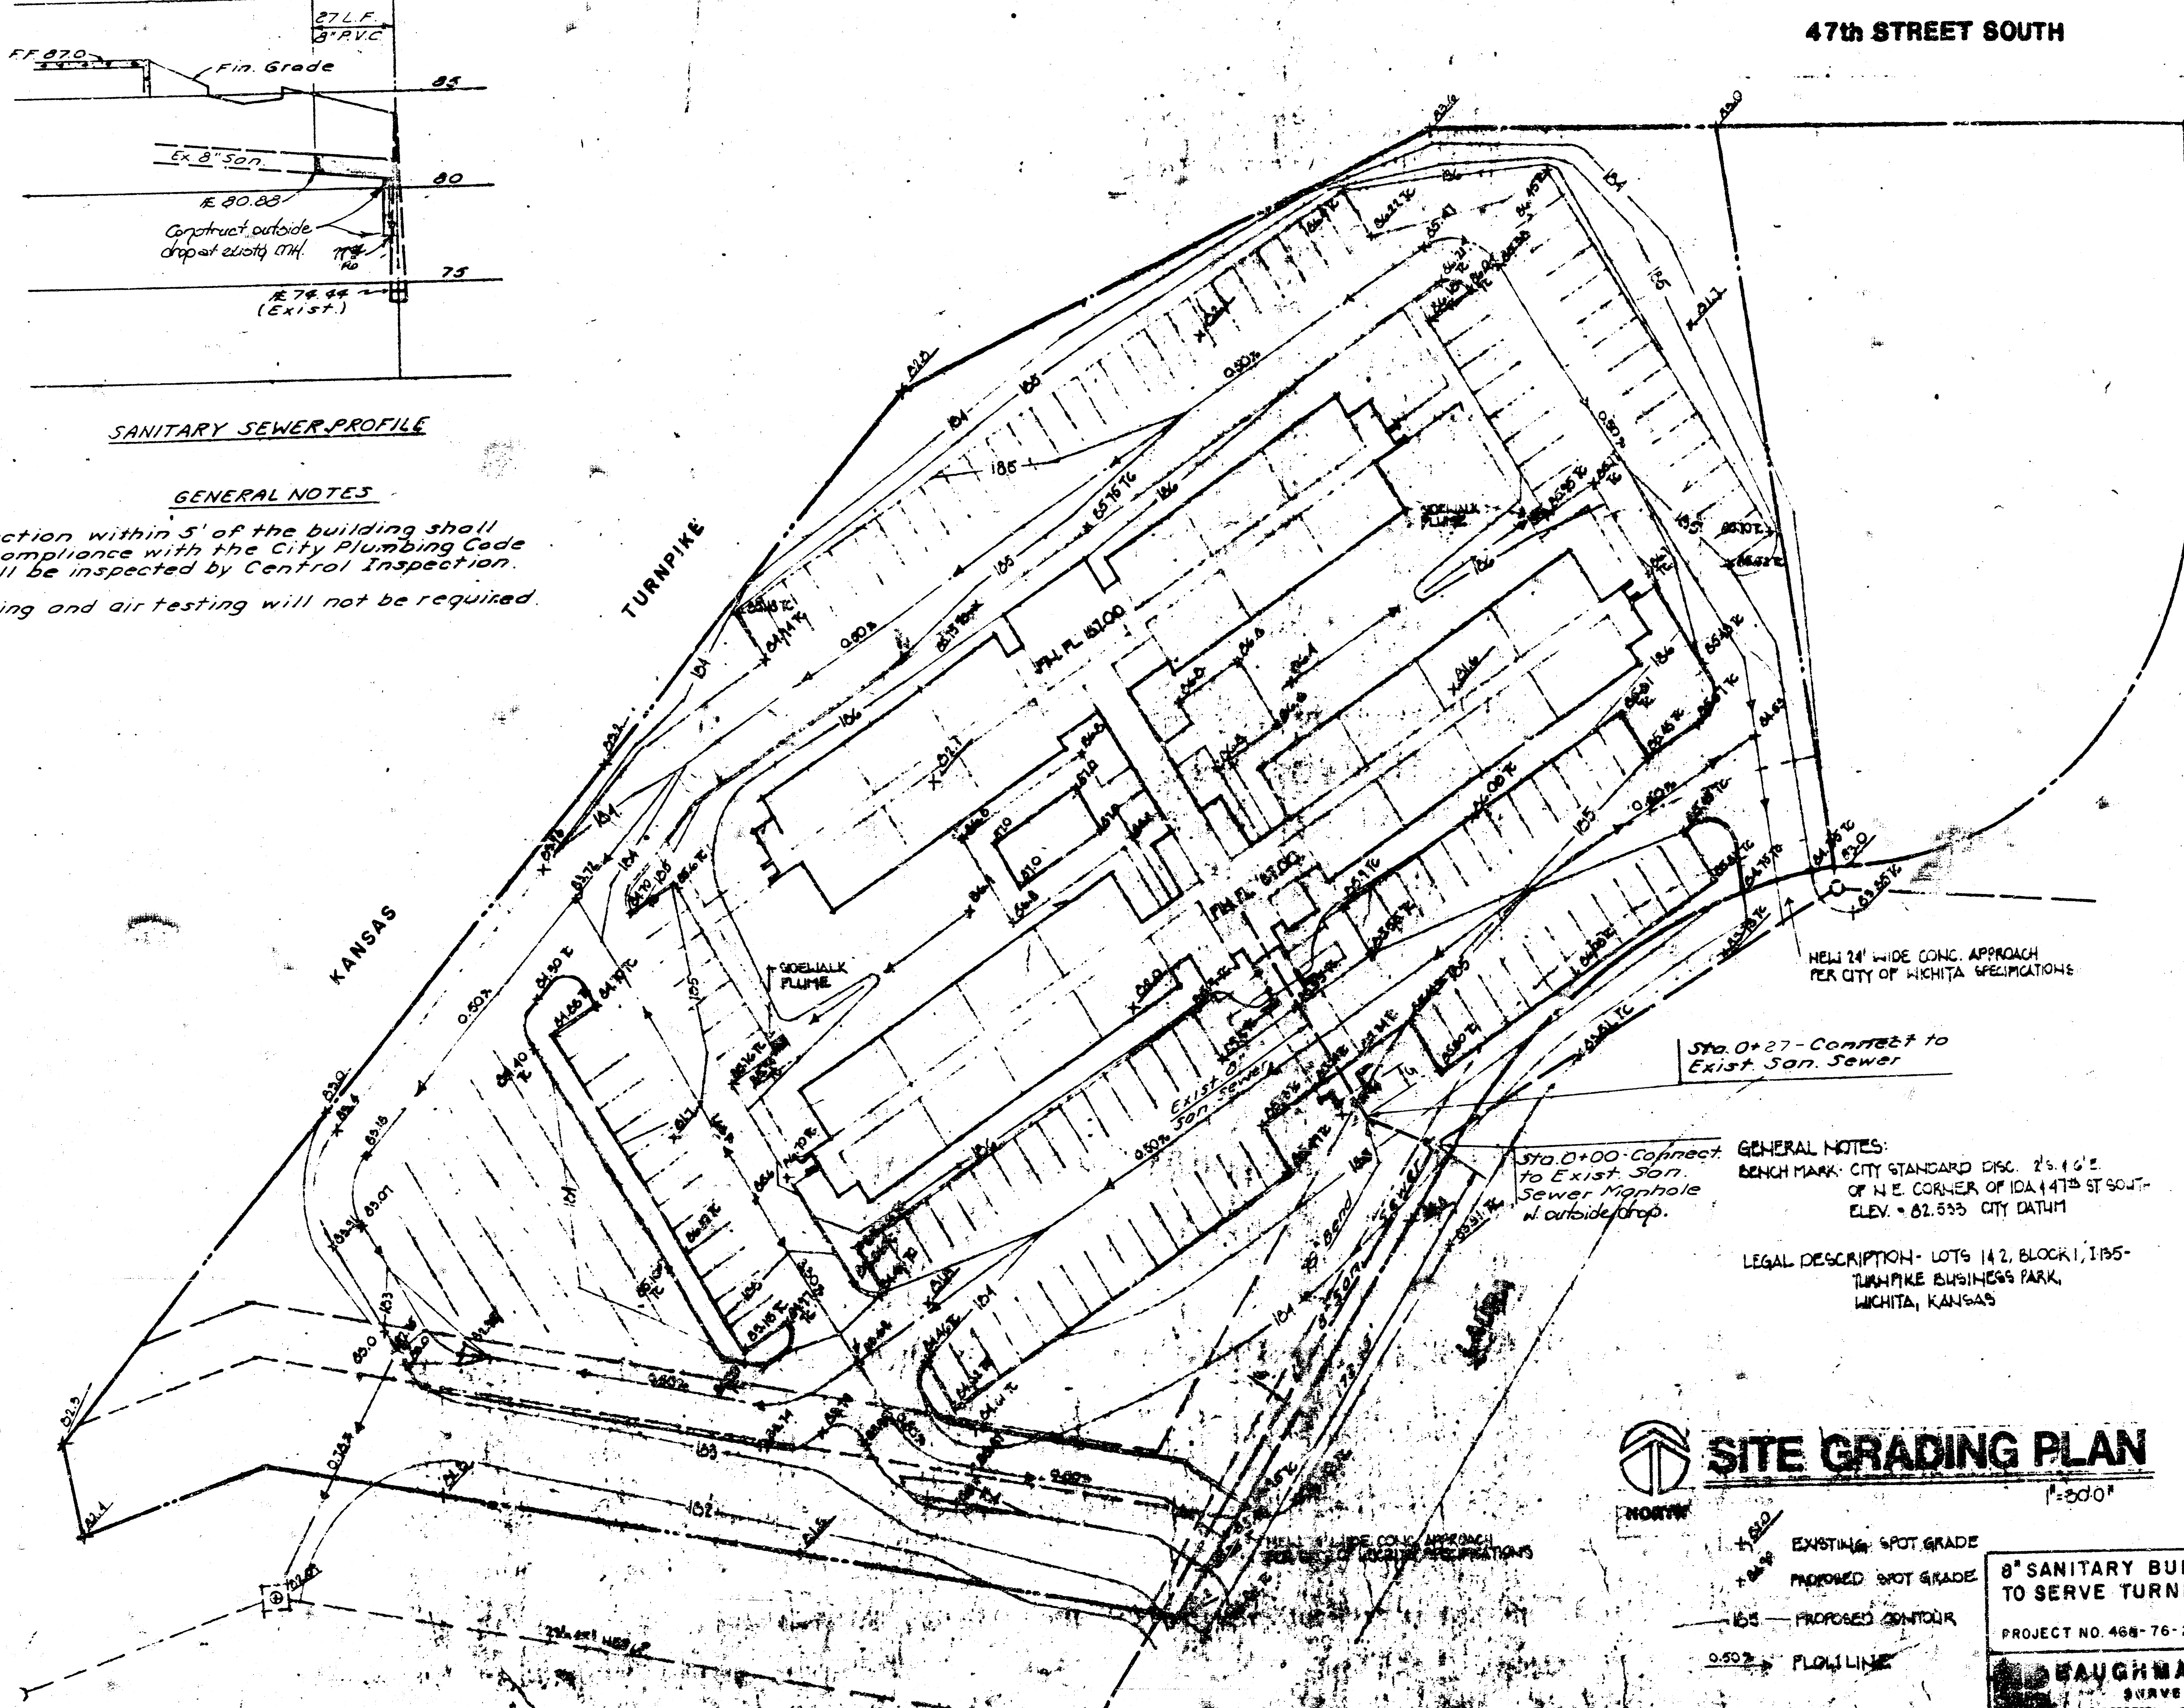

GENERAL NOTES:  
BENCH MARK: CITY STANDARD DISC 25.46' E  
OF N.E. CORNER OF 10A 14TH ST SOUTH  
ELEV. = 82.555 CITY DATUM  
LEGAL DESCRIPTION: LOTS 142, BLOCK 1, 1195-  
TURNPIKE BUSINESS PARK,  
WICHITA, KANSAS




**SITE GRADING PLAN**

- +8.00' EXISTING SPOT GRADE
- +8.00' PROPOSED SPOT GRADE
- 105' PROPOSED CONTOUR
- 0.50% FLOWLINE

8" SANITARY BUILDING SERVICE LINE  
TO SERVE TURNPIKE INN

PROJECT NO. 468-76-245-80001-OCO-000-016

**BAUGHMAN COMPANY, P.A.**  
SURVEYING & ENGINEERING  
1000 SOUTH 10TH ST. WICHITA, KANSAS 67211

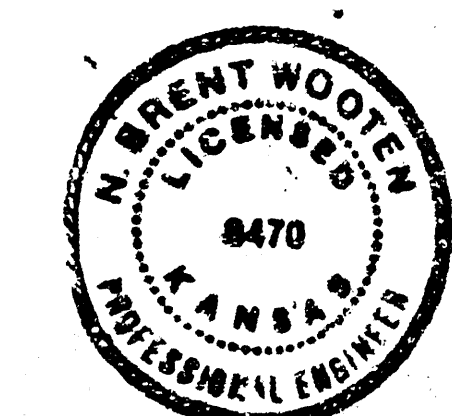

FILMED FROM THE BEST  
AVAILABLE COPY.....