

8" 146.98' cut in SE corner conc. slab on N.L. Central and approx. Central # Sta. 36+27 * Wide flanged ring required

Revised 12-20-79

SANITARY SEWER EXTENSIONS TO SERVE LOTS 2,3,4 BLOCK B, AND LOT 4 BLOCK C OF TY CEN ADDITION.

12-21-79

D. C. S.



CITY OF WICHITA PROJECT NO. 468-76-243-80889-000-000-008 A



PROFESSIONAL ENGINEERING CONSULTANTS, P.A.

ENGINEER
WICHITA, KANSAS


Designed by	Job No.	Sheet	of
Drawn by	Date		

S-8
1/2

FILMED FROM THE BEST AVAILABLE COPY

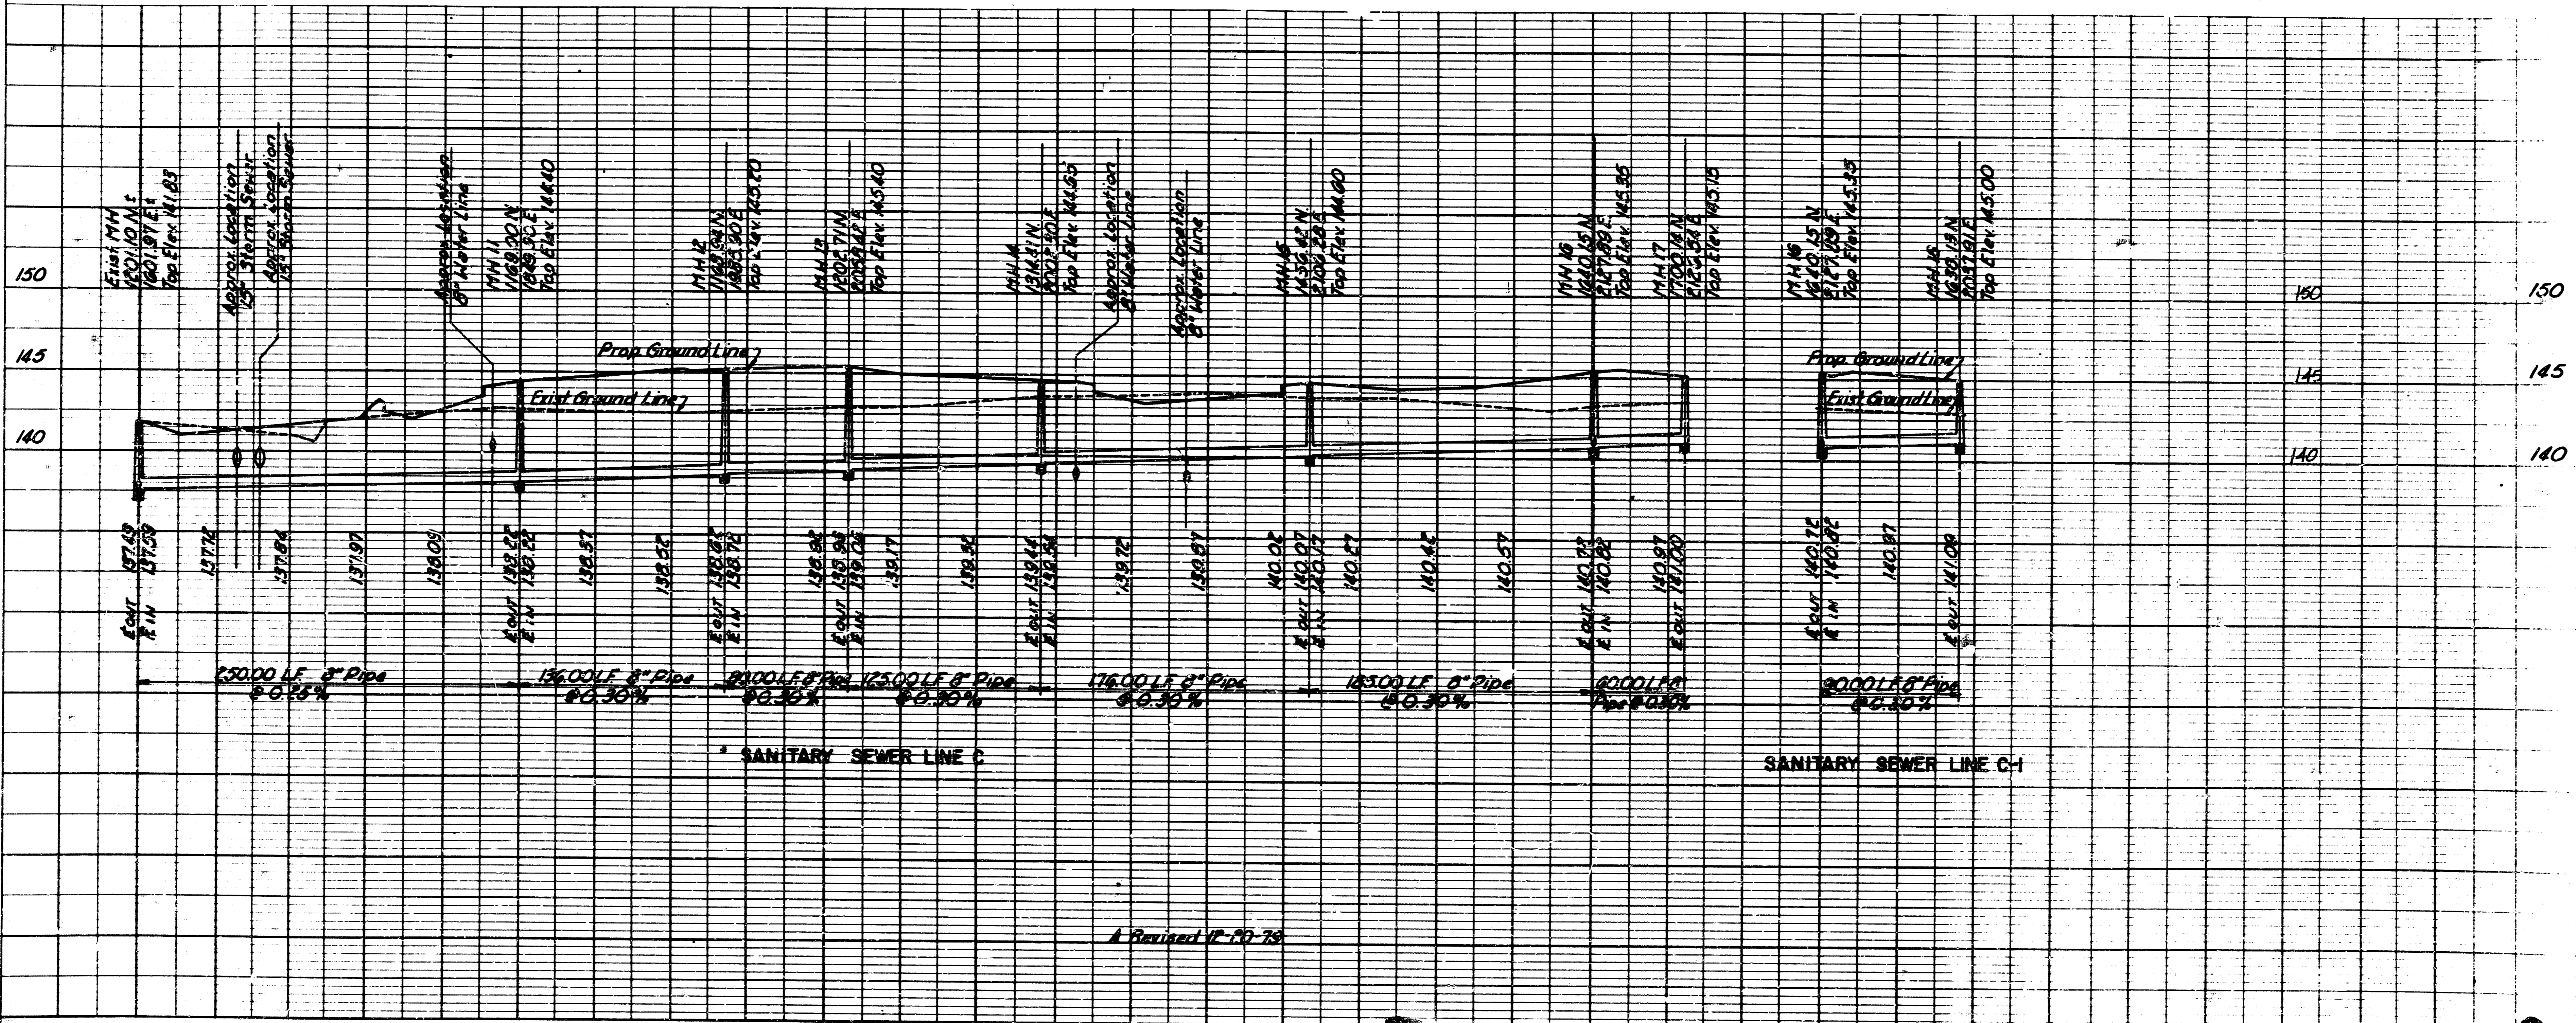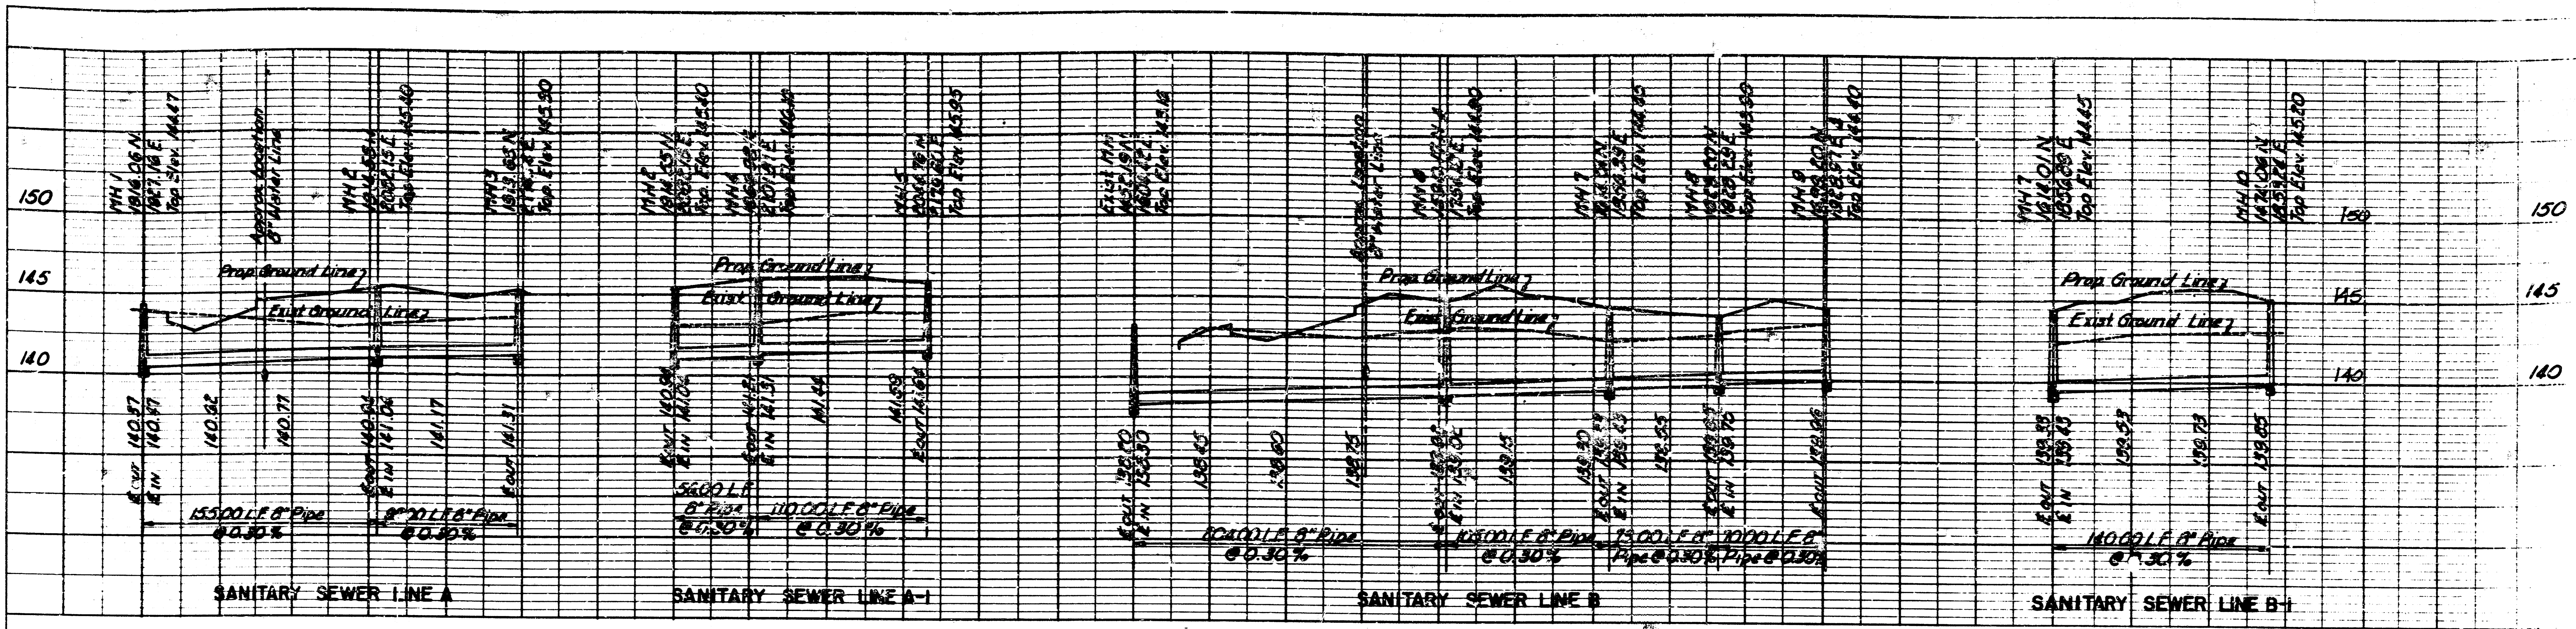

A Revised 12-10-78

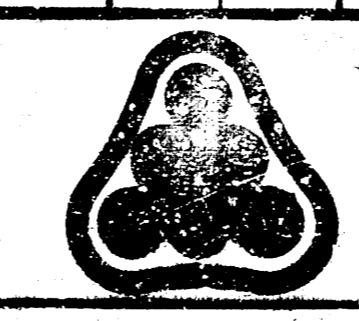

PROFESSIONAL ENGINEERING CONSULTANTS, P.A.
 ENGINEERS
 WICHITA, KANSAS
 Designed by _____ Job No. 20-70 555
 Drawn by _____ Date Dec 1978

FILMED FROM THE BEST AVAILABLE COPY.....