



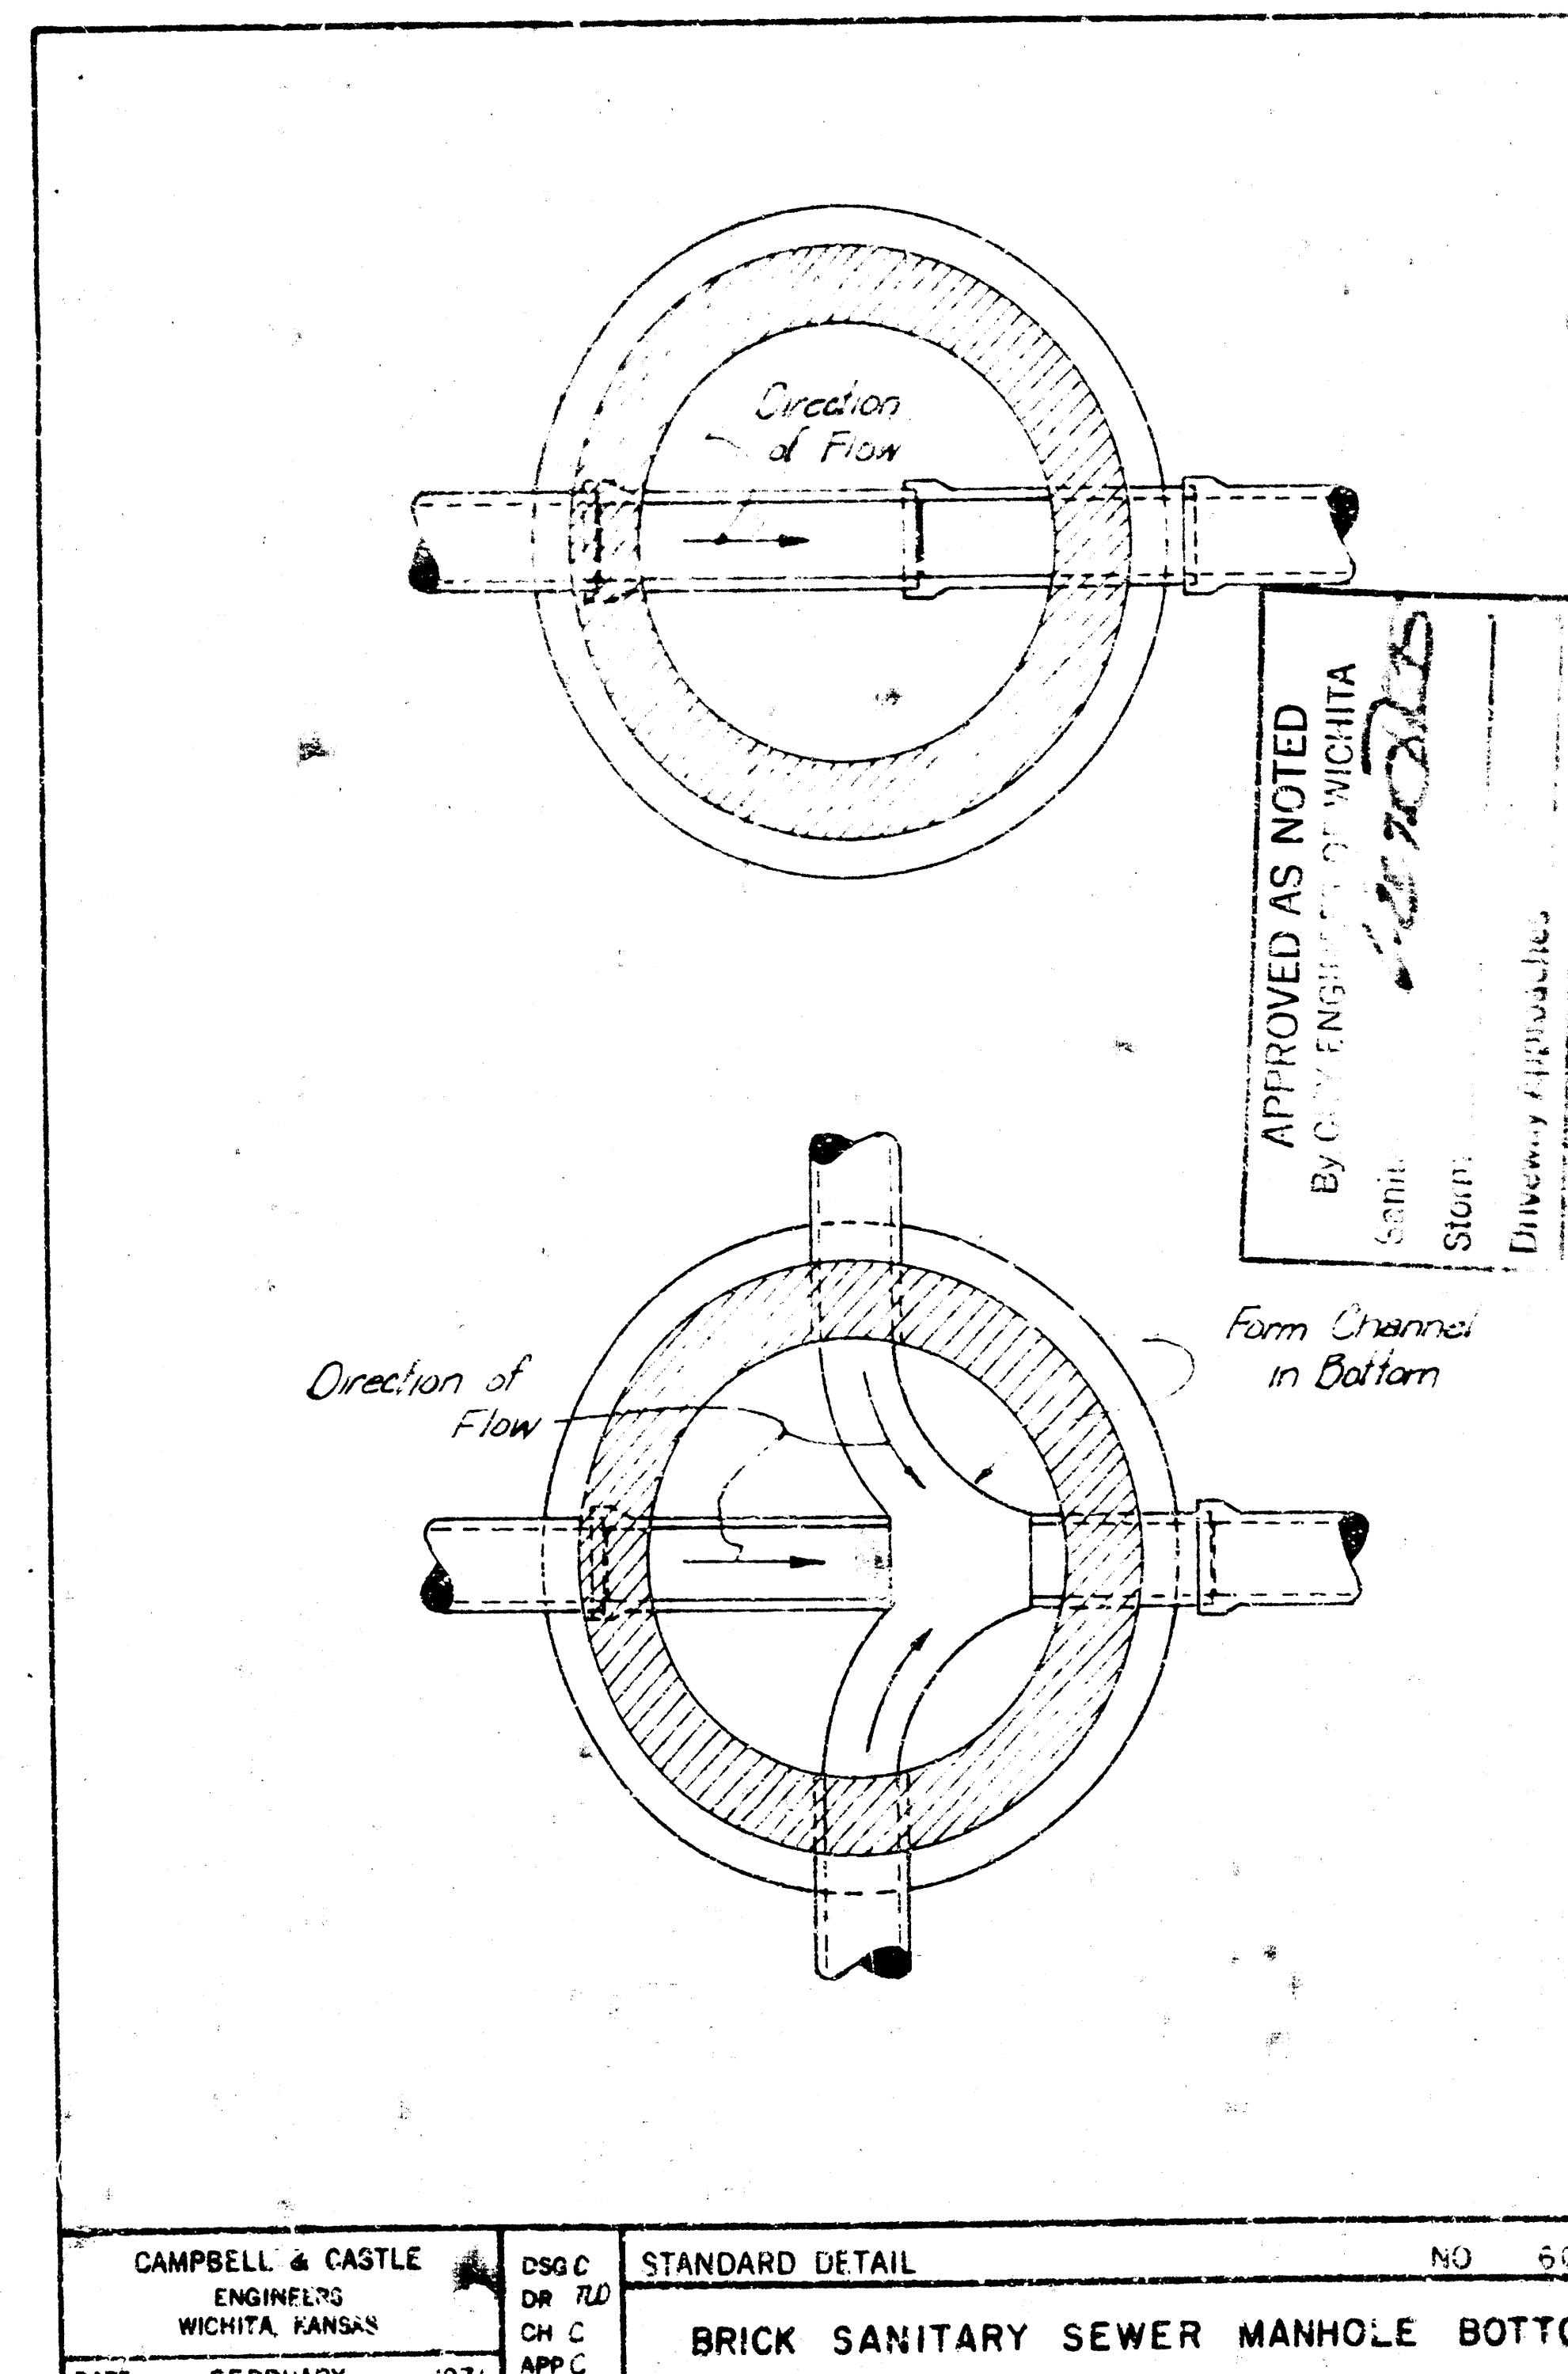
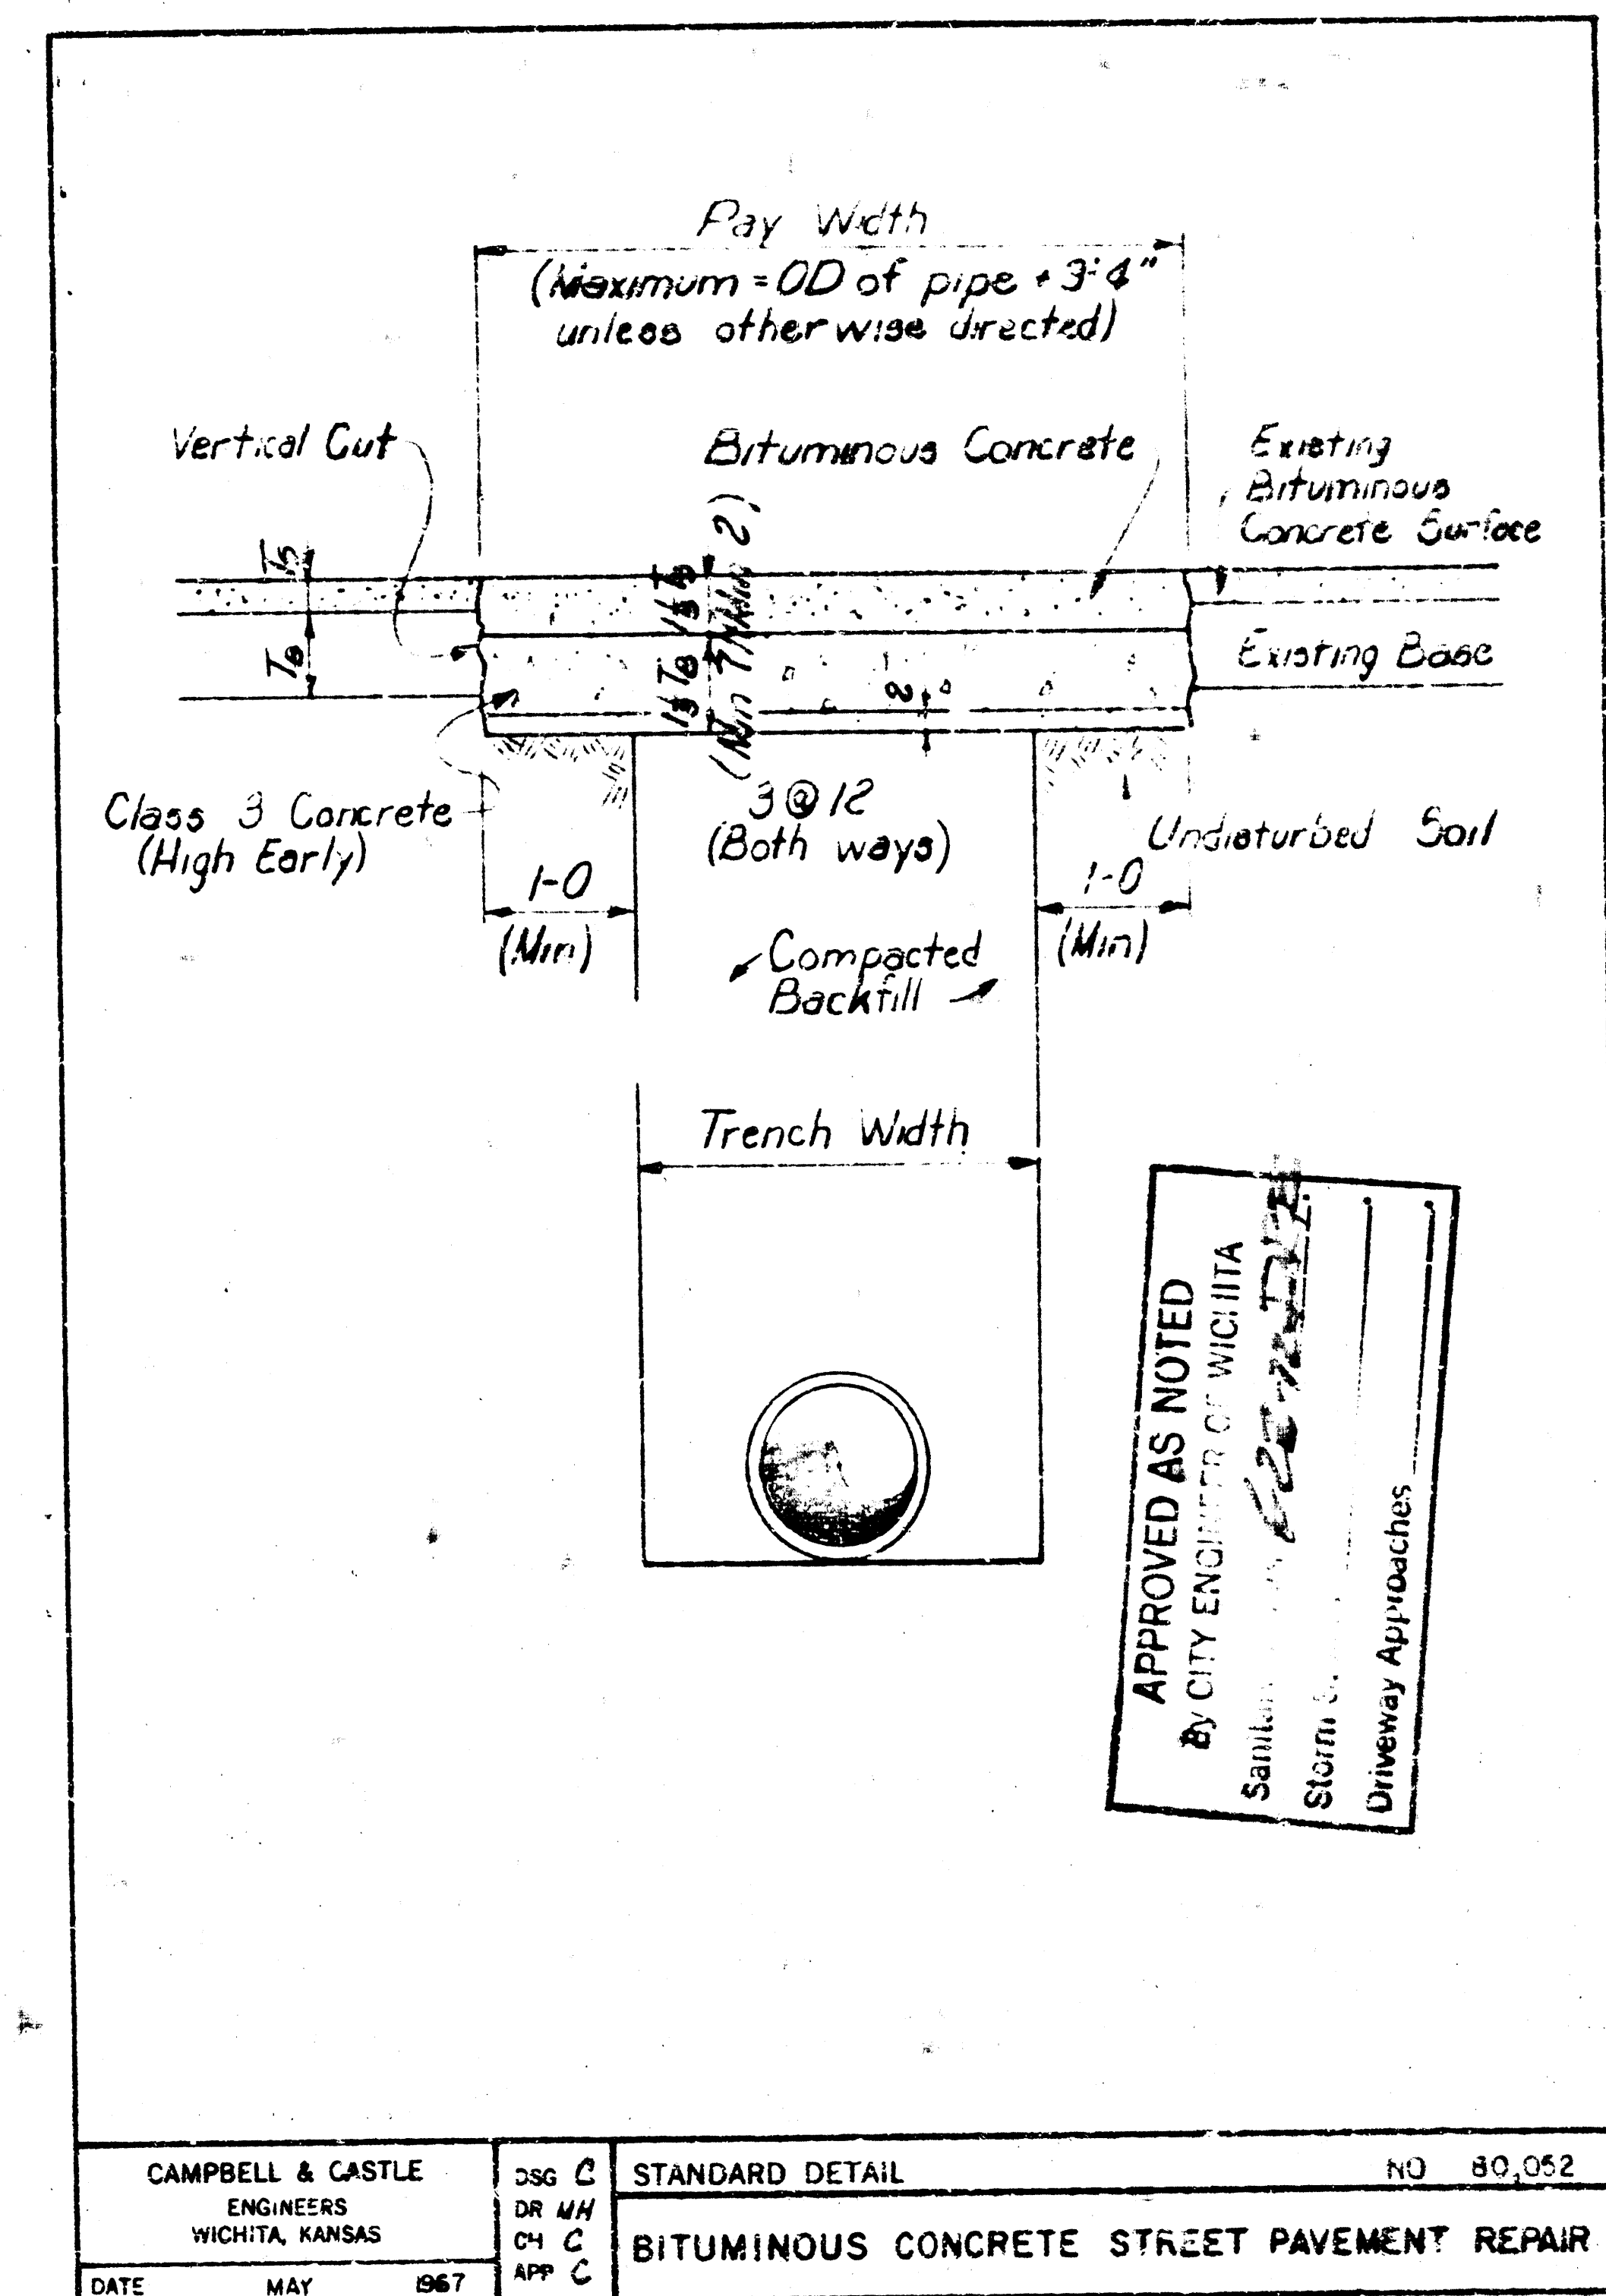


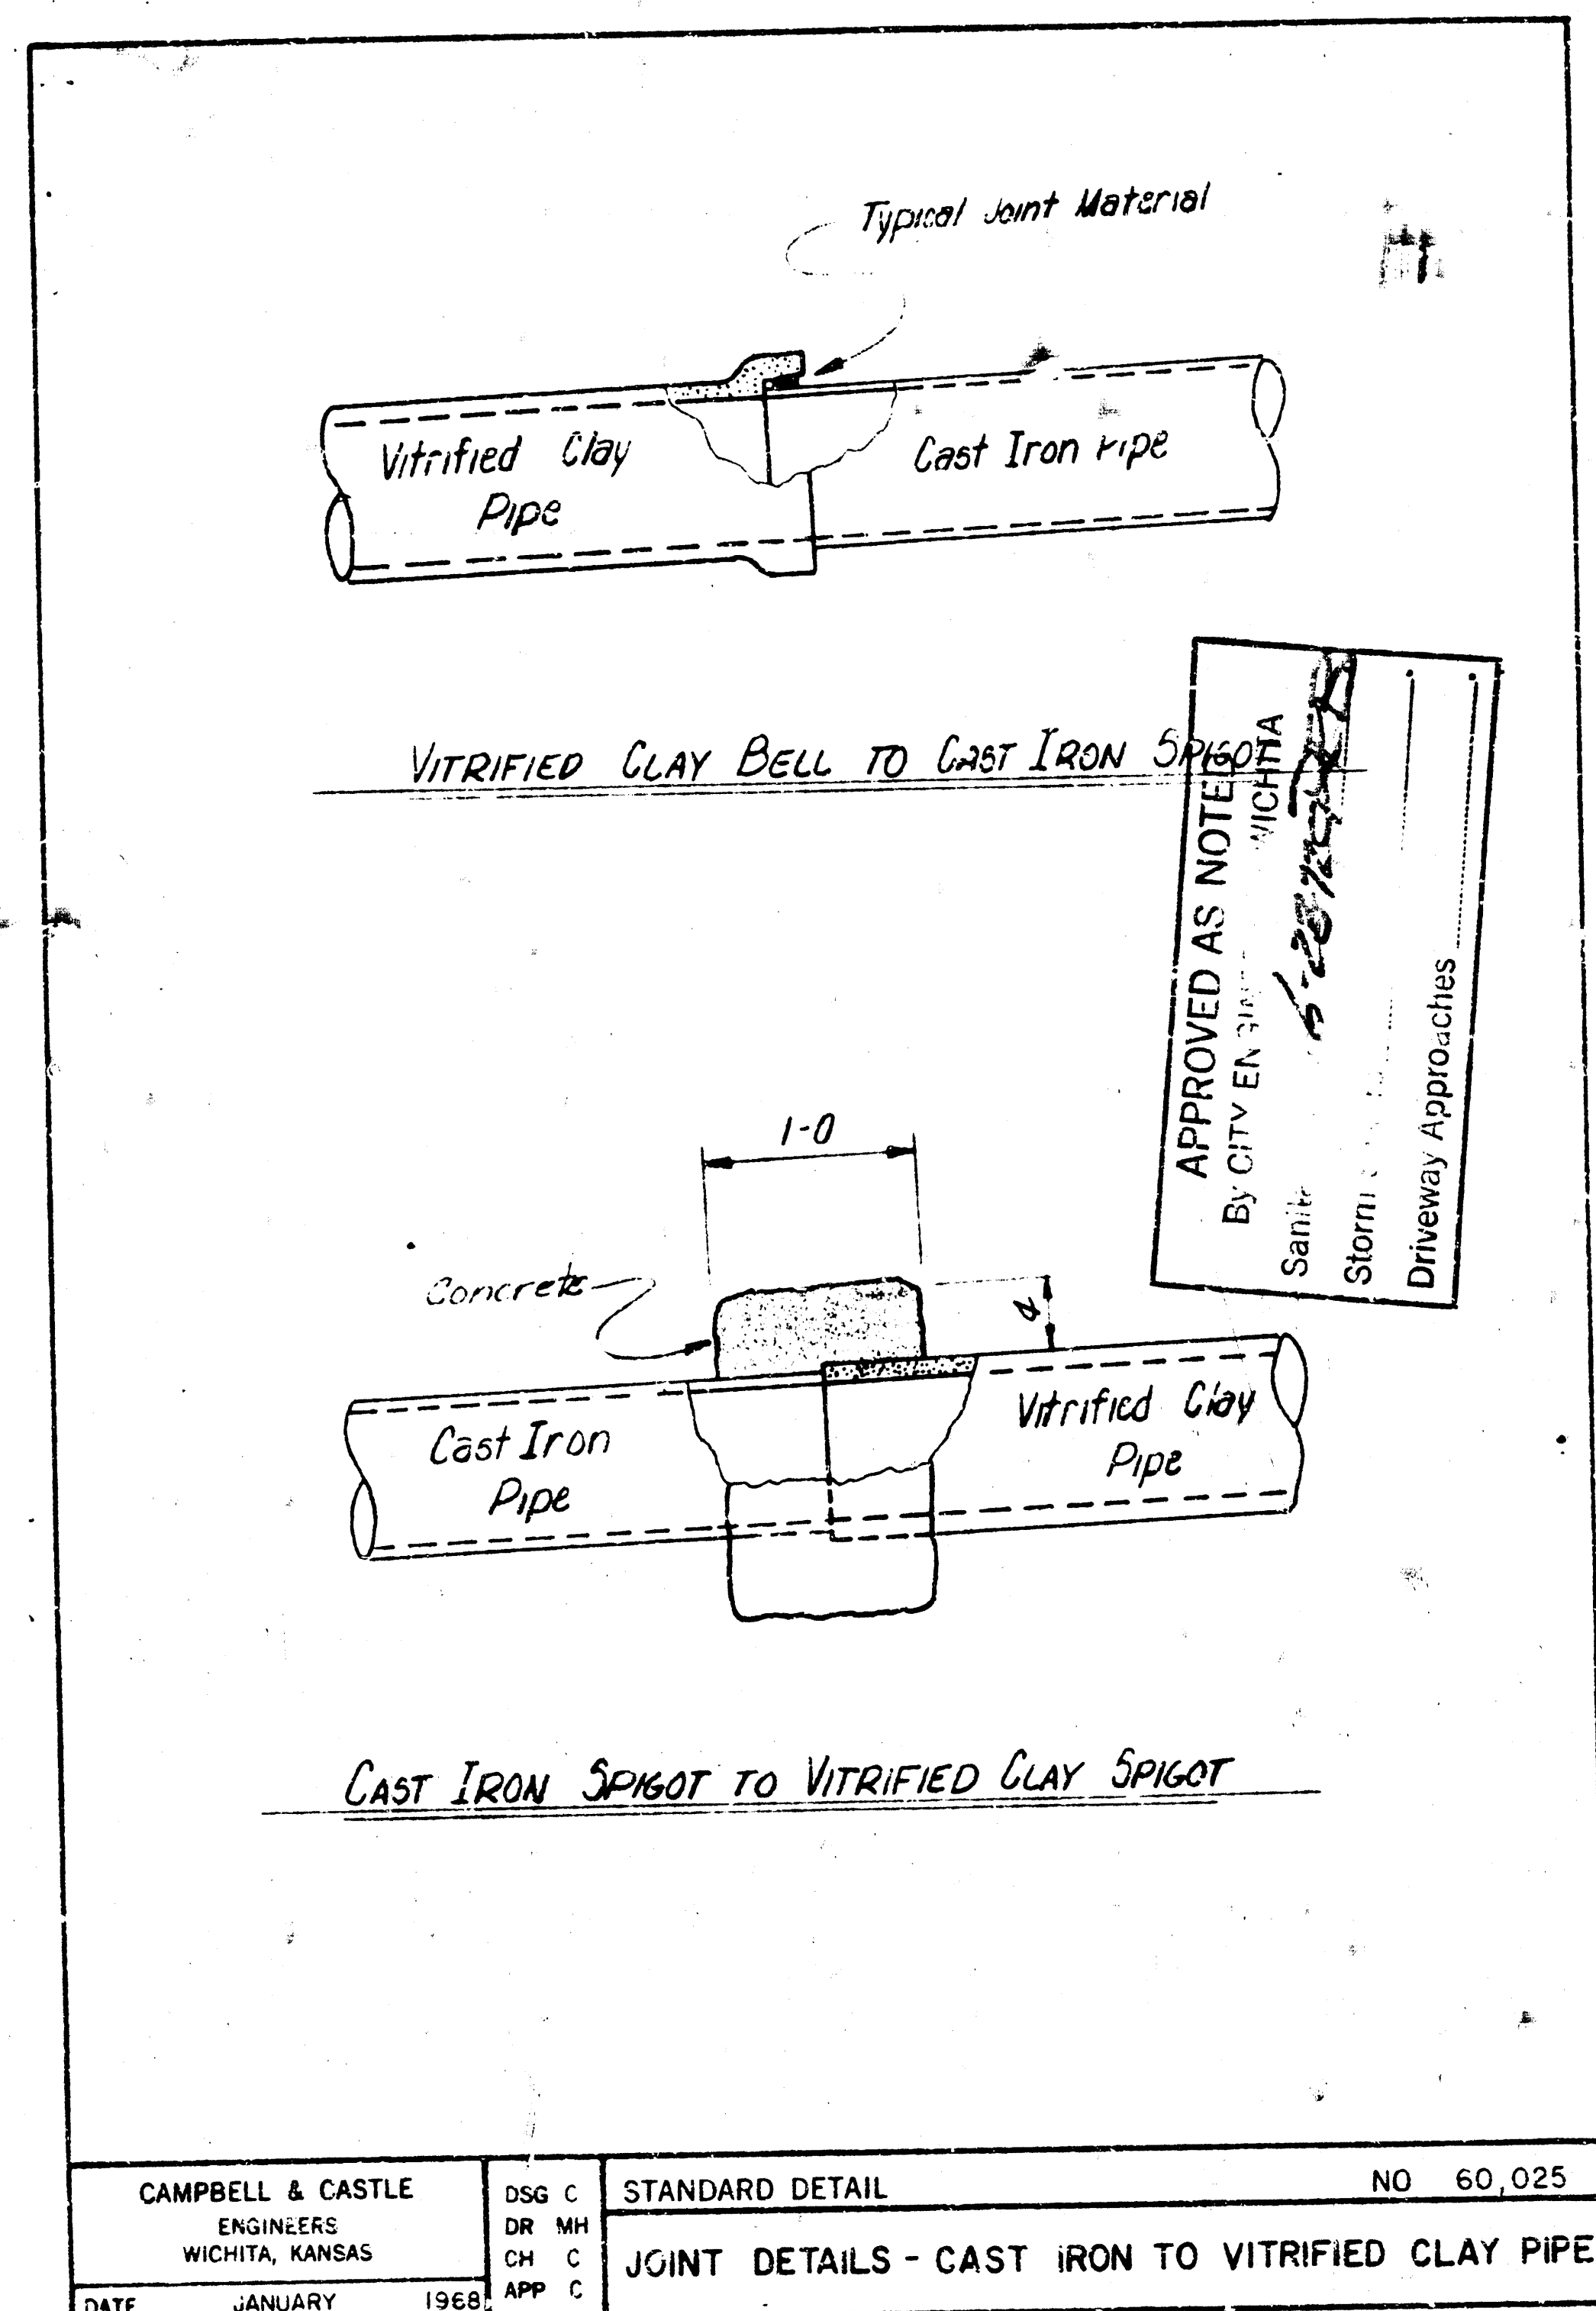

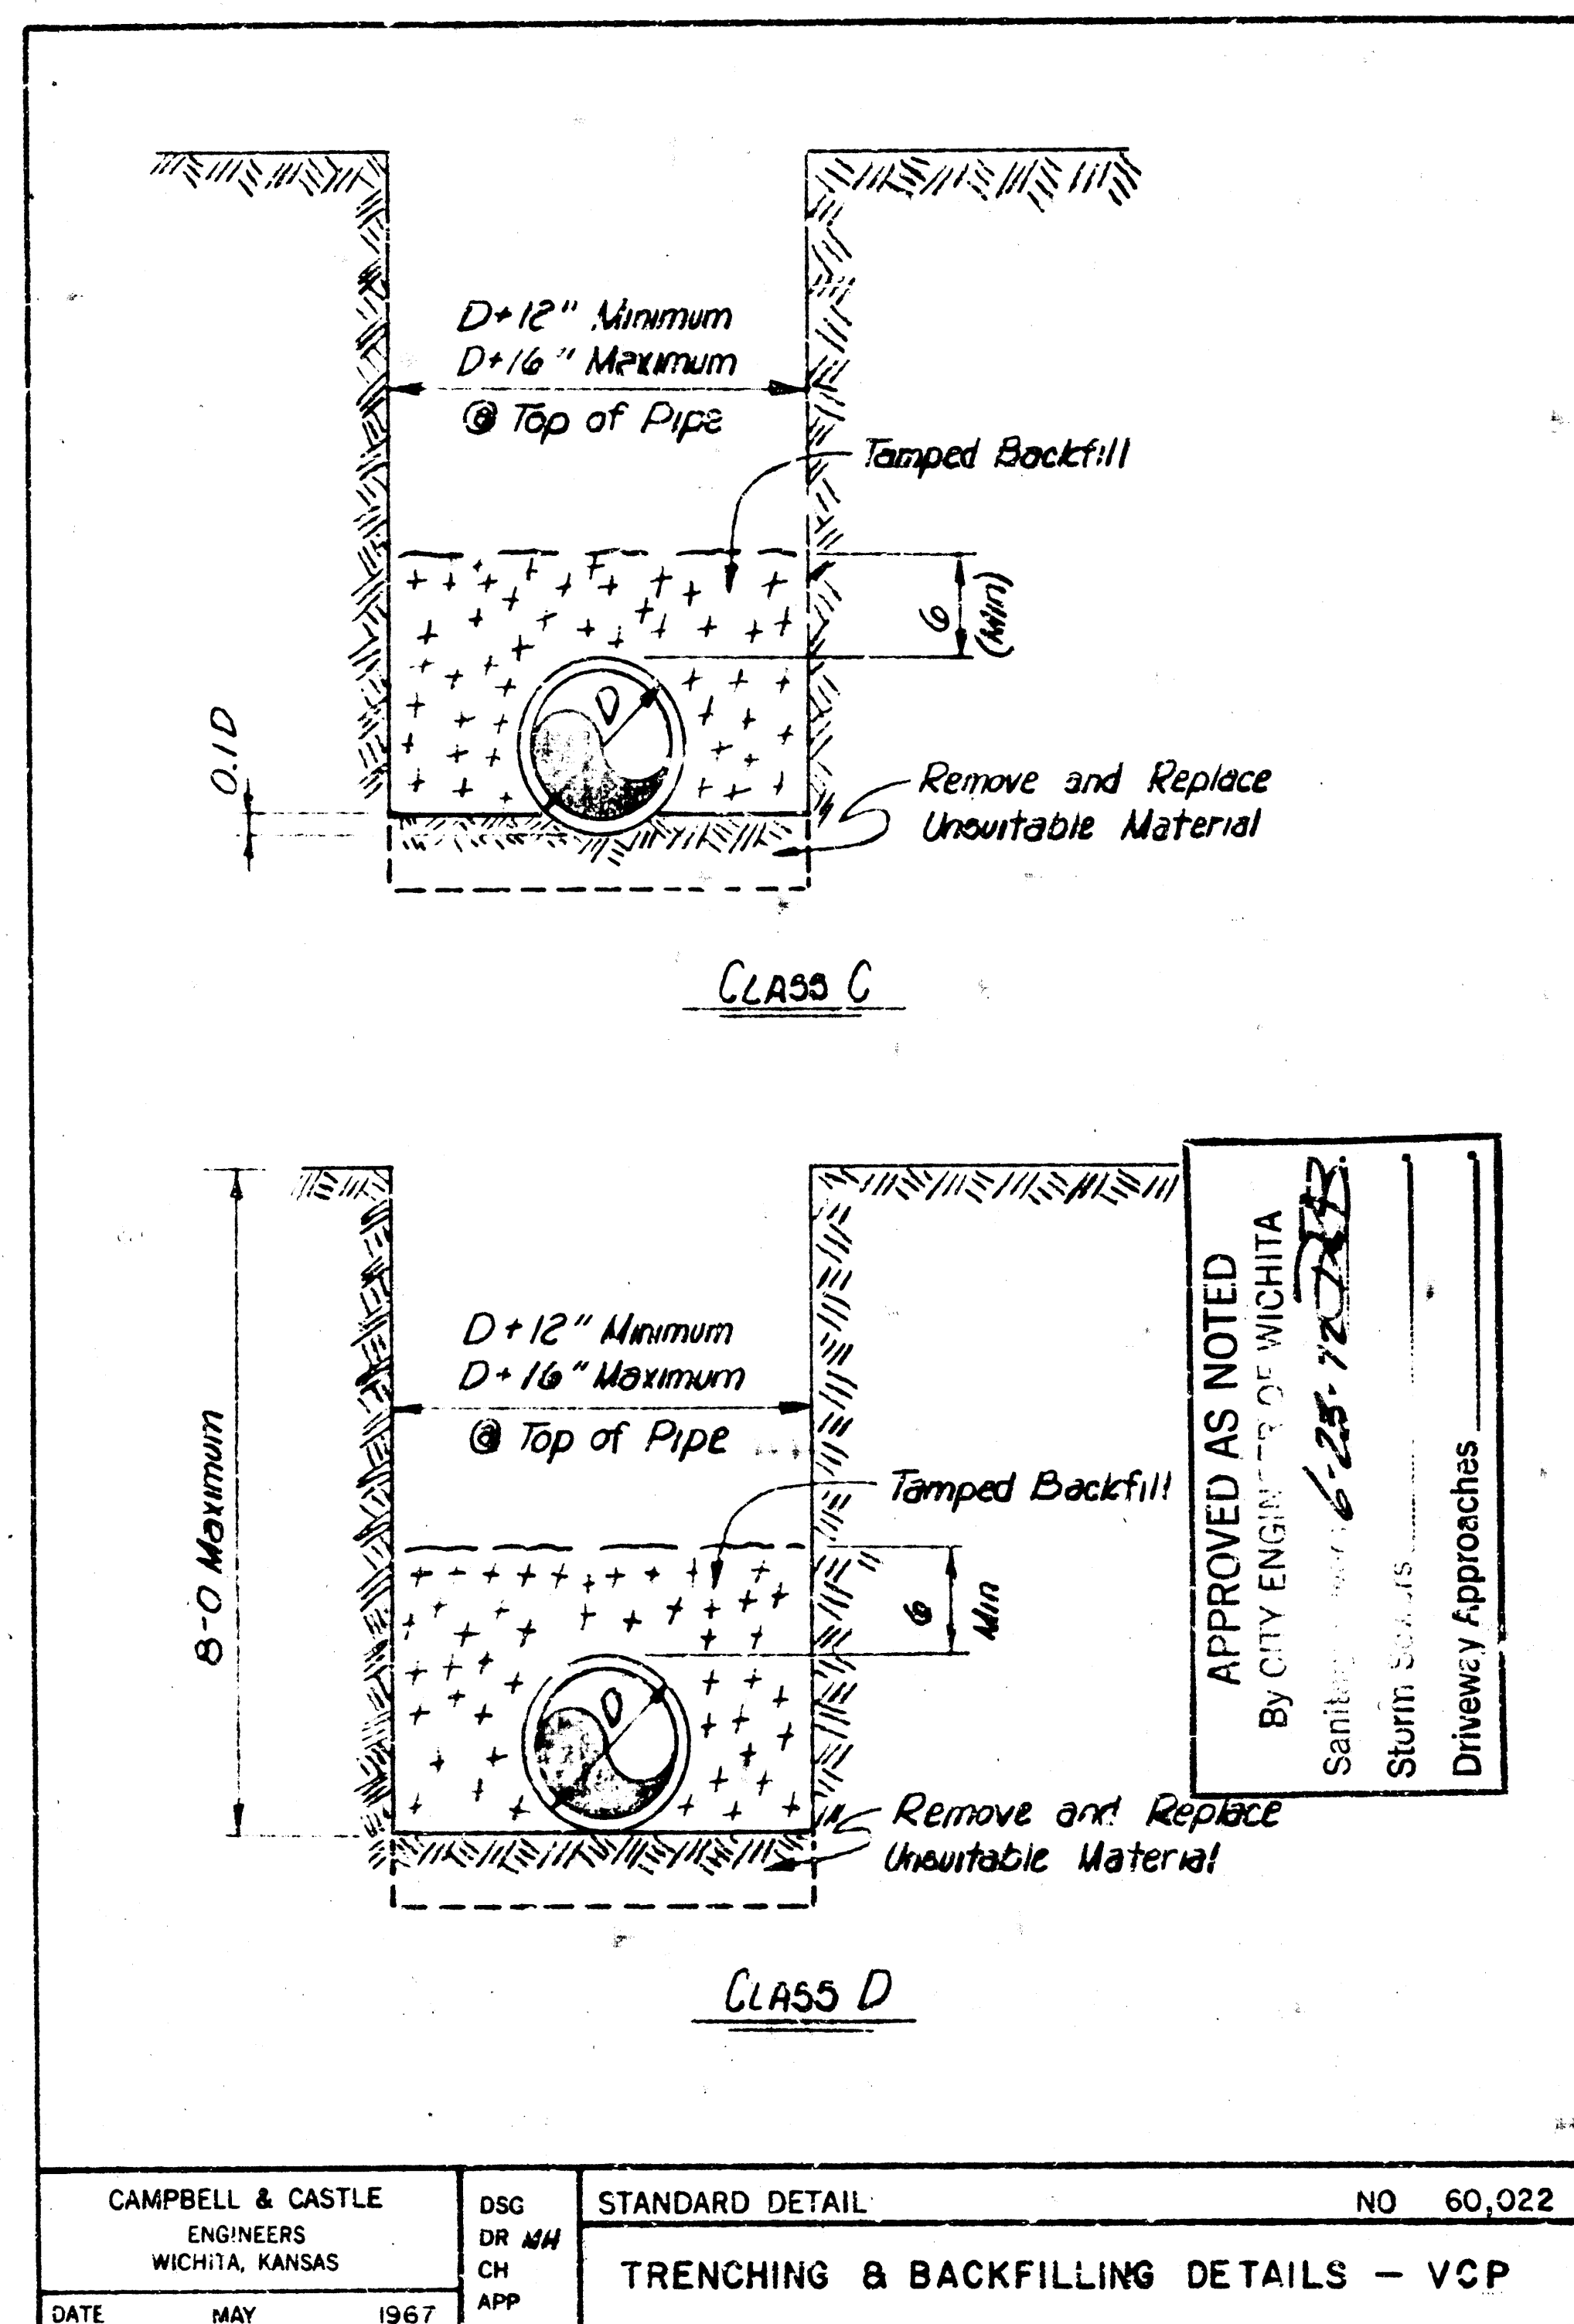

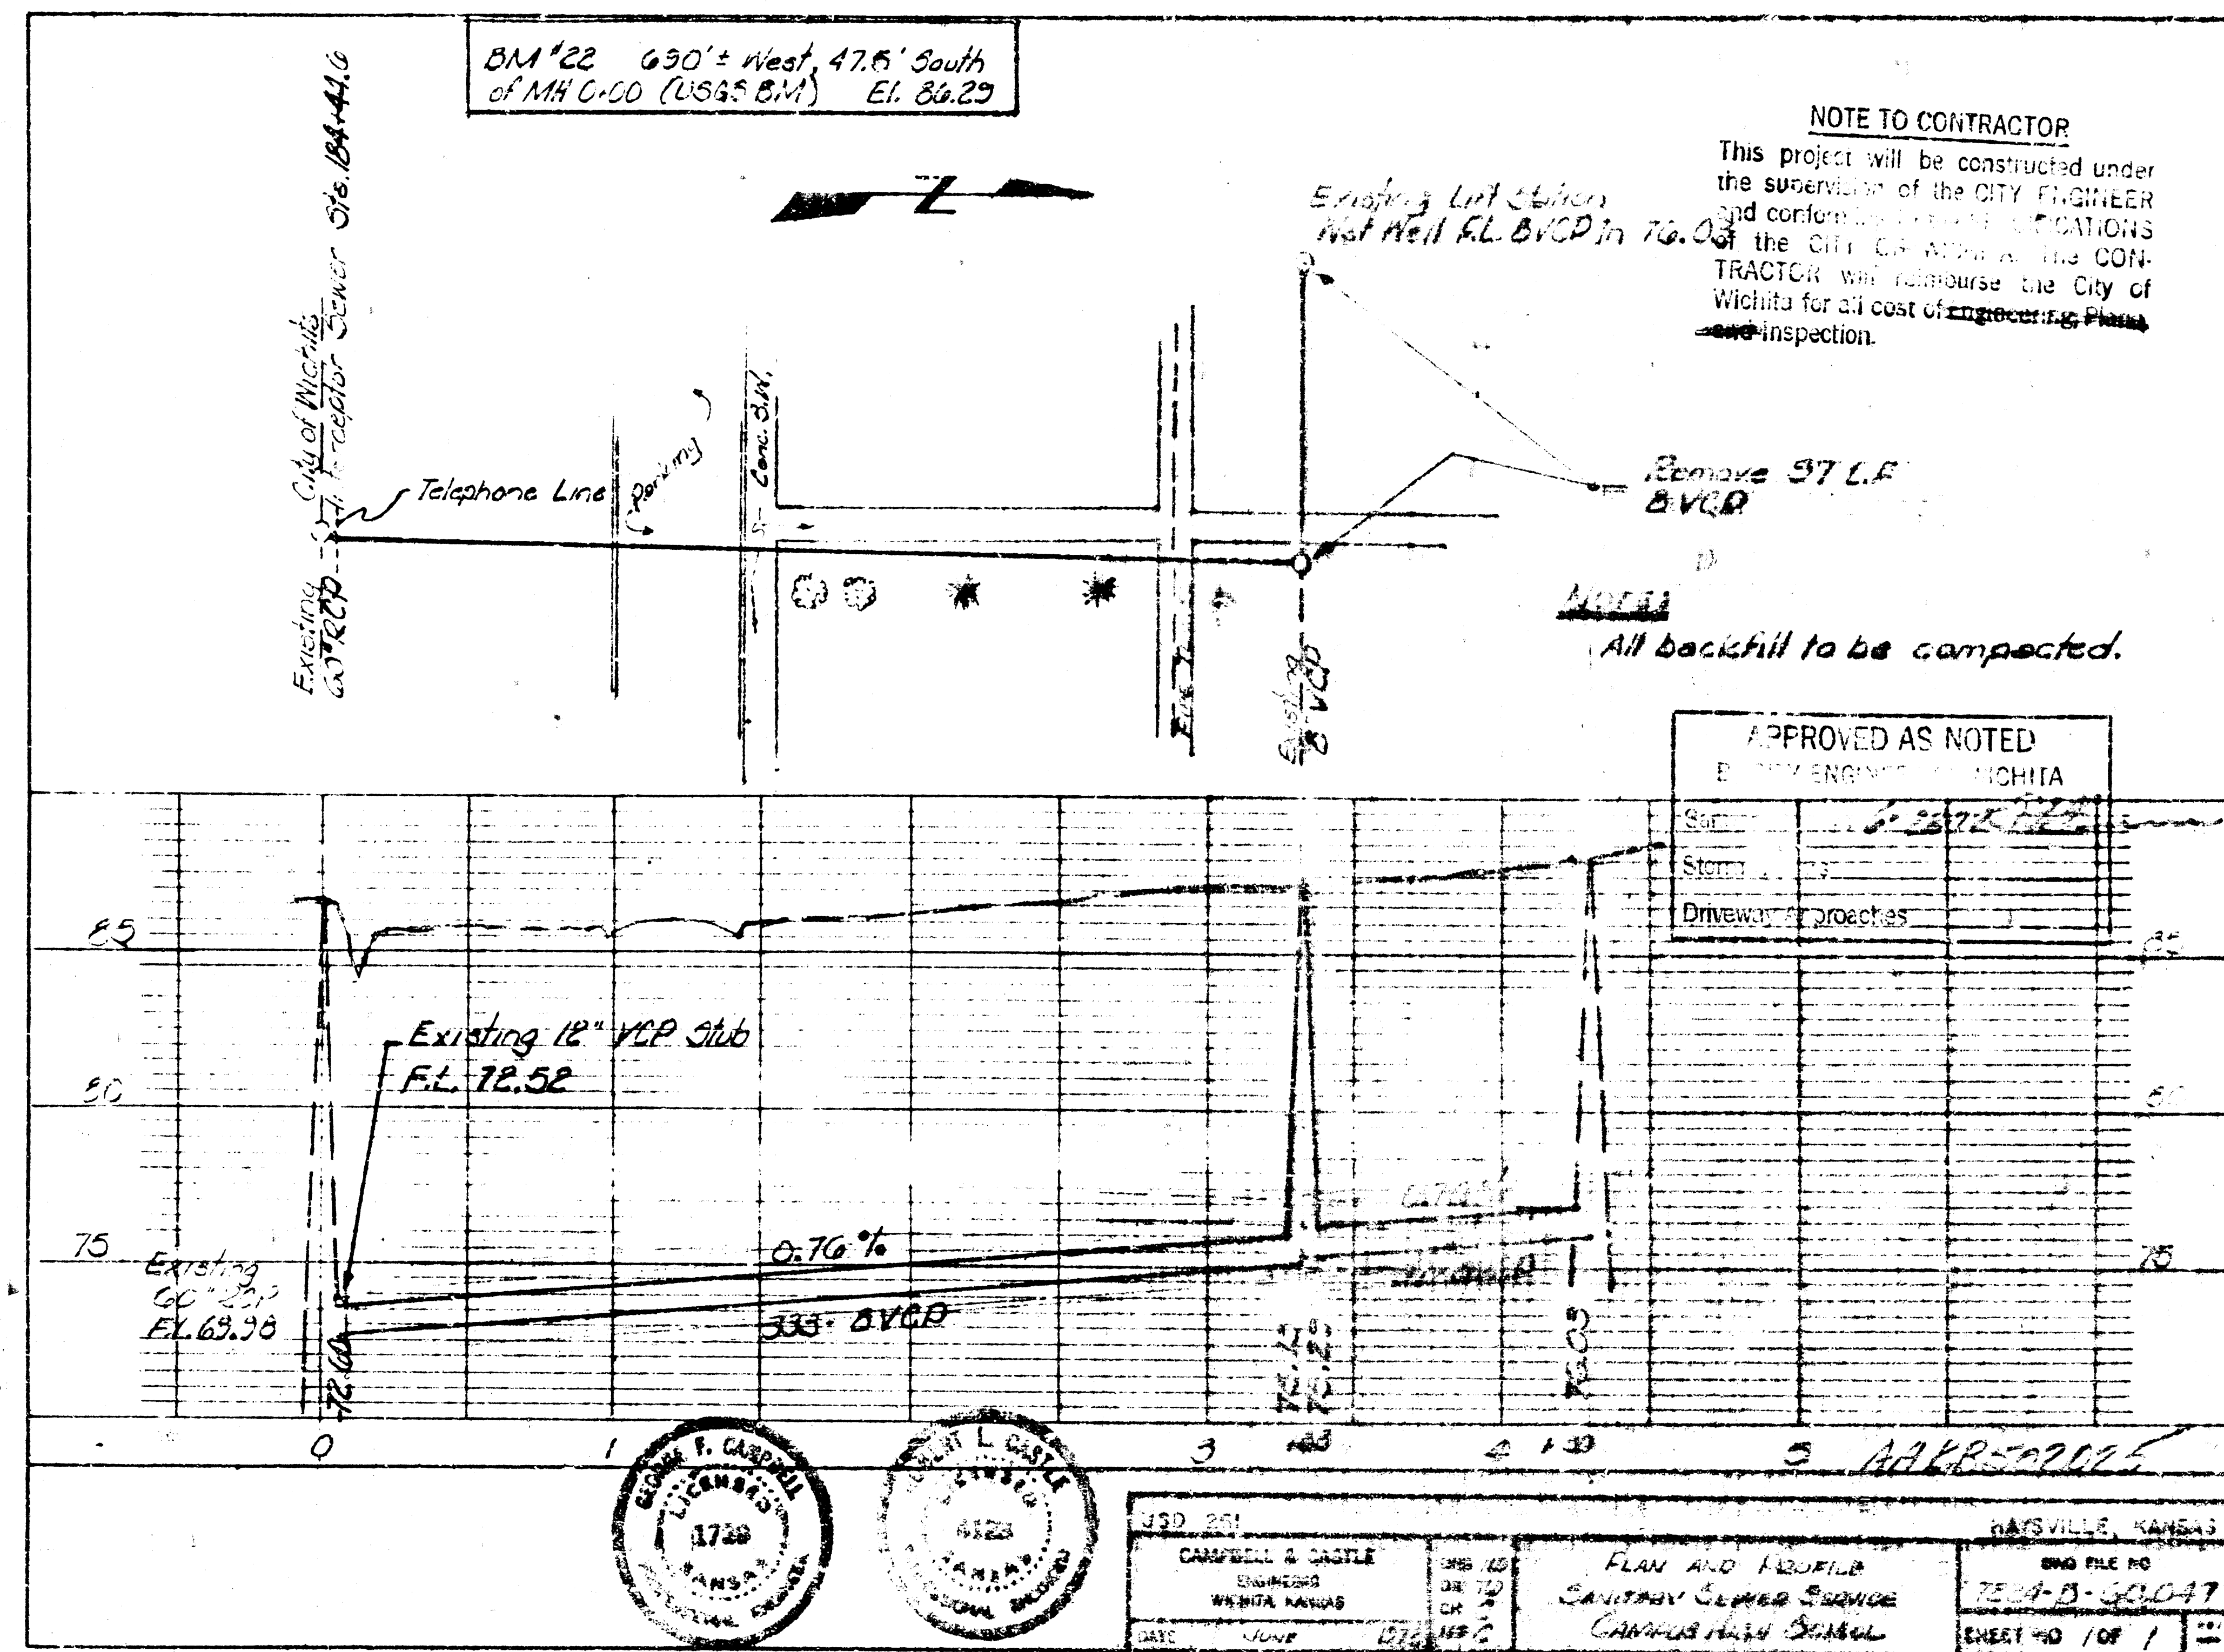


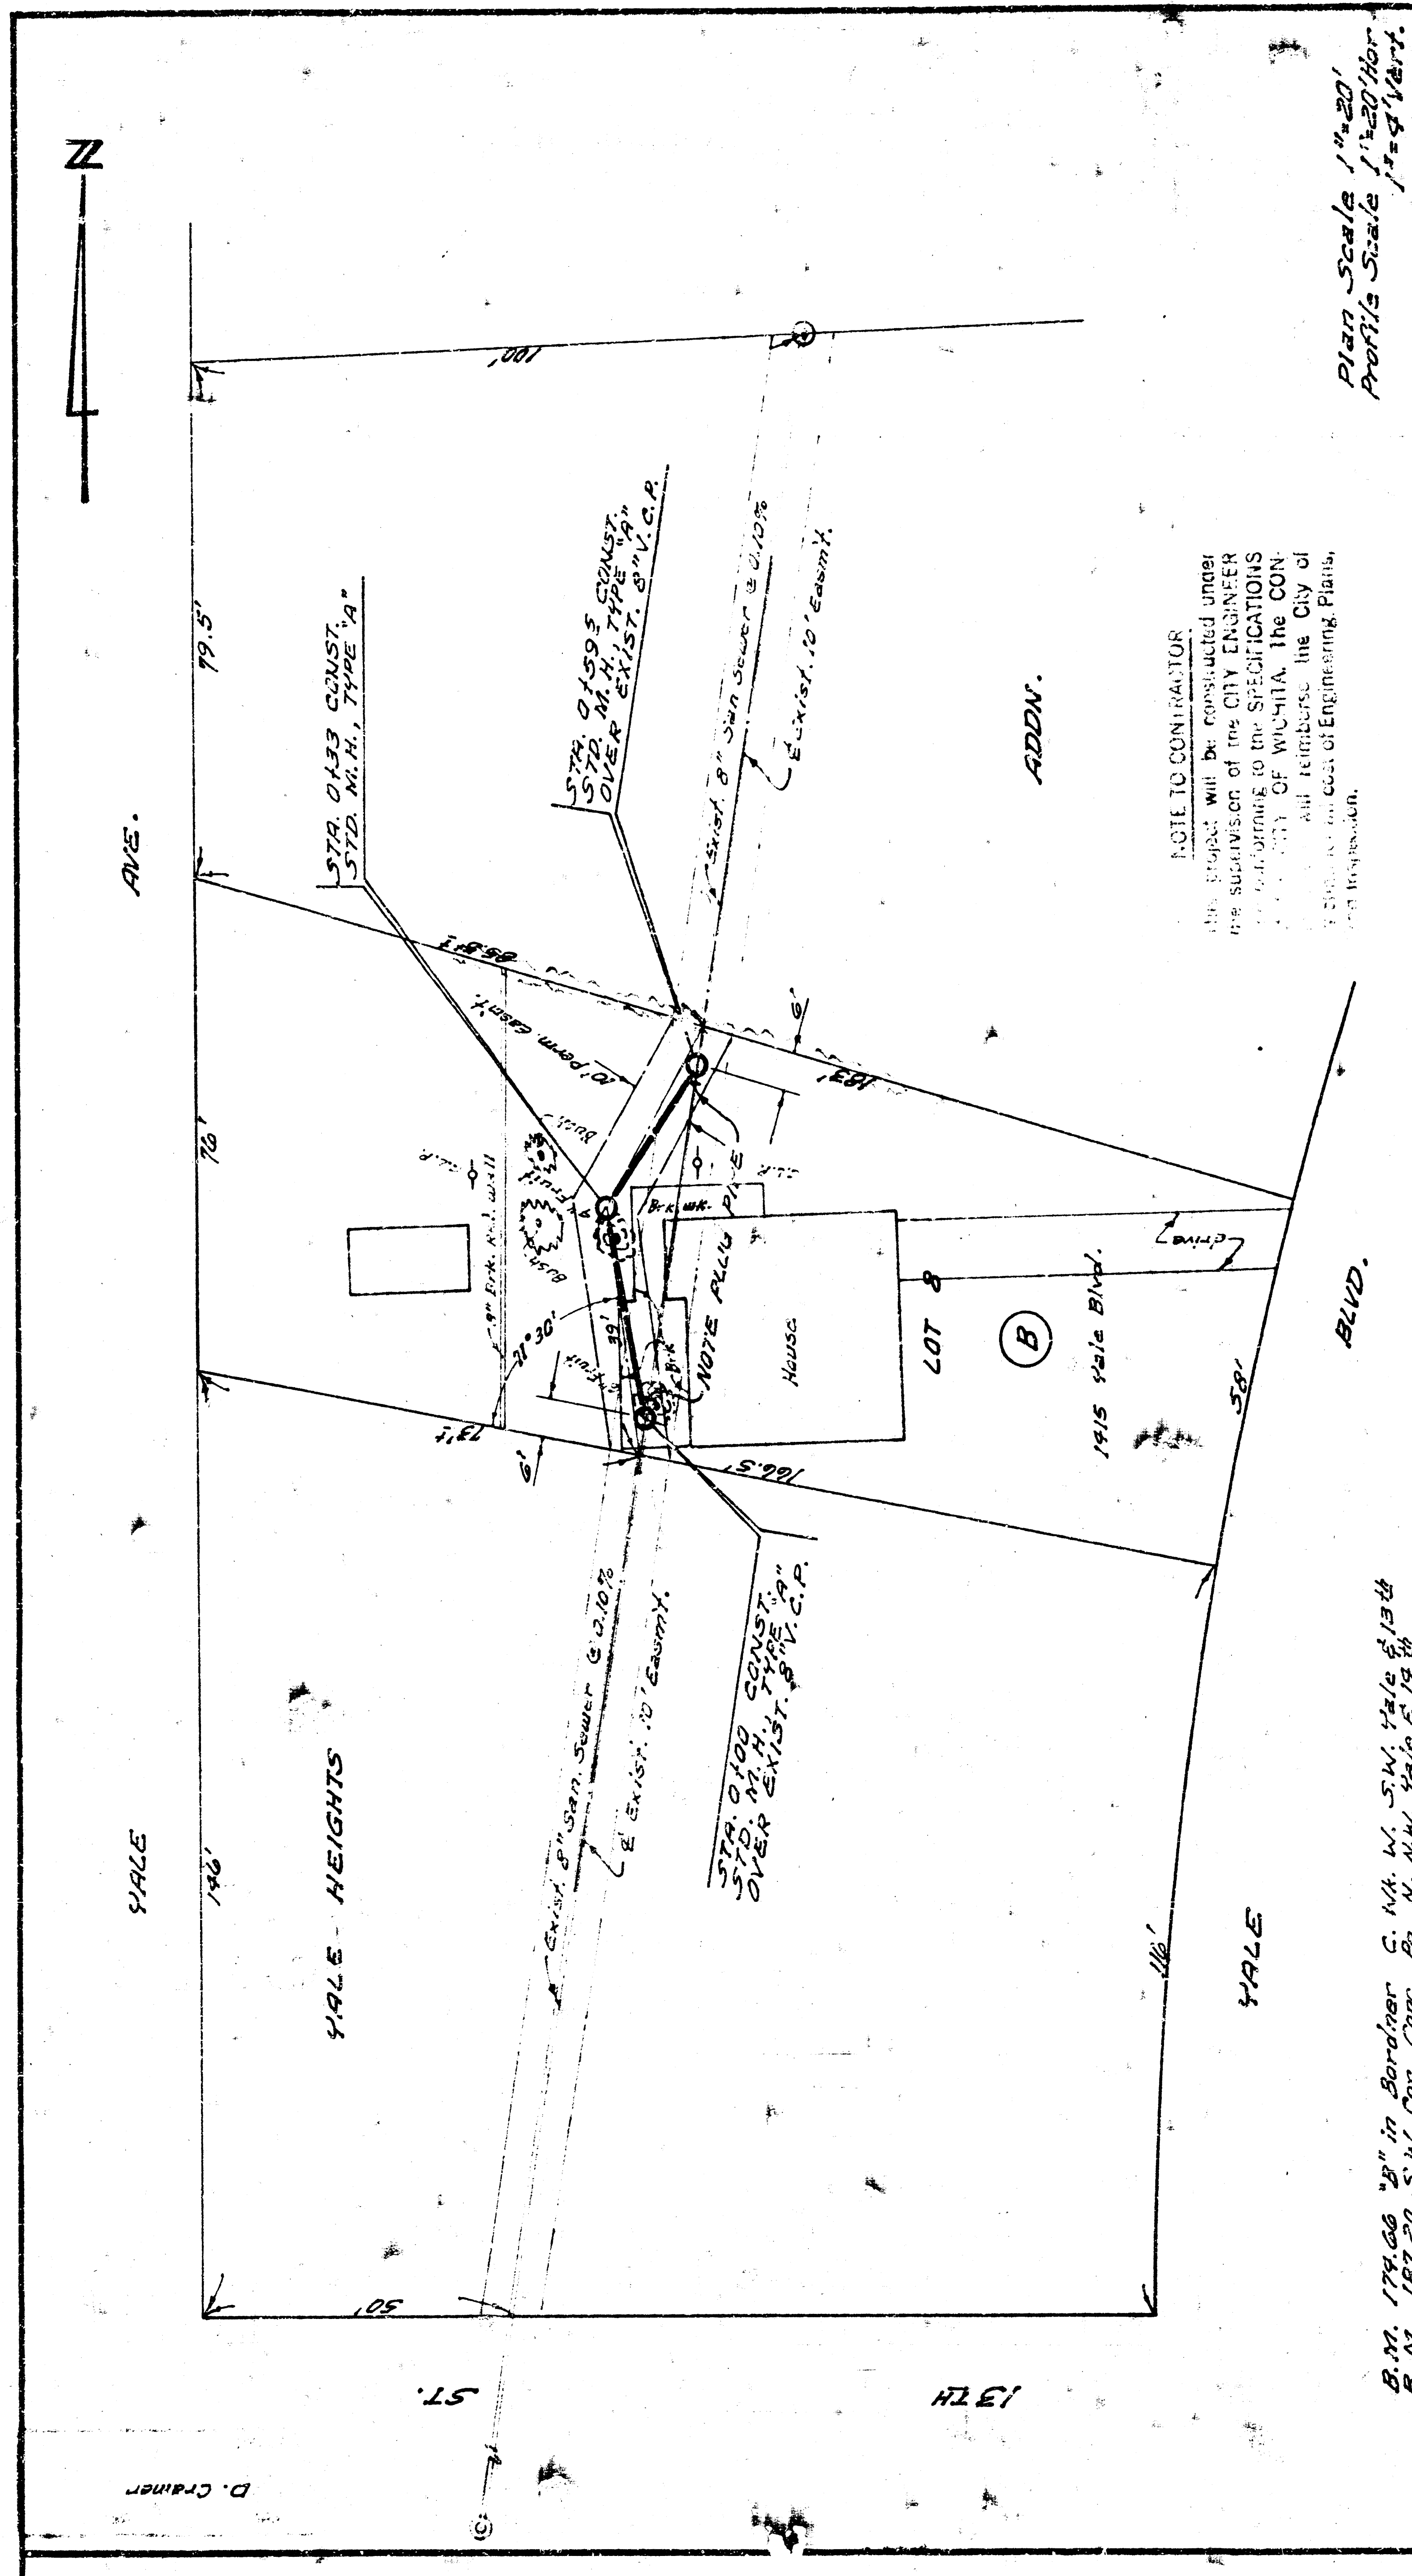

Plan Scale 1"=20'  
Profile Scale 1"=20' Hor.  
1"=4' Vert.

NOTE TO CONTRACTOR

The project will be constructed under the supervision of the CITY ENGINEER conforming to the SPECIFICATIONS of the CITY OF WUCHUA, the CONTRACTOR will reimburse the City of Wuchua for the cost of Engineering, Plans, and Inspection.

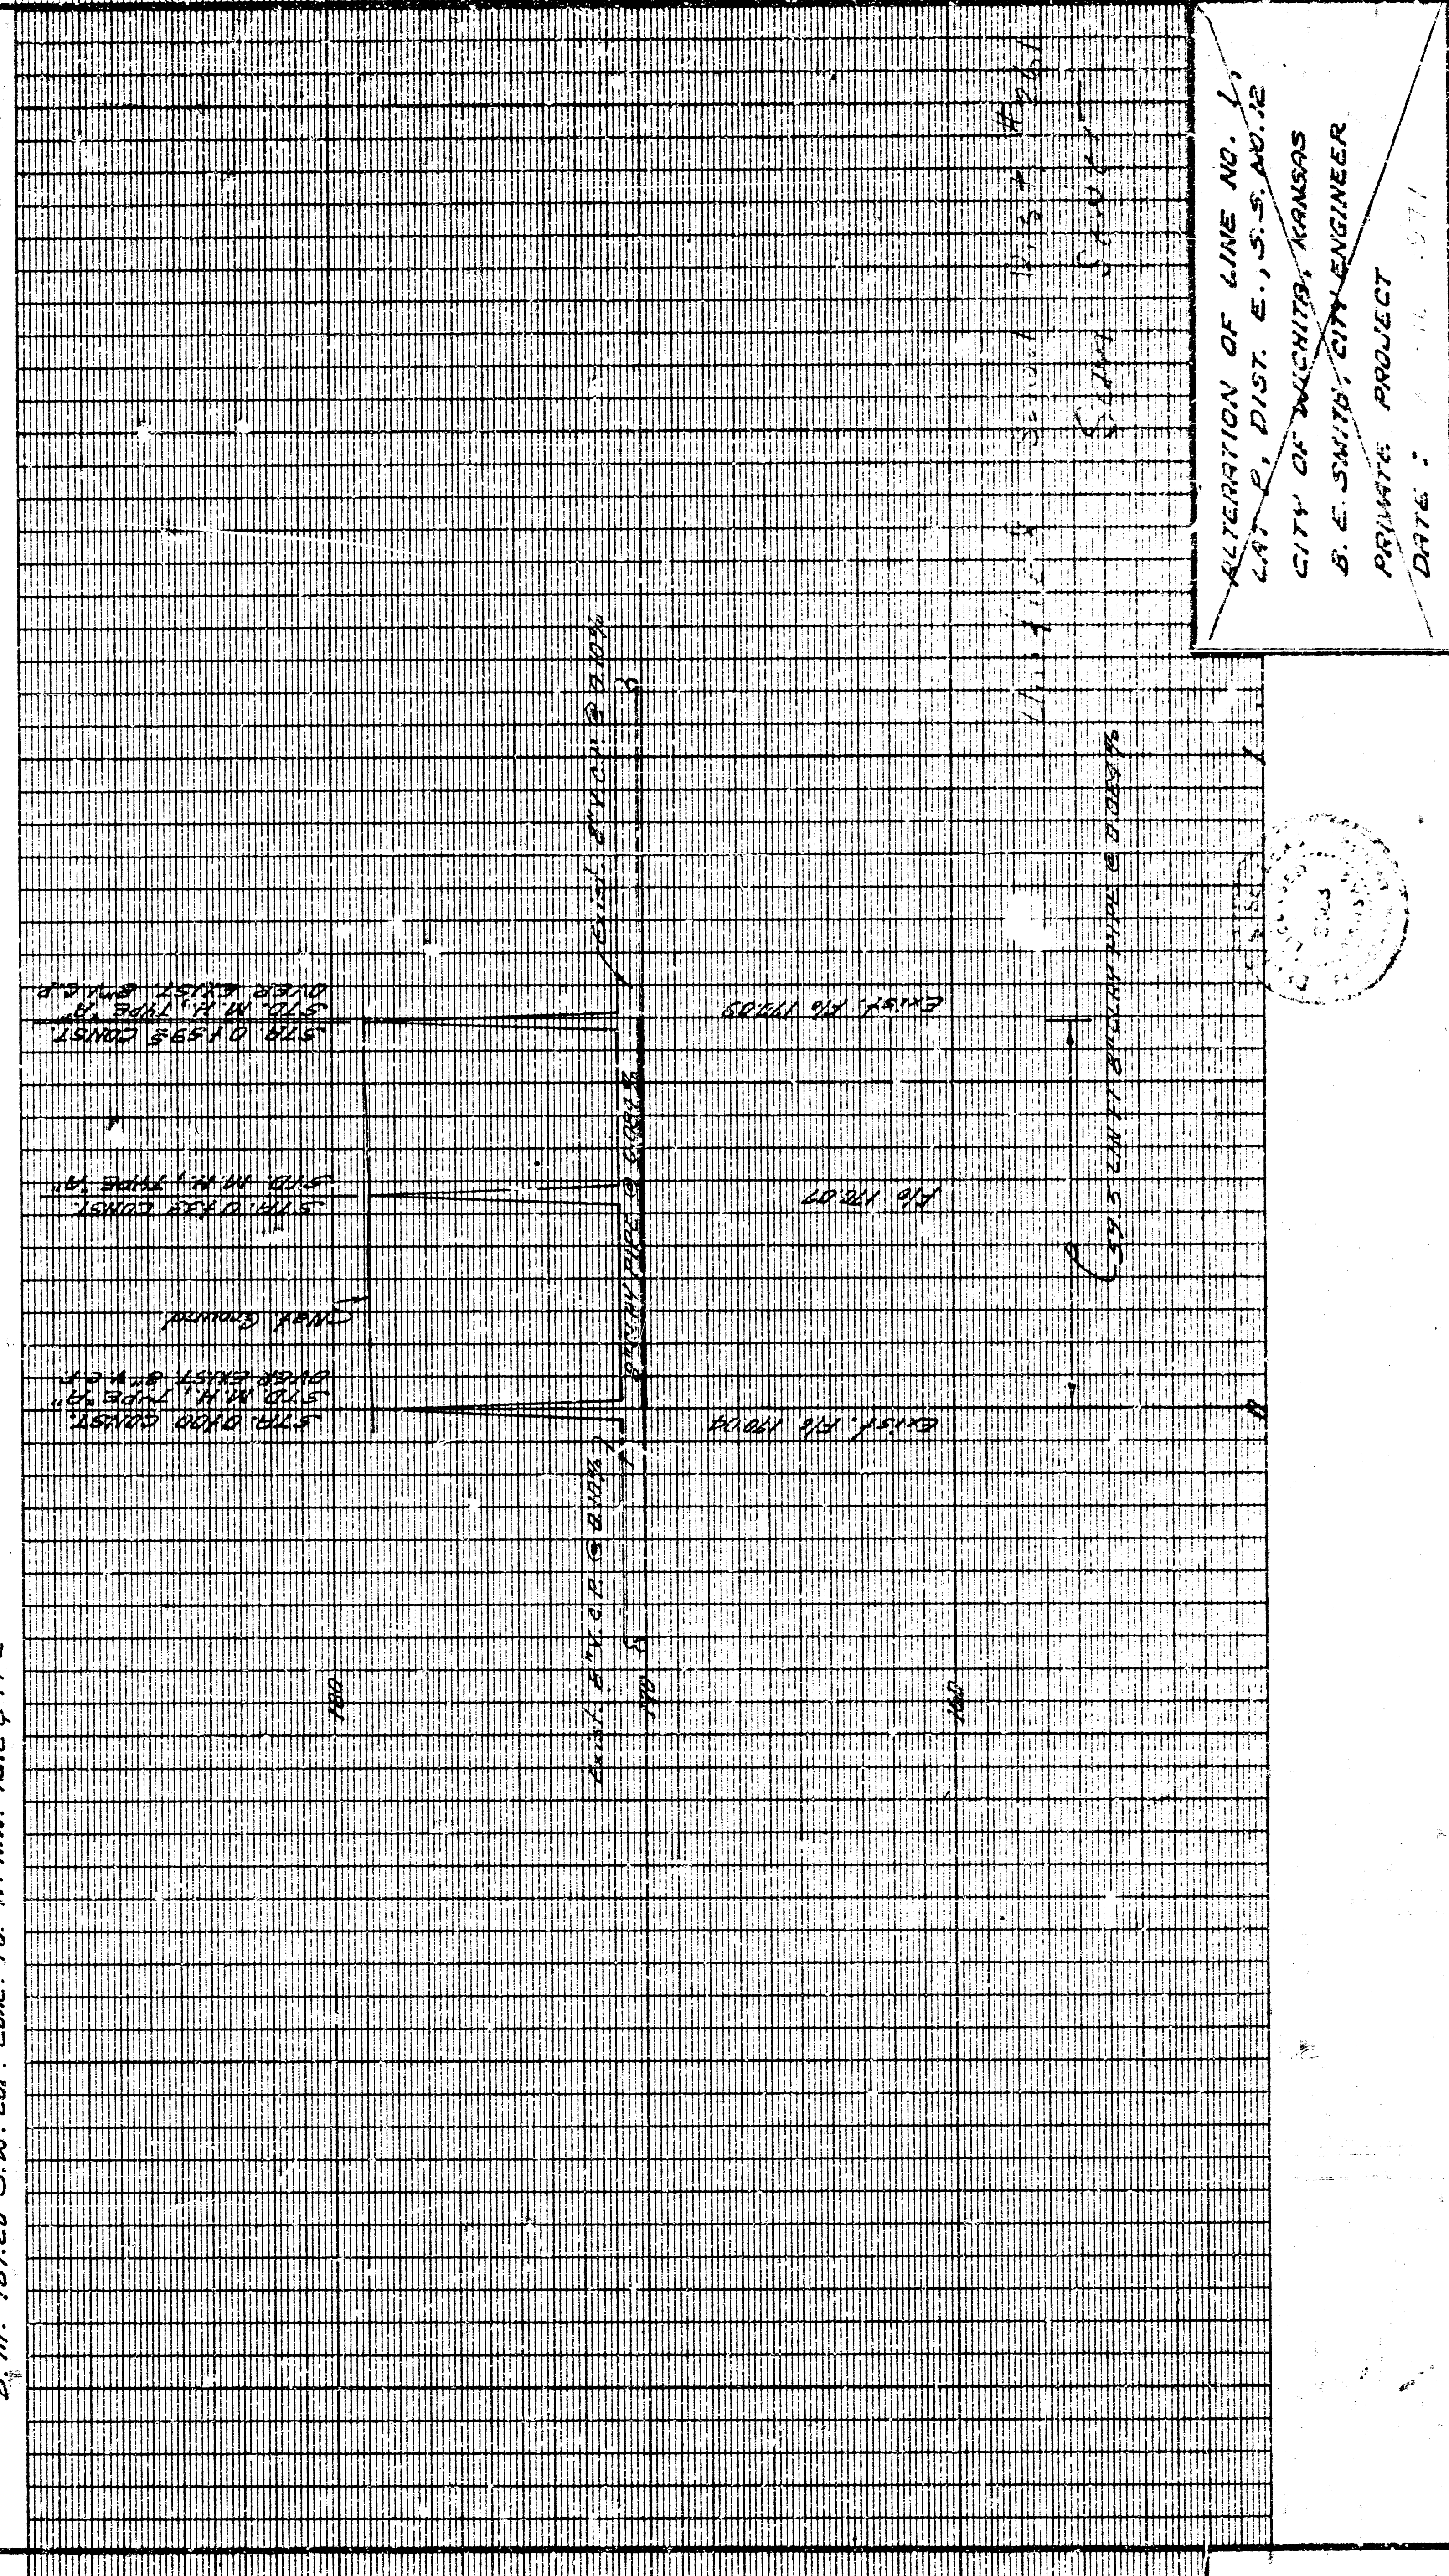

ALTERATION OF LINE NO. 1,  
LA. 8, DIST. E., S. 5. NO. 12  
CITY OF WICHITA, KANSAS  
B. E. SMITH, CITY ENGINEER  
PRIVATE PROJECT  
DATE: 10-16-1971