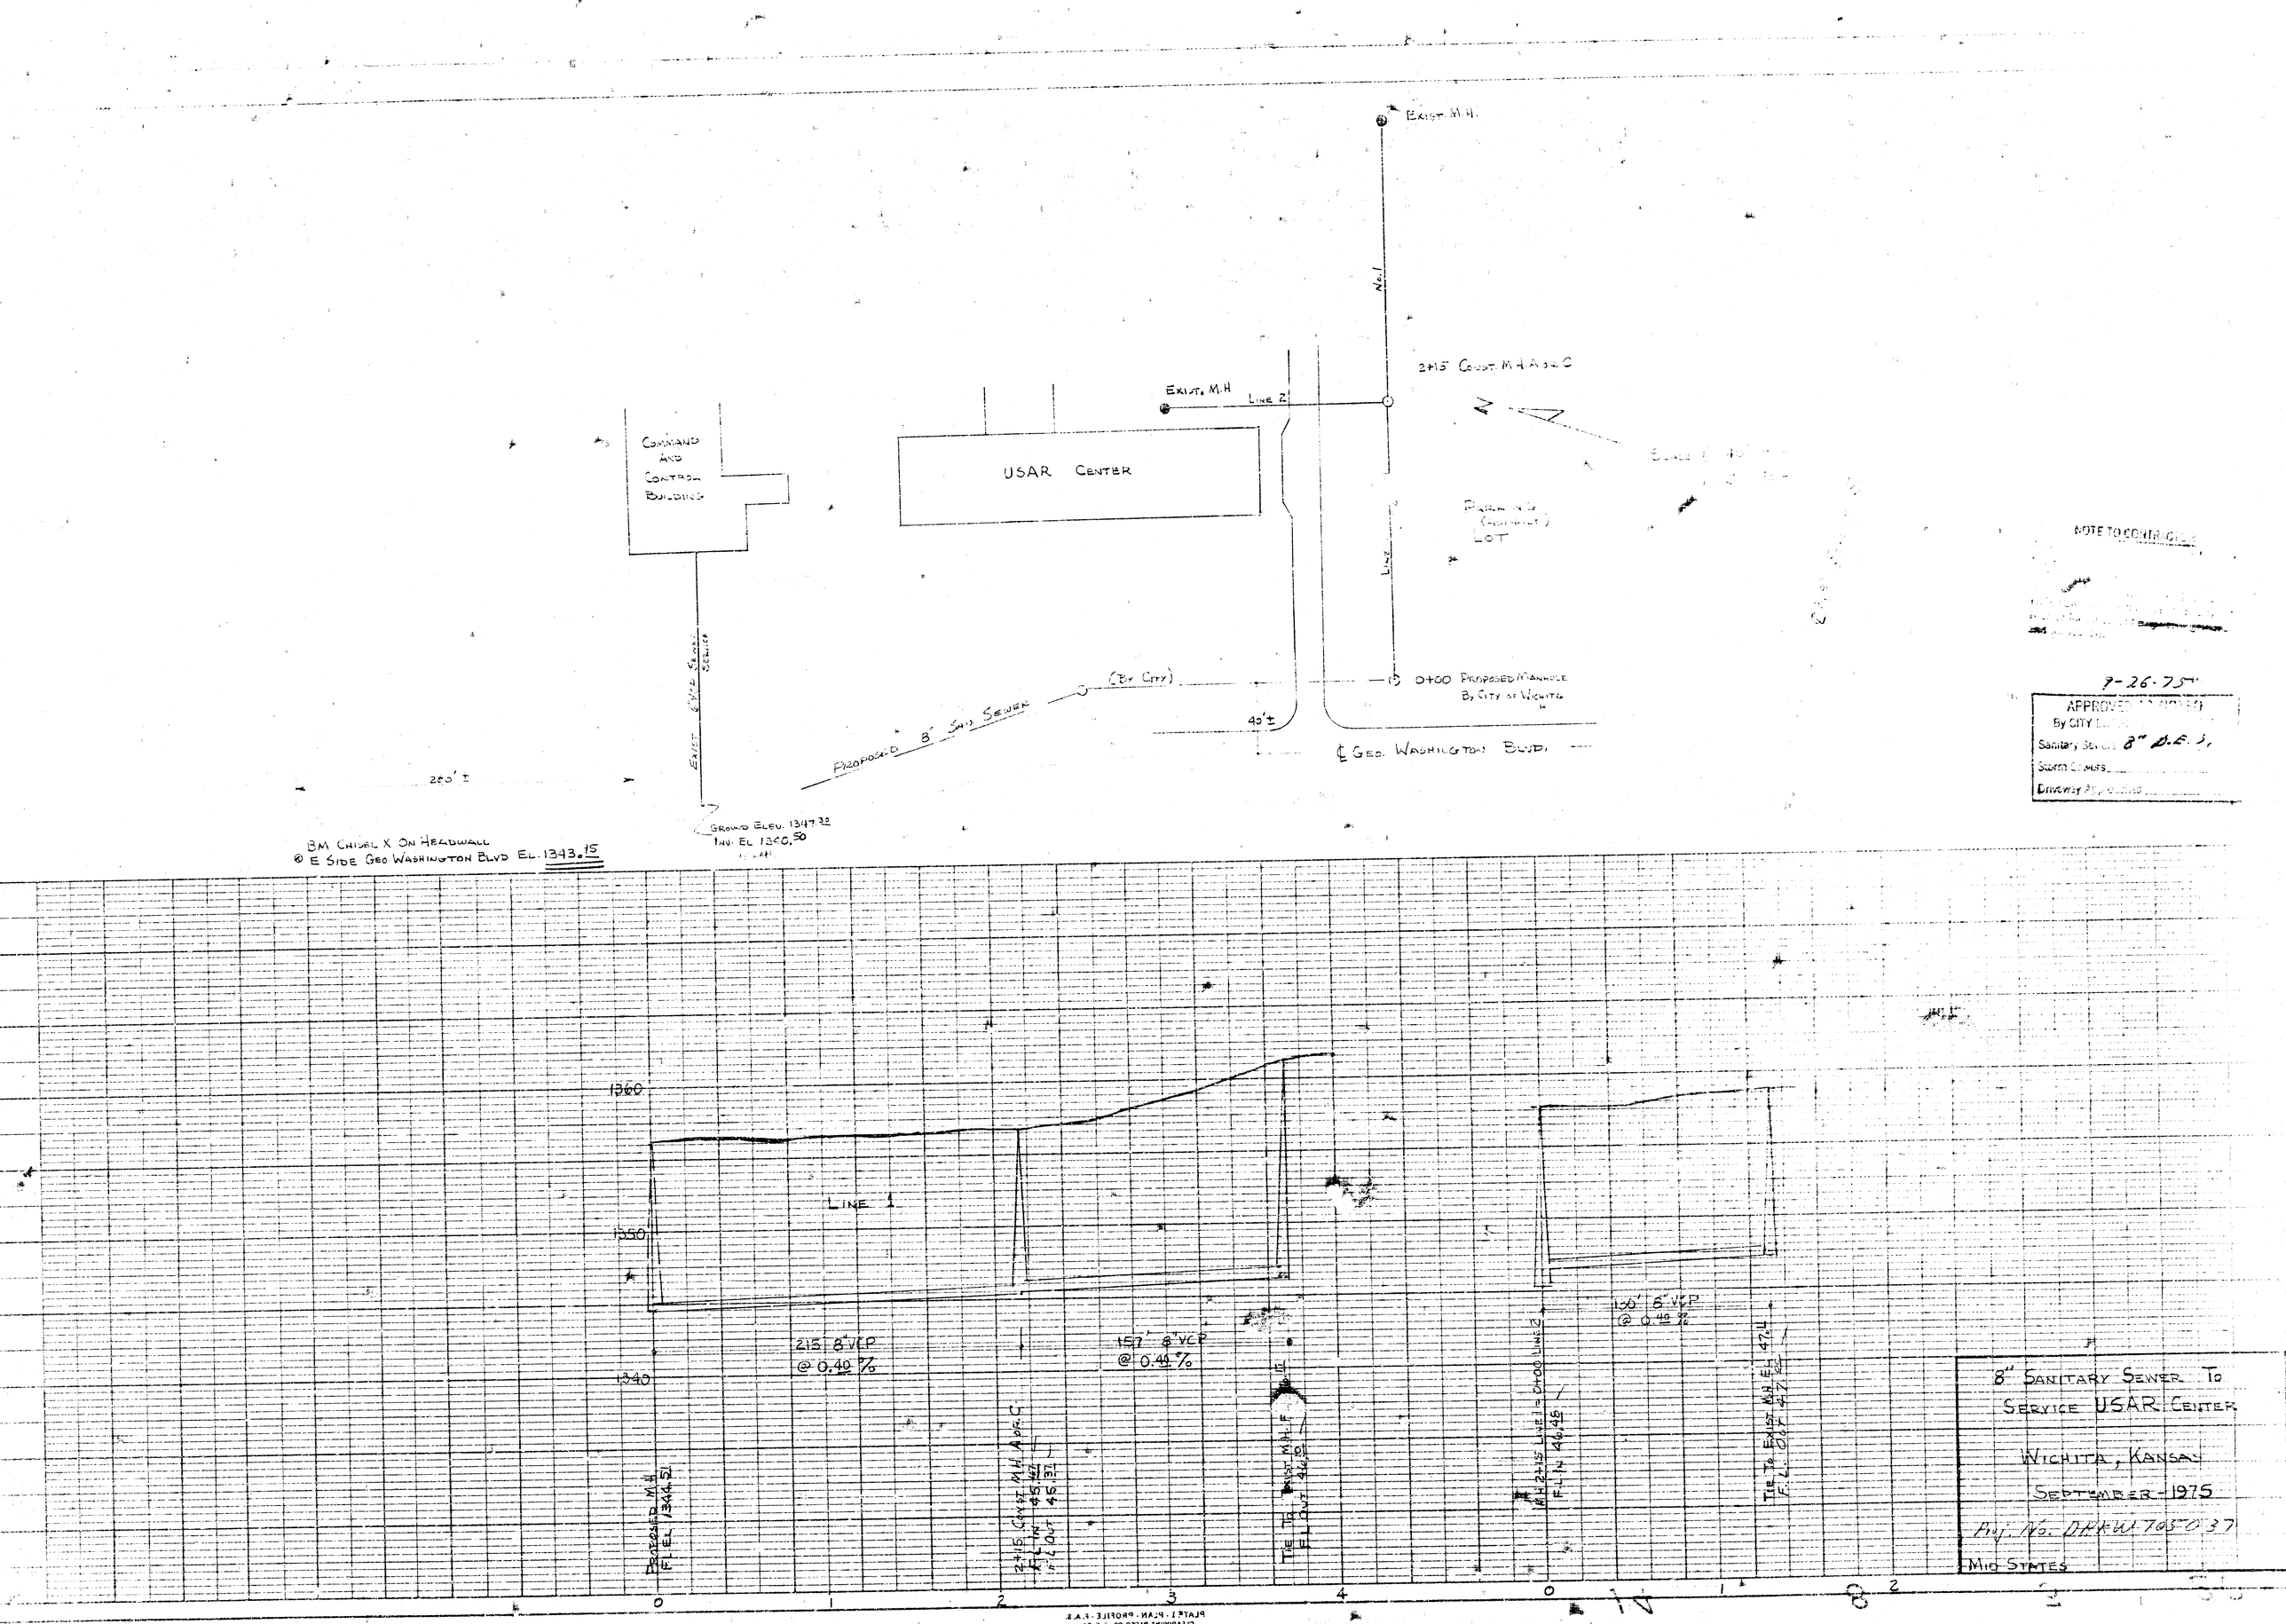
EXIST. M.H.
No. 1
2+15 CONST. M.H. A or C
EXIST. M.H.
LINE 2
N
COMMAND AND CONTROL BUILDING
USAR CENTER
PARKING (ASPHALT) LOT
LINE 1
EXIST 6" VCP SEWER SERVICE
(BY CITY)
0+00 PROPOSED MANHOLE By CITY OF WICHITA
PROPOSED 8" SAN. SEWER
40'±
℄ GEO. WASHINGTON BLVD.
260'±
BM CHISEL X ON HEADWALL @ E SIDE GEO WASHINGTON BLVD EL. 1343.15
GROUND ELEV. 1347.32
INV. EL 1340.50
1360
1350
1340
LINE 1
215' 8" VCP @ 0.40 %
157' 8" VCP @ 0.44 %
100' 8" VCP @ 0.46 %
PROPOSED M.H. FL EL 1344.51
2+15 CONST. M.H. A or C FL IN 45.47 FL OUT 45.37
TIE TO EXIST. M.H. F FL OUT 46.16
M.H. 2+15 LINE 2 = 0+00 LINE 2 FL IN 46.46
TIE TO EXIST. M.H. E FL OUT 47.11
0
1
2
3
4
0
1
2
3
NOTE TO CONTRACTOR
9-26-75
APPROVED AS NOTED
By CITY ENGINEER
Sanitary Sewers 8" D.E.J.
Storm Sewers
Driveway Approaches
8" SANITARY SEWER TO SERVICE USAR CENTER
WICHITA, KANSAS
SEPTEMBER - 1975
Proj. No. DHW 705 037
MID STATES