

SANITARY SEWER SYSTEM


THE VILLAS AT CRESTVIEW


REISS AND GOODNESS ENGINEERS

2160 E. DOUGLAS WICHITA — KANSAS

1970



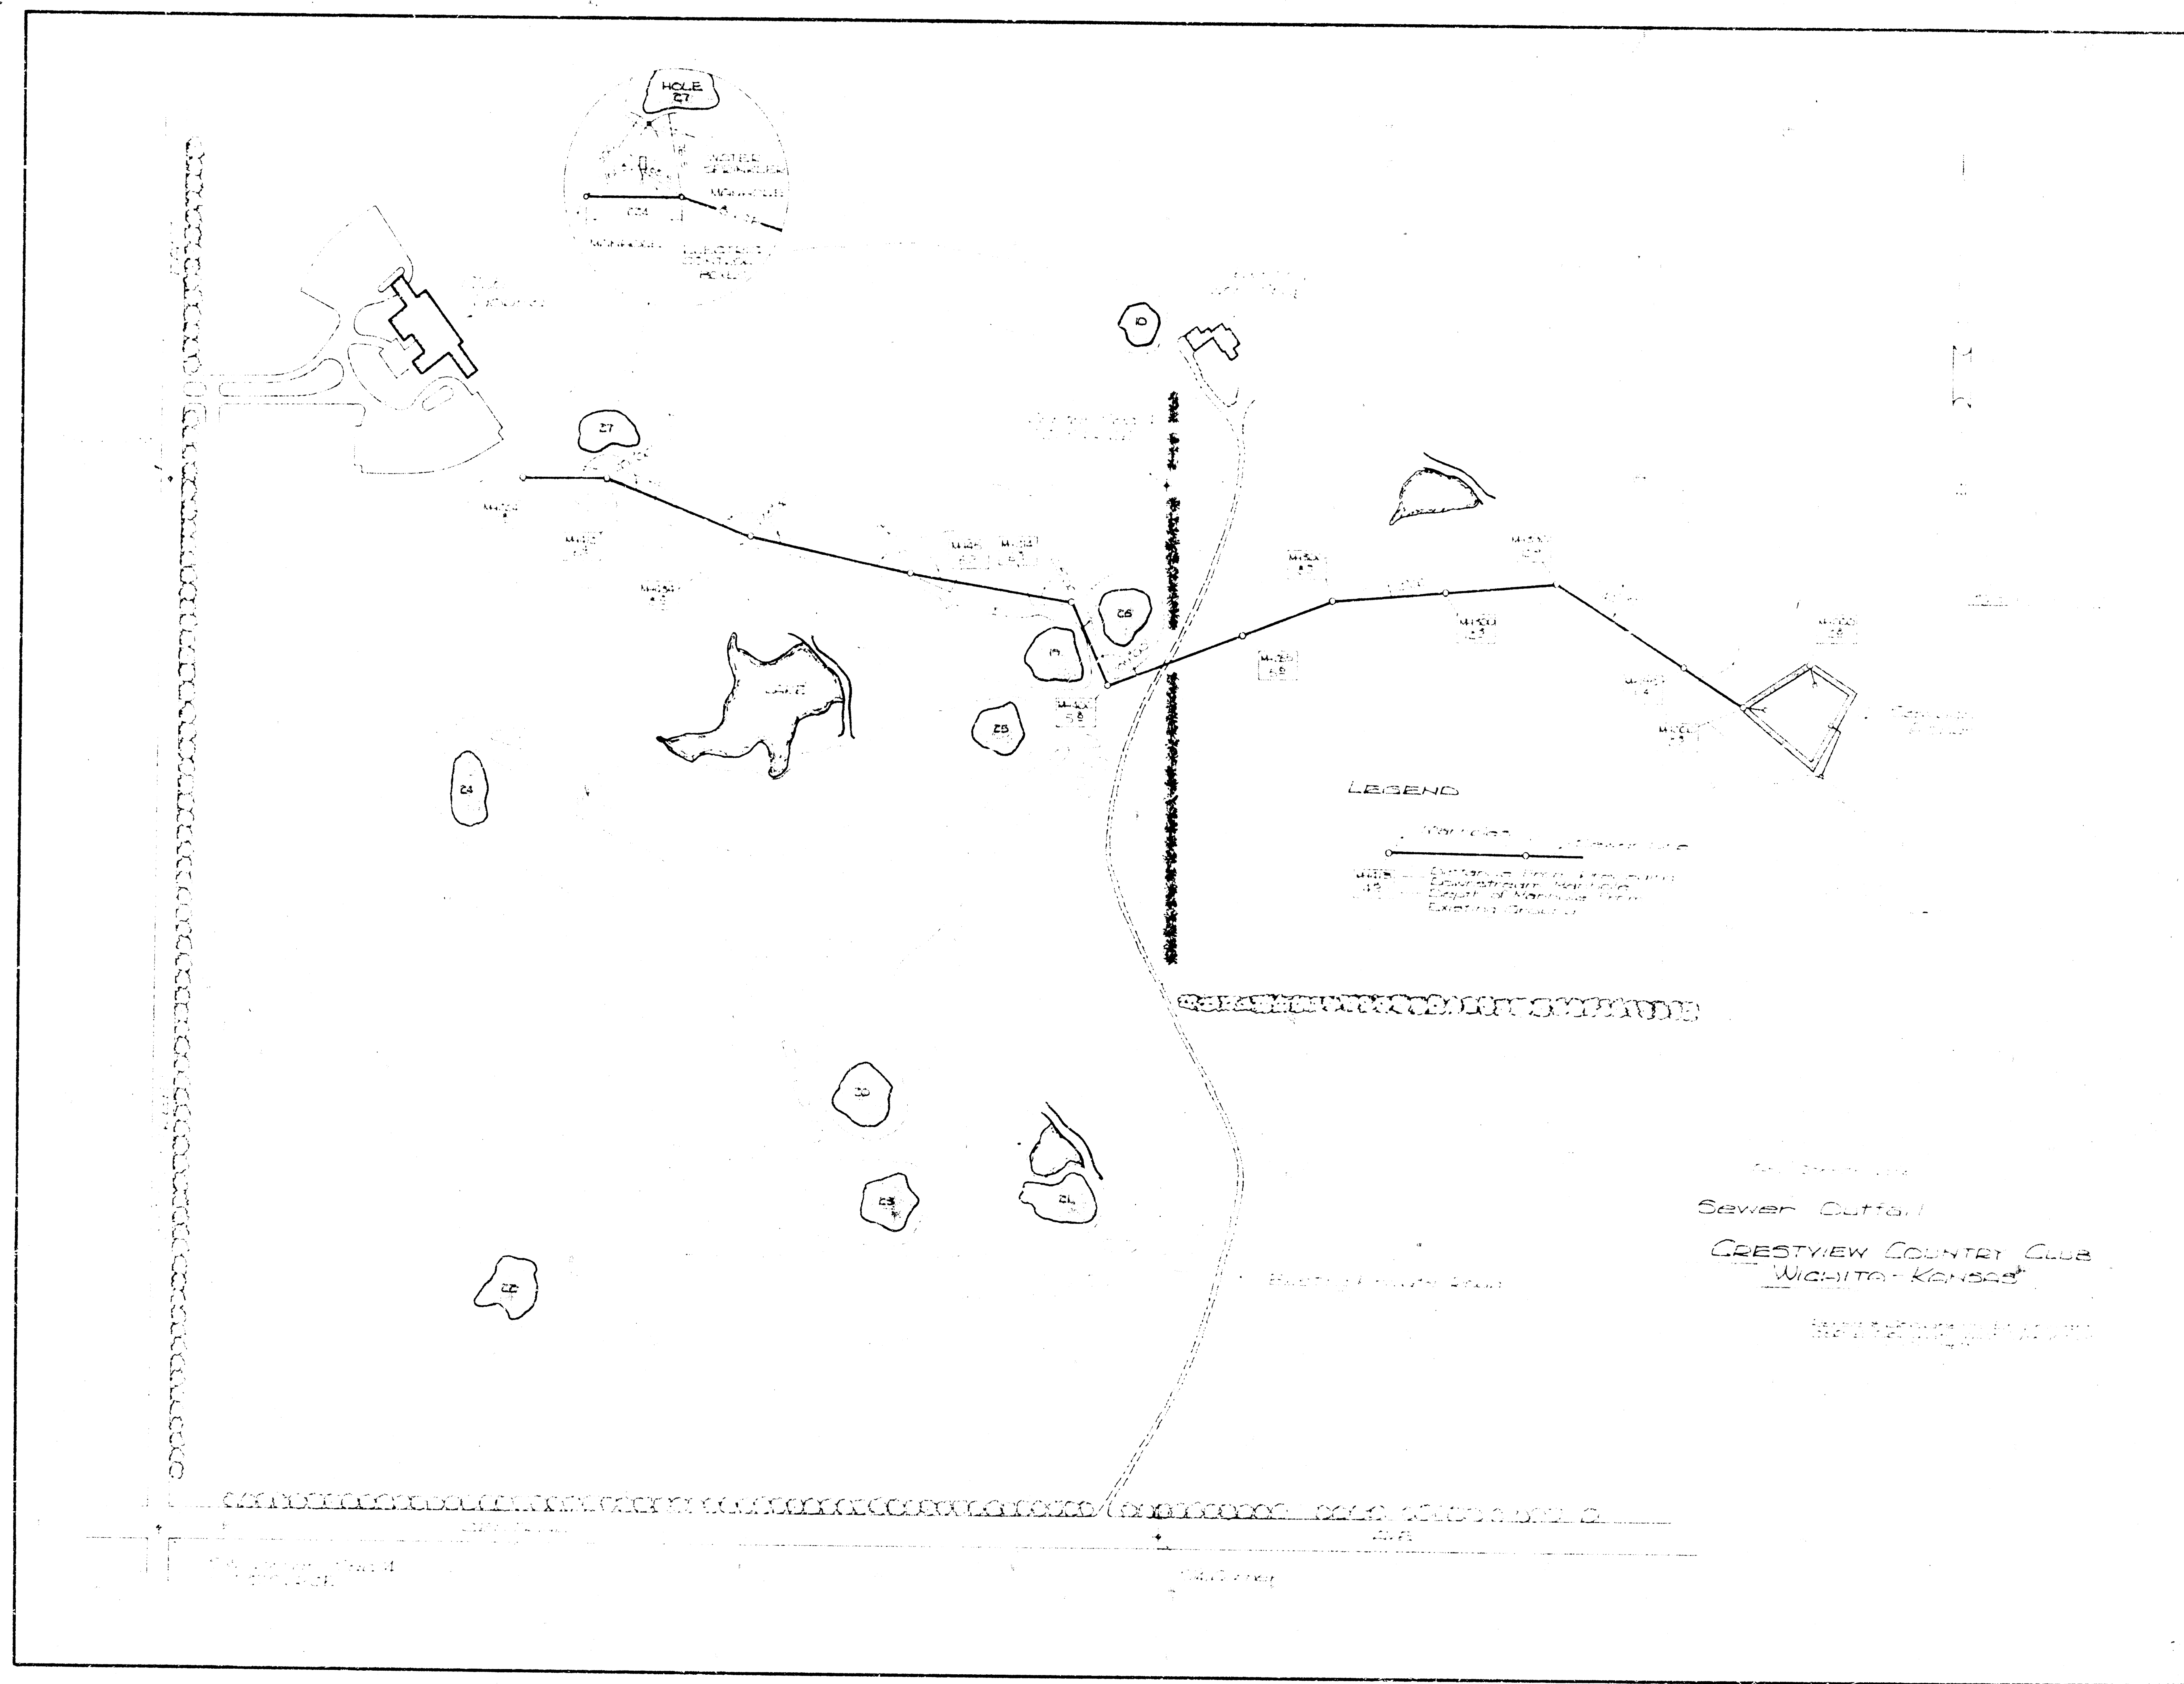

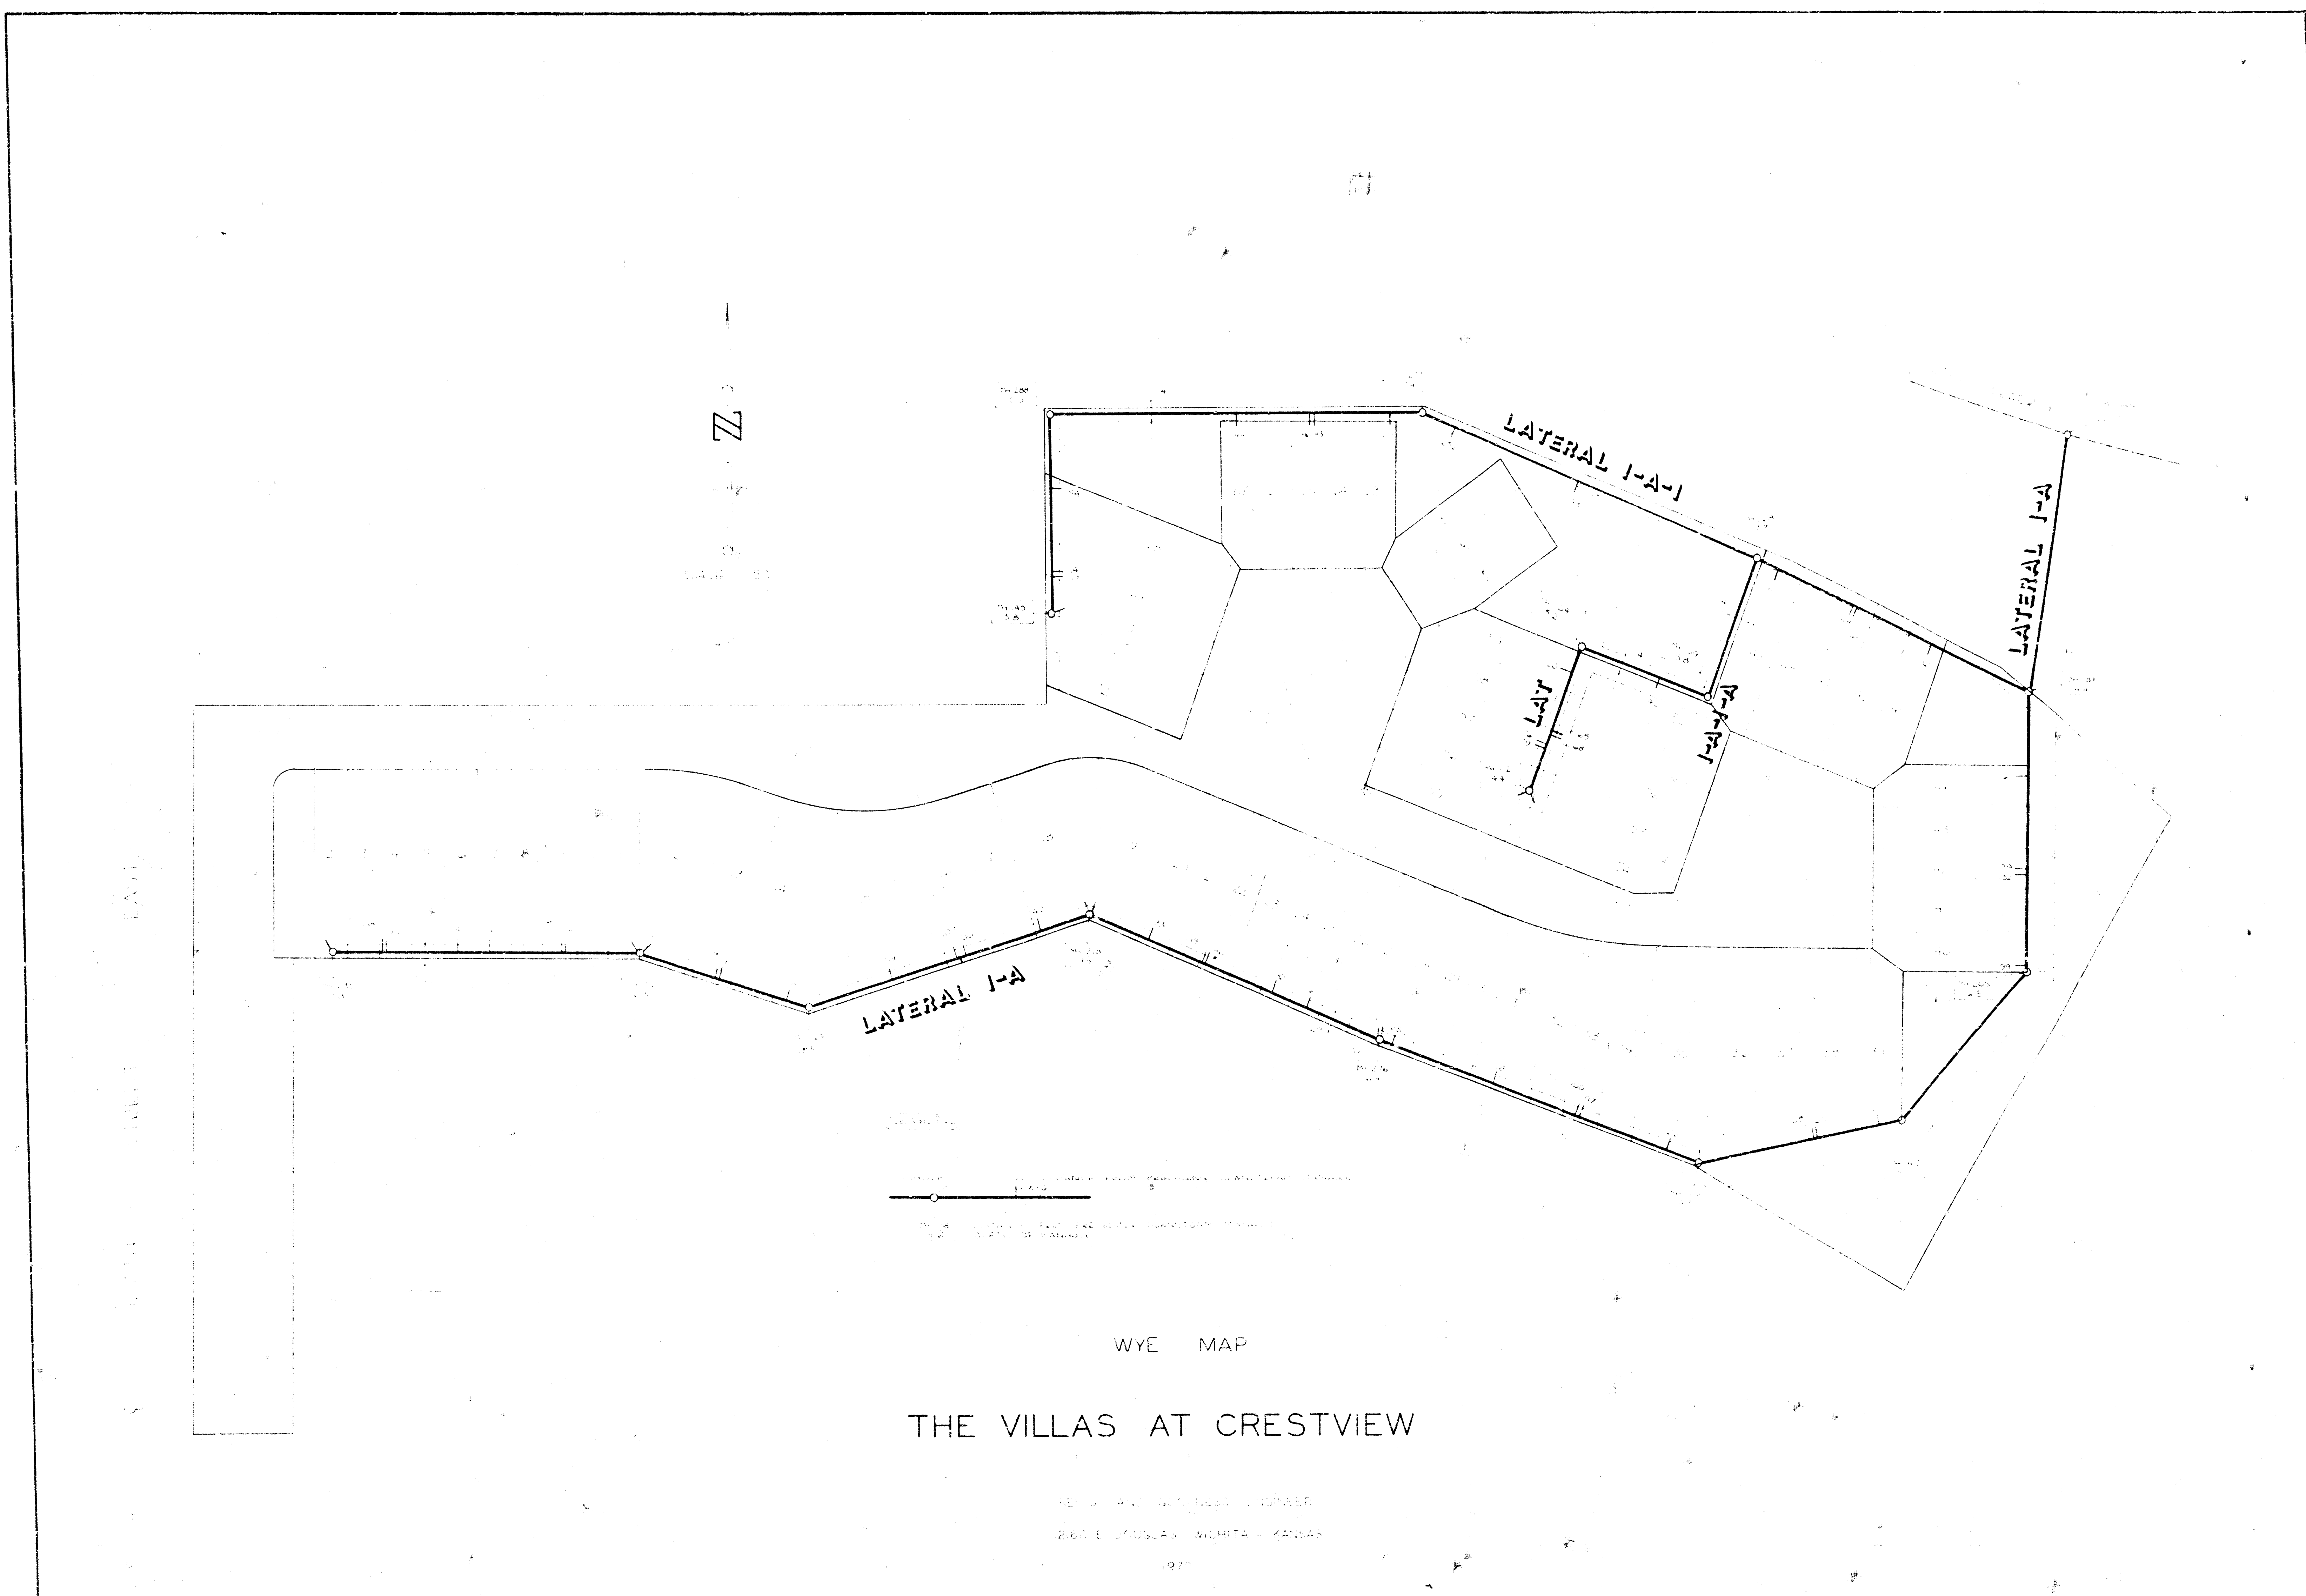


WYE MAP


THE VILLAS AT CRESTVIEW






 


 




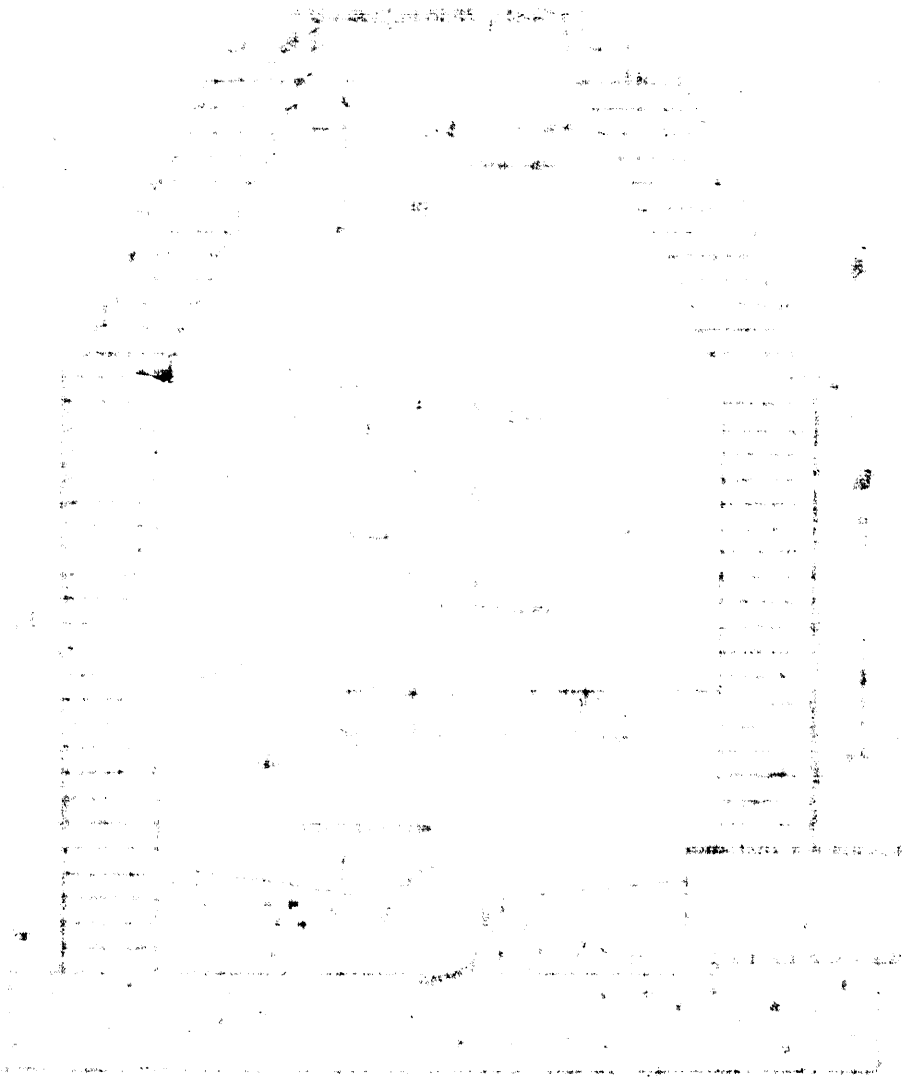


BRICK MANHOLE

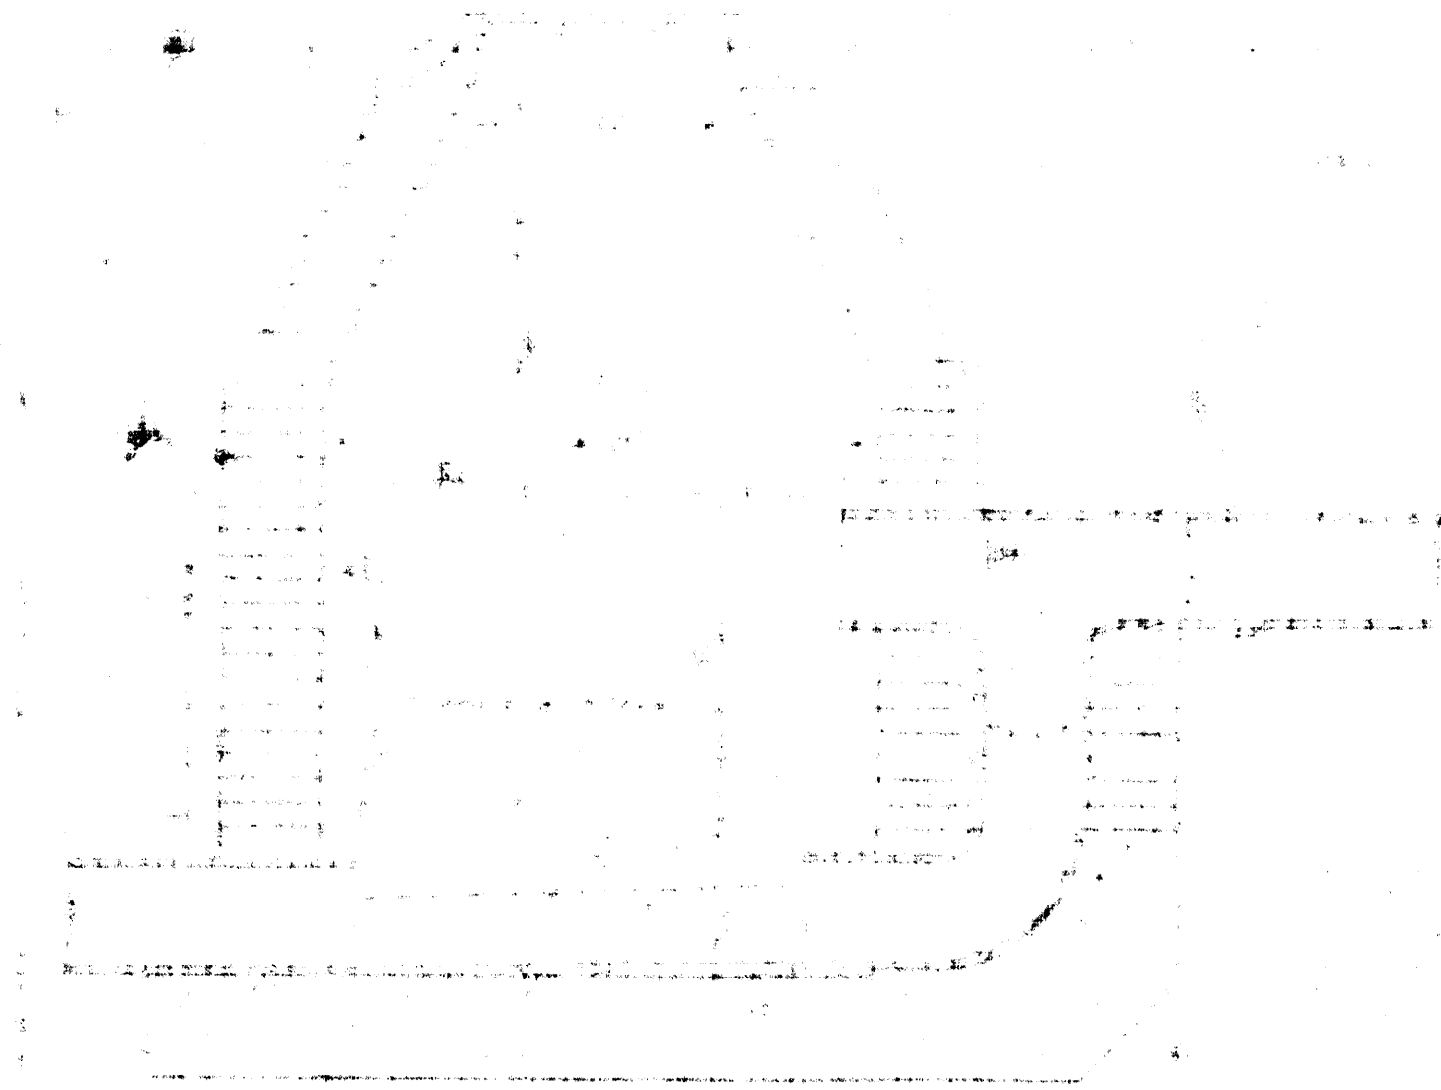


BRICK DROP MANHOLE

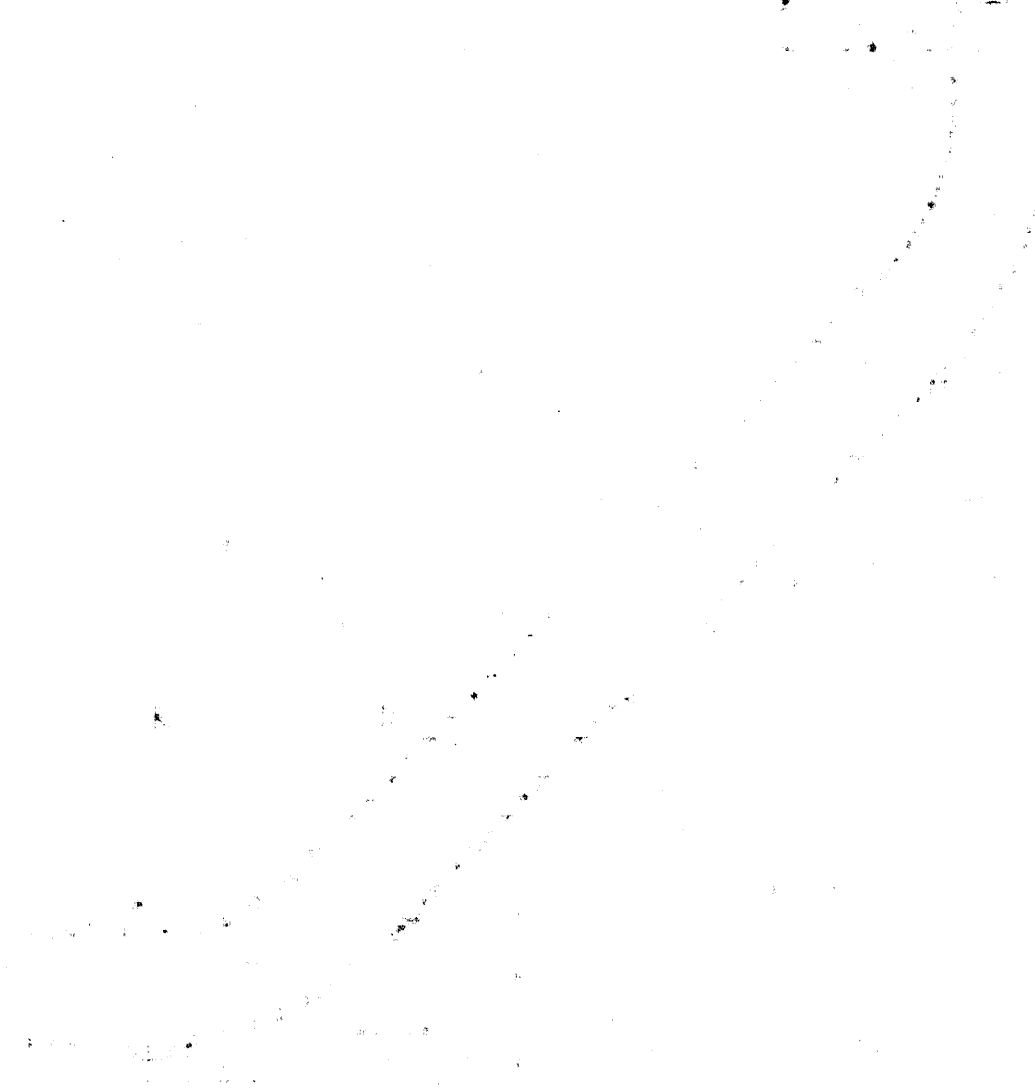


LAMP HOLE

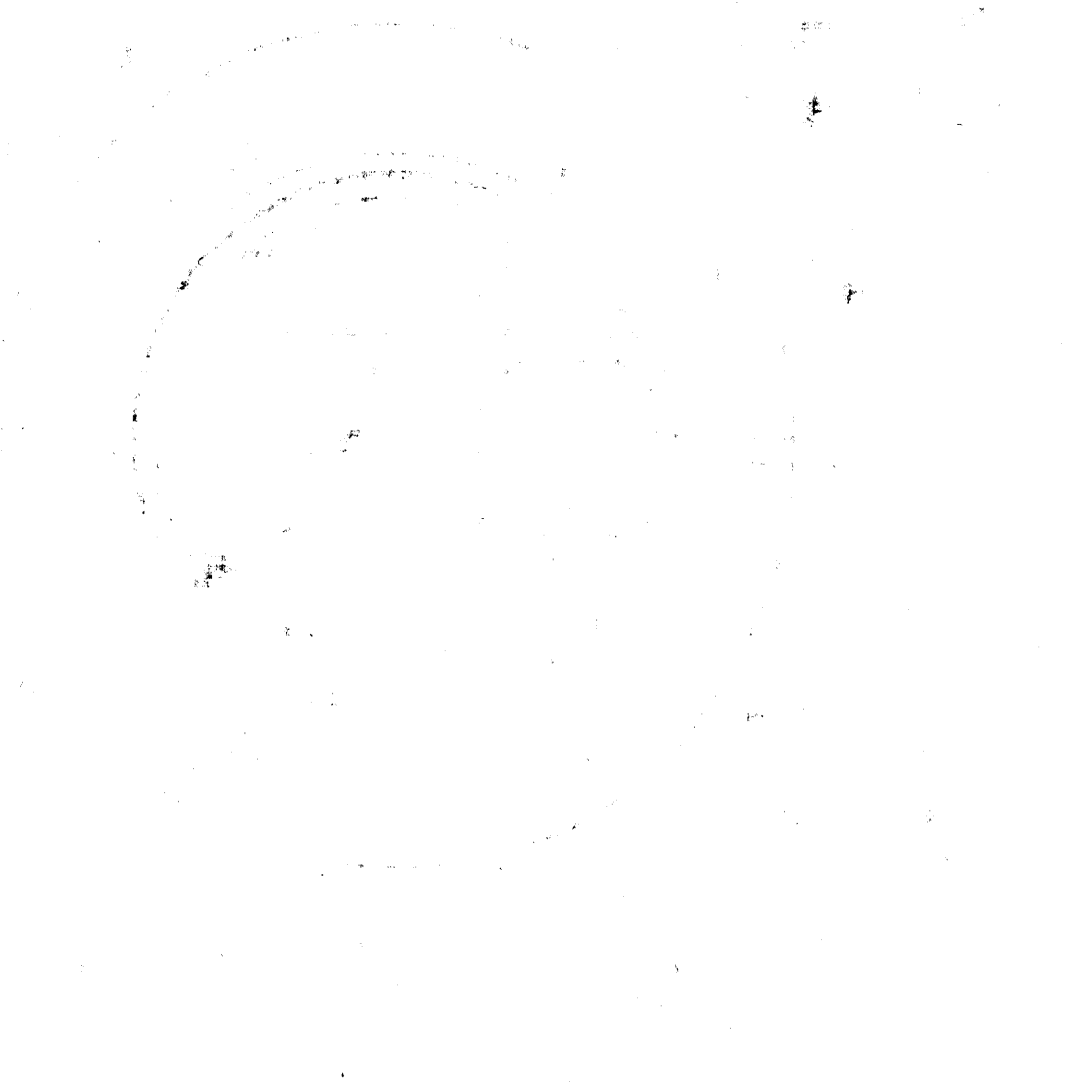


MANHOLE COVER

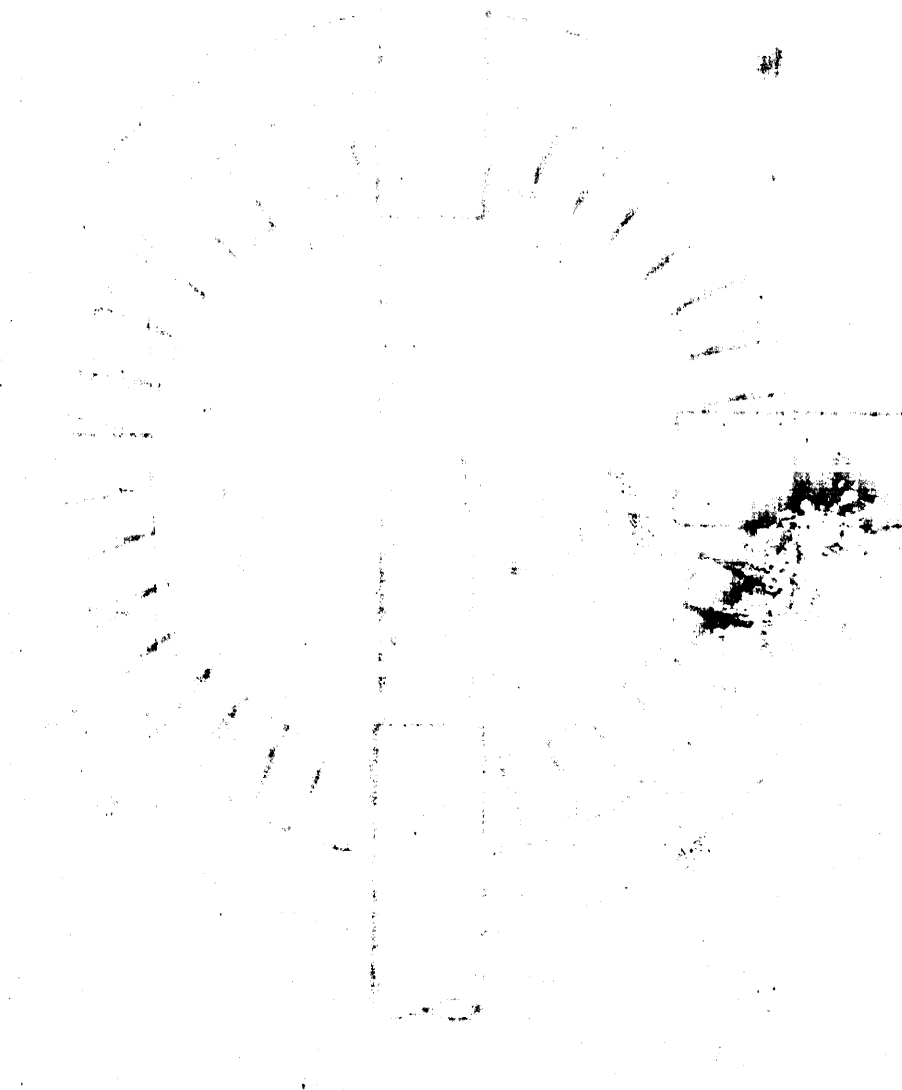

BRICK MANHOLE

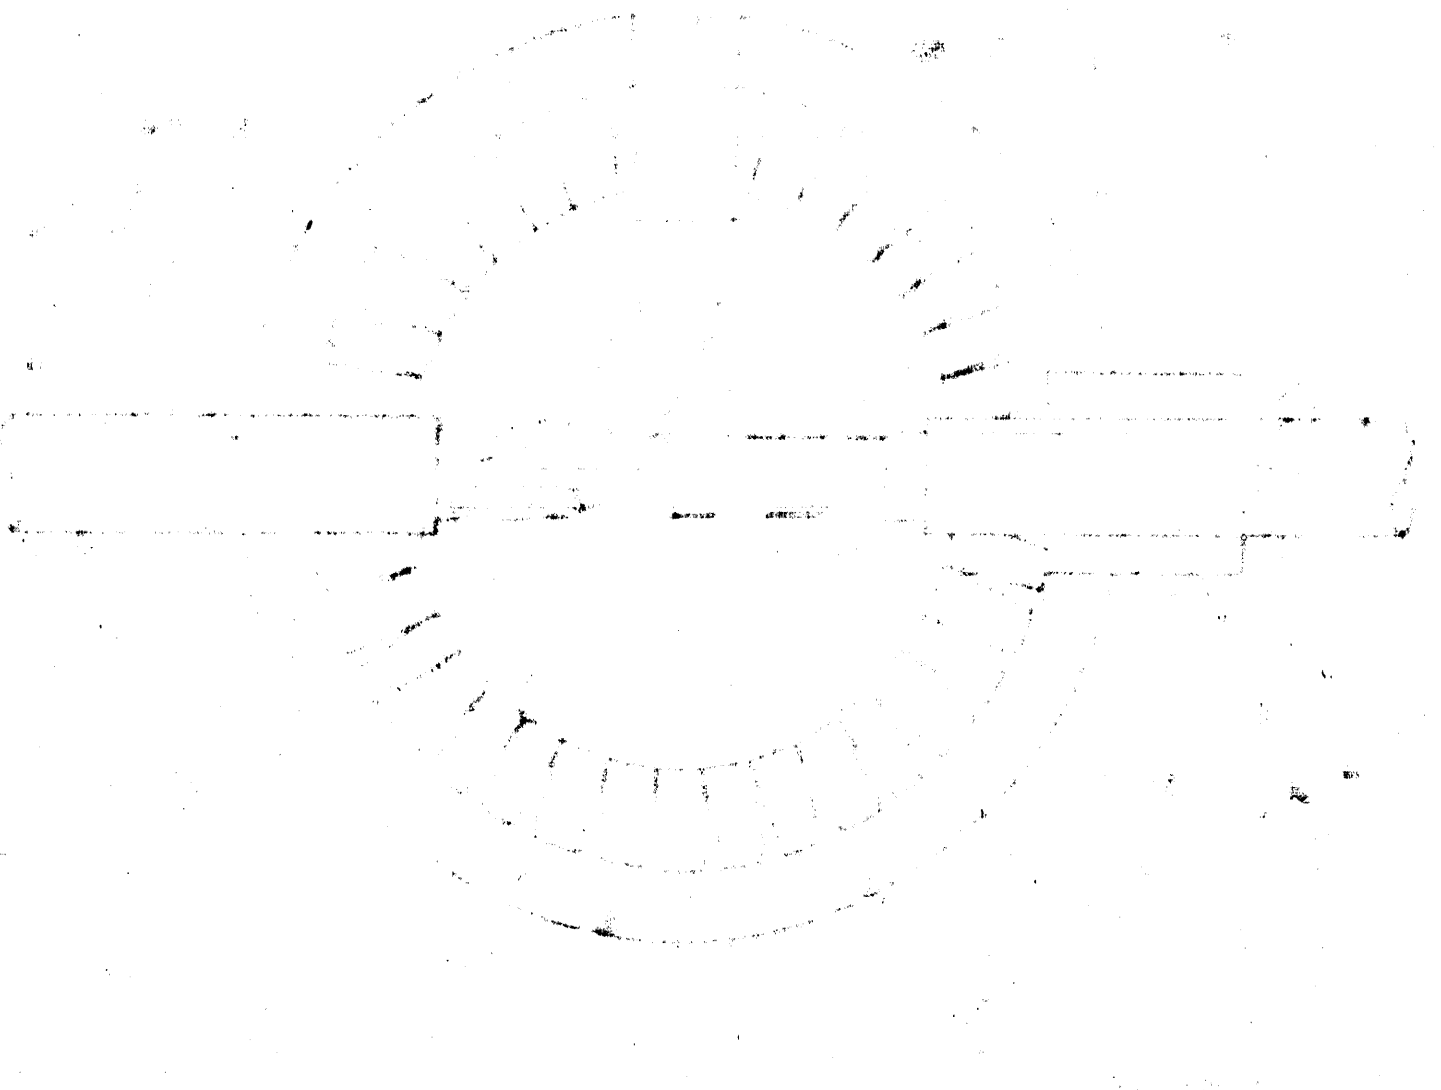

BRICK DROP MANHOLE

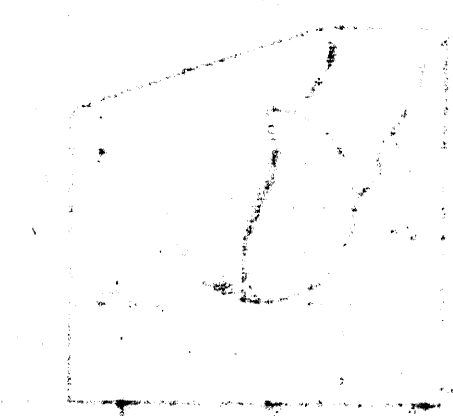

SERVICE CONNECTION



MANHOLE COVER

MANHOLE STEP

SERVICE CONNECTION

STANDARD DETAILS  
SEWERS  
APPLICABLE