BENCH MARK

R.R. Spike in NW face of P.P., 25' W. & 5' S. of SE corner Lot 1, Walnut Grove 5th Add.; elev. 133.60

NOTES

1. Contractor shall contact the Sewer Maintenance Division of the Dept. of Public Works to arrange for the taps on the existing 8" VCP (Lines 1 and 3). Any costs or fees for such taps shall be included in the Contractor's bid.
2. Contractor to verify locations of underground utilities prior to any excavation.
3. Contractor shall preserve property corner irons. Any such irons disturbed by the Contractors operations shall be re-established at the Contractor's expense, by a licensed surveyor in accordance with state law.
4. Trees and fences to be removed as necessary for construction.

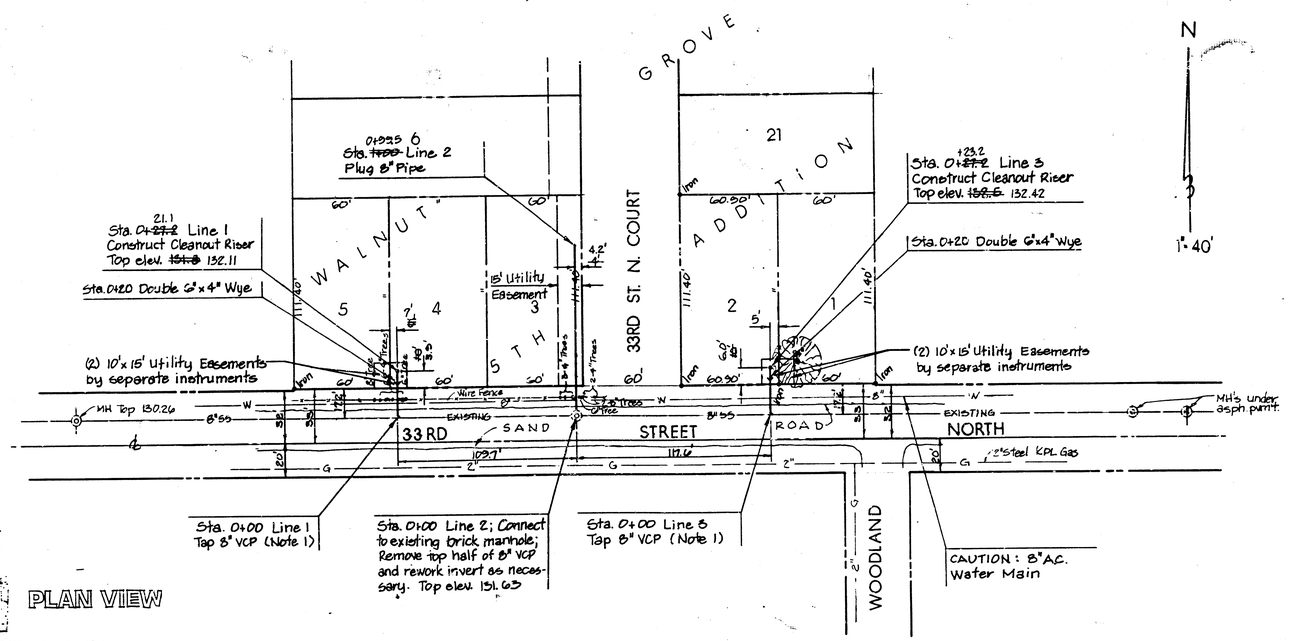

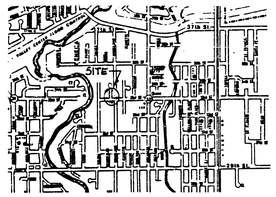

LOCATION MAP

APPROVED AS NOTED
CITY ENGINEER OF WICHITA
Sanitary Sewers EOB 12/30/88
Storm Sewers
Driveway Approaches
Water Mains
Paving

NOTE TO CONTRACTOR

INSPECTION AND TESTING FOR THIS PROJECT IS TO BE PROVIDED BY A LICENSED CONSULTING ENGINEERING FIRM UNDER CONTRACT WITH THE OWNER/DEVELOPER. SAID INSPECTION TO BE IN ACCORDANCE WITH THE CITY OF WICHITA STANDARD CONSTRUCTION SPECIFICATIONS AND ENGINEERING PRACTICES AND CERTIFIED BY A LICENSED PROFESSIONAL ENGINEER. NO WORK SHALL BE PERFORMED ON EASEMENTS OR THE PUBLIC RIGHT-OF-WAY EXCEPT UNDER THE DIRECT SUPERVISION OR CHARGE OF A LICENSED PROFESSIONAL ENGINEER. NO WORK SHALL BE PERFORMED ON EASEMENTS OR THE PUBLIC RIGHT-OF-WAY WITHOUT WRITTEN AUTHORIZATION OF THE CITY ENGINEER

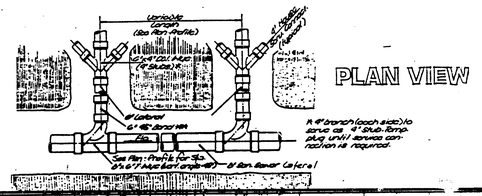

DETAIL CLEANOUT RISER ASSEMBLY

PROFILE SCALE

1" = 40' HORZ.
1" = 5' VERT.

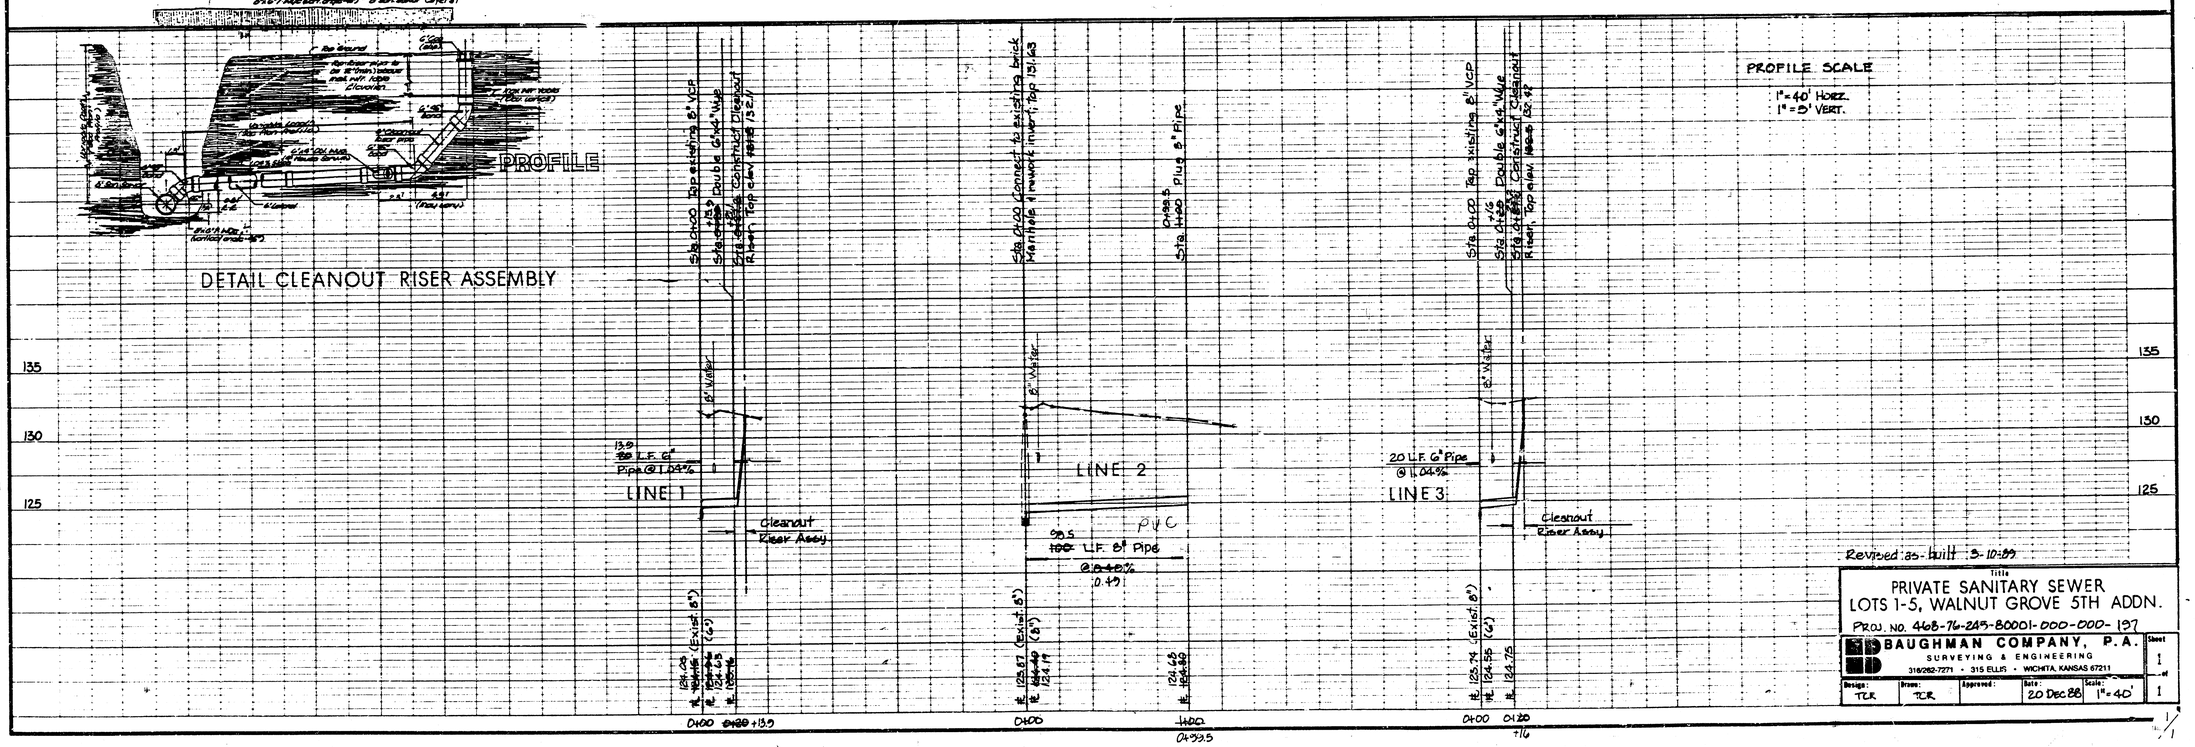

Revised: as-built 3-10-89

Title
PRIVATE SANITARY SEWER
LOTS 1-5, WALNUT GROVE 5TH ADDN.

PROJ. NO. 468-76-243-80001-000-000-137

BAUGHMAN COMPANY, P.A.
SURVEYING & ENGINEERING
316/262-7271 • 315 ELLIS • WICHITA, KANSAS 67211

Design:	Drawn:	Approved:	Date:	Scale:	Sheet	of
TCR	TCR		20 Dec 88	1" = 40'	1	1

FILMED FROM THE BEST AVAILABLE COPY