


PLAN
SCALE: 1" = 40'

PROFILE
SCALE: 1" = 10'

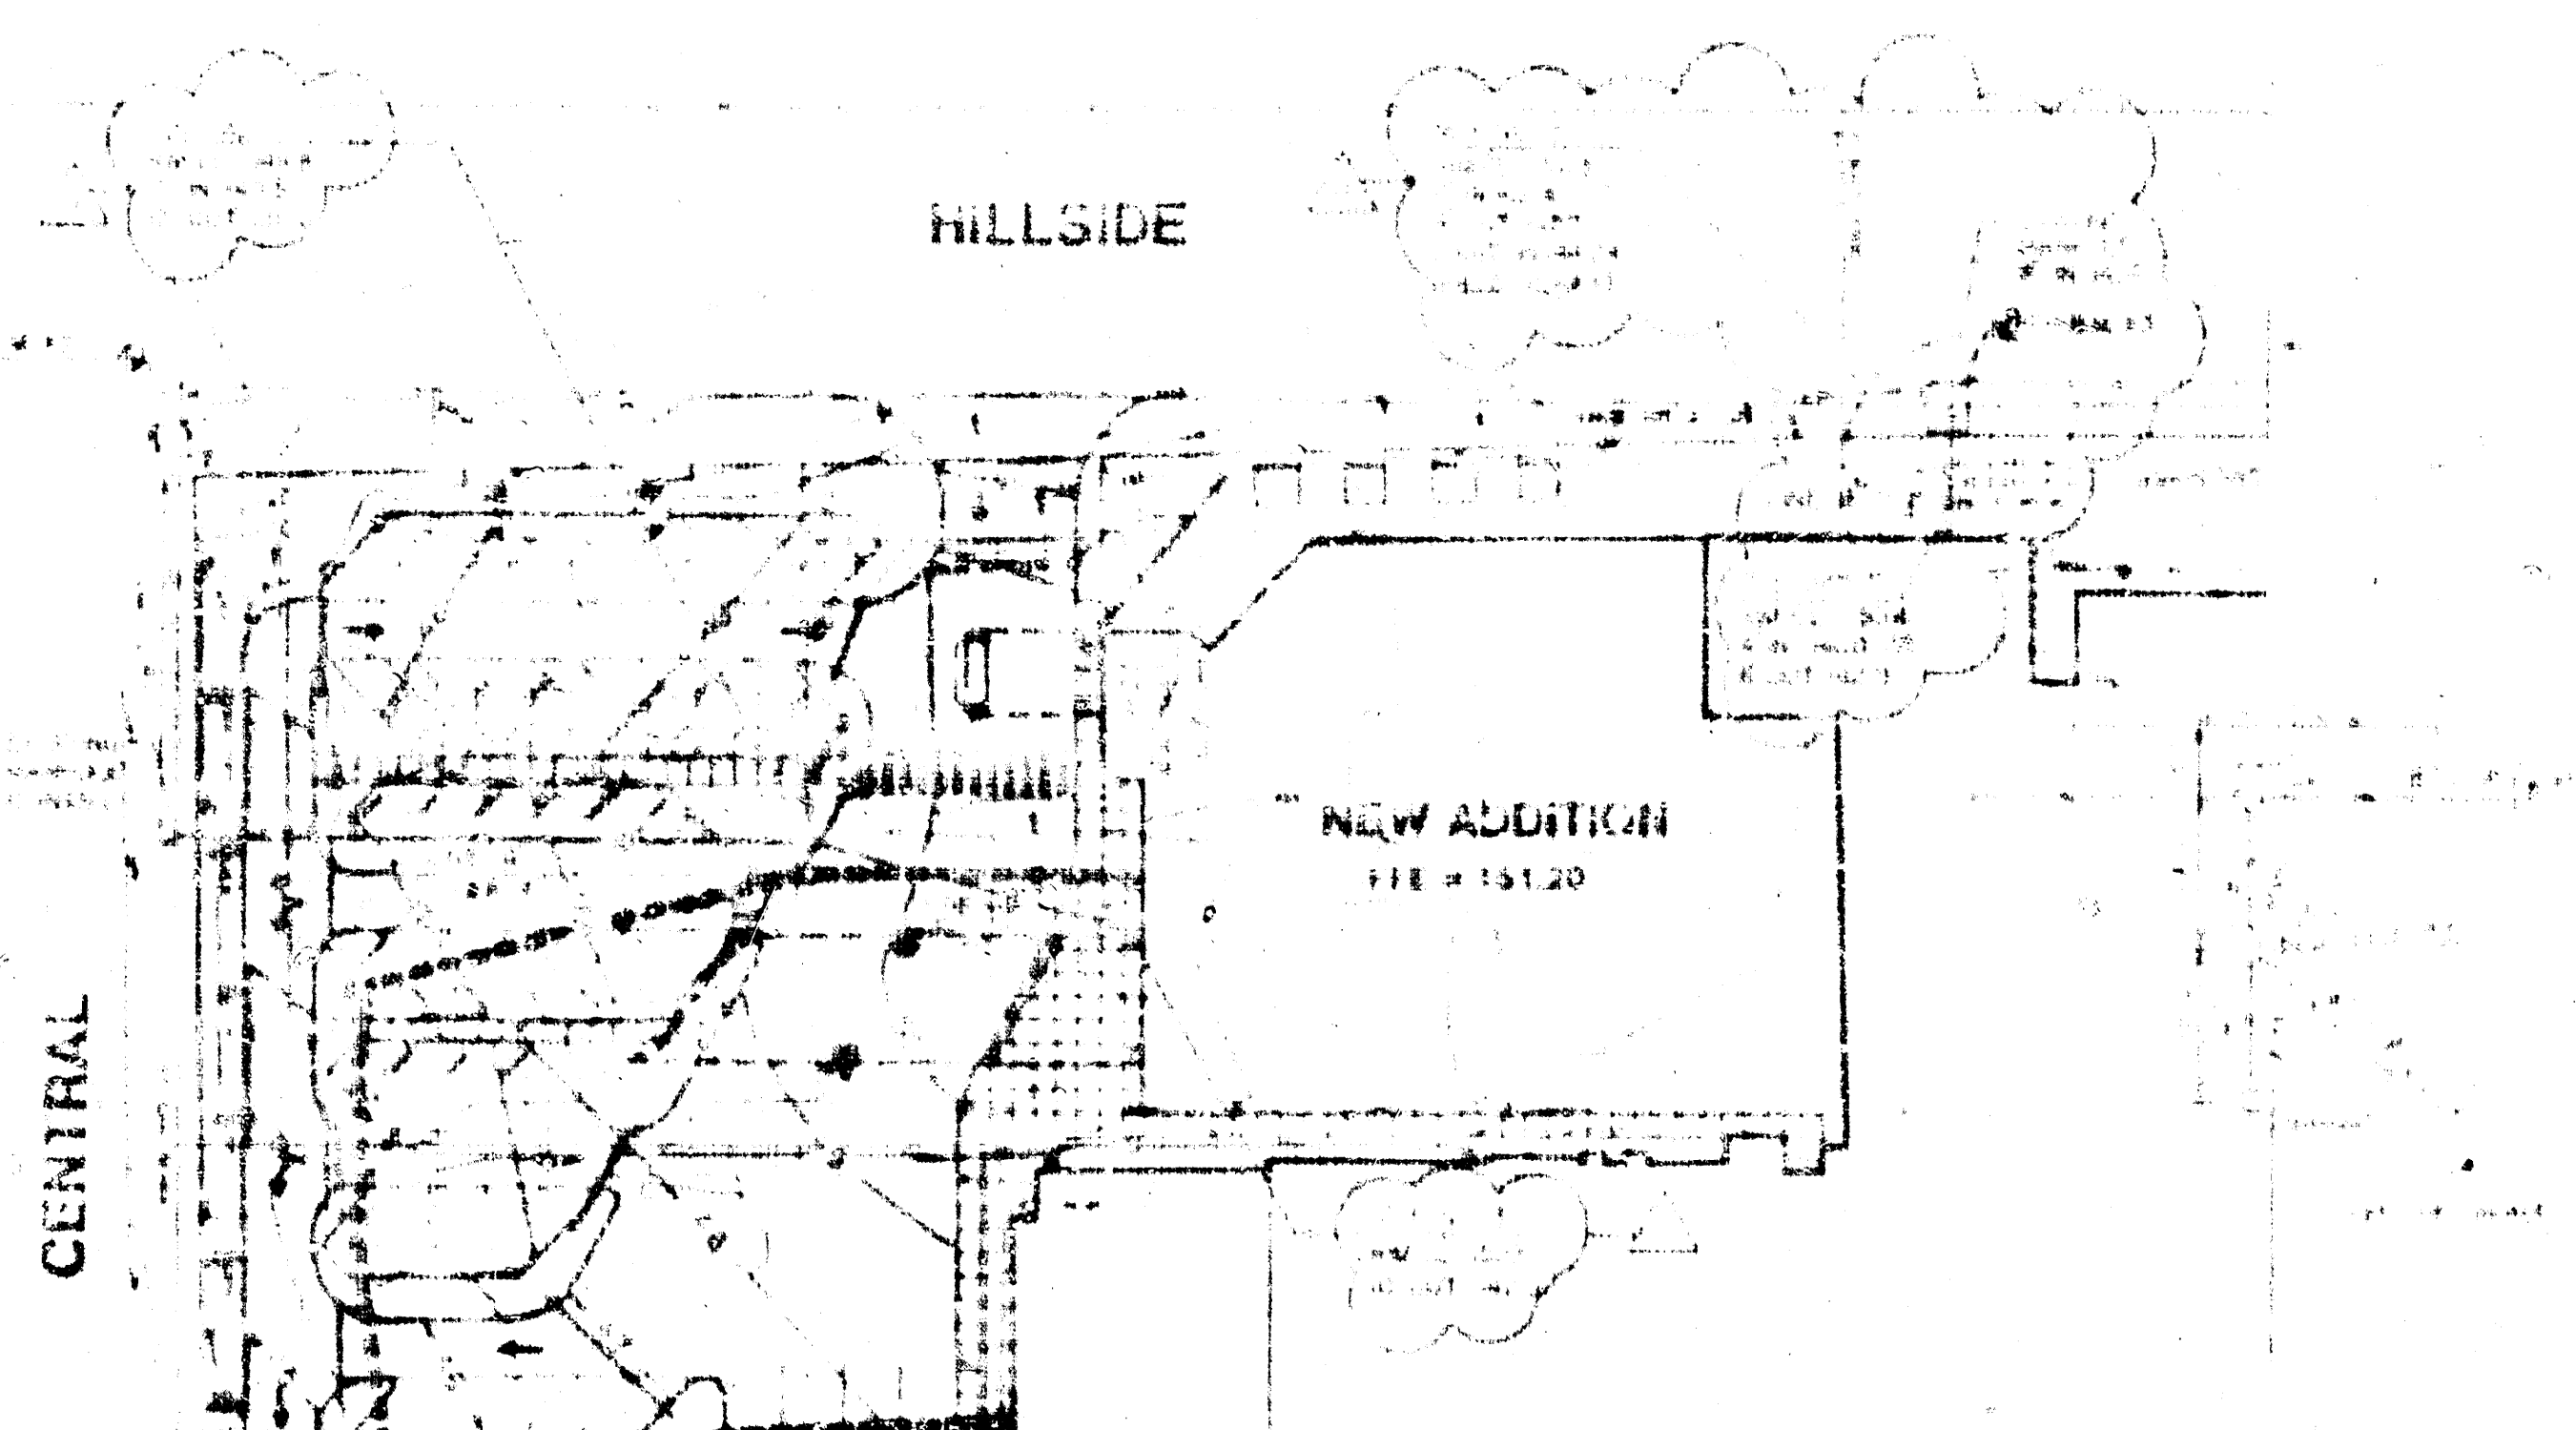

LEGEND





APPROVED AS SHOWN
BY CITY ENGINEER OF WICHITA
QUALITY REVIEW: *[Signature]*
DATE: *[Date]*
SEWER BOARD
CITY ENGINEER
CITY OF WICHITA



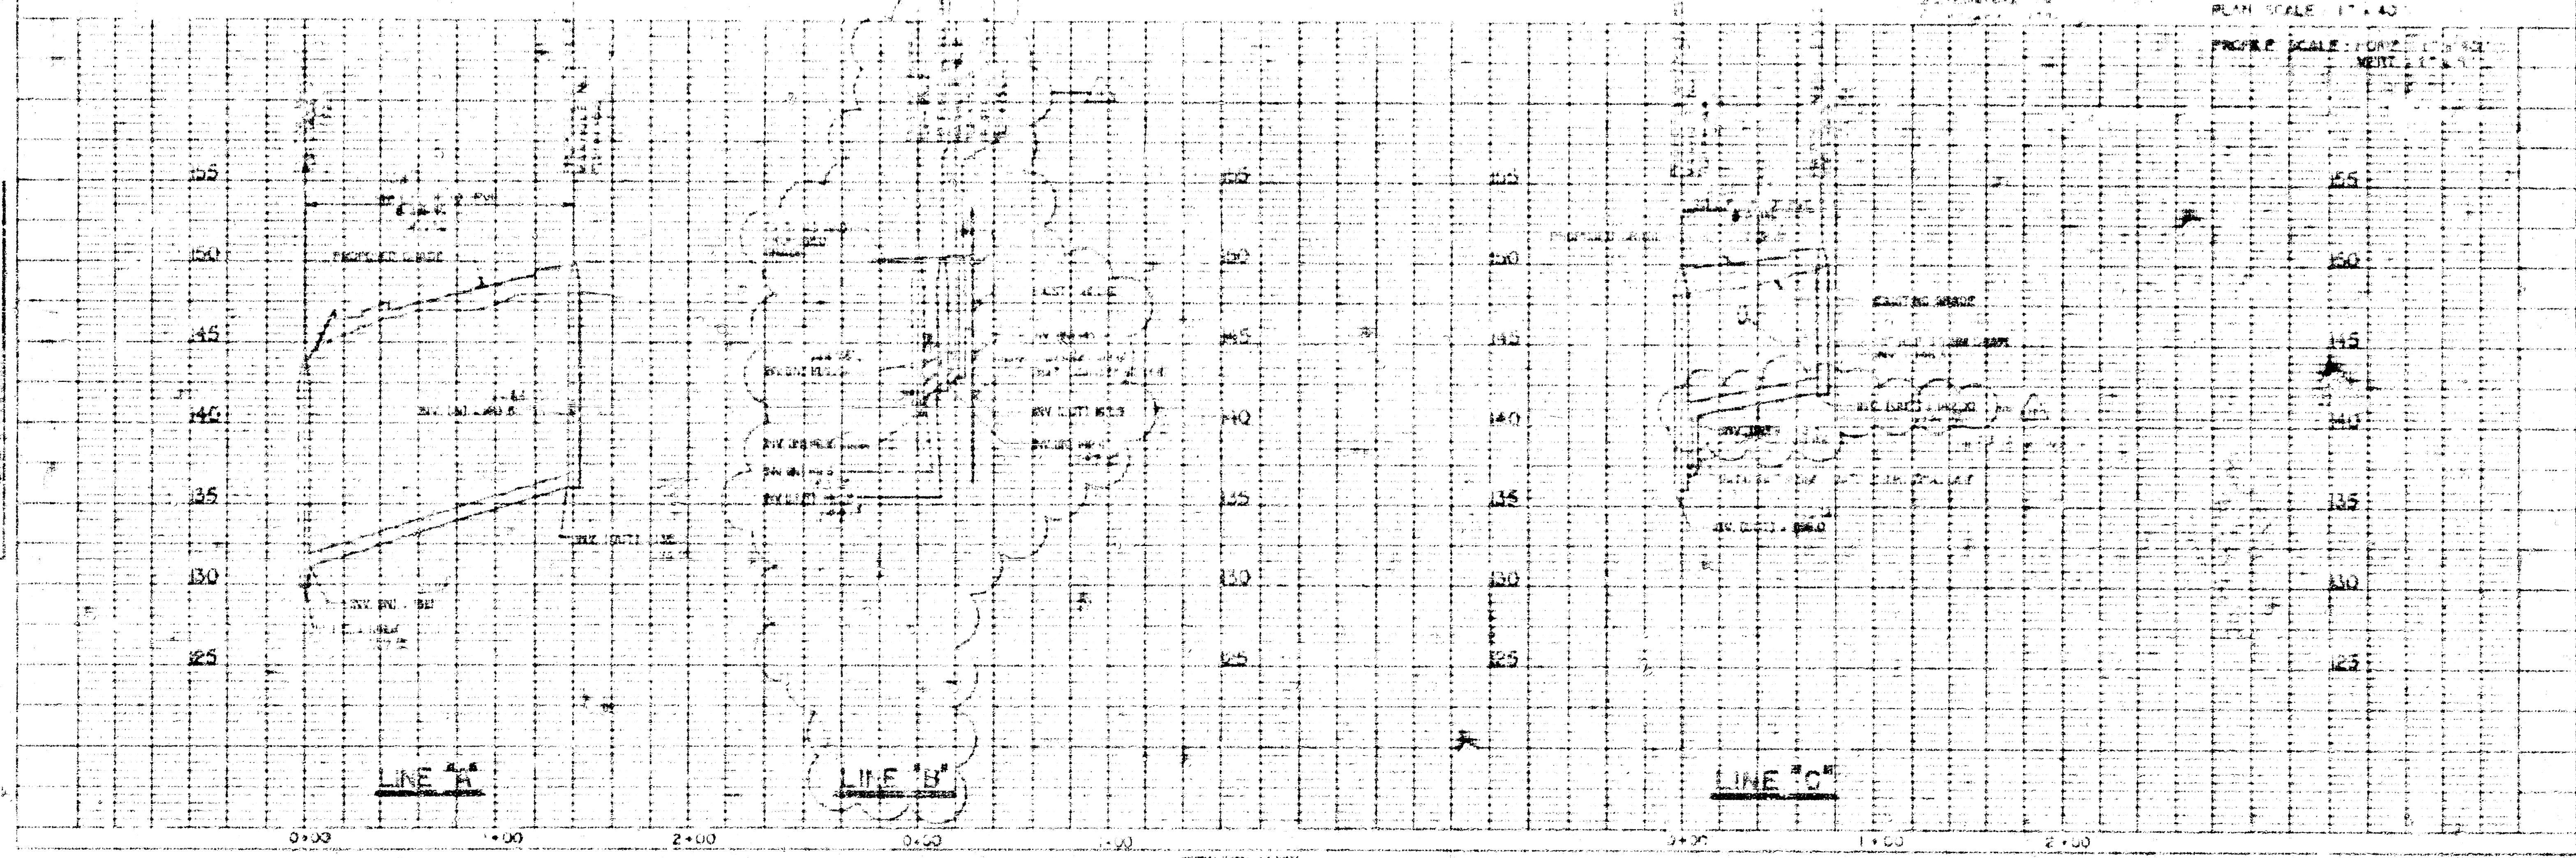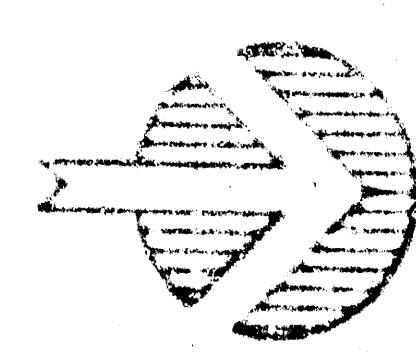

CITY OF WICHITA PRIVATE PROJECT NO. 302PPS(607A51)

VOLUME TWO

DATE: 10/1/84
BY: [Signature]

GOULD TURNER GROUP, P.C.
ARCHITECTS & PLANNERS



WESLEY MEDICAL CENTER
ADDITIONS AND RENOVATIONS
WICHITA, KANSAS
HCA, Inc.



SANITARY SEWER PLAN AND PROFILE

CA-13

FILED FROM THE BEST