**BENCH MARKS:**

City Disc @ Pawnee and Sheridan, Elev. = 103.29 City Datum

"X" Cut on High Edge West Side of Sheridan 107' South Line of Lot 1, Blk 1, Westport Industrial Park First Addition. Elev. = 102.68 City Datum

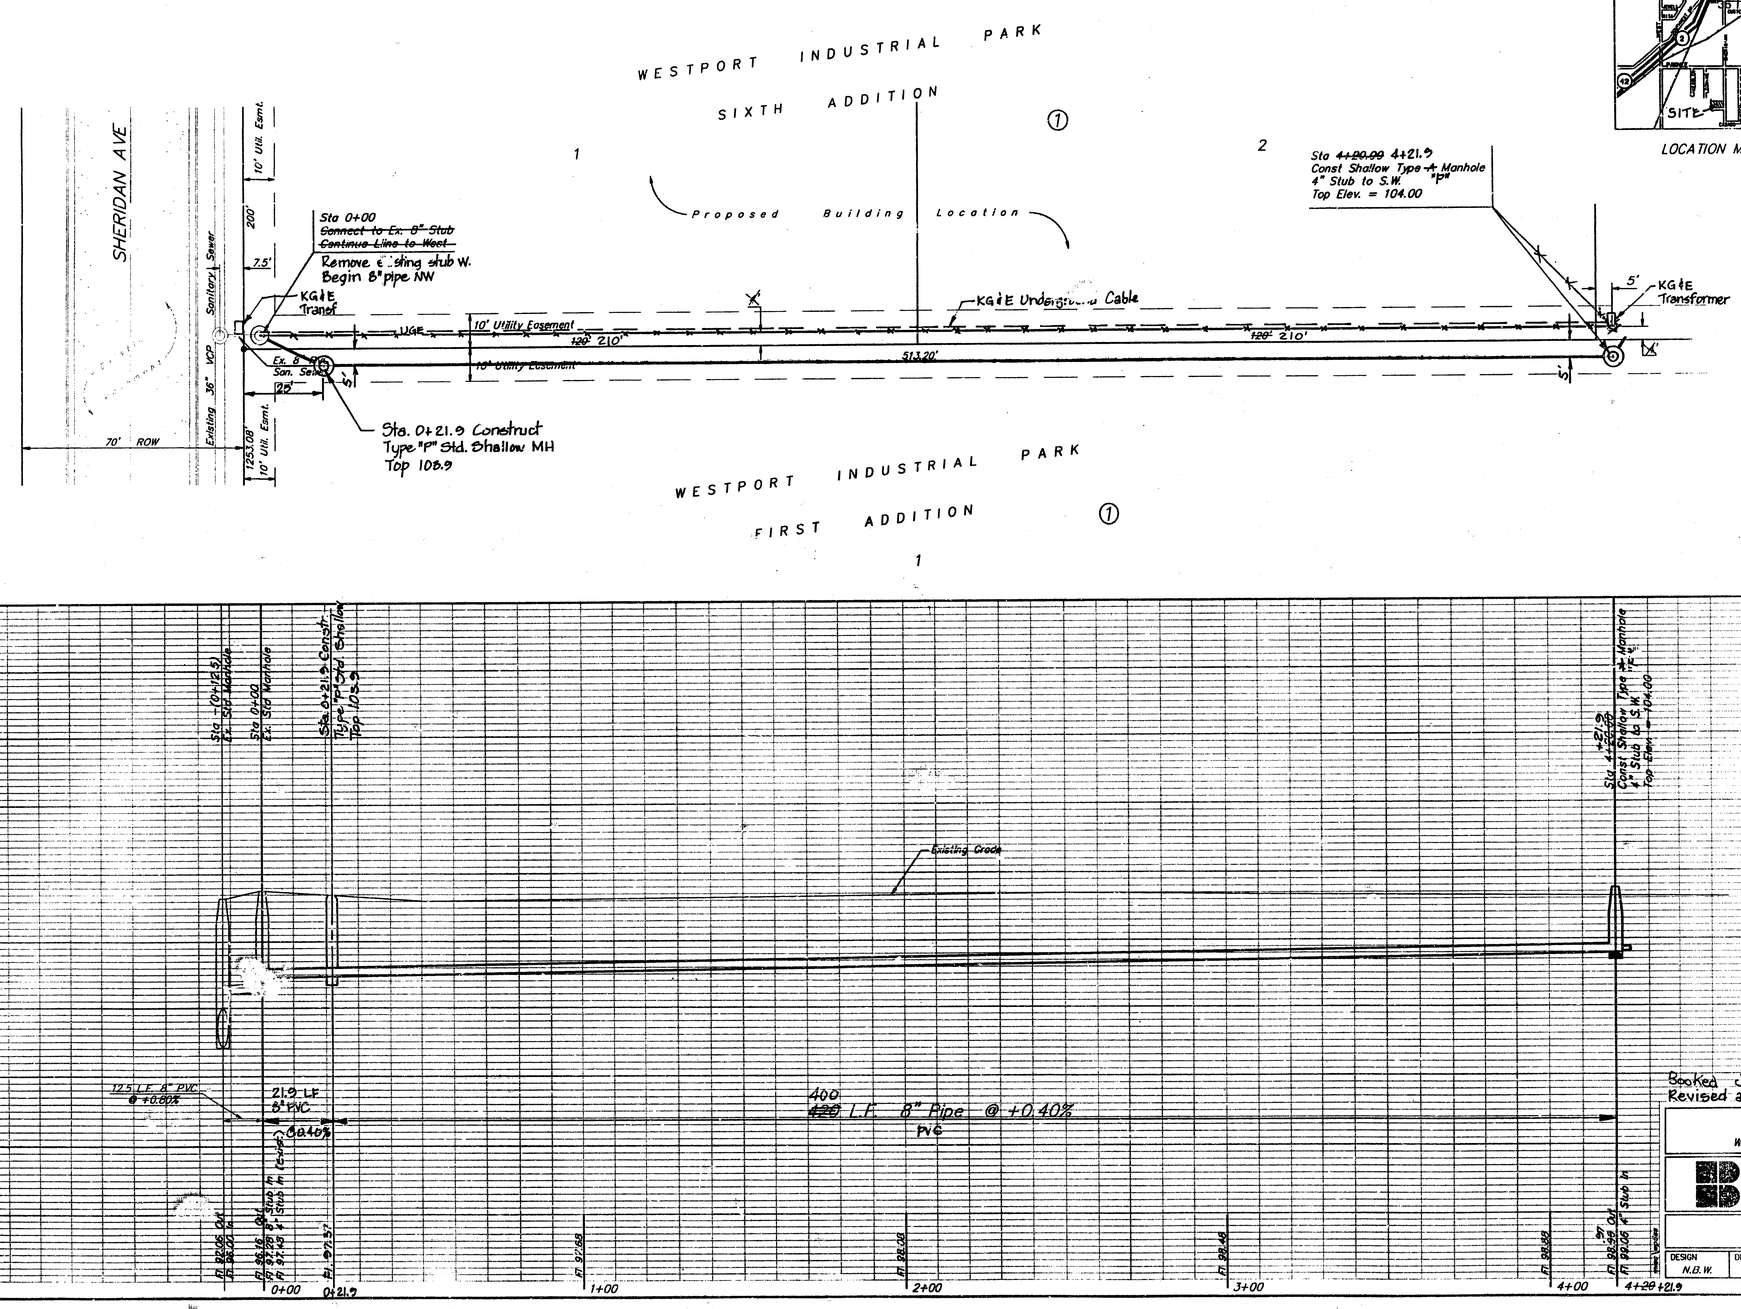


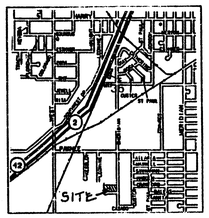


LOCATION MAP

Plan: 1" = 20'-0"
Profile: 1" = 5'-0"
● = Iron

APPROVED AS NOTED
BY CITY ENGINEER OF WICHITA
Sanitary Sewers RH 9/19/91
Storm Sewers
Driveway Approaches
Water Mains
Paving

NOTE TO CONTRACTORS

Inspection and testing for this project is to be provided by a Licensed Consulting Engineering Firm under contract with the Owner/Developer. Said inspection to be in accordance with the City of Wichita standard construction engineering practices and certified by a Licensed Professional Engineer. No work shall be performed in dedicated easements or public right-of-way by the Contractor without such inspection nor shall any work be commenced without written authorization by the City Engineer.




Booked JKB 2-12-92
Revised as built 10-9-91 TCR

PRIVATE SANITARY SEWER
TO SERVE LOTS 1, 2, & 3; BLK 1
WESTPORT INDUSTRIAL PARK SIXTH ADDITION

BAUGHMAN COMPANY P. A.
ENGINEERING & SURVEYING
316/262-7271 • 315 ELLIS • WICHITA, KANSAS 67211

| PROJECT NUMBER | SHEET |
|---|---|
| 305PPS (607861) | 1 OF 1 |

| DESIGN | DRAWN | UTIL. CHECK'D | DATE | SCALE |
|---|---|---|---|---|
| N.G.W. | P.J.M. | | SEPT 91 | as noted |

FILMED FROM THE BEST AVAILABLE COPY