
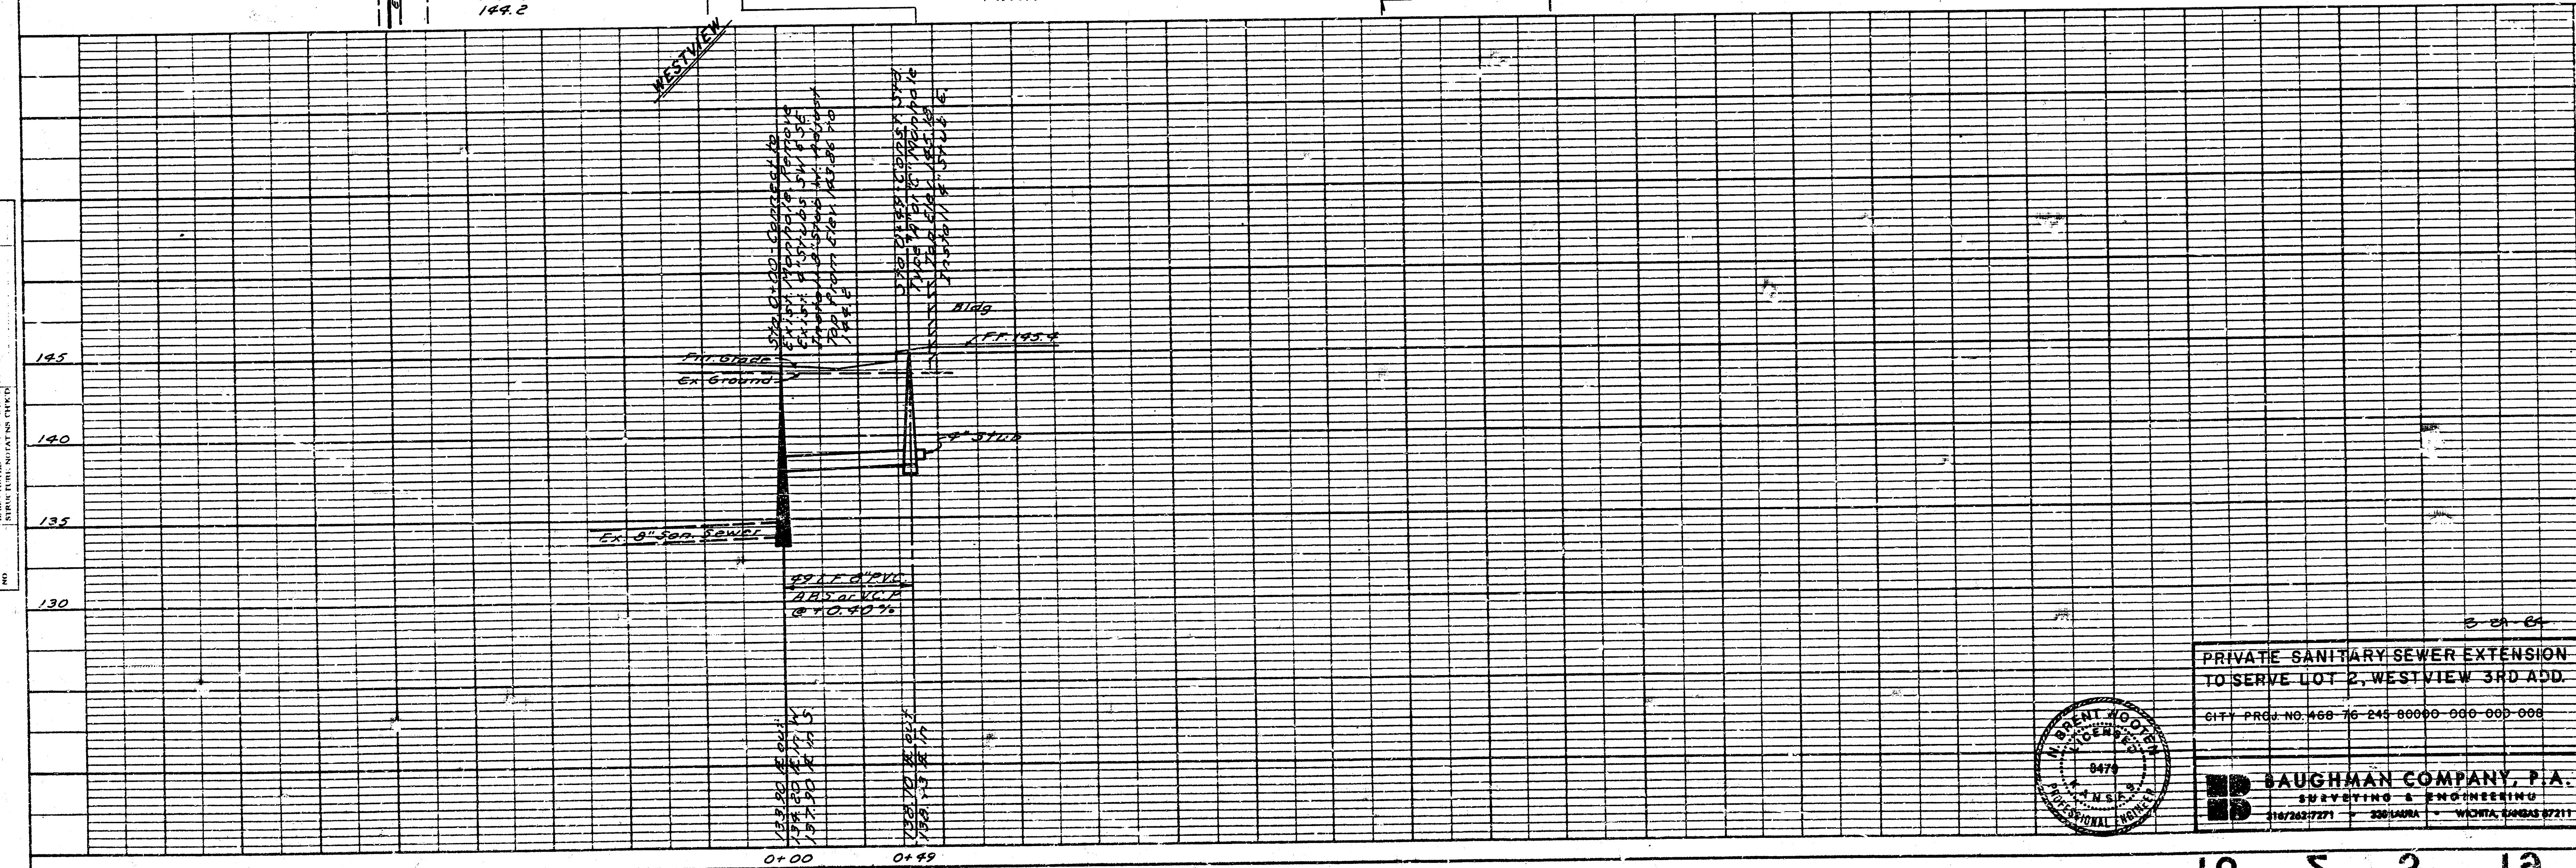
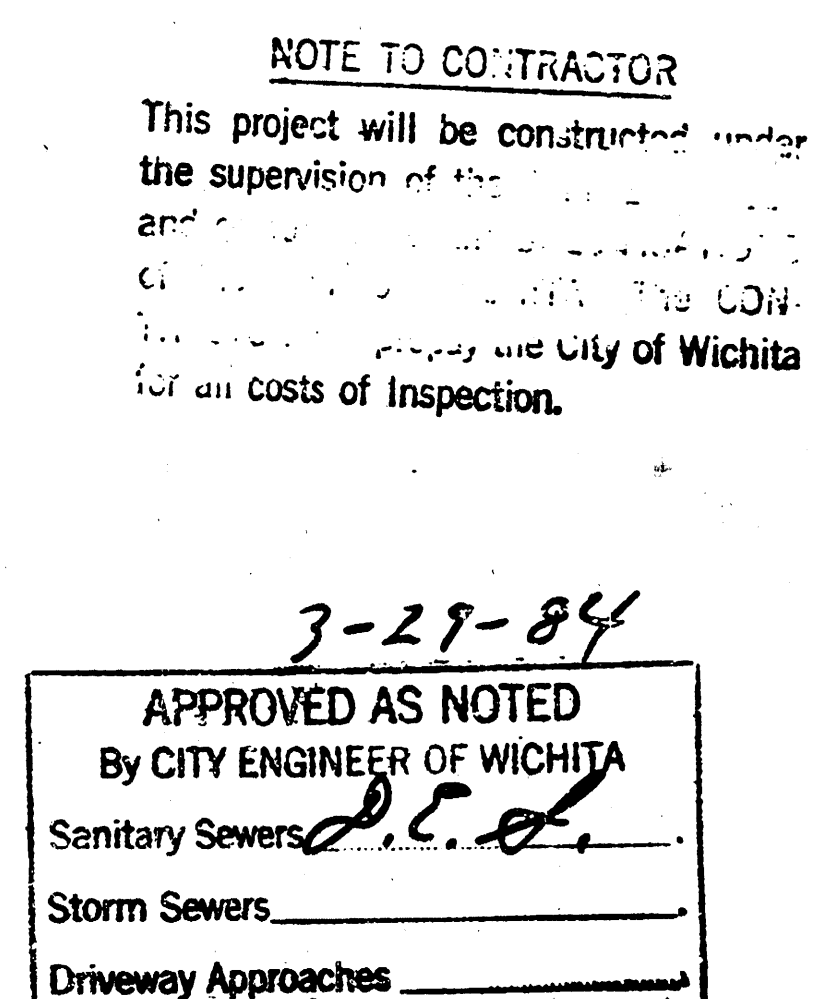


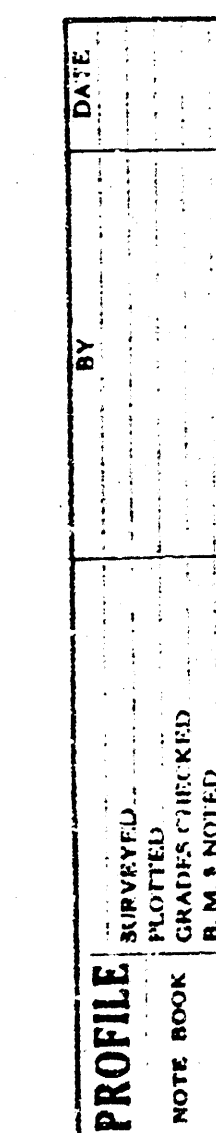

PRIVATE SANITARY SEWER EXTENSION
TO SERVE LOT 2, WESTVIEW 3RD ADD.
CITY PROJ. NO. 466-76-245-00000-000-000-000

BAUGHMAN COMPANY, P.A.
SURVEYING & ENGINEERING
216/263-7271 • 200 LAURA • WICHITA, KANSAS 67211

PLATE 1 - PLAN - PROFILE - F.A.S.
CLEARPRINT PAPER CO., S. F. CAL.
NO. 1000H-1

10 5 3 10