




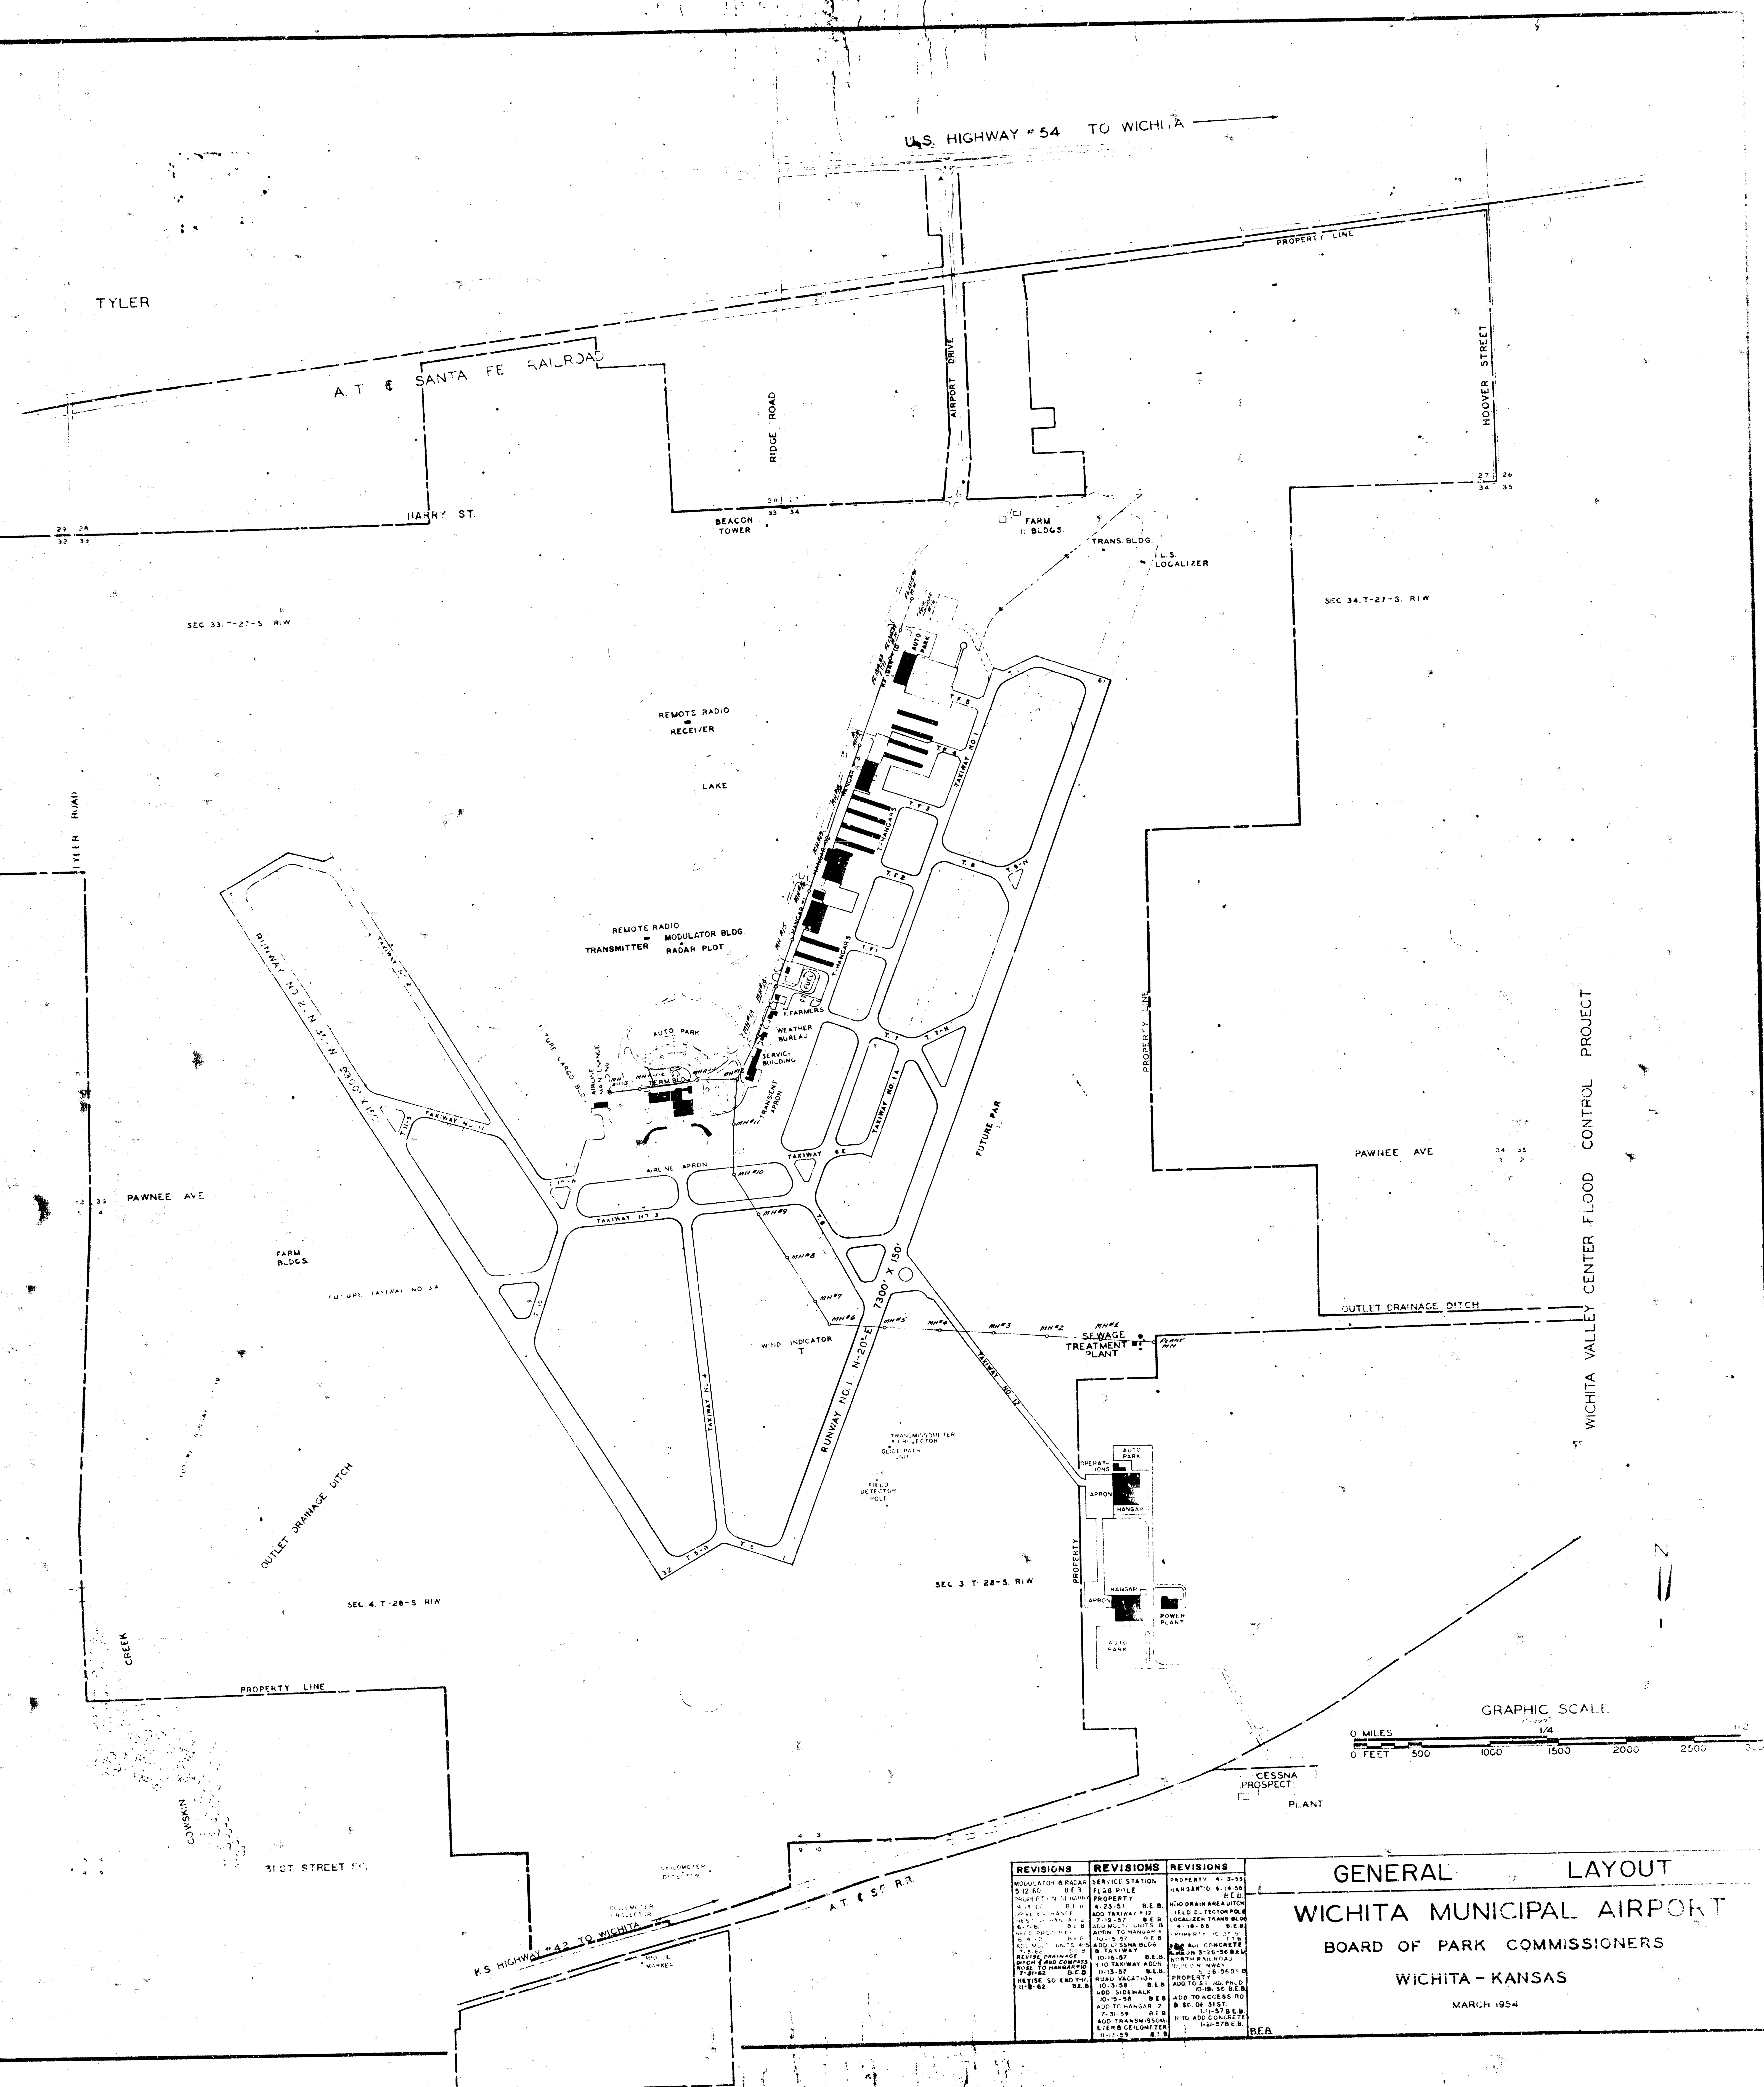


PLAN
 NO.


PROFILE
 NO.

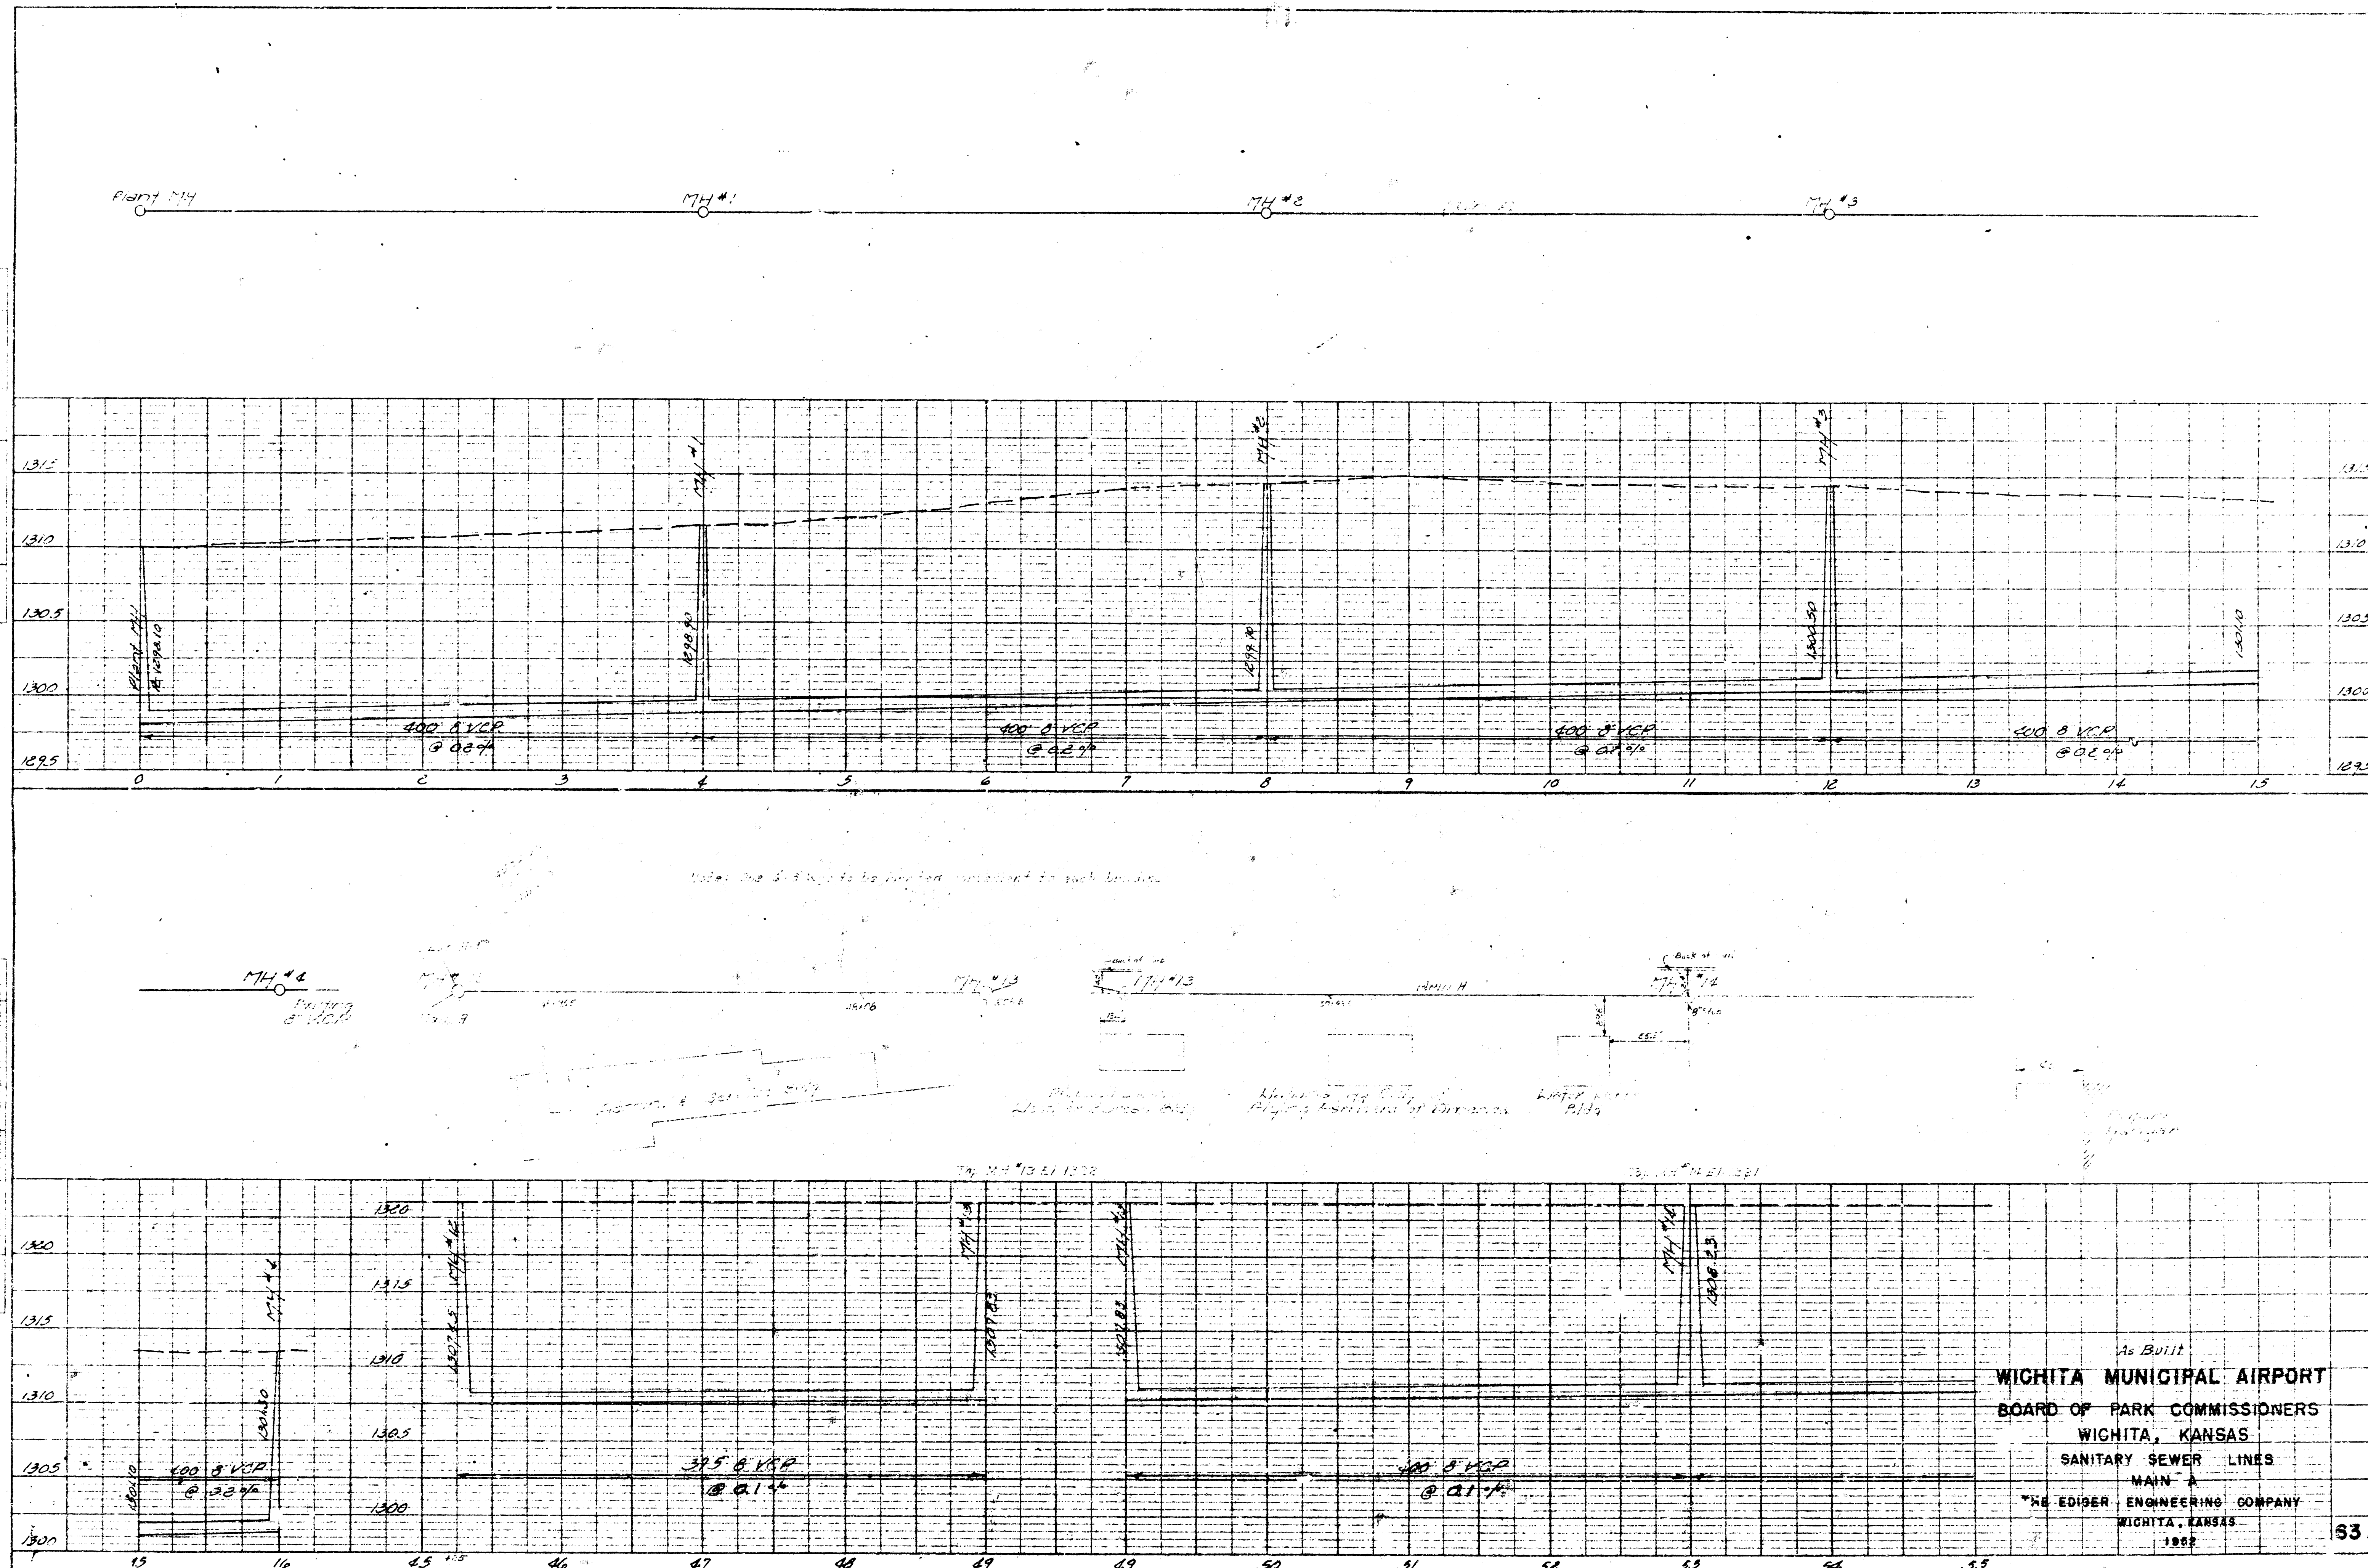


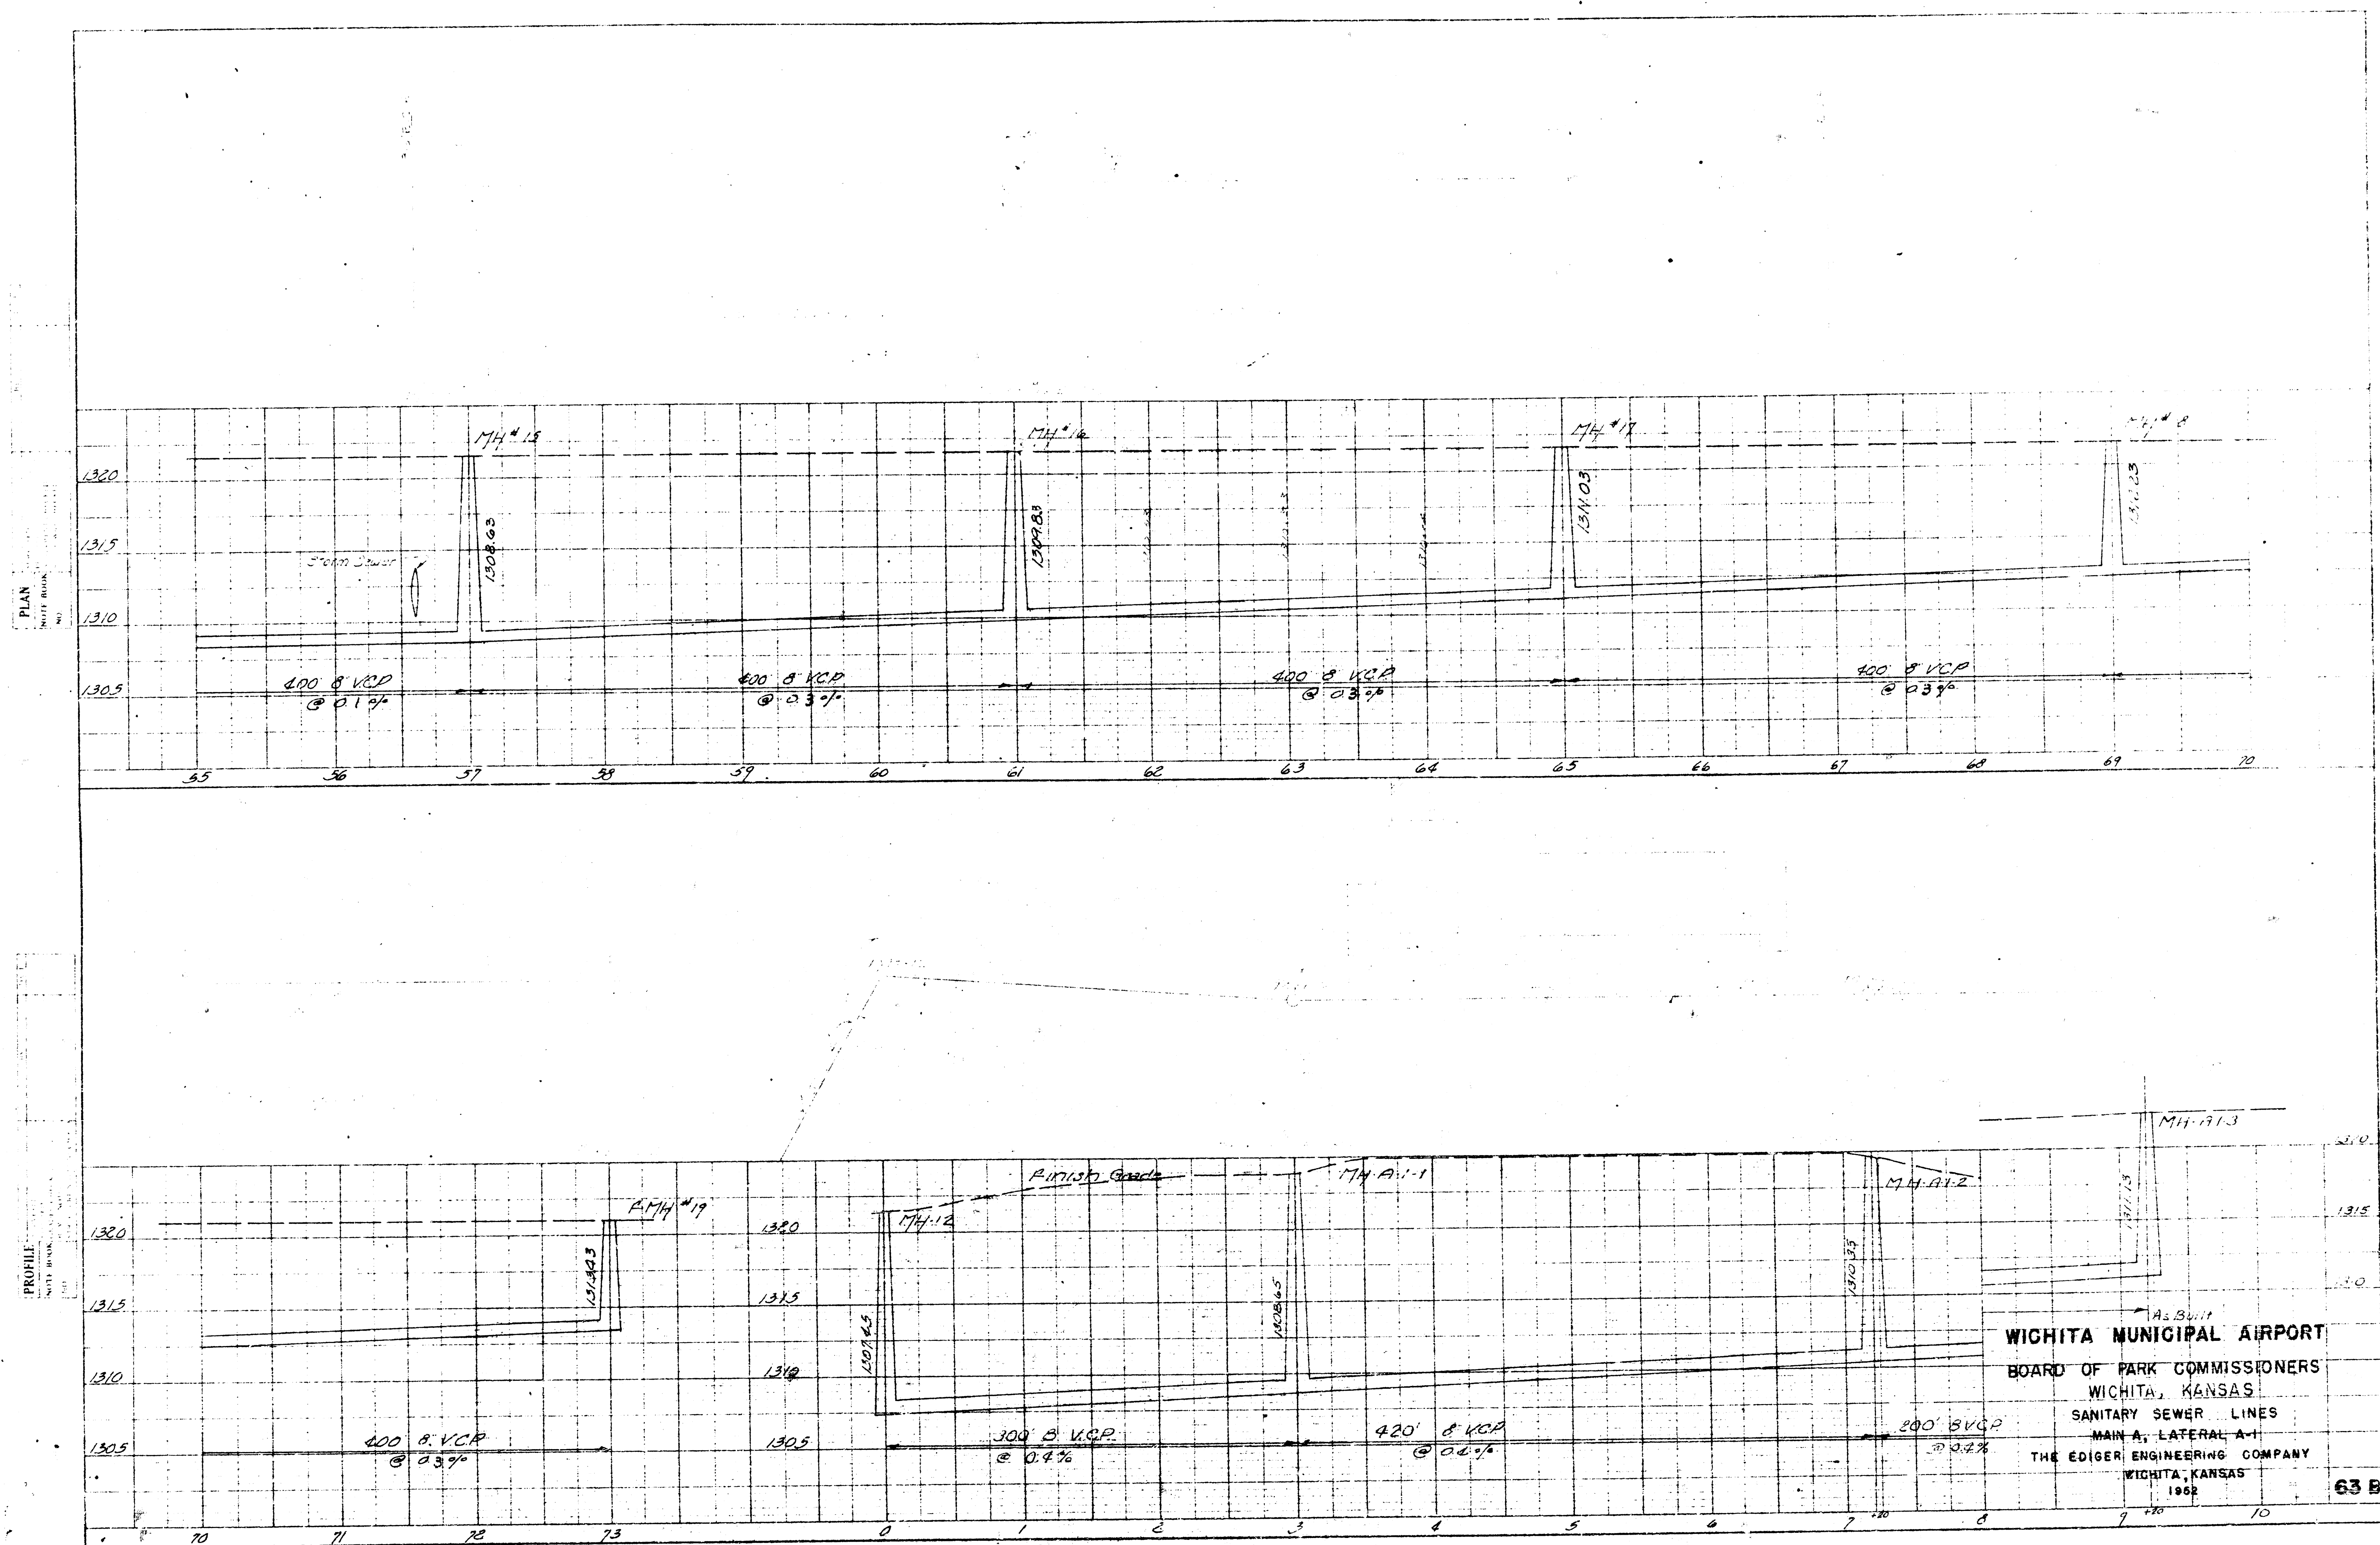



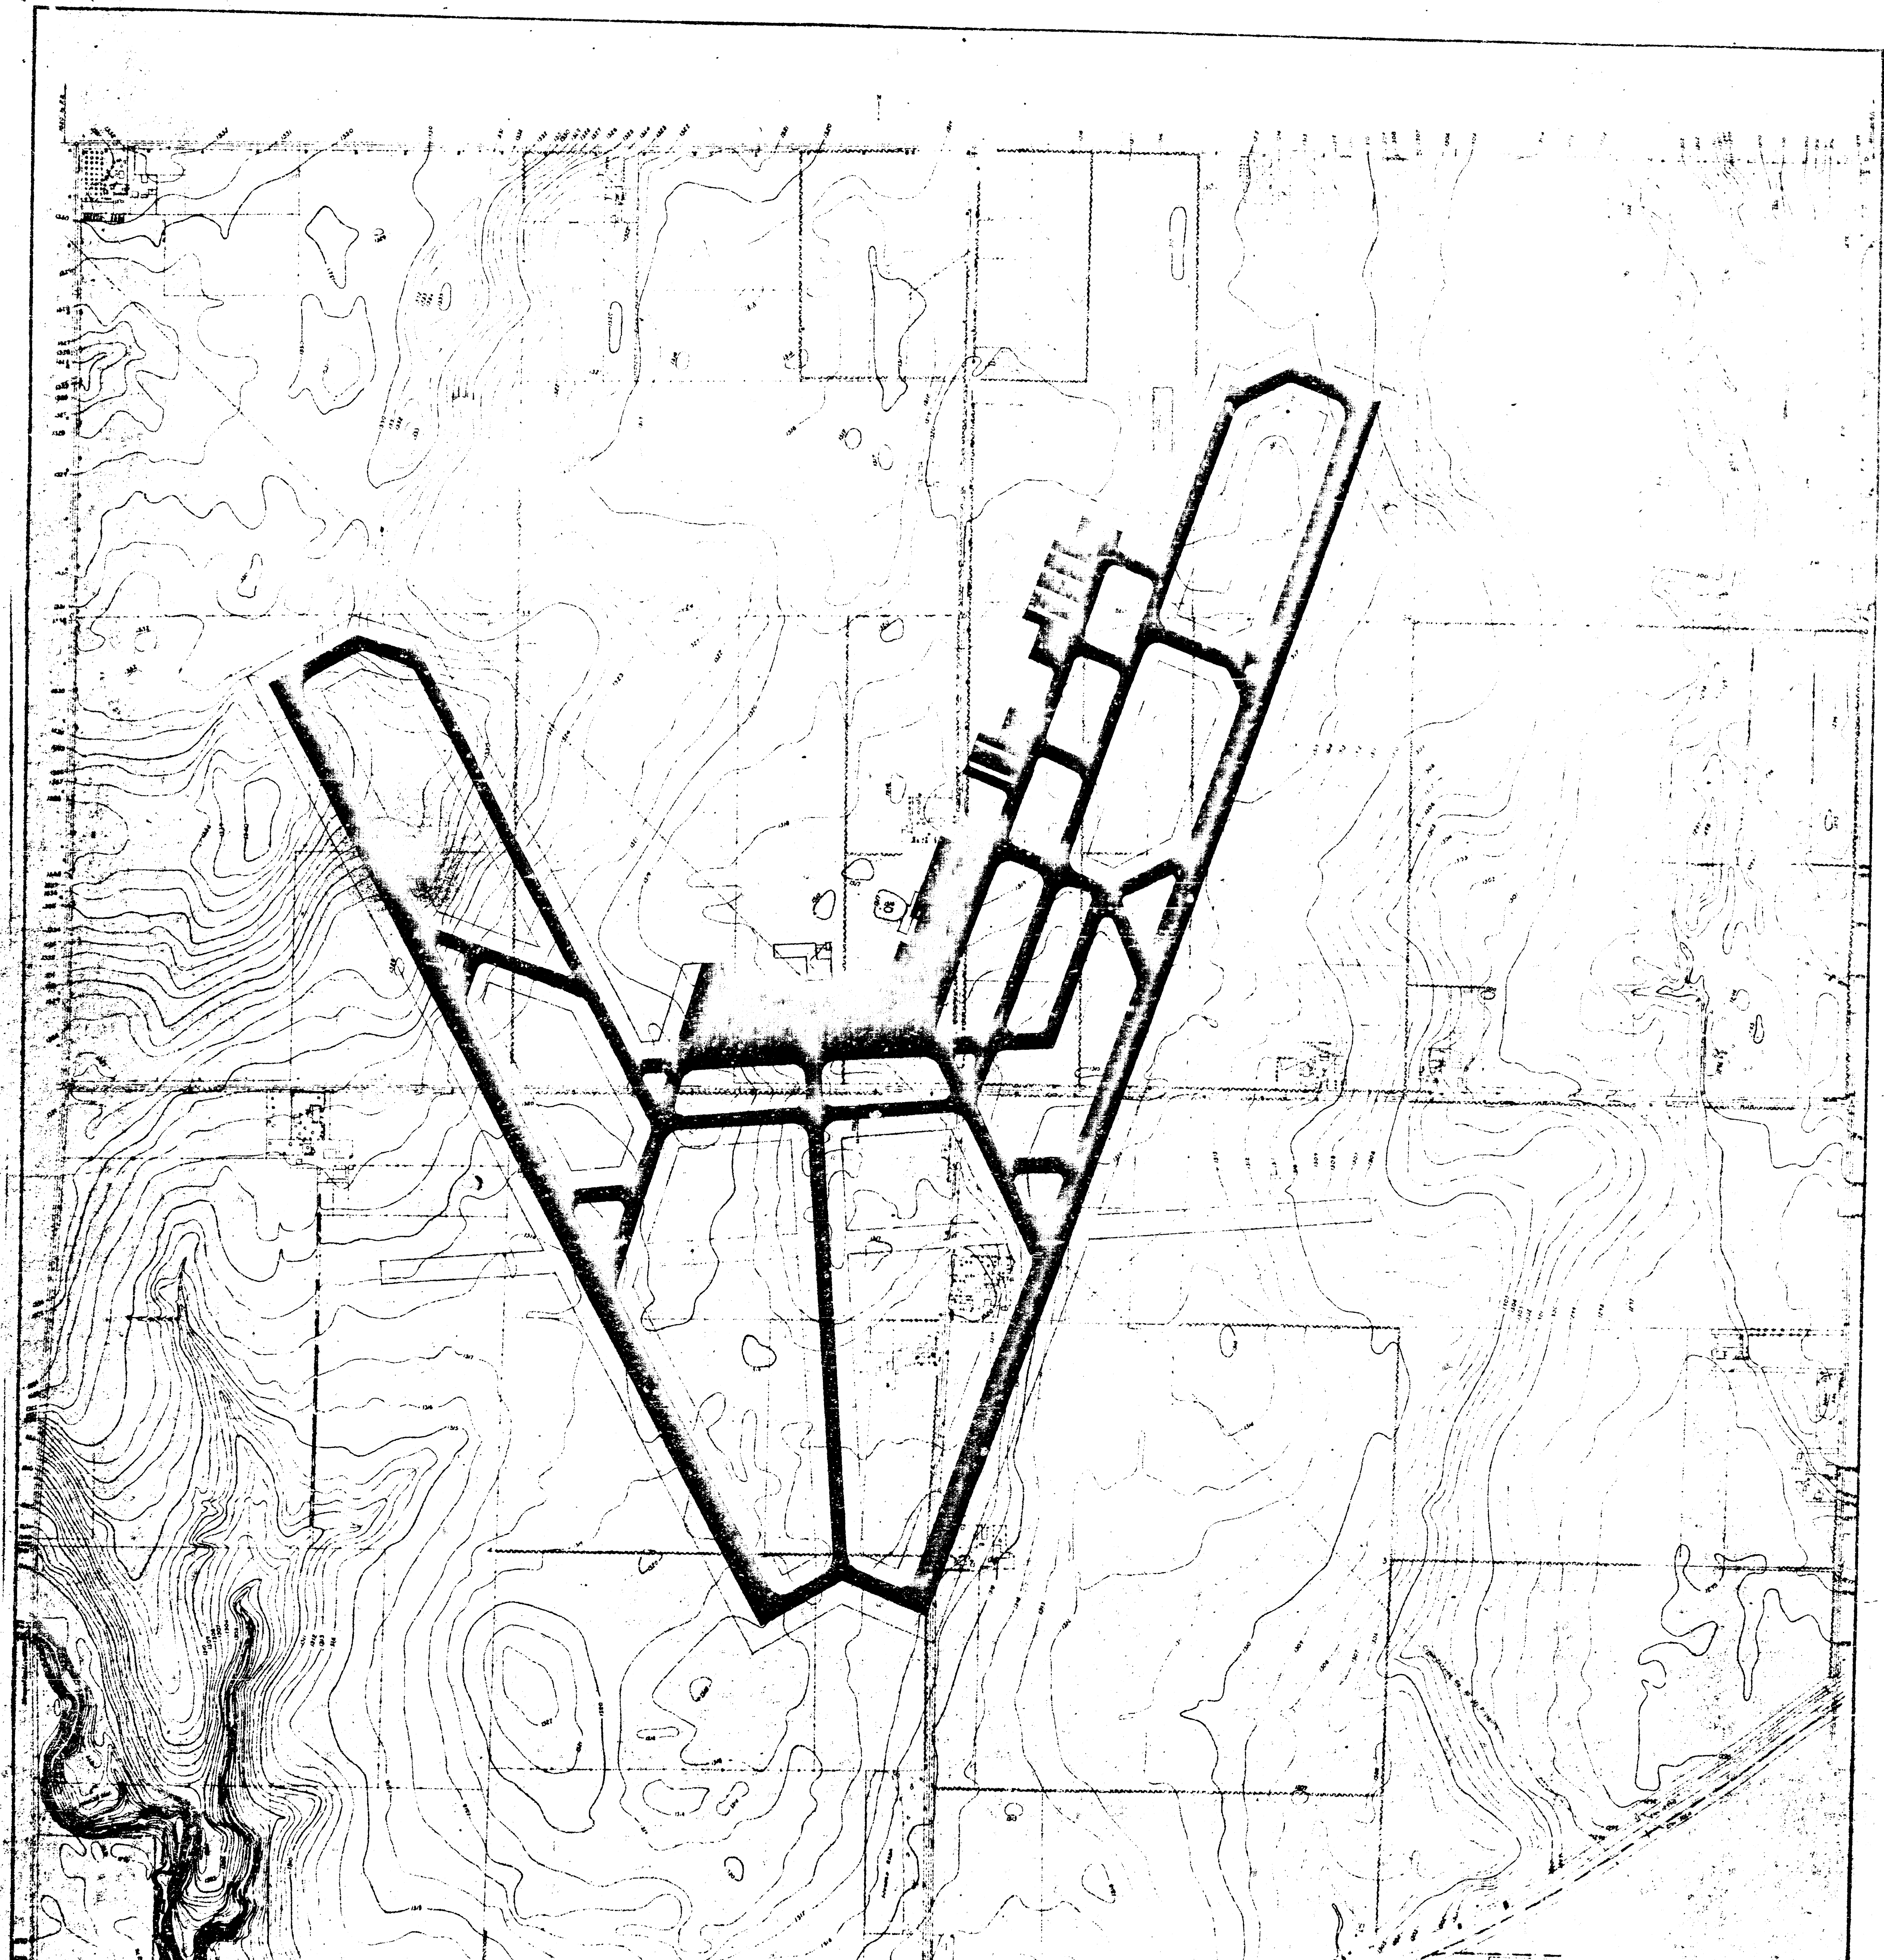

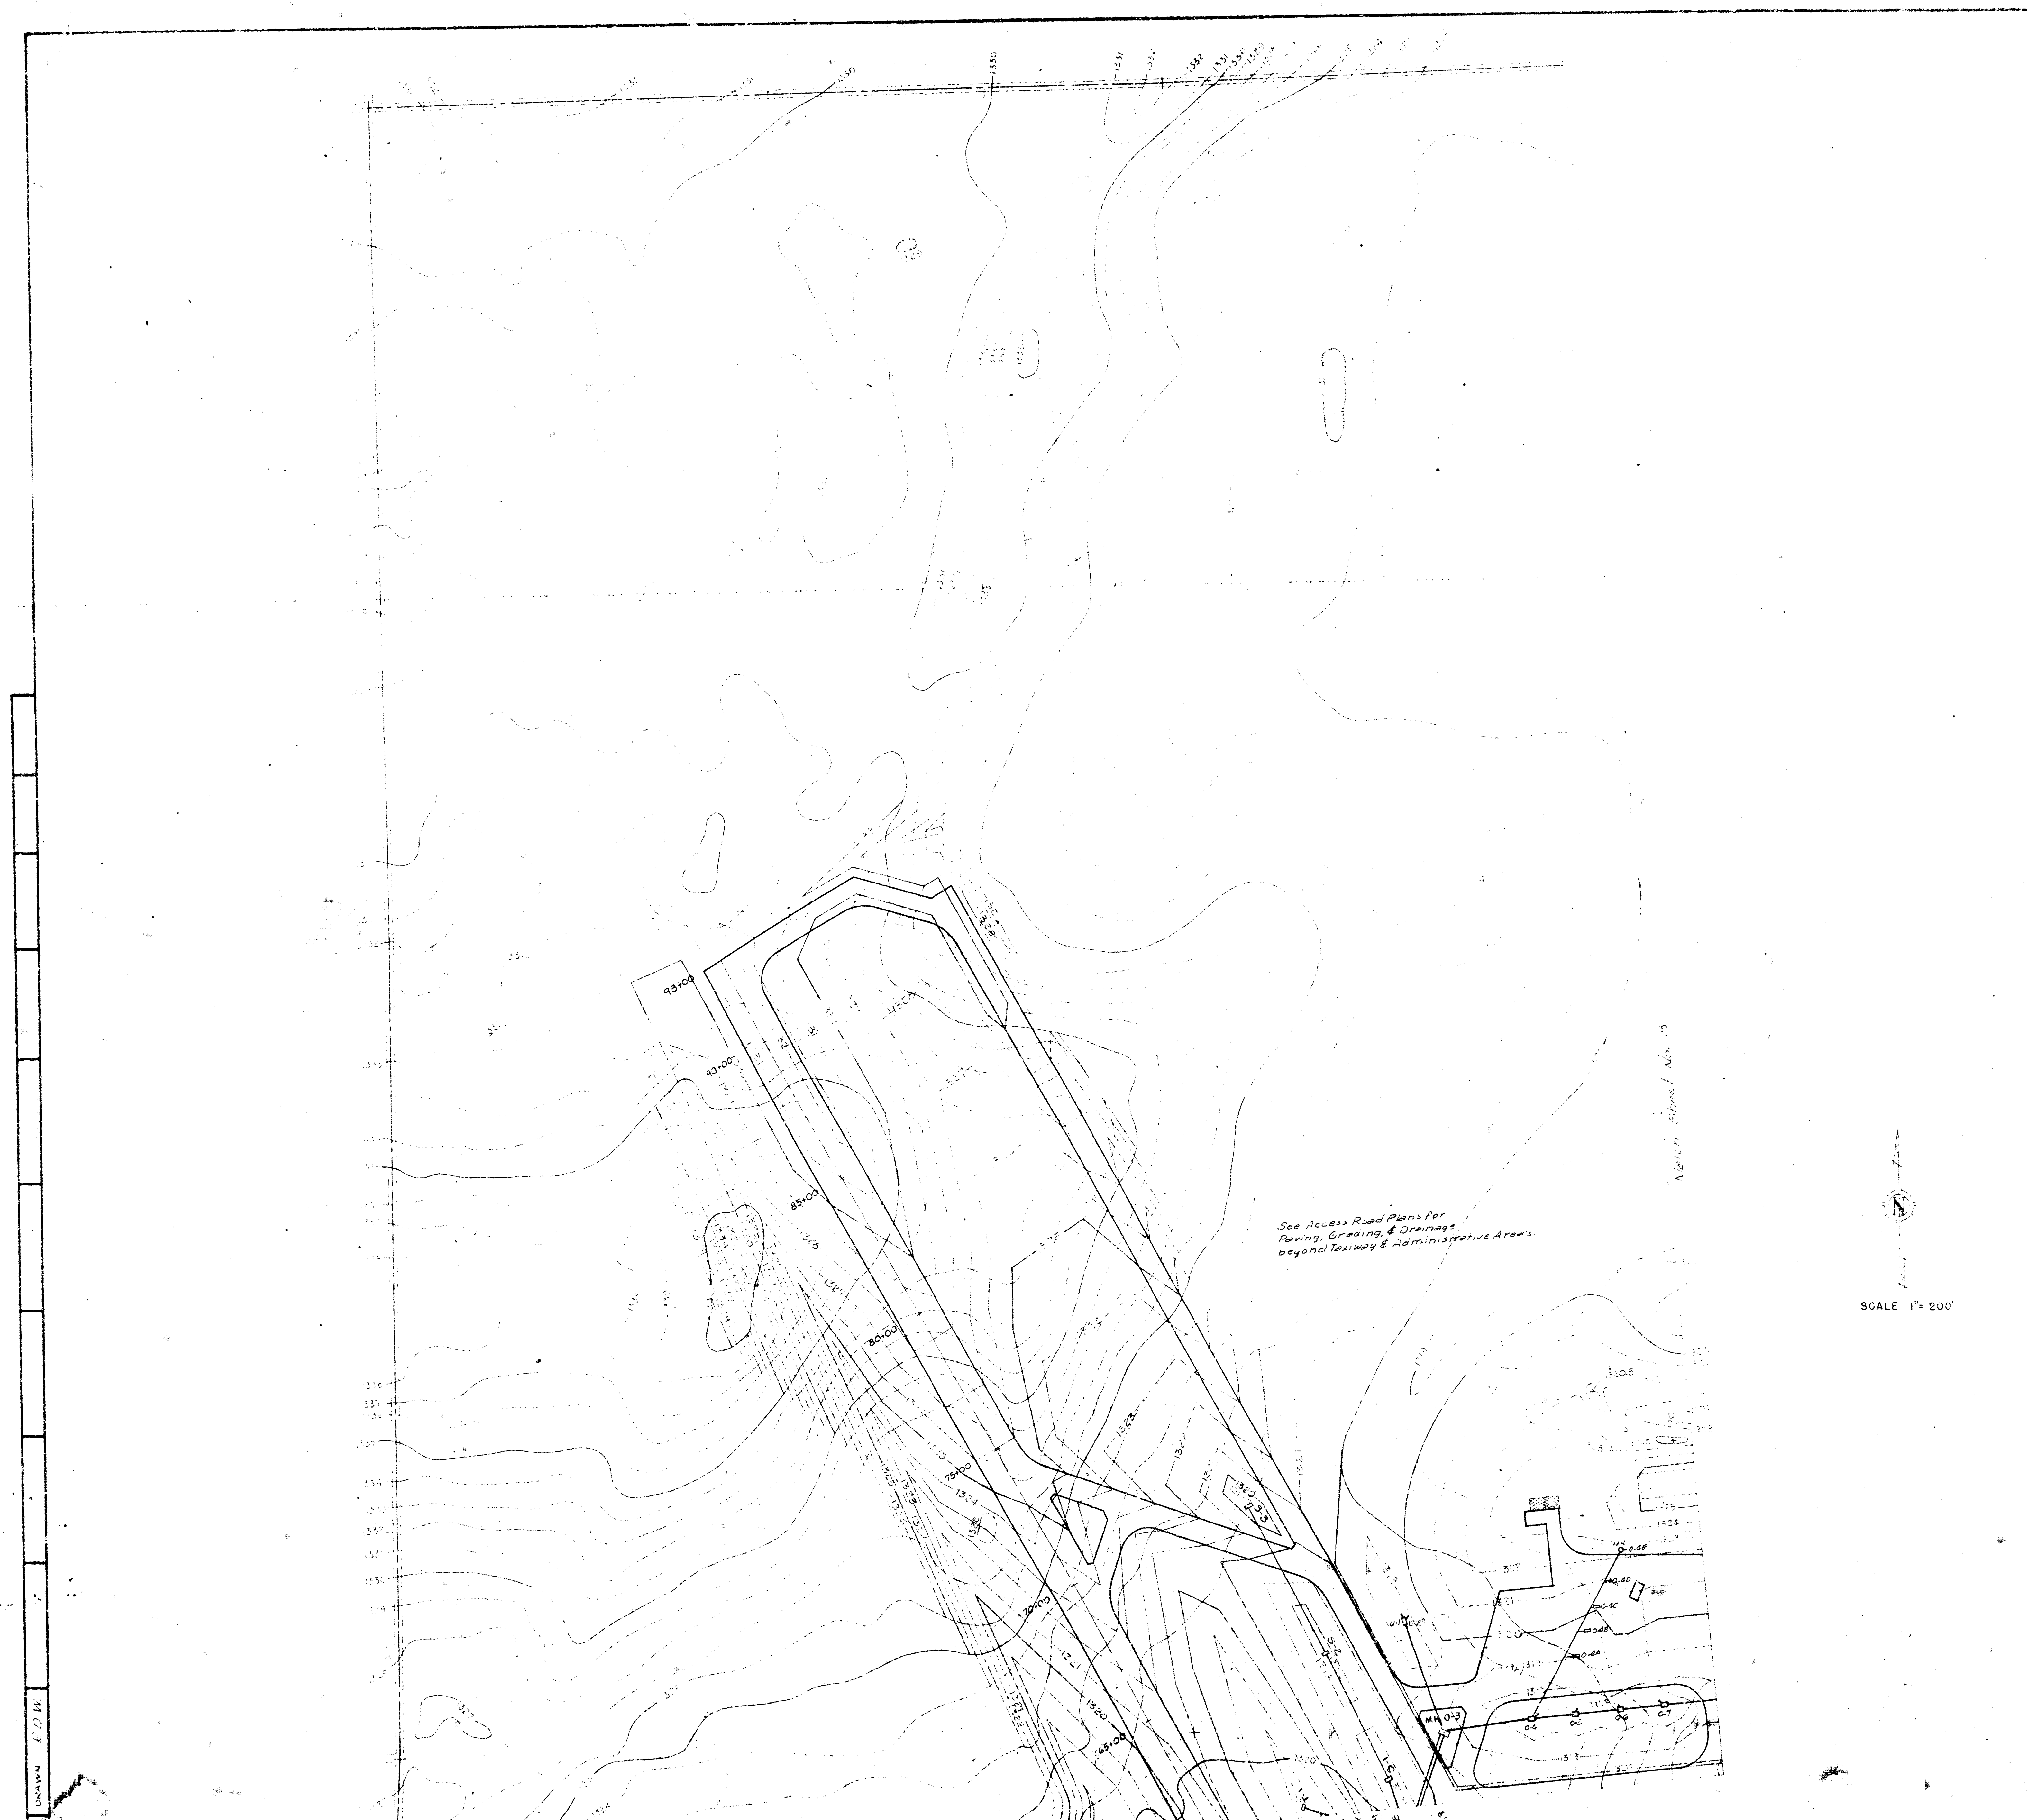

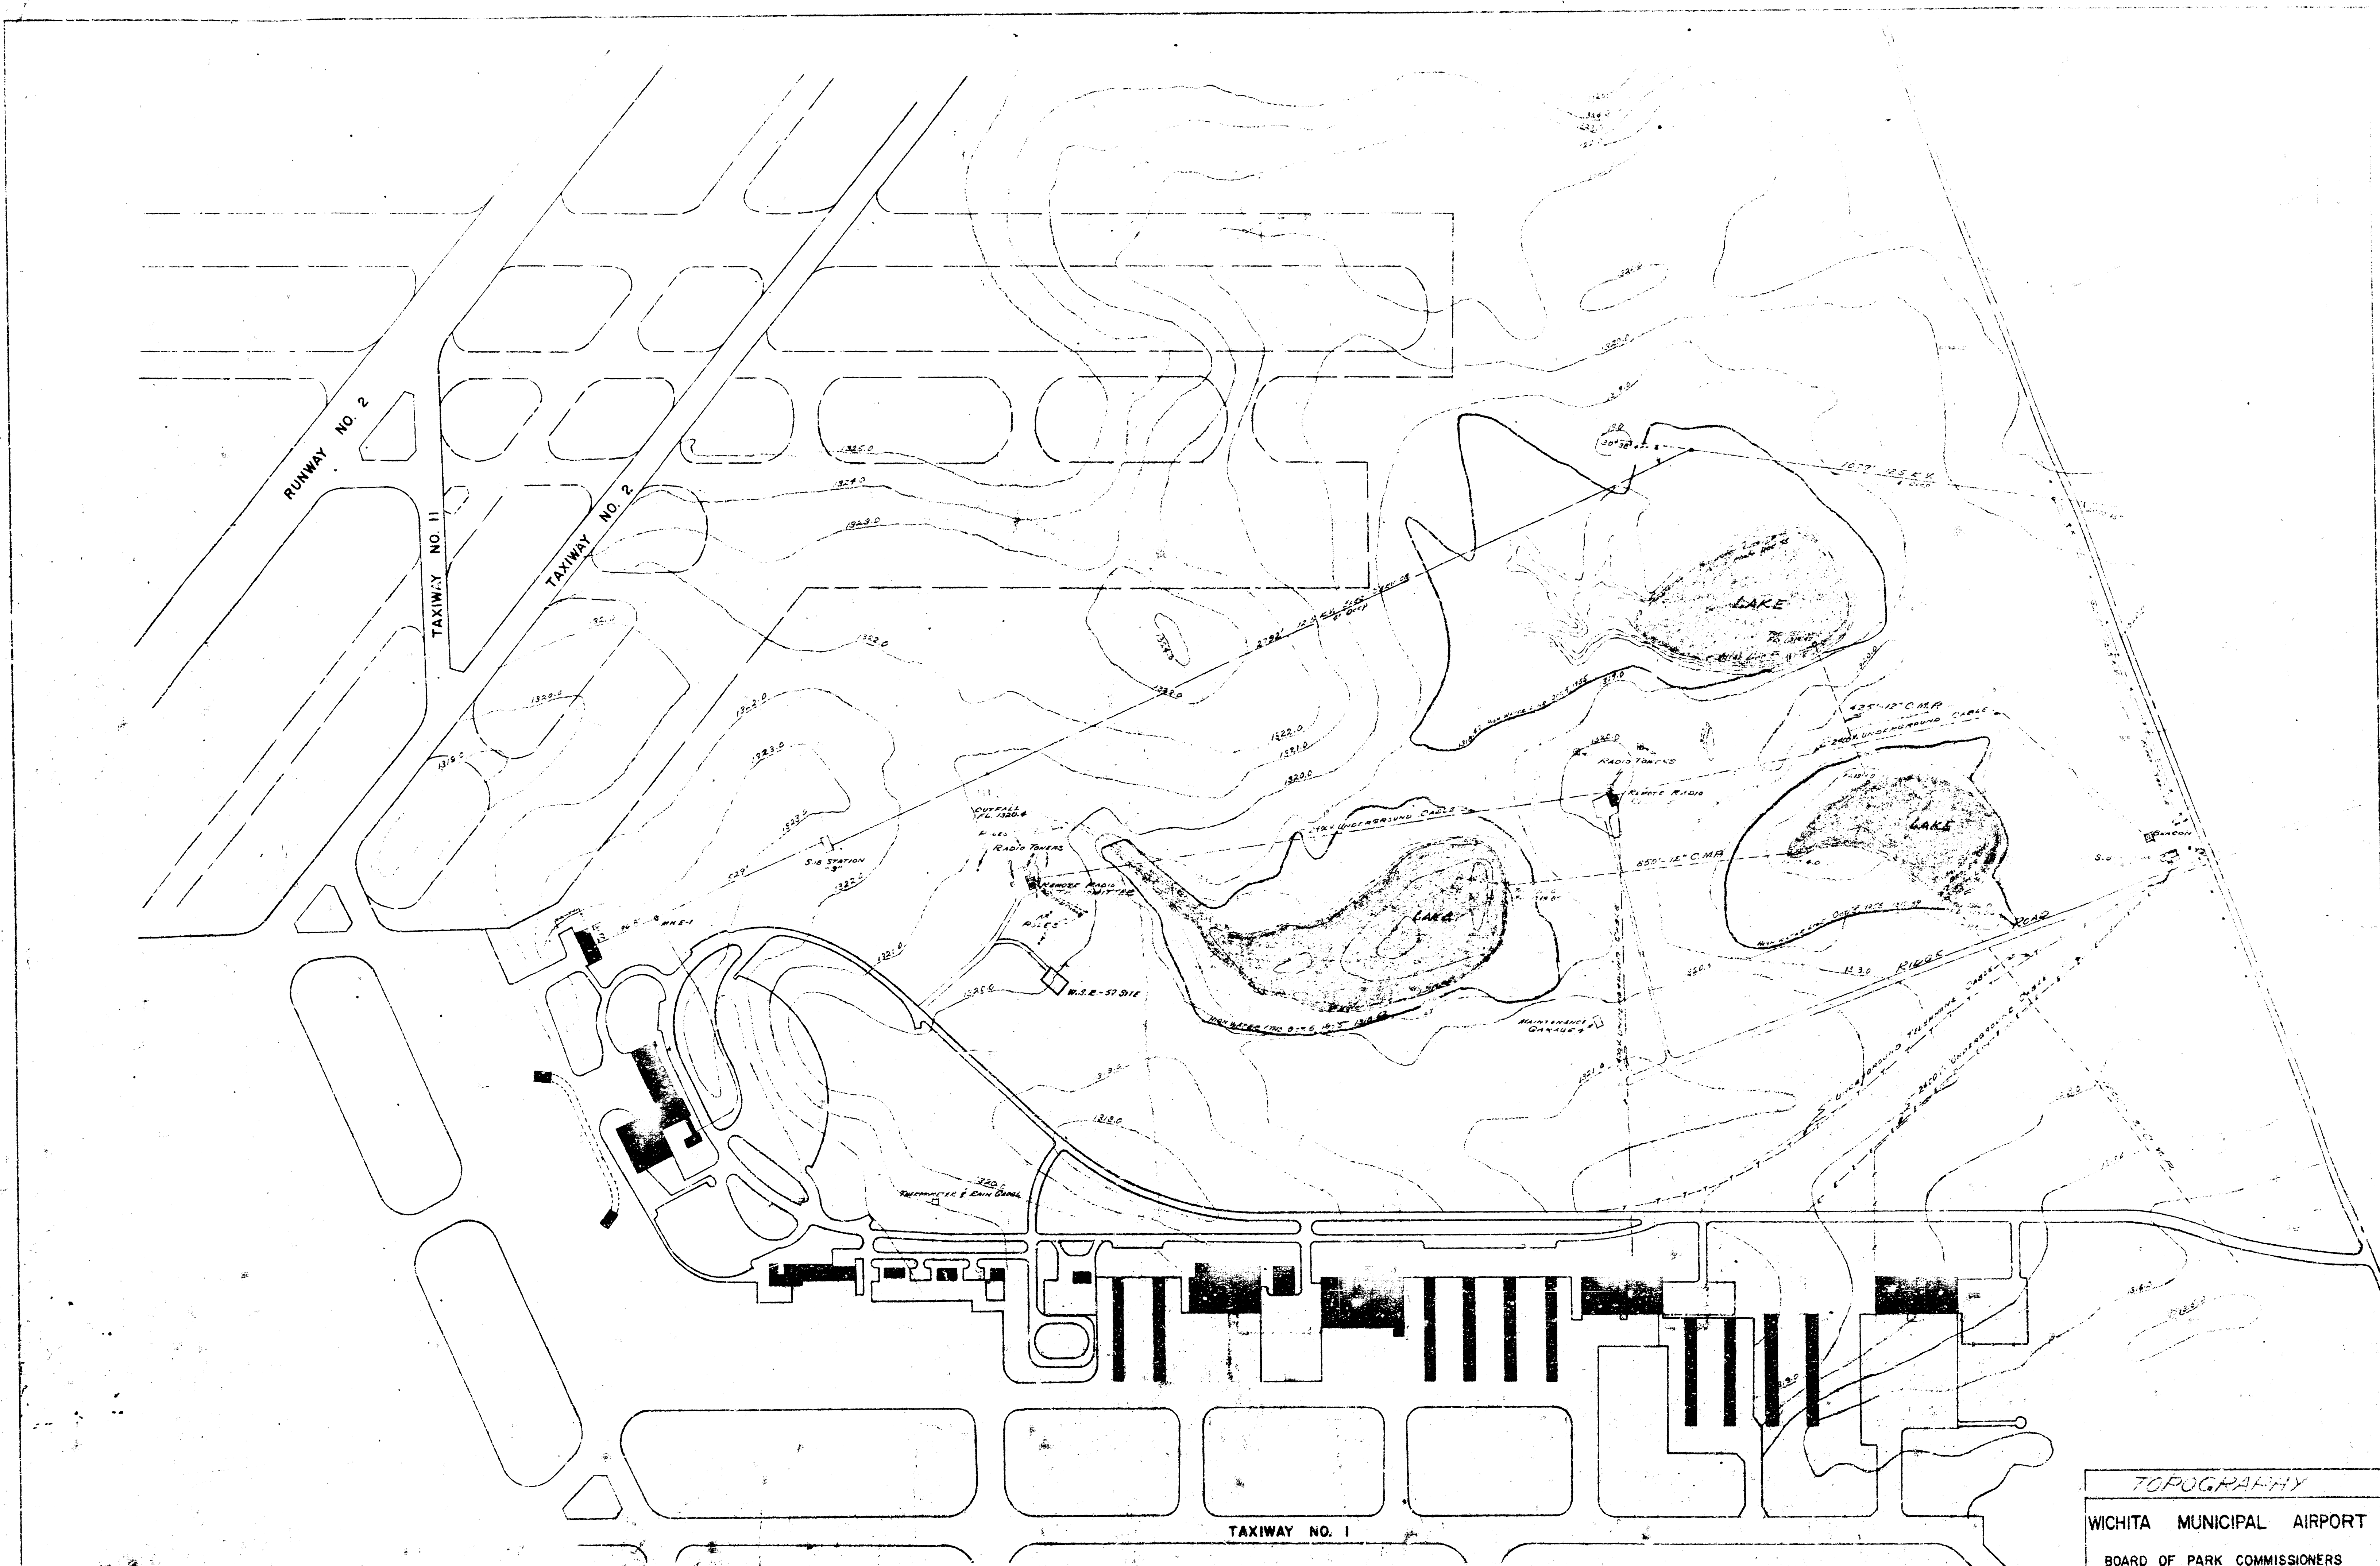

TOPOGRAPHY
WICHITA MUNICIPAL AIRPORT
BOARD OF PARK COMMISSIONERS
WICHITA, KANSAS

DATE	SCALE	SHEET
11-14-55	1" = 200'	1 OF 1

Prepared by: [illegible]
Checked by: [illegible]
Approved by: [illegible]
Date: 11-14-55

