


B. M. 86.85 Sta. 12 N. of 38' E?

13th & Rock Road.

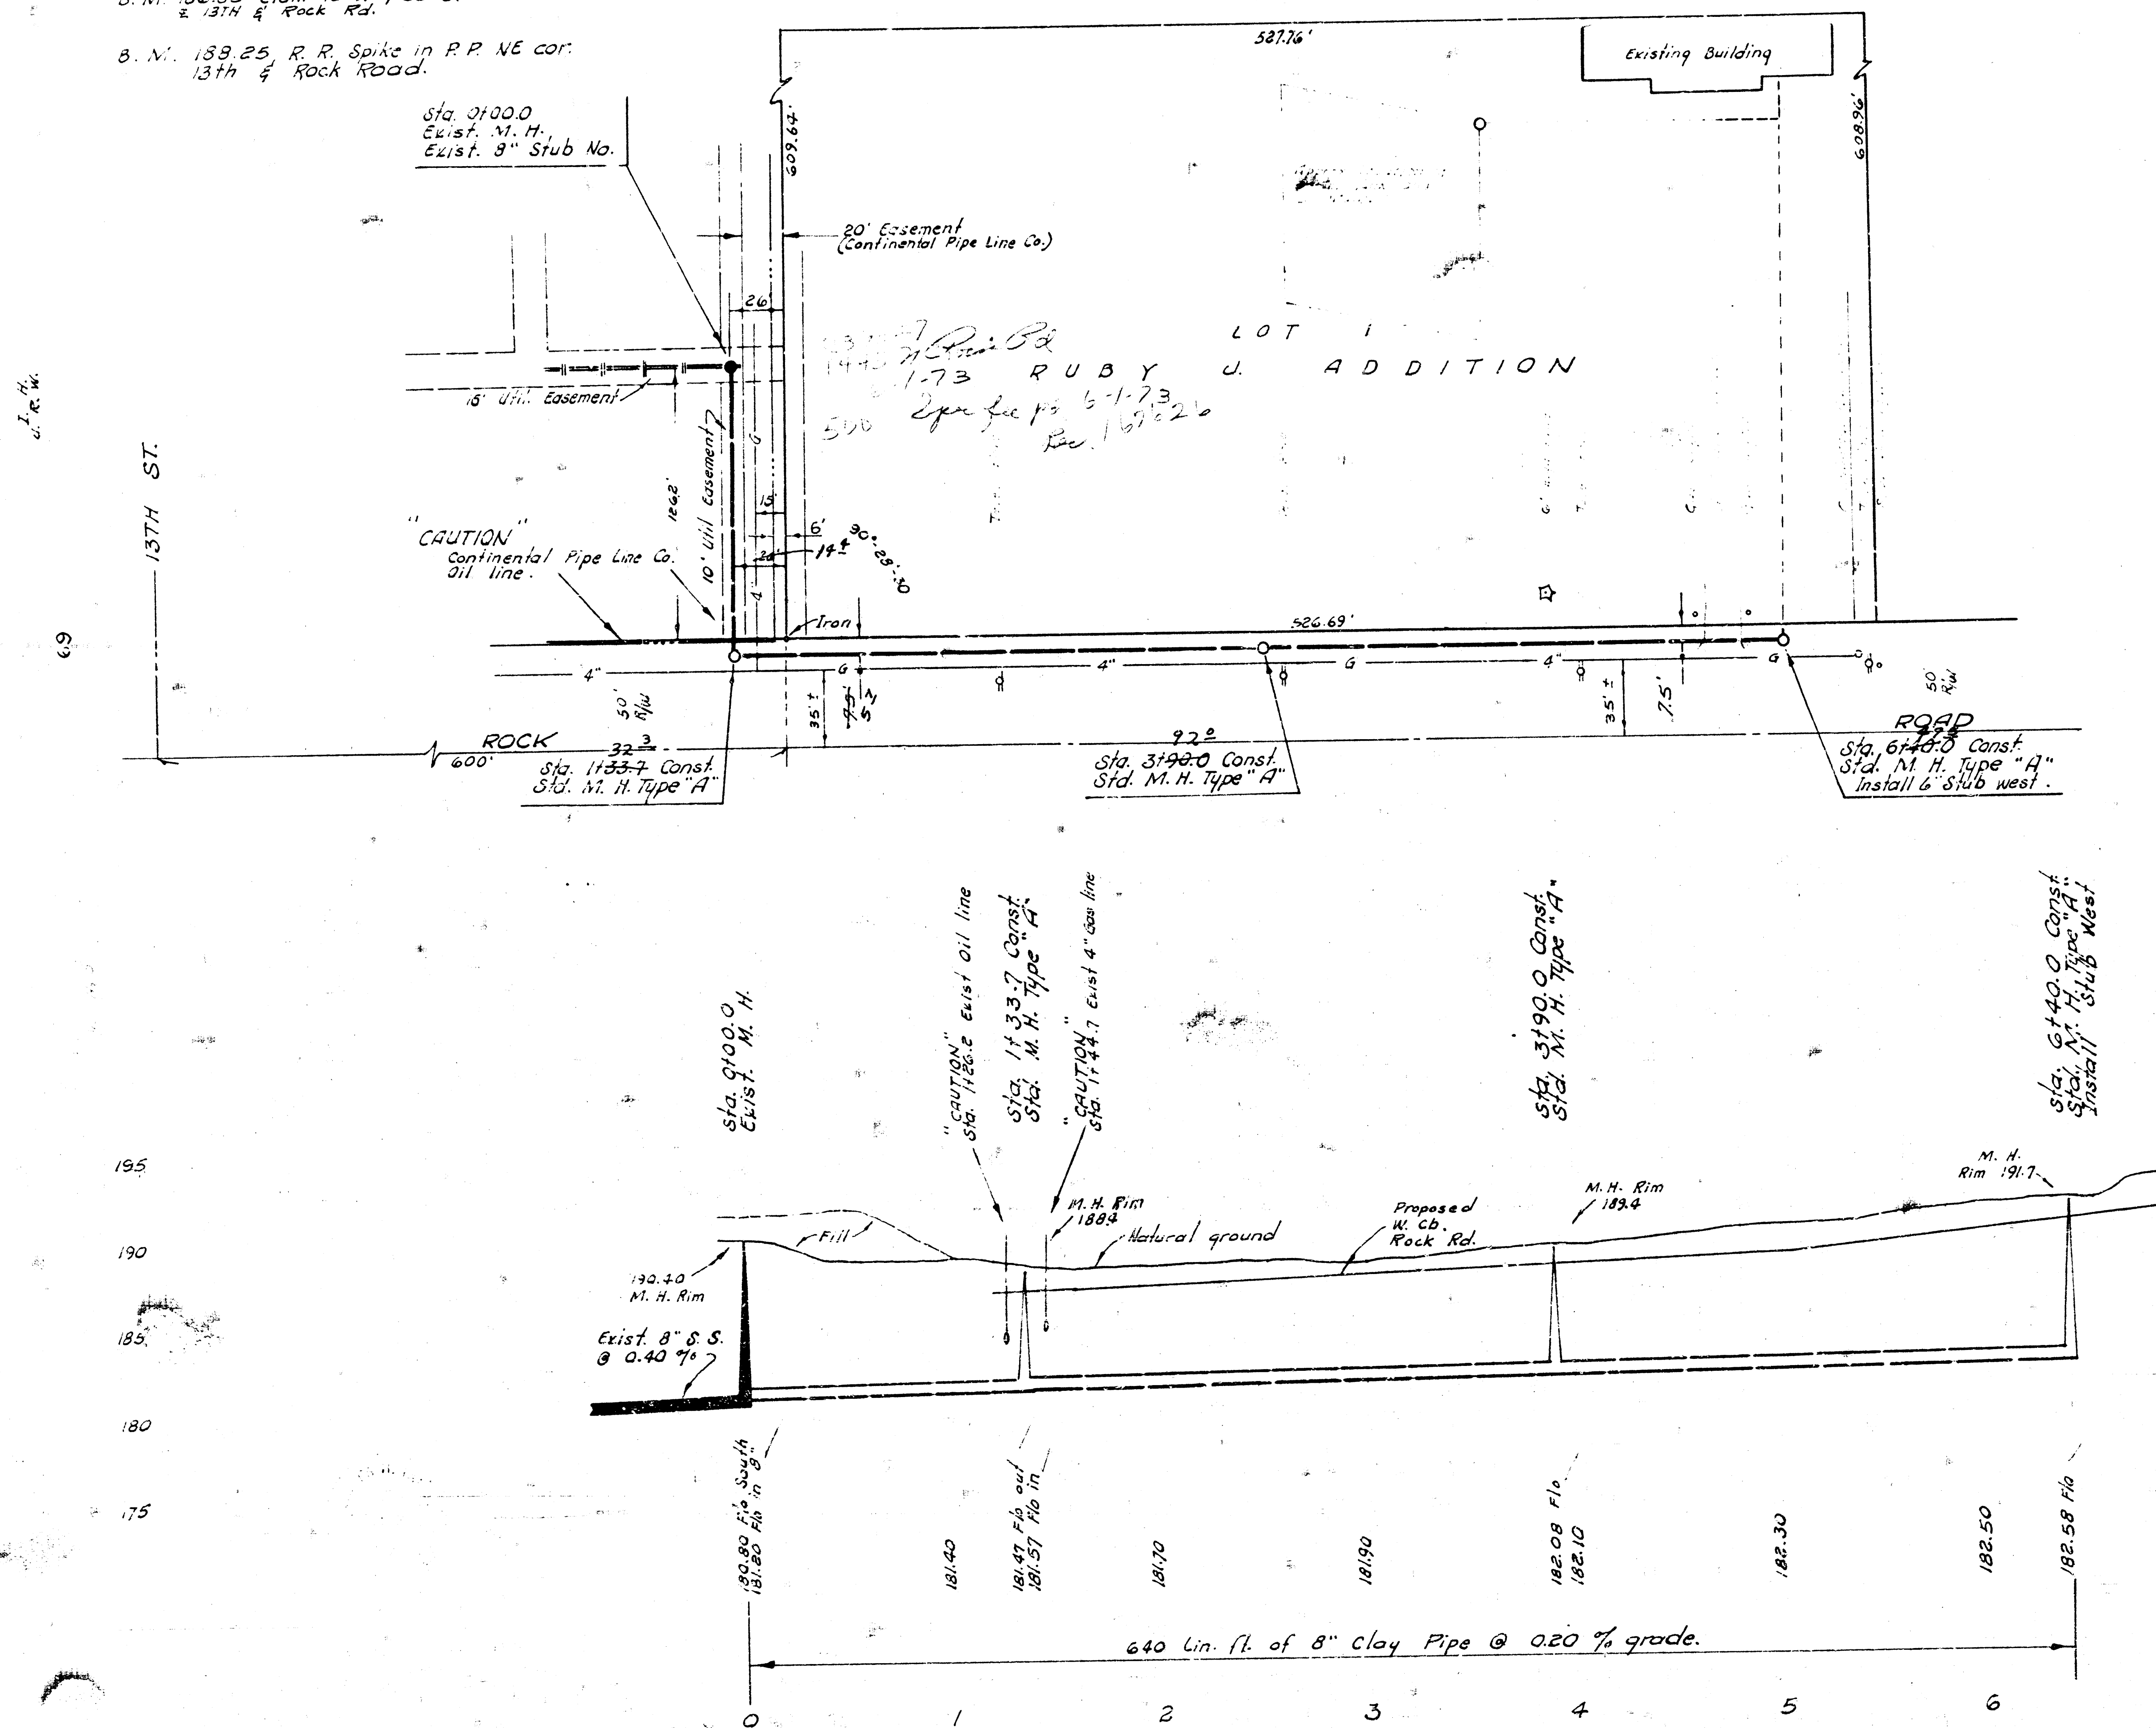

Plan Scale 1" = 40'
Profile Scale 1" = 5' Vert.

NOTE TO CONTRACTOR:

Contractor to give the Continental Pipe Line Co. a 24 hour notice before commencing excavation so that the pipe line Co. and contractor may co-ordinate the construction of this project.

Continental Pipe Line Co.
Valley Center
7551-0241

Call Mr. Stace Peet
824-6230
Rd. code 316
Home Phone No.
357-3556
446ns, Kansas

NOTE TO CONTRACTOR

This project will be constructed under the supervision of the CITY ENGINEER and conforming to the SPECIFICATIONS of the CITY OF WICHITA. The CONTRACTOR will reimburse the City of Wichita for all cost of Engineering, Plans, and Inspection.

WICHITA RACQUET CLUB INC.
PRIVATE SANITARY SEWER
1445 No. Rock Road
CITY OF WICHITA, KANSAS
R. W. LINN - CITY ENGINEER
MAY, 1973 PROJECT NO. BHK8503026