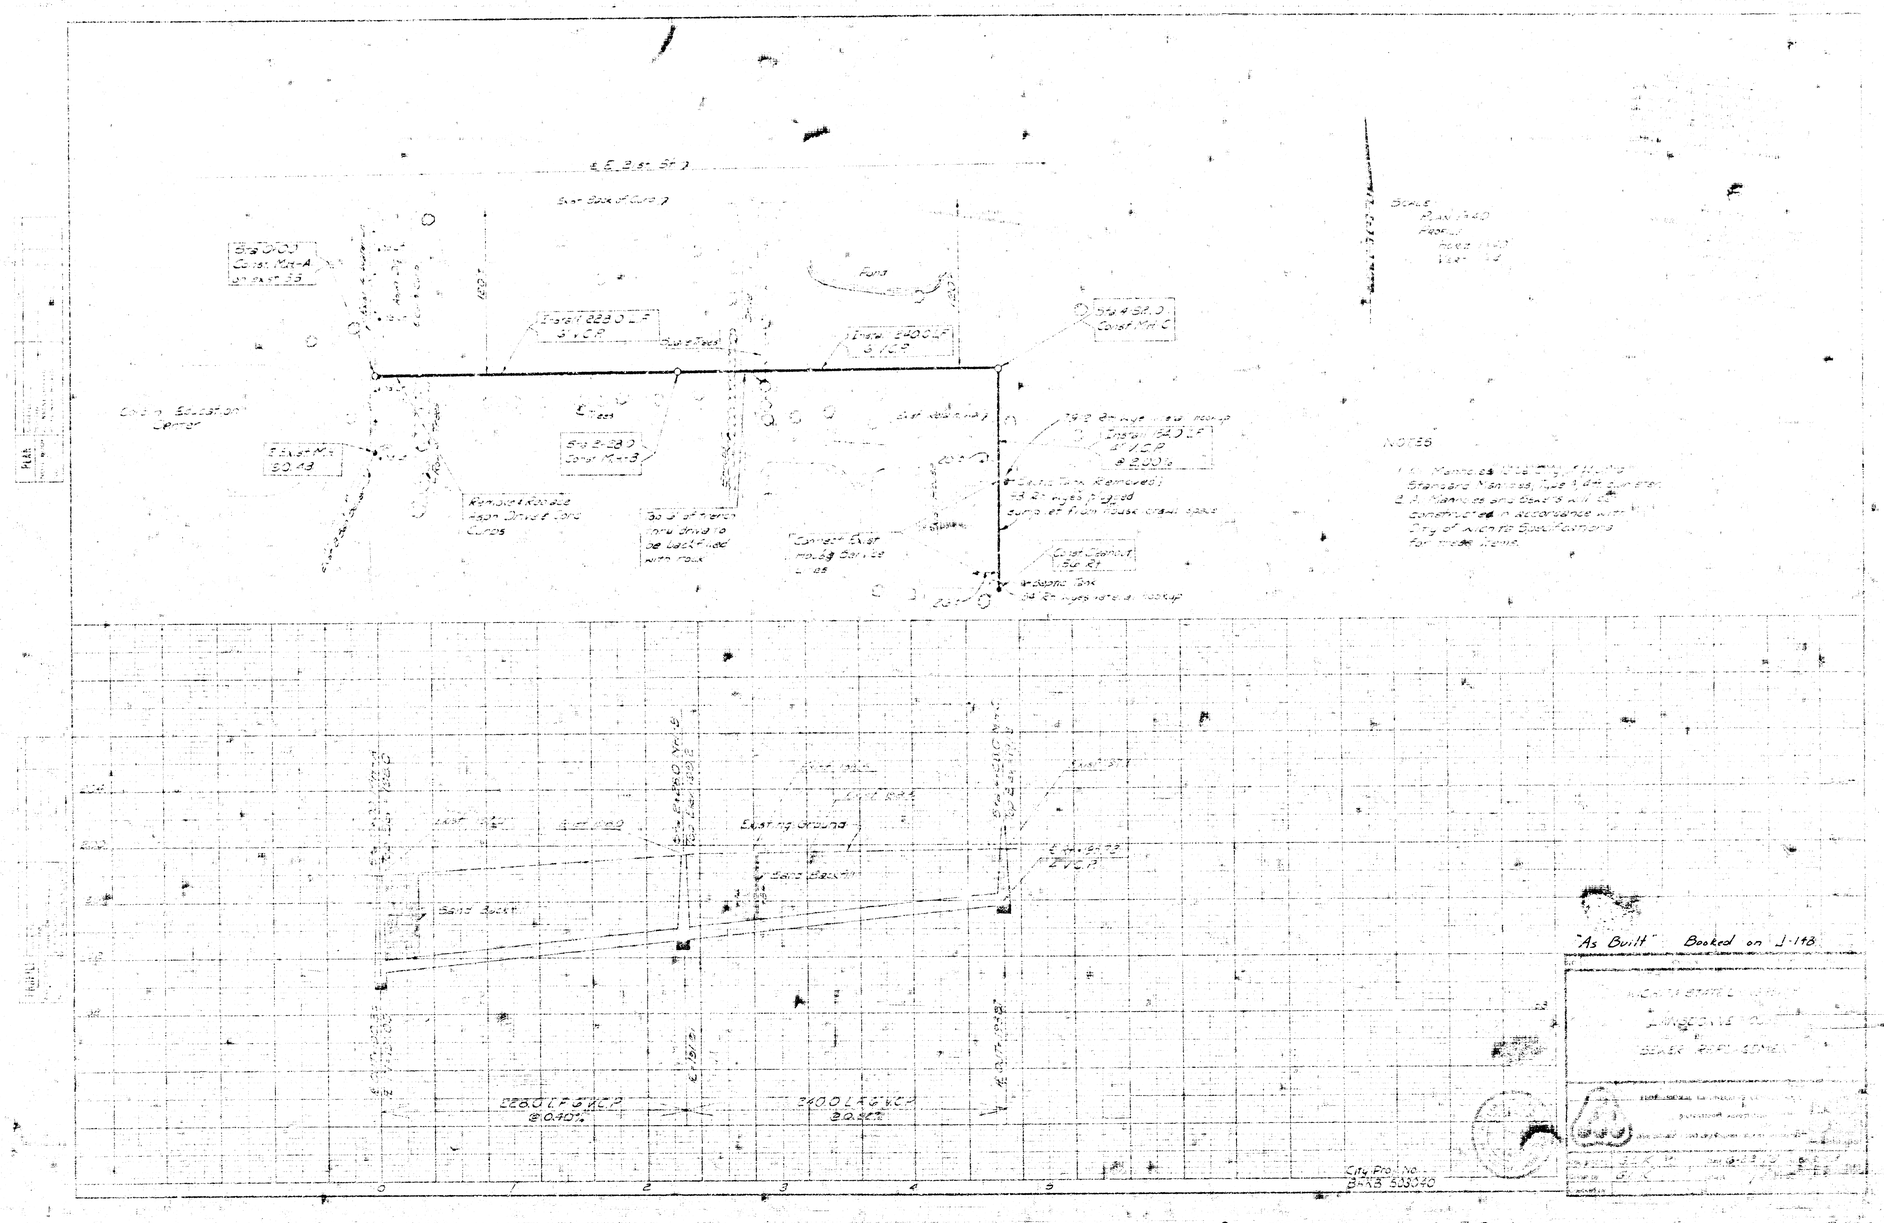

Exist Back of Curb
Fund
Sta 0+00 Const Mh-A
Install 228.0 L.F. 6" V.C.P.
Install 240.0 L.F. 6" V.C.P.
Sta 4+82.0 Const Mh-C
Sta 2+28.0 Const Mh-B
Remove & Replace Asph Drive & Conc Curbs
Connect Exist House Service Lines
Exist Rear Lines
Install 154.0 L.F. 4" V.C.P. @ 2.00%
Septic Tank Removed
Const Cleanout
Septic Tank
Scale
Plan 1:40
Profile
Notes
Existing Ground
Sand Backfill
Sand Bucket
228.0 L.F. 6" V.C.P. @ 0.40%
240.0 L.F. 6" V.C.P. @ 0.32%
"As Built" Booked on J-148
City Proj. No.
BRKB 503040