


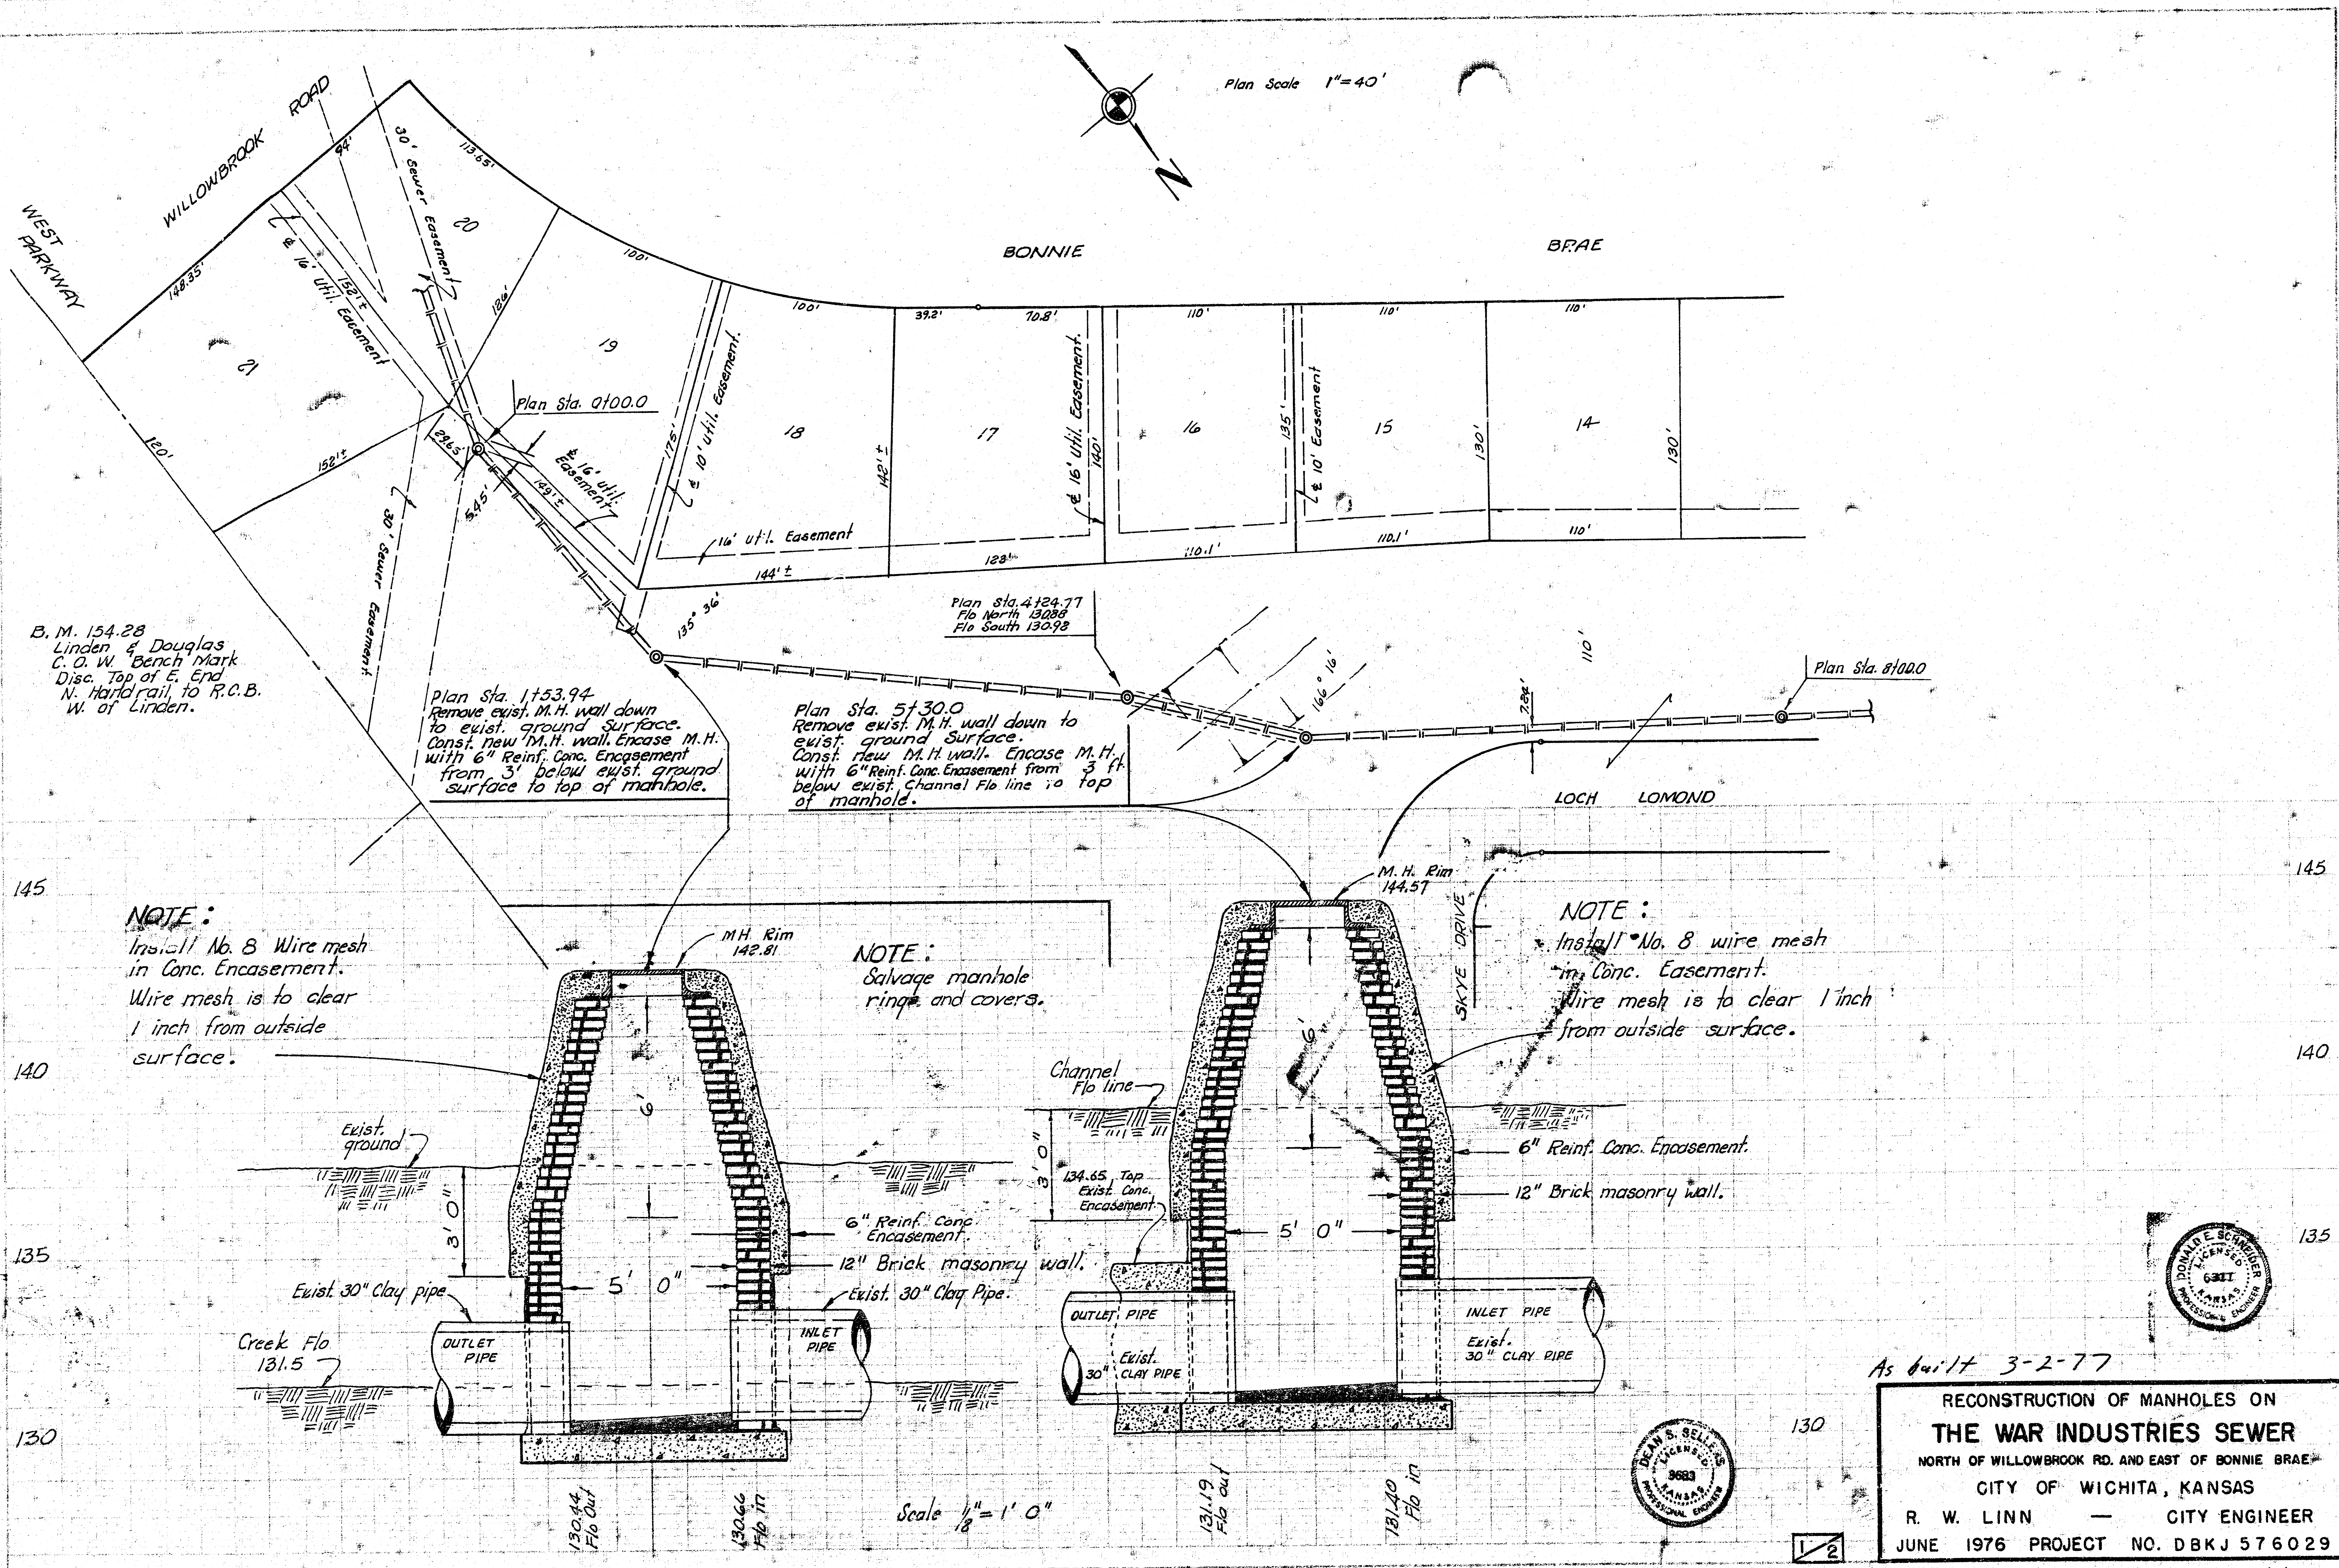

DATE	NO.
1/16/20	1
1/16/20	2
DATE	NO.
1/16/20	1
1/16/20	2
