


PLAN	DATE
Sanitary Sewers	9-13-78
Storm Sewers	
Driveway Approaches	

PROFILE	DATE
Sanitary Sewers	9-13-78
Storm Sewers	
Driveway Approaches	



PRIVATE SANITARY SEWER EXTENSION TO
SERVE WILLOW CREEK MANOR
CITY OF WICHITA, KANSAS
R. W. LINN - CITY ENGINEER
PROJ. NO. 468-76-245-80608-000-000-008

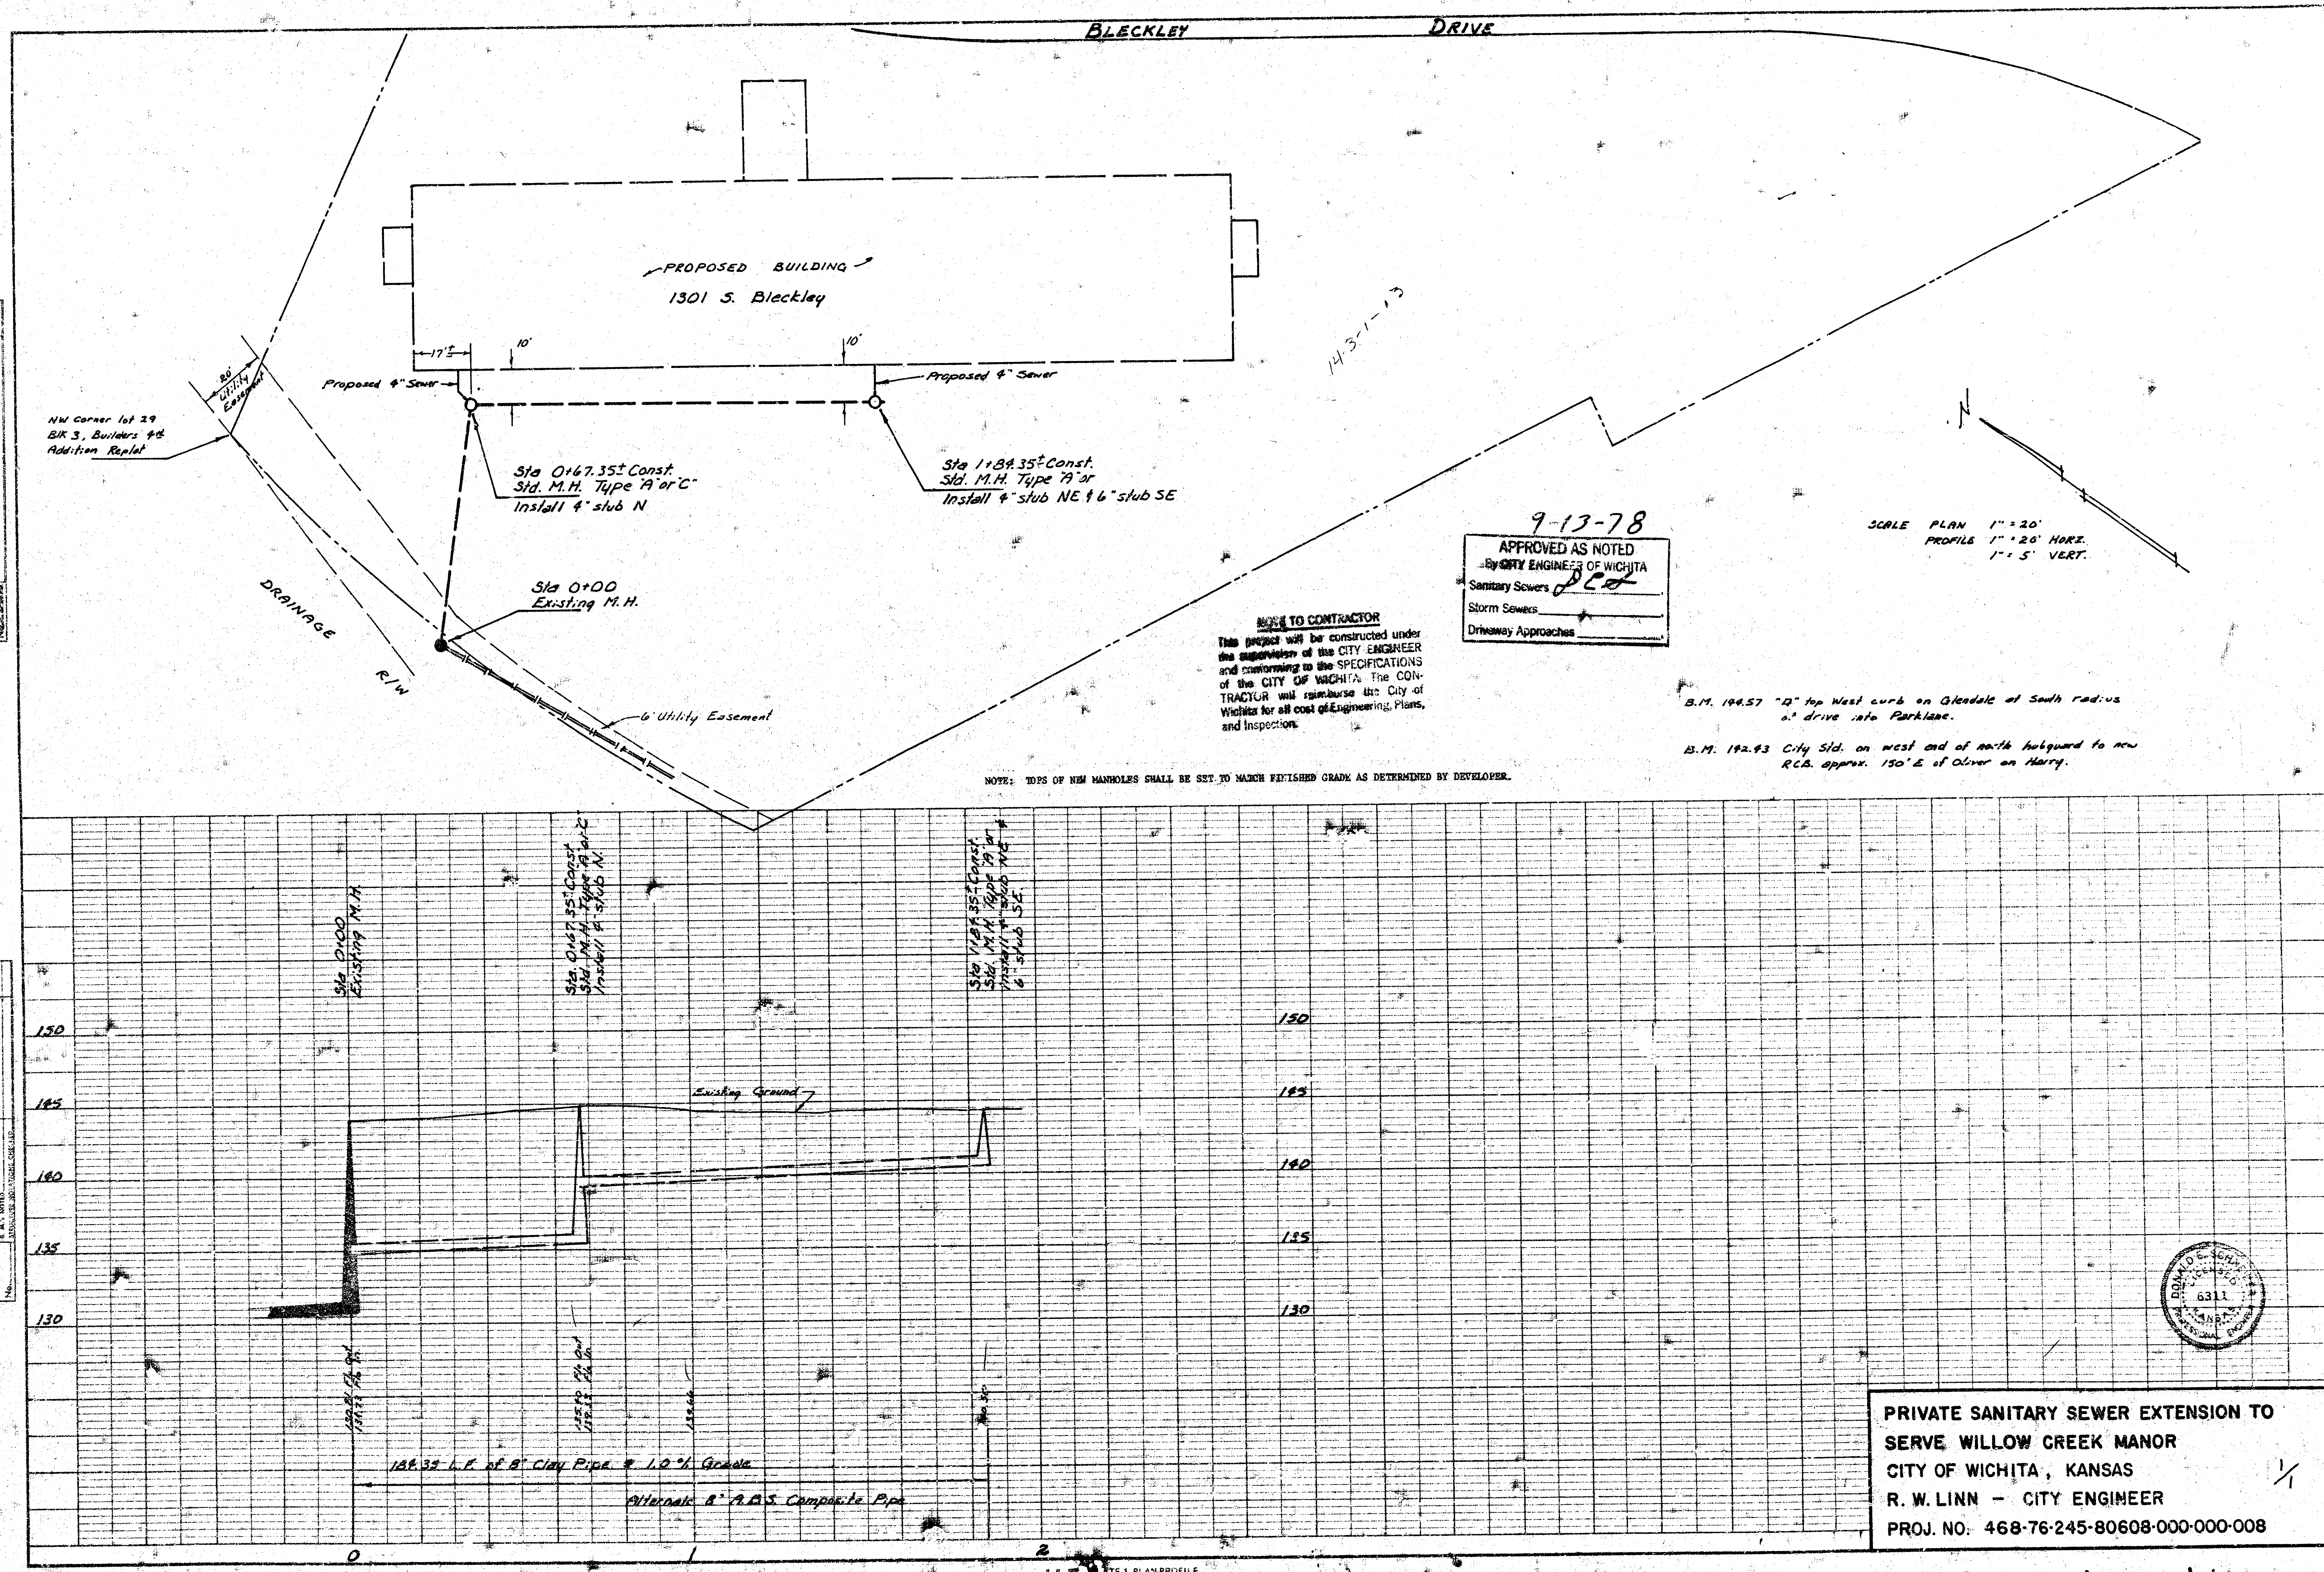