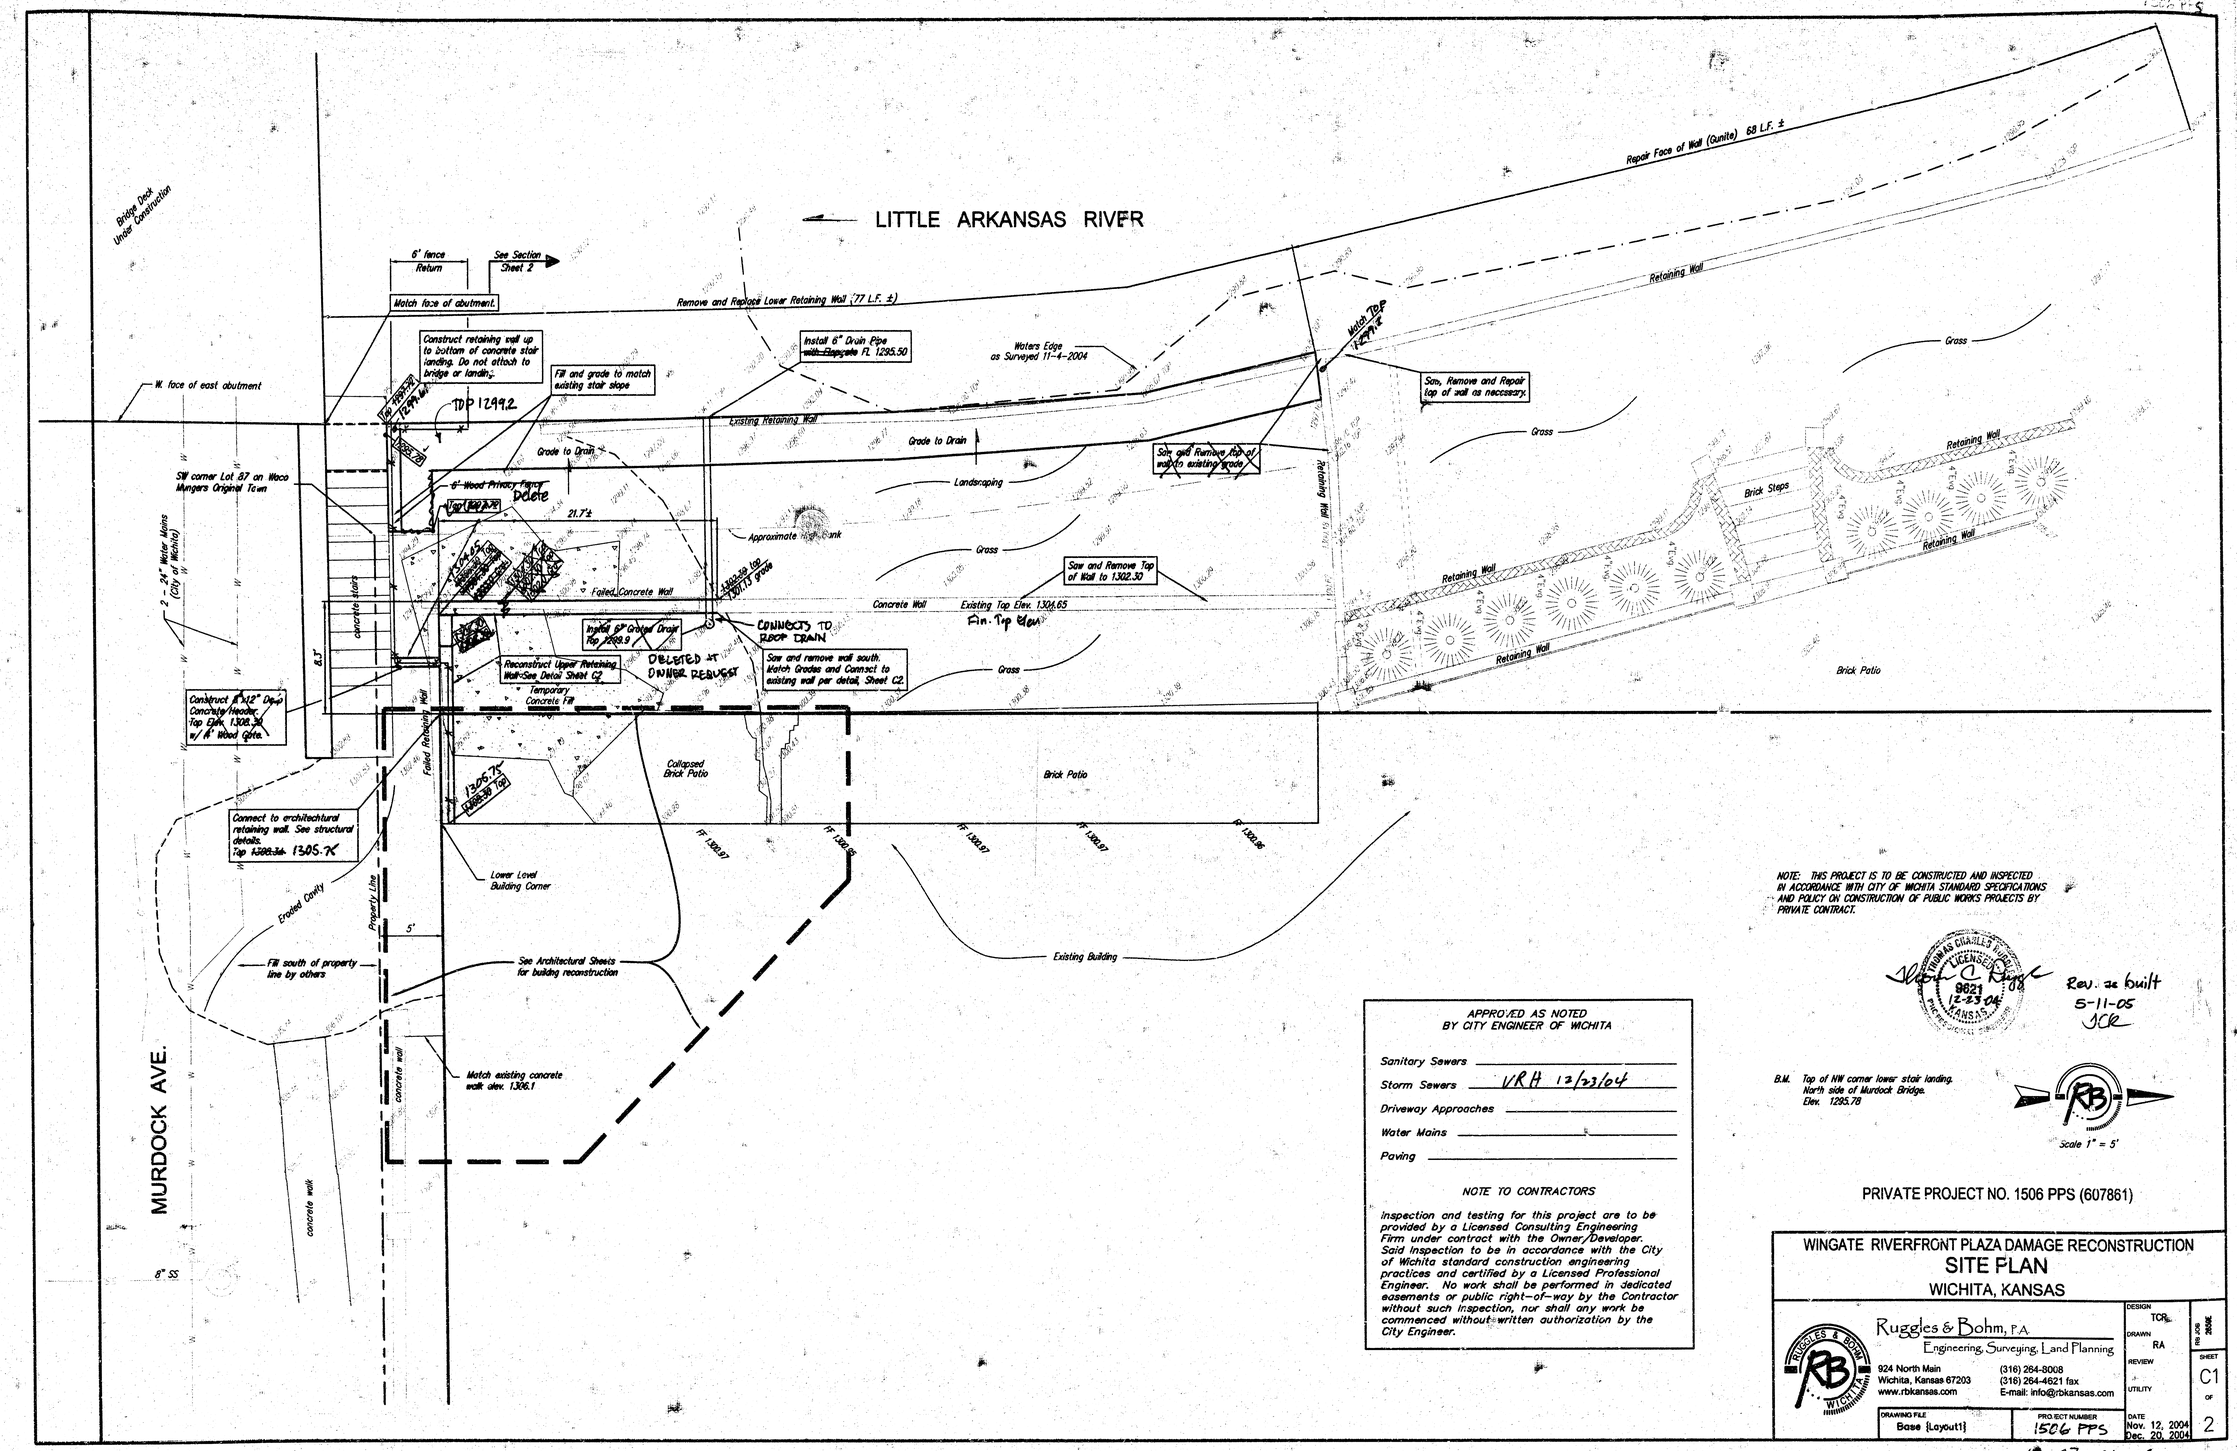

APPROVED AS NOTED
BY CITY ENGINEER OF WICHITA

Sanitary Sewers _____

Storm Sewers VRH 12/23/04

Driveway Approaches _____

Water Mains _____

Paving _____

NOTE TO CONTRACTORS

Inspection and testing for this project are to be provided by a Licensed Consulting Engineering Firm under contract with the Owner/Developer. Said inspection to be in accordance with the City of Wichita standard construction engineering practices and certified by a Licensed Professional Engineer. No work shall be performed in dedicated easements or public right-of-way by the Contractor without such inspection, nor shall any work be commenced without written authorization by the City Engineer.

NOTE: THIS PROJECT IS TO BE CONSTRUCTED AND INSPECTED IN ACCORDANCE WITH CITY OF WICHITA STANDARD SPECIFICATIONS AND POLICY ON CONSTRUCTION OF PUBLIC WORKS PROJECTS BY PRIVATE CONTRACT.

THOMAS CHARLES RINGE LICENSED 9821 12-23-04 KANSAS PROFESSIONAL ENGINEER

Rev. as built 5-11-05 JCR

B.M. Top of NW corner lower stair landing. North side of Murdock Bridge. Elev. 1295.78

Scale 1" = 5'

PRIVATE PROJECT NO. 1506 PPS (607861)

WINGATE RIVERFRONT PLAZA DAMAGE RECONSTRUCTION
SITE PLAN
WICHITA, KANSAS

Ruggles & Bohm, P.A.
Engineering, Surveying, Land Planning
924 North Main
Wichita, Kansas 67203
www.rbkansas.com
(316) 264-8008
(316) 264-4621 fax
E-mail: info@rbkansas.com

DESIGN	TCR
DRAWN	RA
REVIEW	
UTILITY	
DRAWING FILE	Base (Layout1)
PROJECT NUMBER	1506 PPS
DATE	Nov. 12, 2004 Dec. 20, 2004
RB JOB #	2006
SHEET	C1
OF	2

1 07 01 04

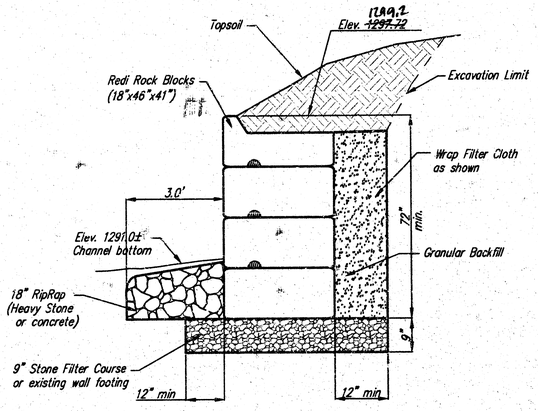

LOWER RETAINING WALL

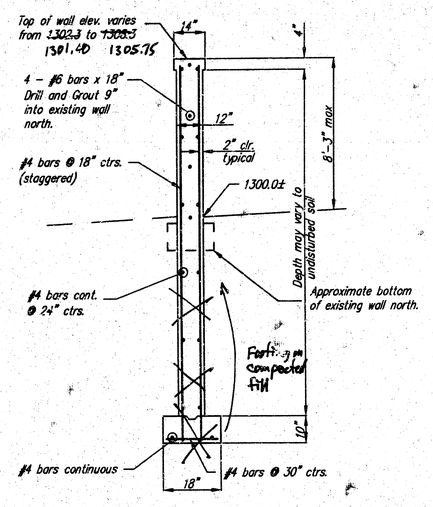

UPPER RETAINING WALL

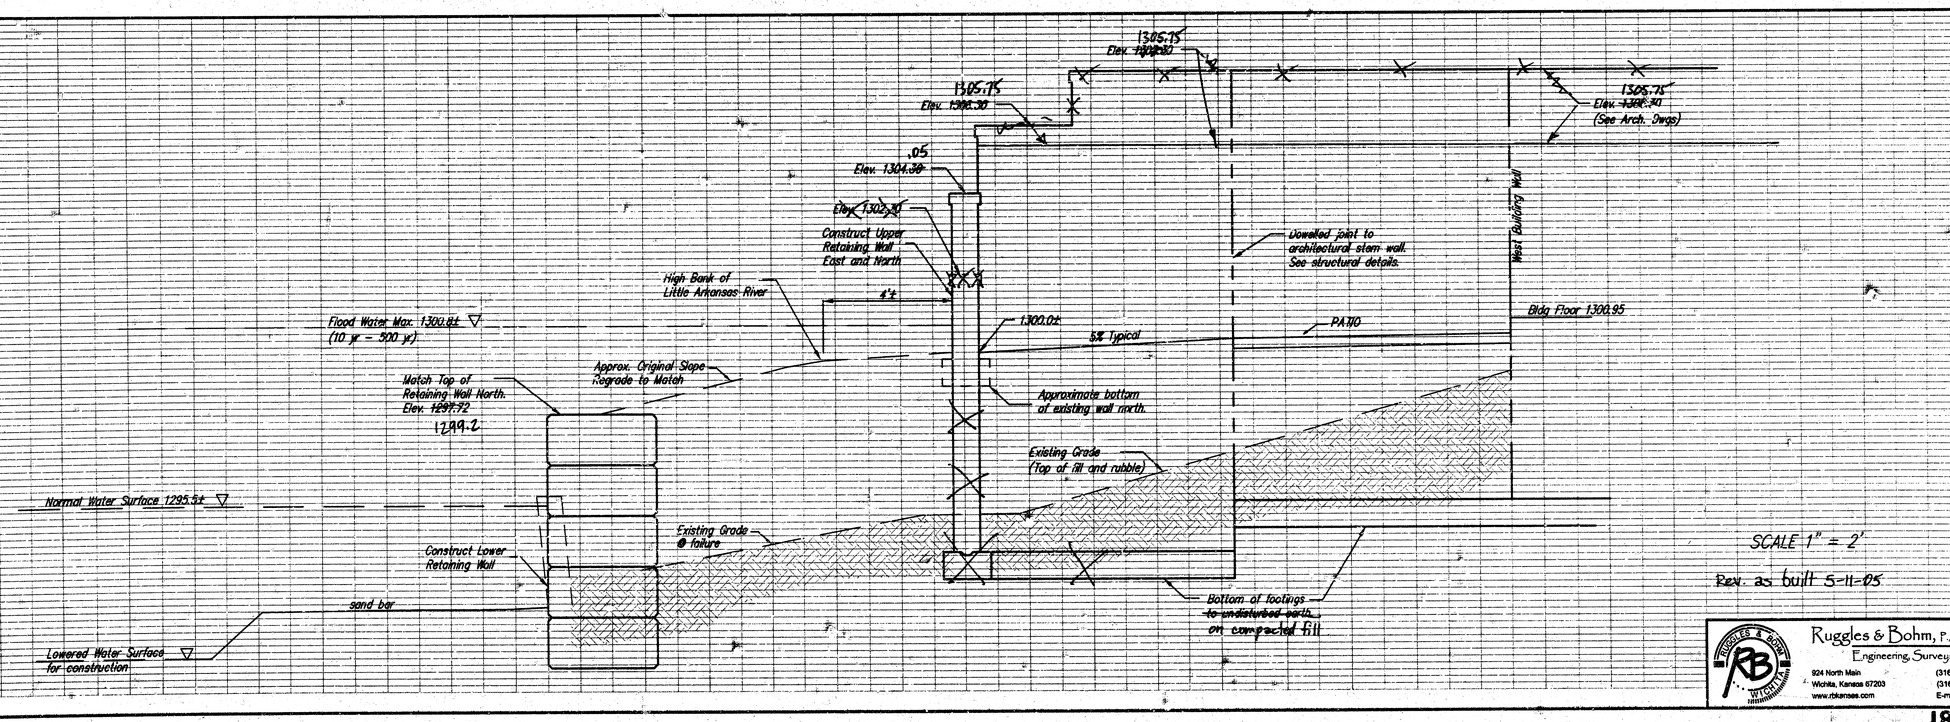

SCALE 1" = 2'

Rev. as built 5-11-05

Ruggles & Bohm, P.A.
Engineering, Surveying, Land Planning
924 North Main
Wichita, Kansas 67203
www.rbkansas.com
(316) 264-8008
(316) 264-4621 fax
E-mail: info@rbkansas.com

DRAWN RA REVISED Dec. 20, 2004
DESIGN TCR DATE Nov. 12, 2004
UTILITY REVIEW
PROJECT NUMBER 1596.PPS
DRAWING FILE Rcbm [Layout1]

WINGATE RIVERFRONT PLAZA
SECTION AT SOUTH WALL
WICHITA, KANSAS

RB JOB 2659E
SHEET C2
OF 2

18 02 01 04

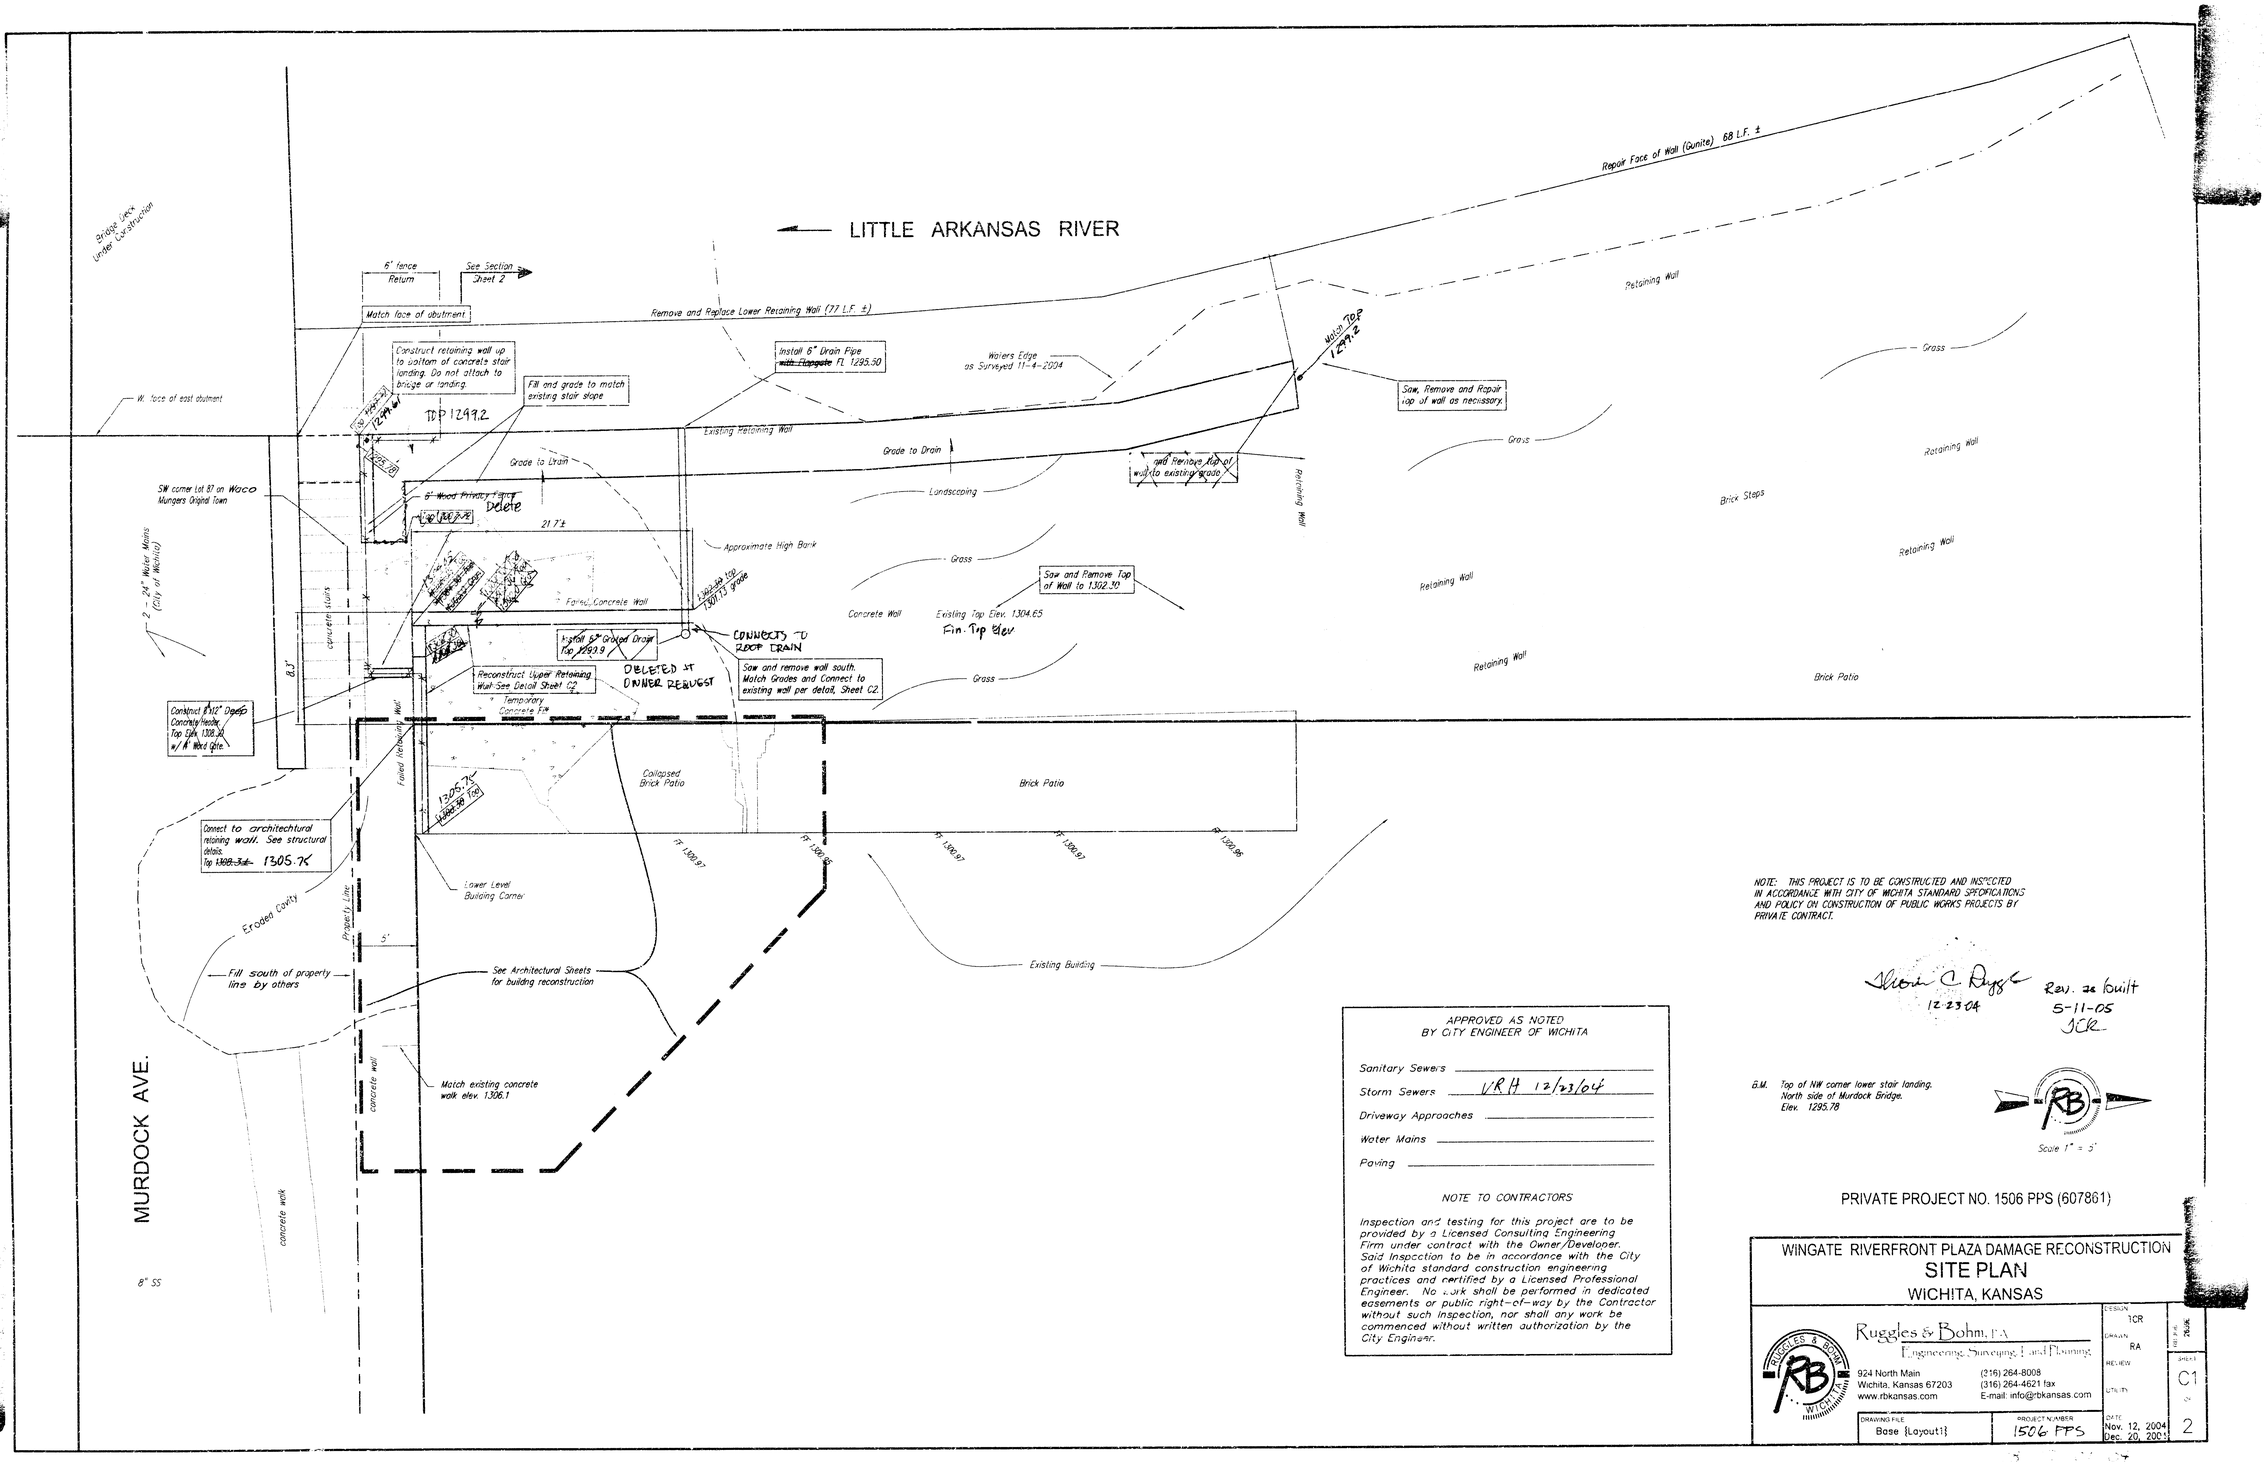

NOTE: THIS PROJECT IS TO BE CONSTRUCTED AND INSPECTED IN ACCORDANCE WITH CITY OF WICHITA STANDARD SPECIFICATIONS AND POLICY ON CONSTRUCTION OF PUBLIC WORKS PROJECTS BY PRIVATE CONTRACT.

Steven C. Ruggles 12-23-04

Rev. as built 5-11-05 SCR

B.M. Top of NW corner lower stair landing. North side of Murdock Bridge. Elev. 1295.78

Scale 1" = 5'

APPROVED AS NOTED
BY CITY ENGINEER OF WICHITA

Sanitary Sewers _____

Storm Sewers VRH 12/23/04

Driveway Approaches _____

Water Mains _____

Paving _____

NOTE TO CONTRACTORS

Inspection and testing for this project are to be provided by a Licensed Consulting Engineering Firm under contract with the Owner/Developer. Said Inspection to be in accordance with the City of Wichita standard construction engineering practices and certified by a Licensed Professional Engineer. No work shall be performed in dedicated easements or public right-of-way by the Contractor without such inspection, nor shall any work be commenced without written authorization by the City Engineer.

PRIVATE PROJECT NO. 1506 PPS (607861)

WINGATE RIVERFRONT PLAZA DAMAGE RECONSTRUCTION
SITE PLAN
WICHITA, KANSAS

Ruggles & Bohm, P.A.
Engineering, Surveying, Land Planning
924 North Main
Wichita, Kansas 67203
www.rbkansas.com
(316) 264-8008
(316) 264-4621 fax
E-mail: info@rbkansas.com

DESIGN	TCR
DRAWN	RA
REVIEW	
UTILITY	
DRAWING FILE	Base {Layout1}
PROJECT NUMBER	1506 PPS
DATE	Nov. 12, 2004 Dec. 20, 2004
SHEET	C1
OF	2

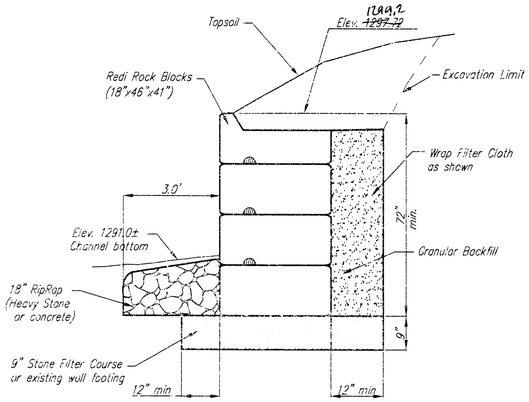

LOWER RETAINING WALL

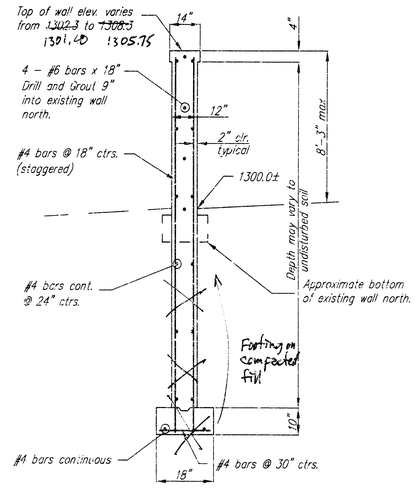

UPPER RETAINING WALL

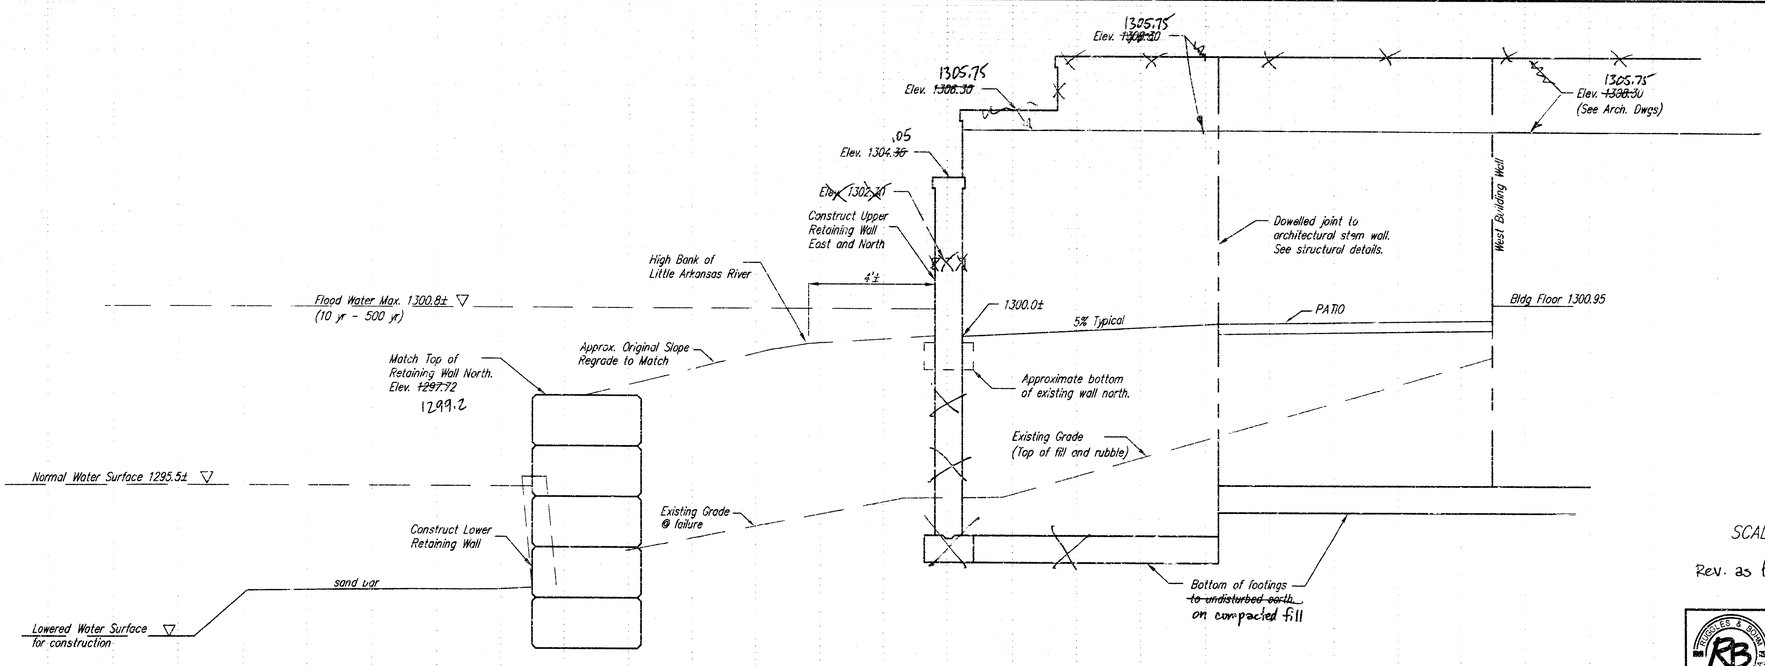

SCALE 1" = 2'

Rev. as built 5-11-05

DRAWN	RA Dec. 20, 2004
CHECKED	TCH Nov. 12, 2004
PROJECT NUMBER	15126 PPS
DRAWING FILE	Base Layout

WINGATE RIVERFRONT PLAZA
SECTION AT SOUTH WALL
WICHITA, KANSAS

Ruggles & Bohm, P.A.
Engineering, Surveying, Land Planning
924 North Main
Wichita, Kansas 67203
www.rbkansas.com
(316) 264-8008
(316) 264-4621 fax
E-mail: info@rbkansas.com

RB JOB 2659E
SHEET C2 OF 2

40 of 70 of 81