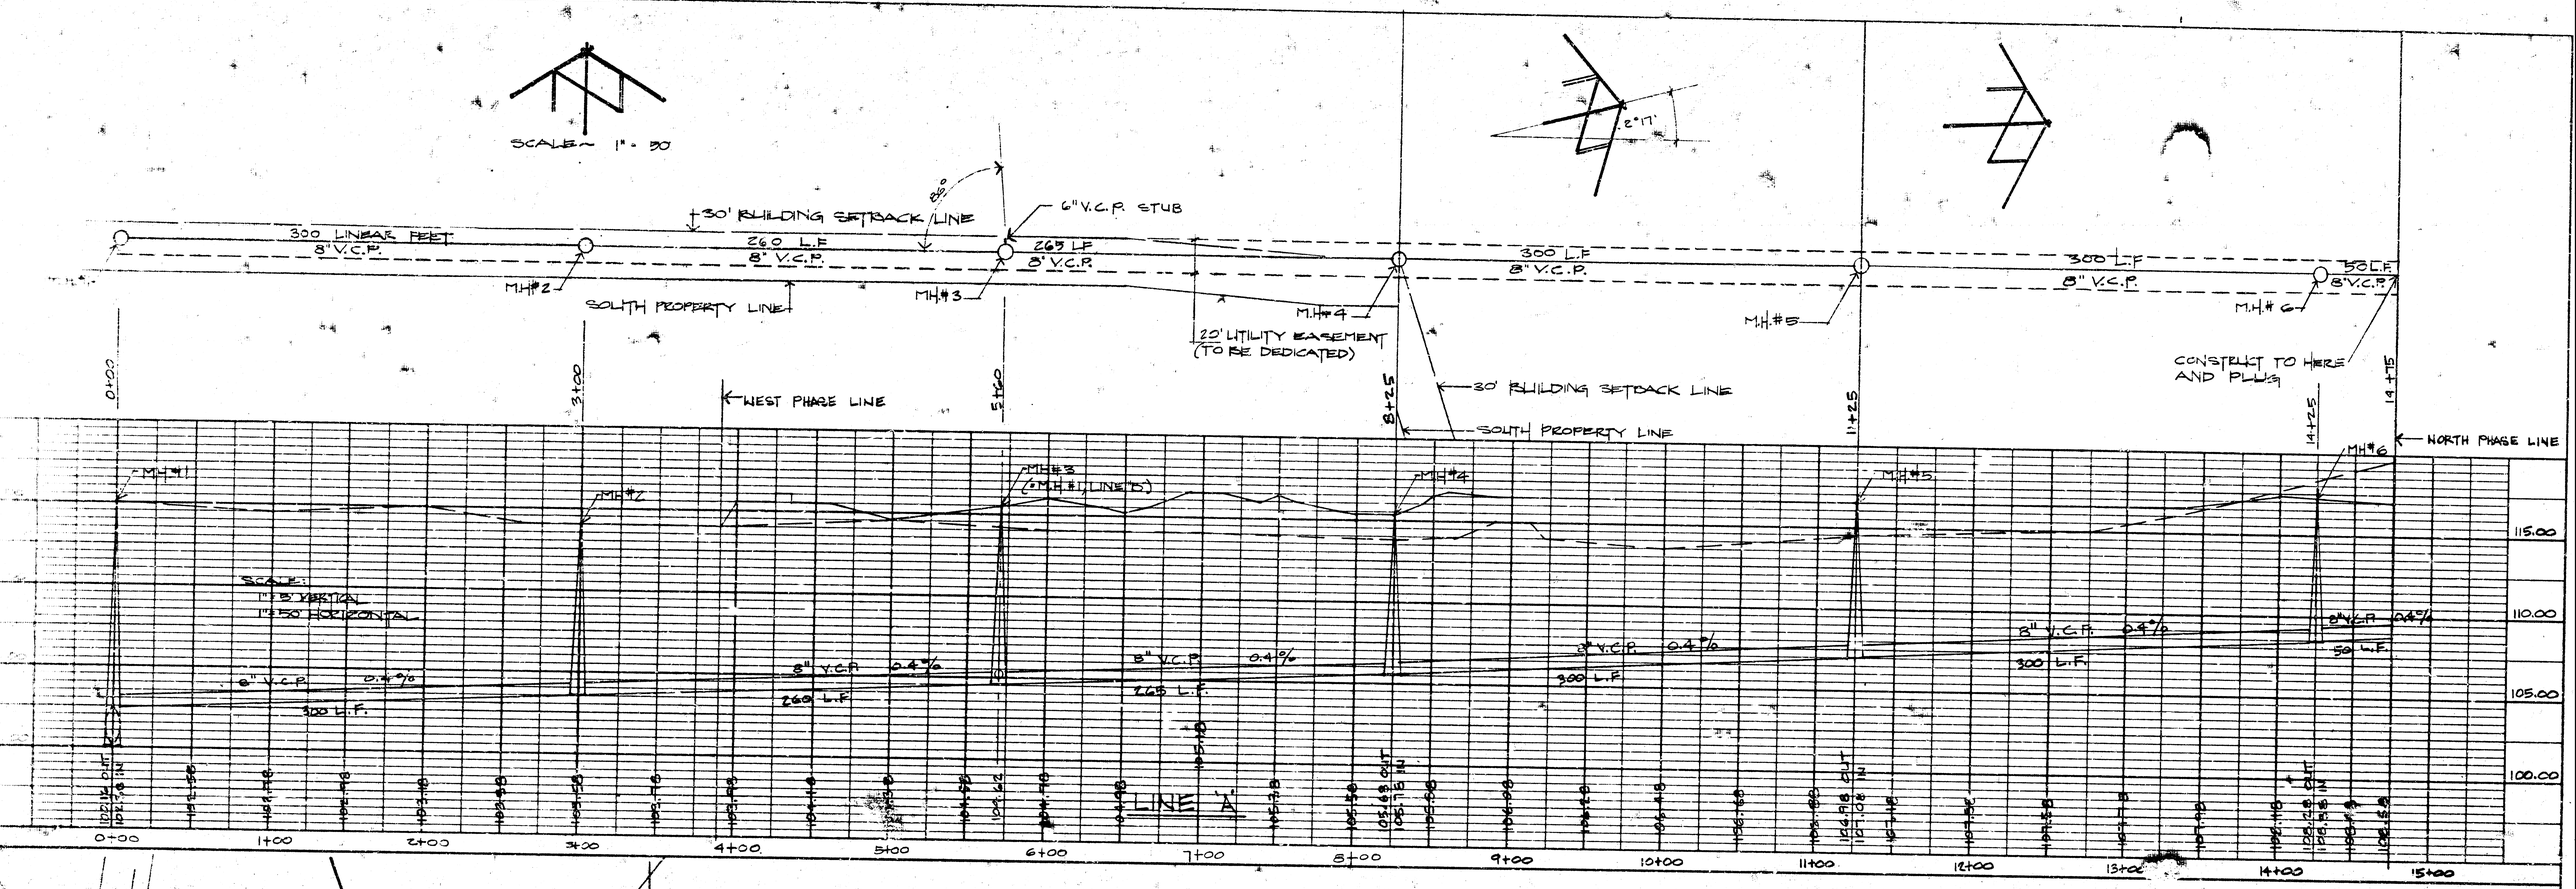

REVISED 3·17·77 J.W.H.

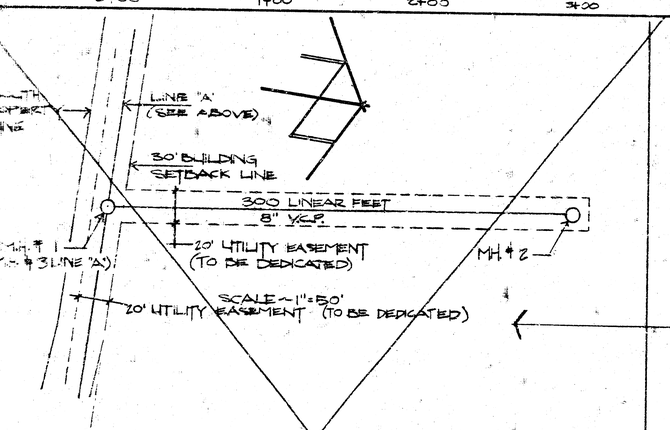

NOTE: ALL SANITARY SEWER TO BE CONSTRUCTED TO CITY OF WICHITA STANDARDS AND SPECIFICATIONS

LINE 'B' DELETED 3·17·77

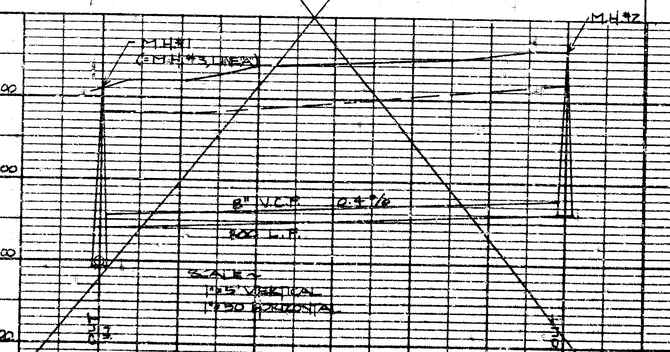

MOUNT CARMEL BUILDINGS