




A REPLAT OF EXCEPTION IN
A.J. CHRISTMAN THIRD ADDITION
WICHITA, KANSAS

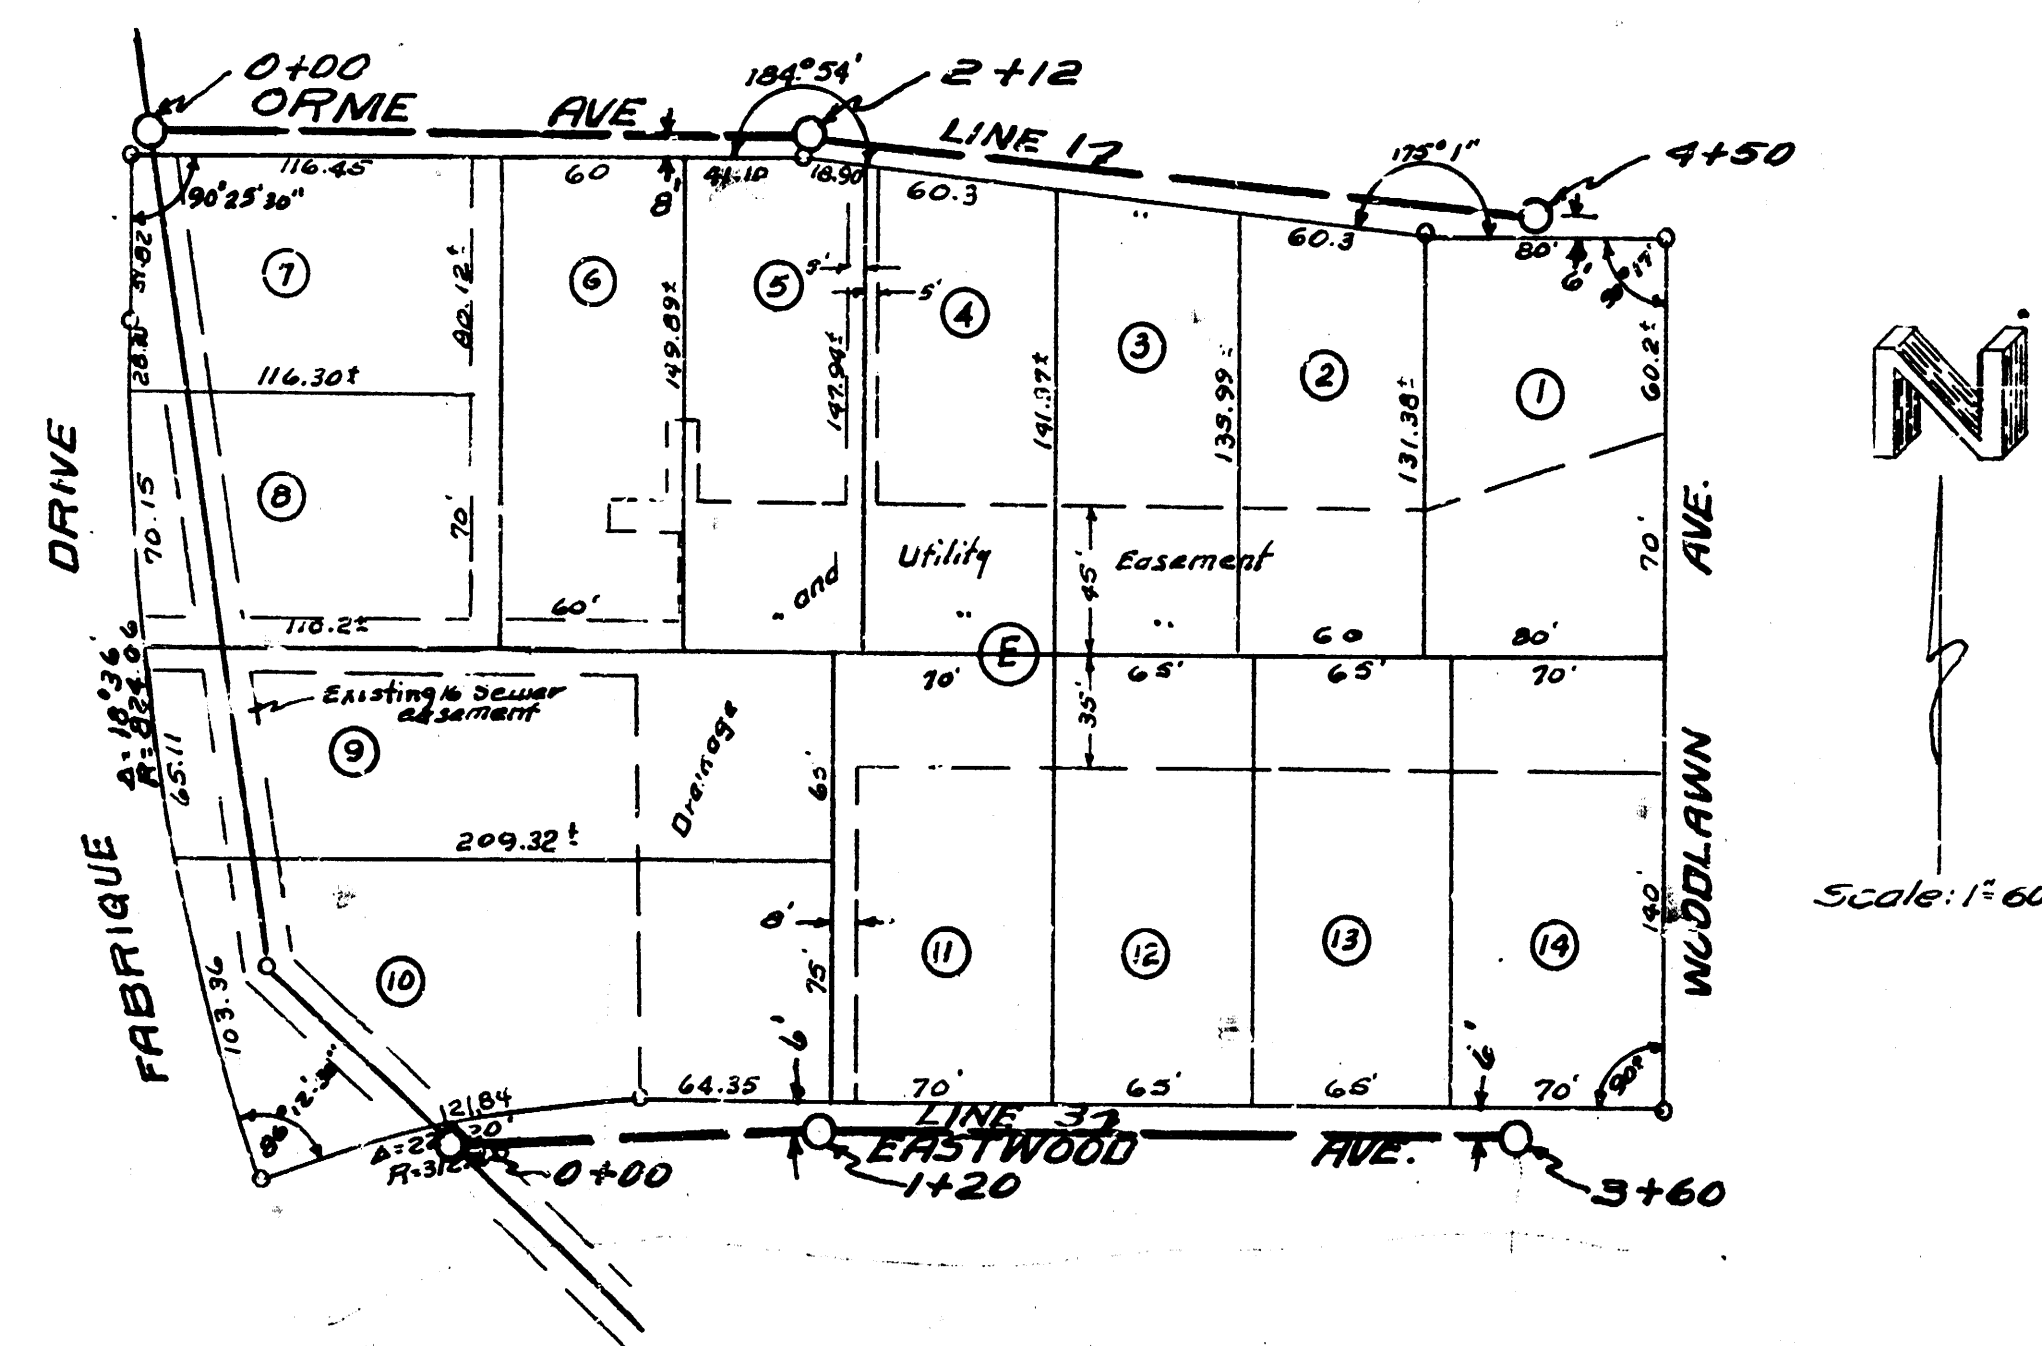


REPLAT OF LOTS 2 & 3
PATE'S ADDITION

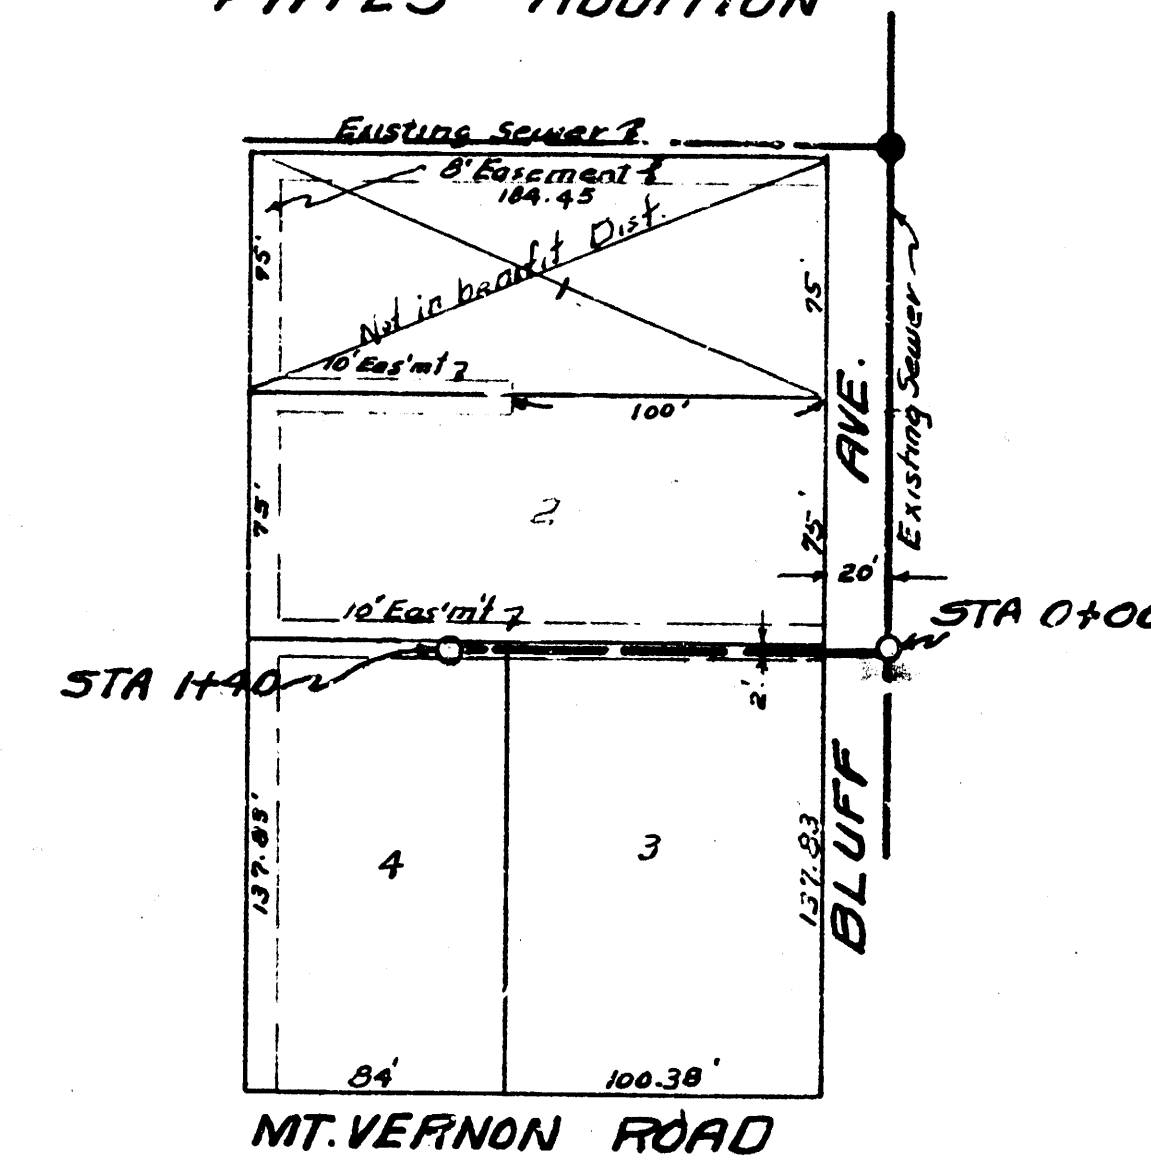

10-1-53
Drawn by
McClain
Checked by
Book No. 71-Y

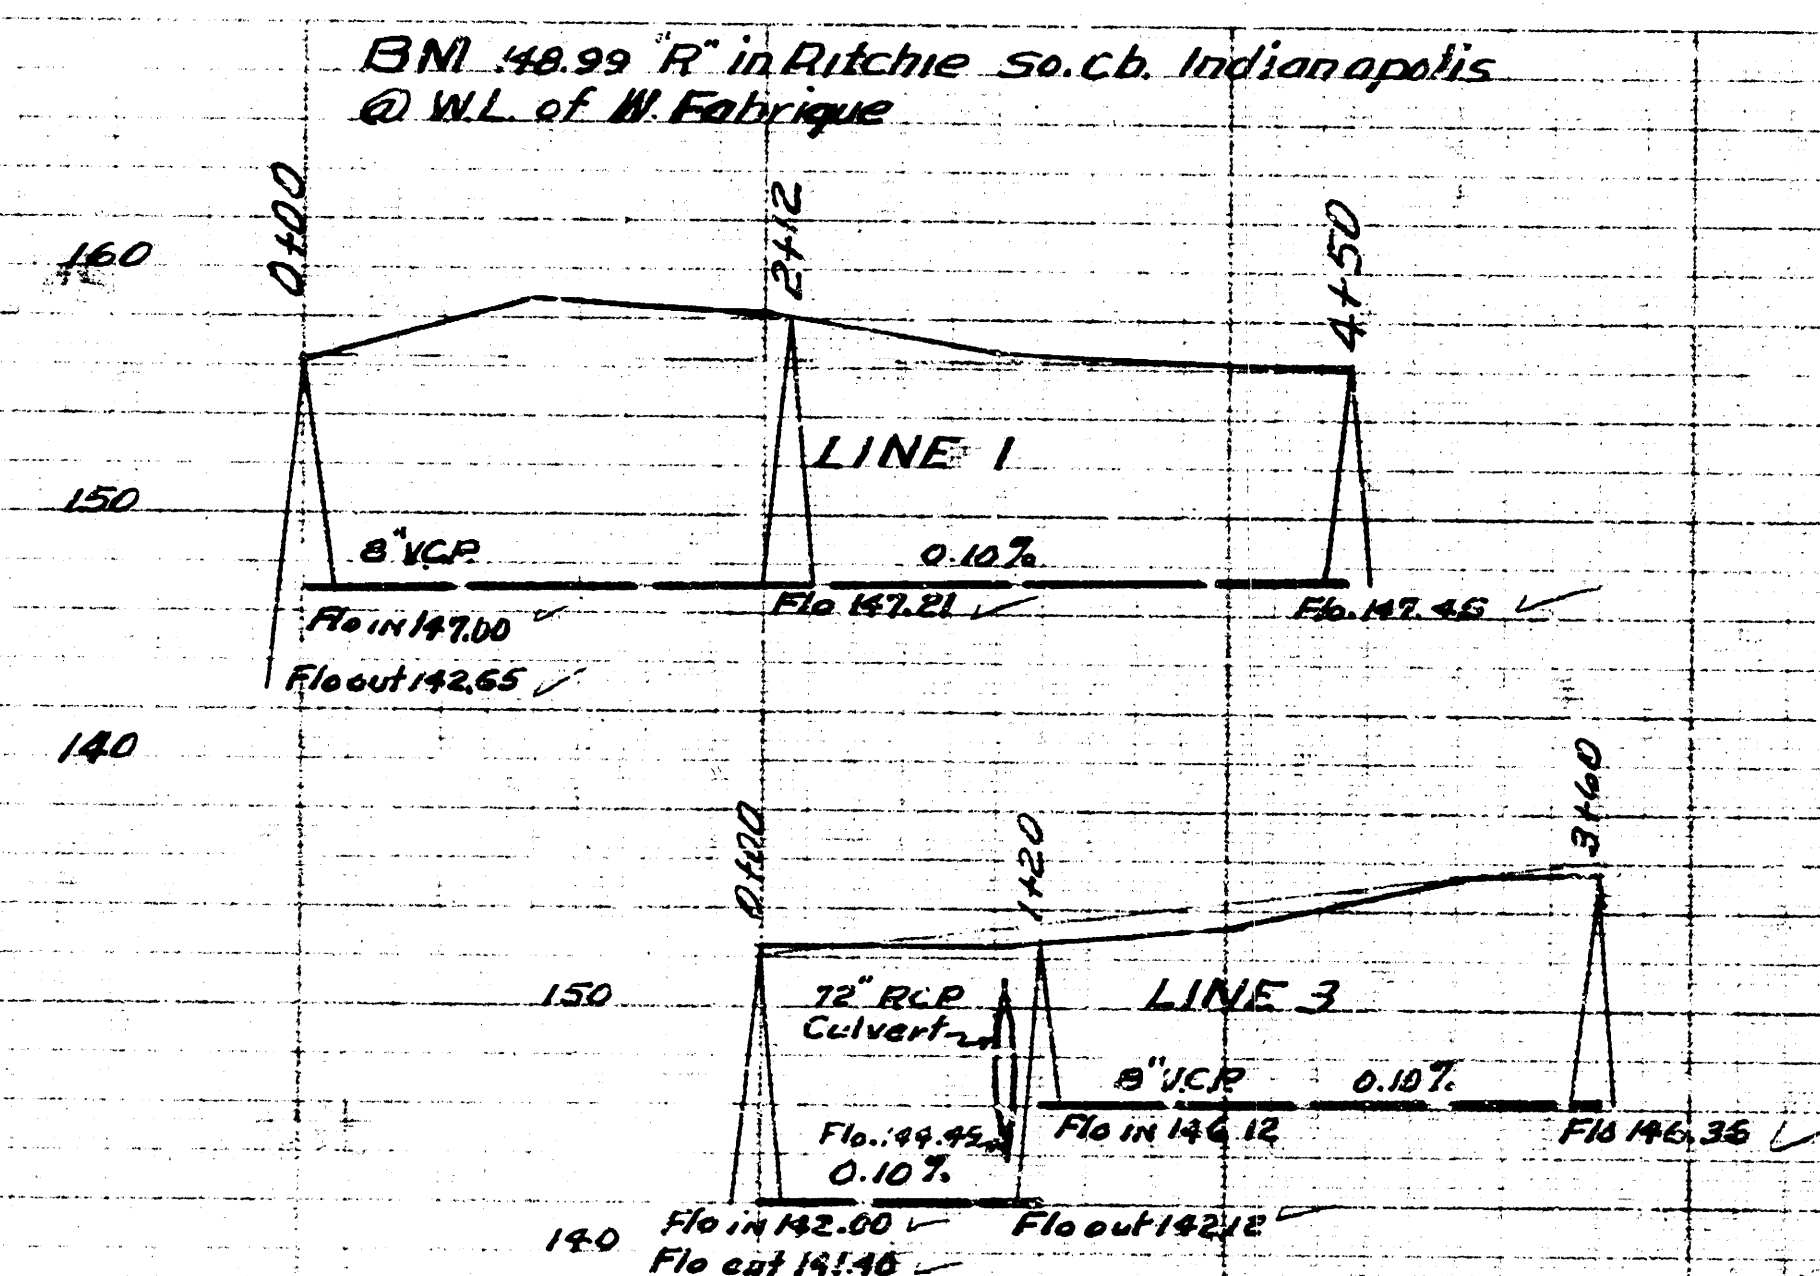

9-30-53
Drawn by
McClain
Checked by
Book No. 69-Y

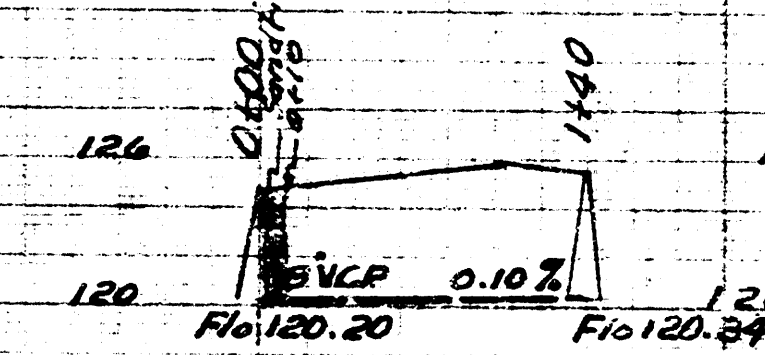

BM. 125.27 Head 60" SPIKE w. s. wood
piling No wingwall bridge 55' SW. of
MT. Vernon & Bluff

LAT. 13 SUBMAIN & WLS
CITY OF WICHITA, KANSAS
B.E. SMITH, CITY ENGINEER
Proj. No. C-23-49

SUB. 1 LAT. 22 DCS. 2 SS. 12
CITY OF WICHITA, KANSAS
B.E. SMITH, CITY ENGINEER
Proj. No. C-23-50

