
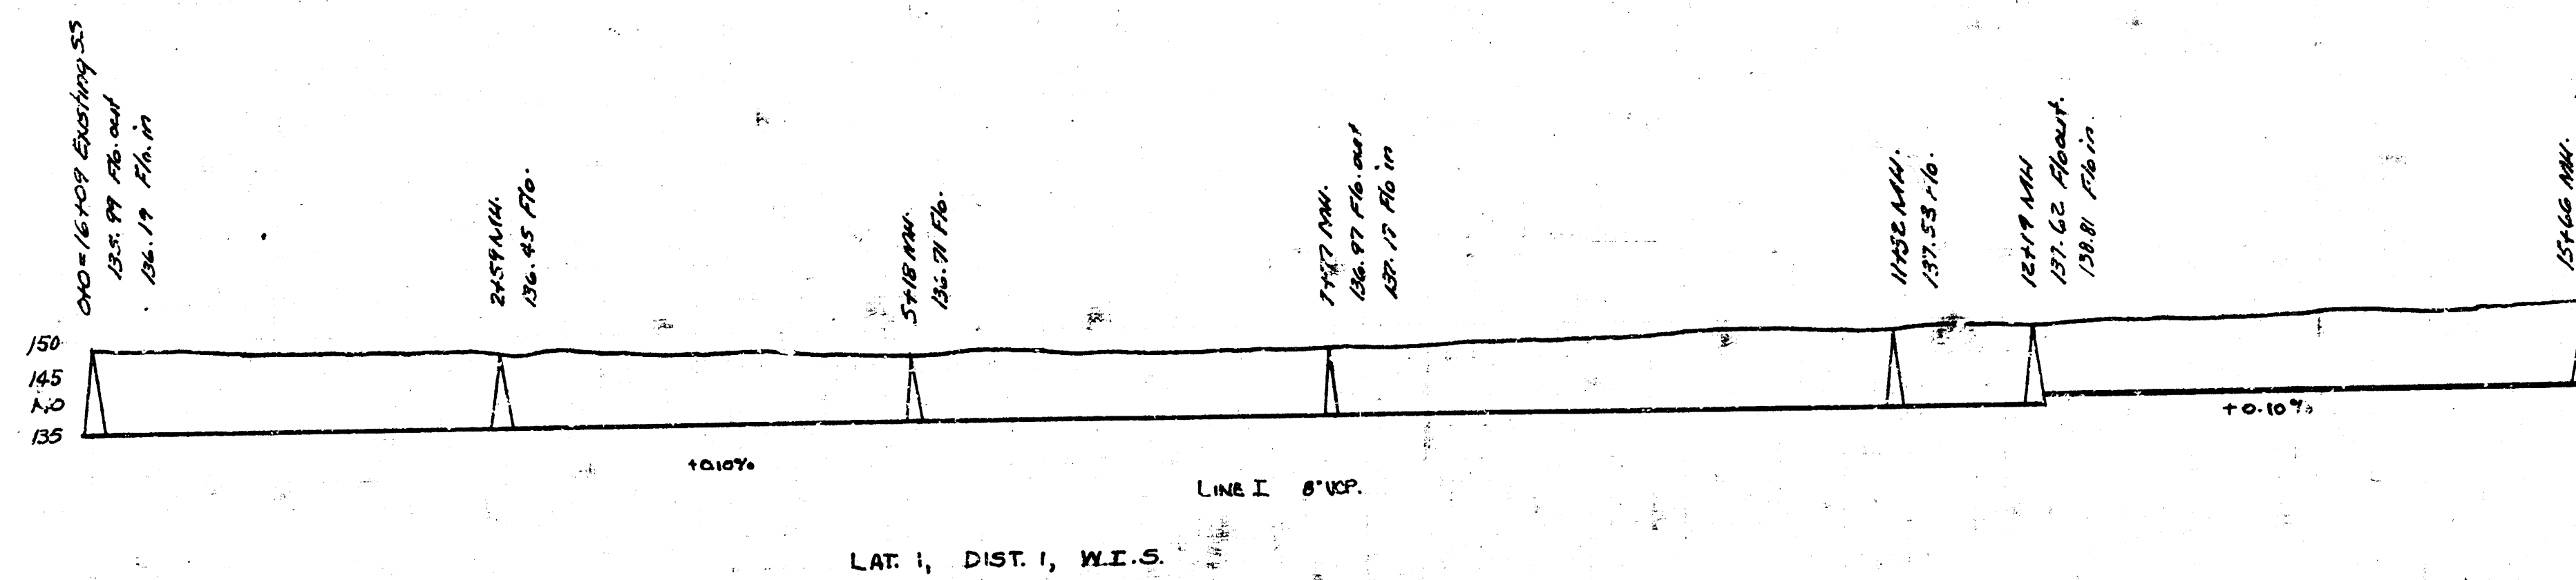
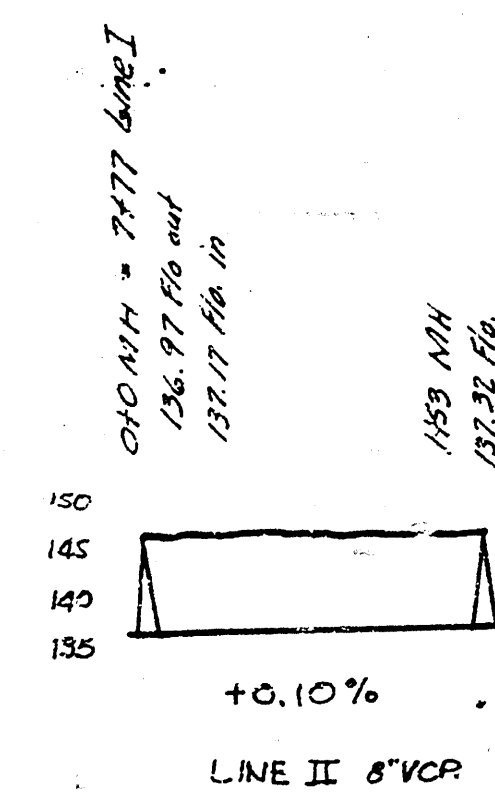
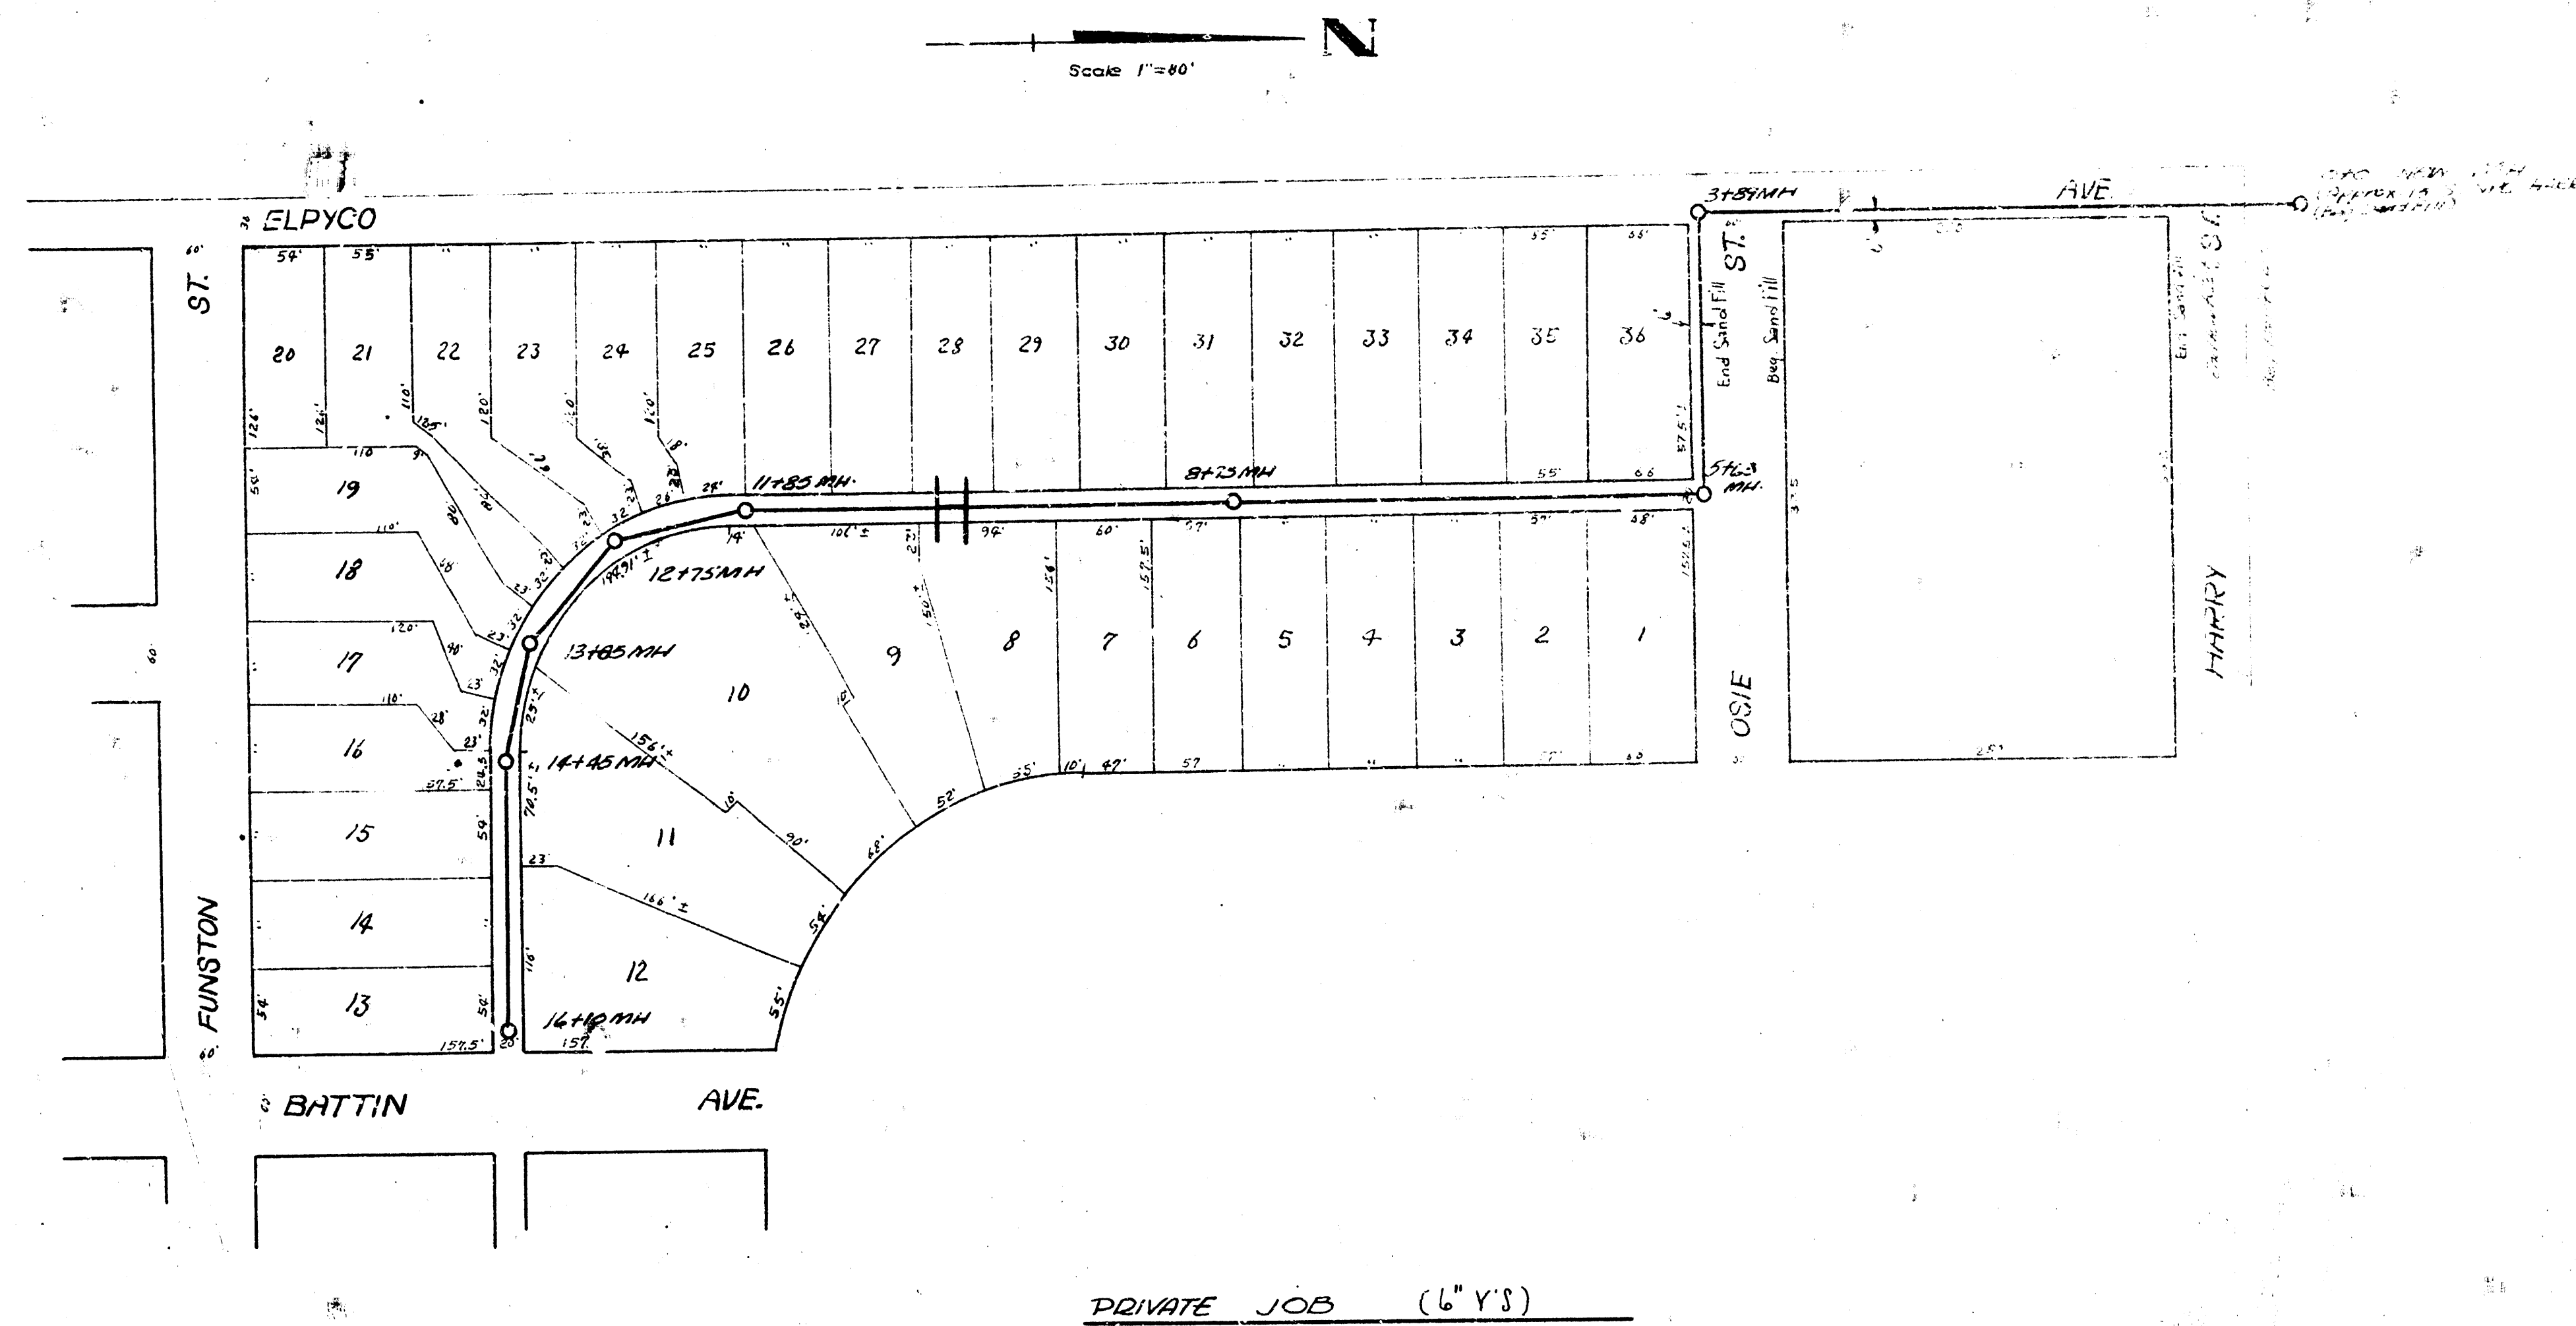
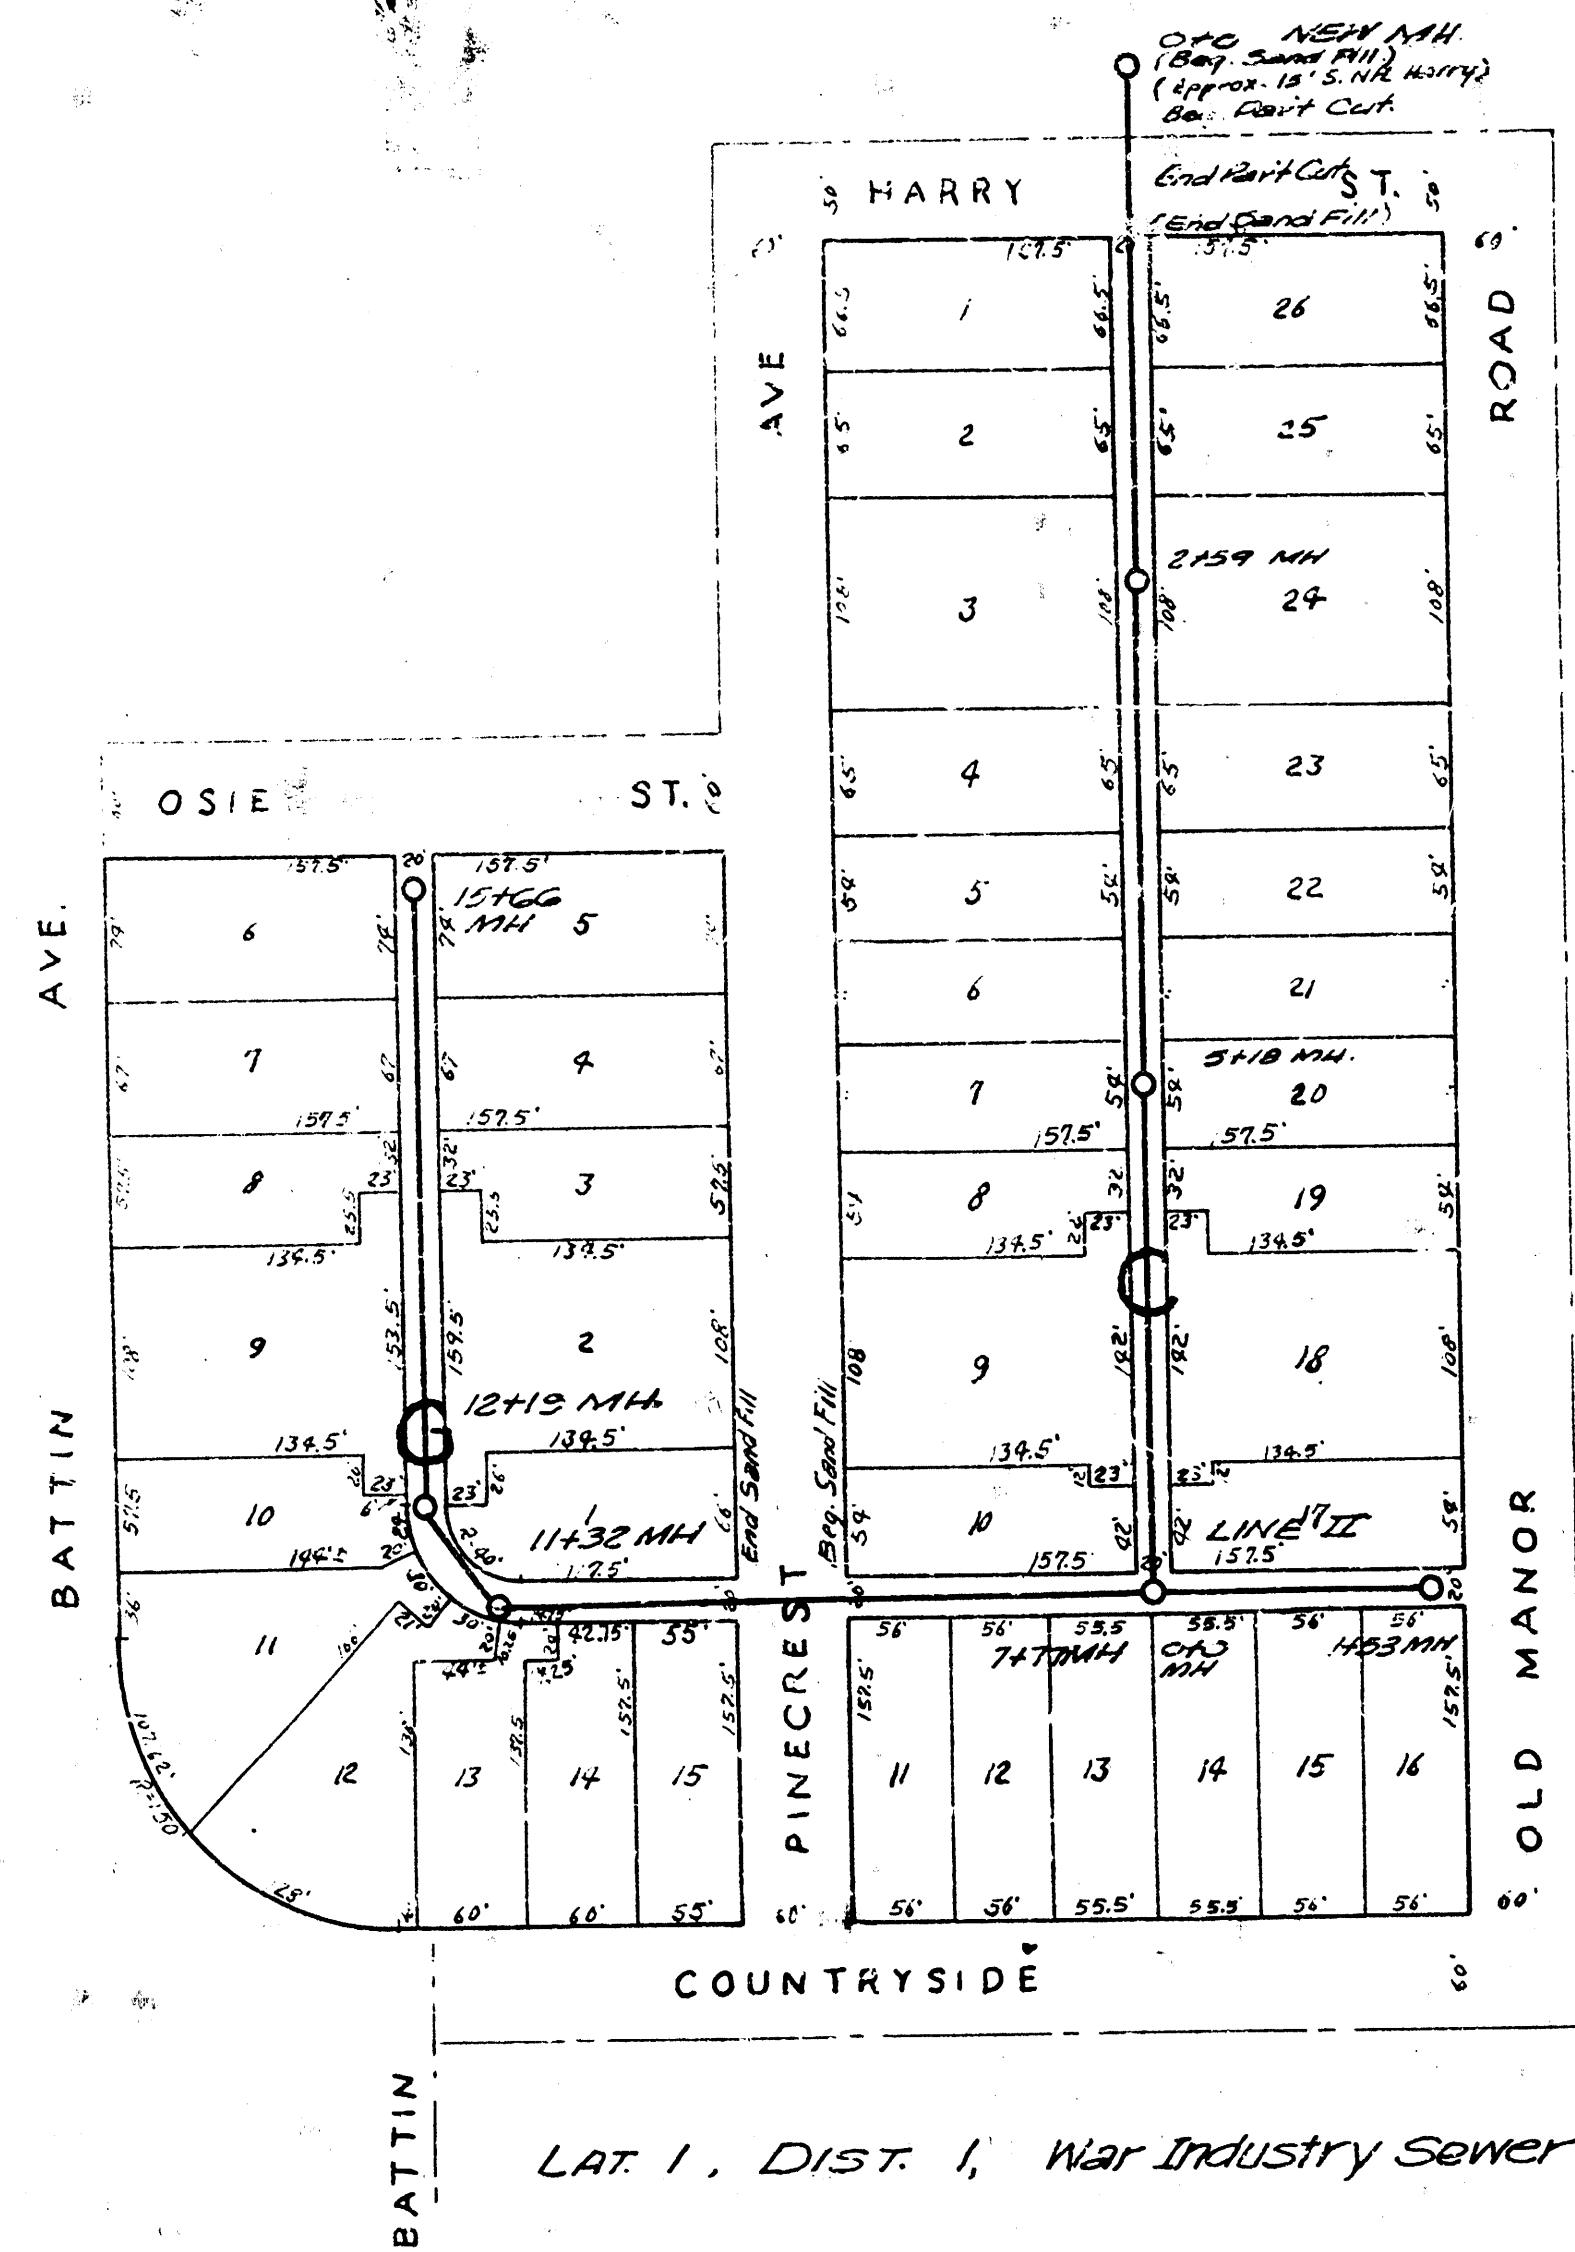


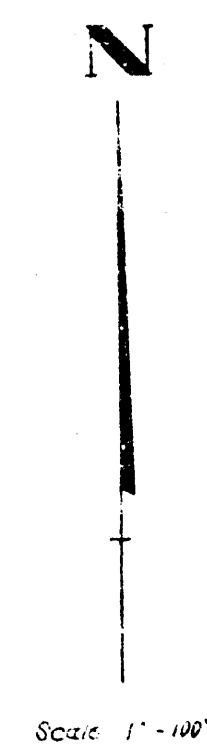

PRIVATE JOB - RES. H.  
LAT. 1, DIST. 1, WAR INDUSTRY SEWER.  
CITY OF WICHITA - KANSAS  
L. K. WHITE - CITY ENGINEER  
Date: 9-20-45 PROJ. NO. - 127-34