


B.M. 139.81 0 IN TOP NE COR HD'WL 2000 ON ROCK ROAD - 400'S OF TURNPIKE

PLAN SCALE 1"=40'
PROFILE SCALE 1"=40' HOR, 1"=4' VERTICAL

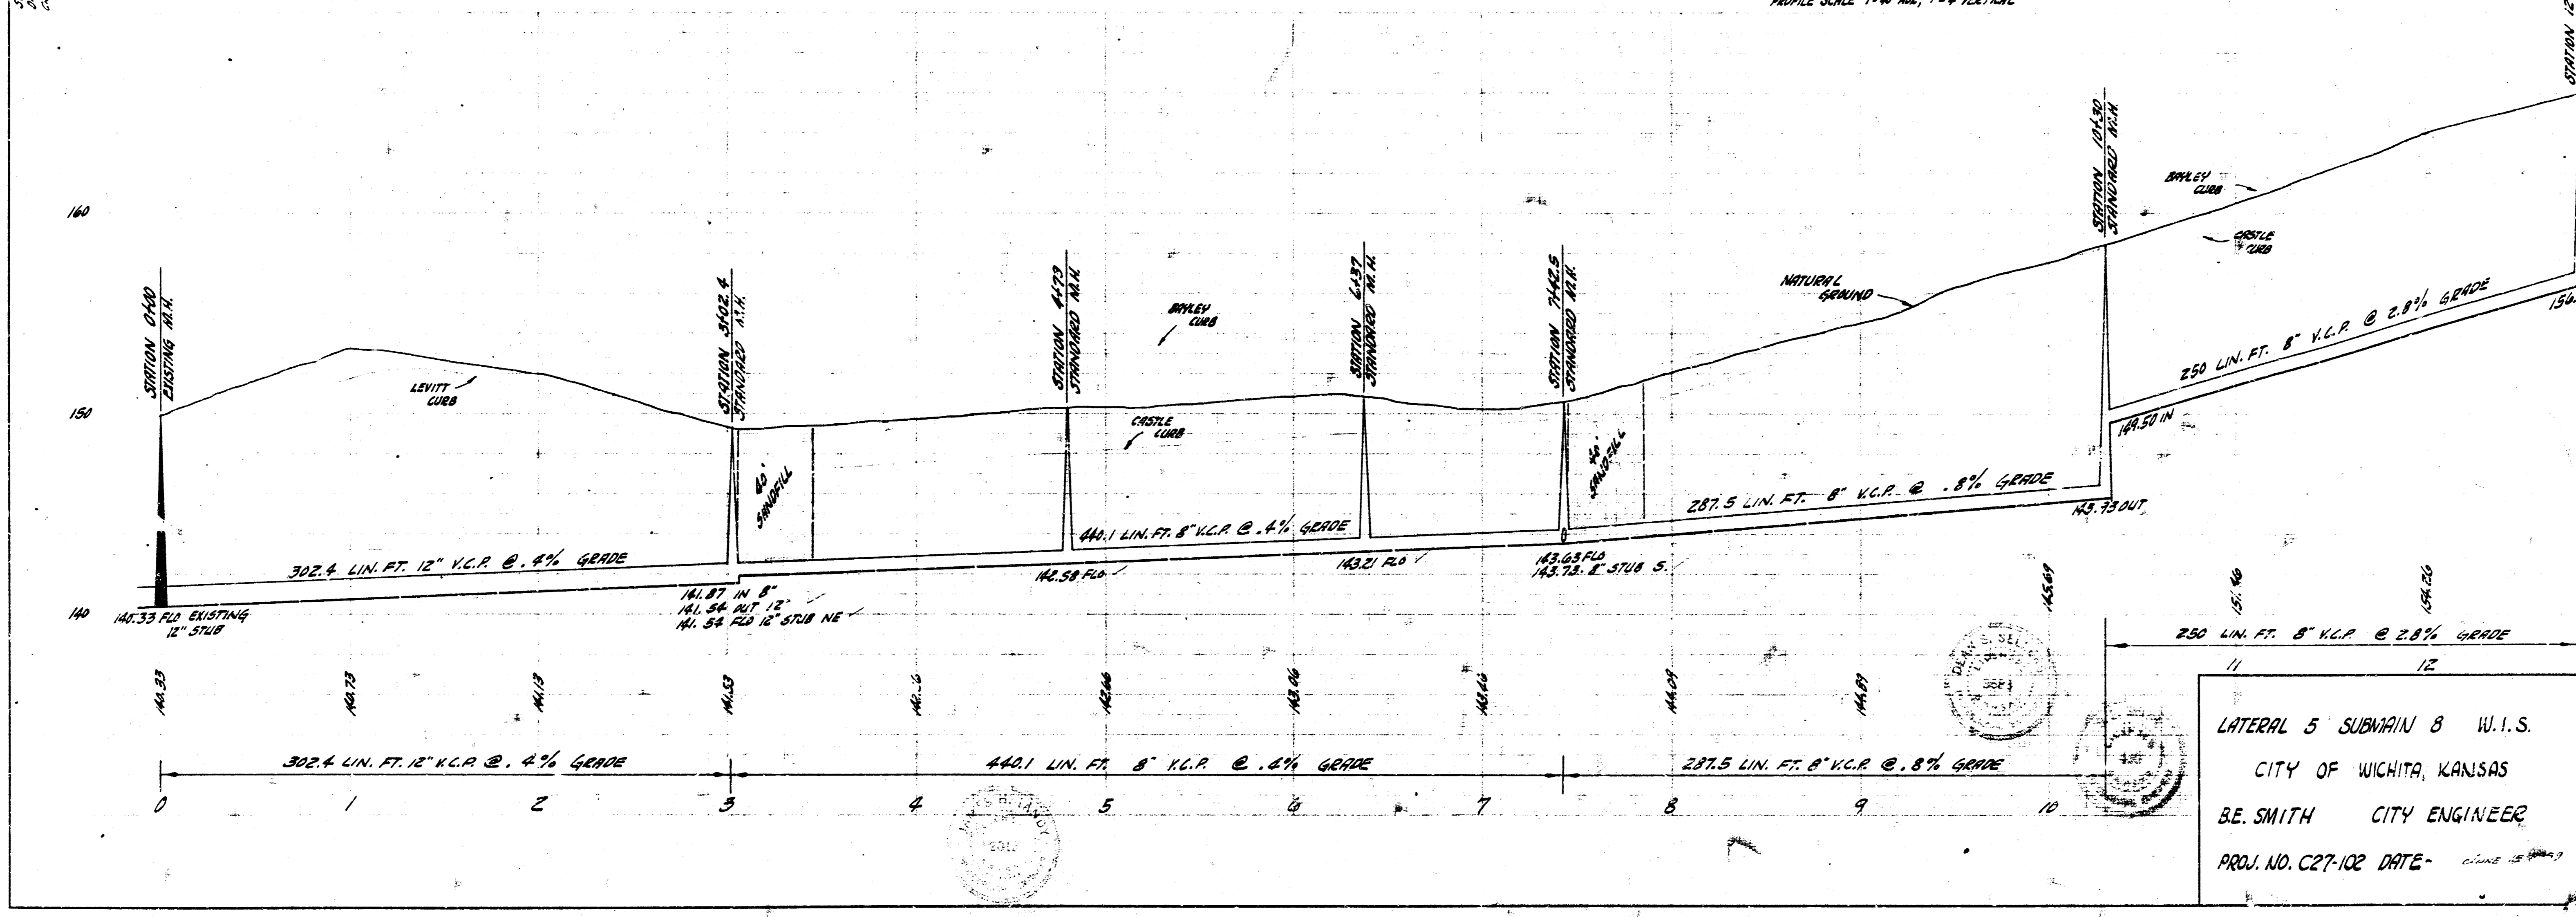

LATERAL 5 SUBMAIN B W.I.S.
CITY OF WICHITA, KANSAS
B.E. SMITH CITY ENGINEER
PROJ. NO. C27-102 DATE -