G. Young
D. Cramer

STA. 0+00 EXIST. M.H.
BEGIN C.L. NO. 1

LINE NO. 2

DEDICATION

DRAINAGE

LANE

TARA

TAMARAC LANE

BROOKHOLLOW FIRST ADDN.

1 2 3 4 5 6 7 8 9


























160
150
140
110
100

0 1 2 3 4 5 6 7 8 9 10 11

LAT. 10, SUB. 9, W. I. S.
CITY OF WICHITA, KANSAS
B. E. SMITH, CITY ENGINEER
PROJECT NO. C28-71
DATE: Sept. 1968 SHEET 1 OF 3

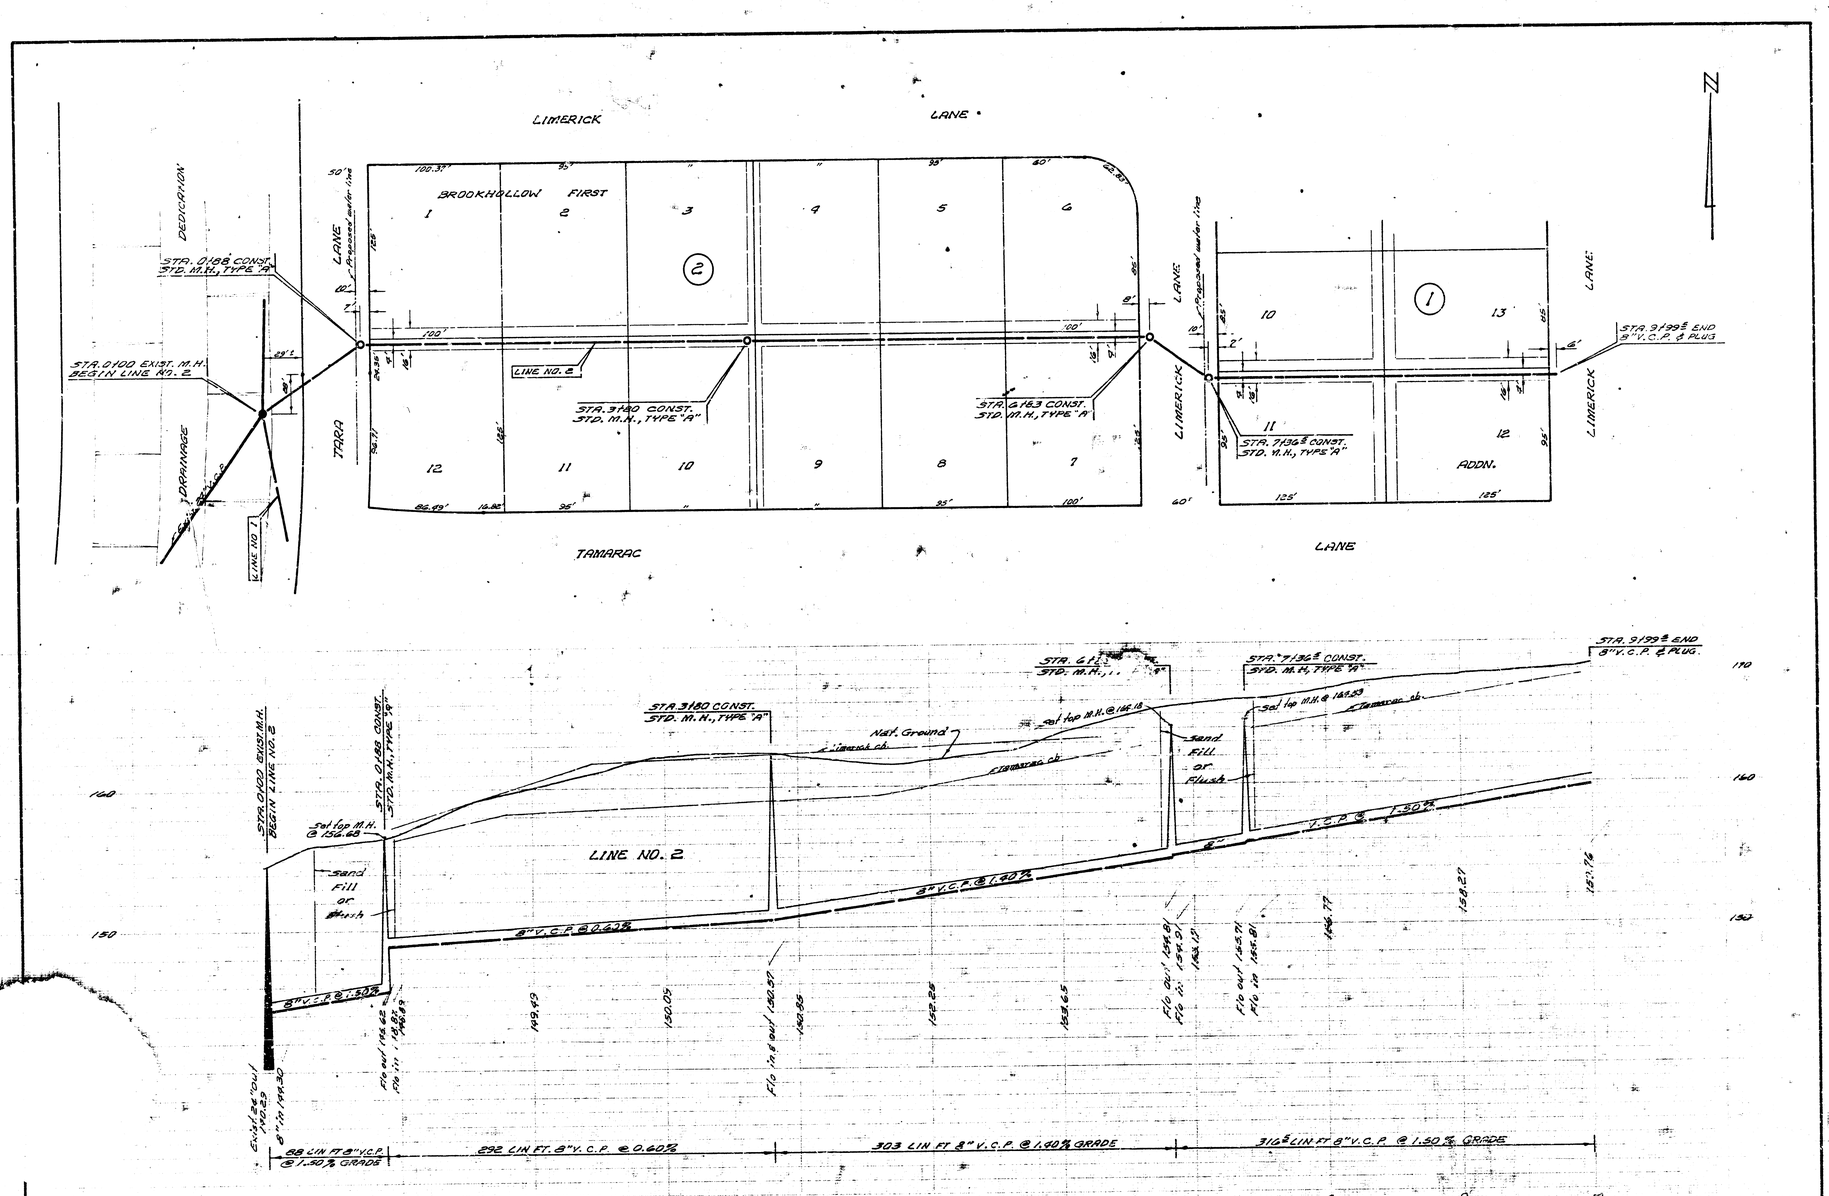

LAT. 10, SUB. 9, W. I. S.
PROJ. NO. C28-71

SHEET 2 OF 3

CENTRAL AVE.

Existing M.H. S. Rim = 137.06
R.C. El. = 131.06

Prop. row of Fr.

50'

100.57'

33'

143.33

91.49'

91.49'

DEDICATION

DRAINAGE

TRAD LANE

STA. 0+40 CONST. STD. M.H., TYPE "A" OVER EXIST. 54" V.C.P. WITH OUTSIDE DROP

Existing M.H. R.C. El. = 140.6

STA. 2175 CONST. STD. M.H., TYPE "A"

STA. 5150 CONST. STD. M.H., TYPE "A"

LINE NO. 4

STA. 8125 CONST. STD. M.H., TYPE "A" INSTALL 8" STUB E.

STA. 9180 CONST. STD. M.H. TYPE "A" END LINE NO. 4

BROOKHOLLOW FIRST

1 2 3 4 5 6 7 8 15

LIMERICK LANE

9 14

10 13

11 12 ADDN.

TAMARAC LANE

LIMERICK LANE

LIMERICK LANE

Natural Ground

LINE NO. 4

Sand Fill or Flush

8" V.C.P. @ 2.00%

8" V.C.P. @ 0.90%

8" V.C.P. @ 0.30%

outside drop in 142.90

275 LIN FT. 8" V.C.P. @ 2.00 %

705 LIN. FT. 8" V.C.P. @ 0.90 % GRADE

LAT. 10, SUB. 3, W. I. 3
PROJ. NO. C28-71
SHEET 3 OF 3