


Plan Scale 1"=40'
 Profile Scale Horiz. 1"=40'
 Vert. 1"=5'

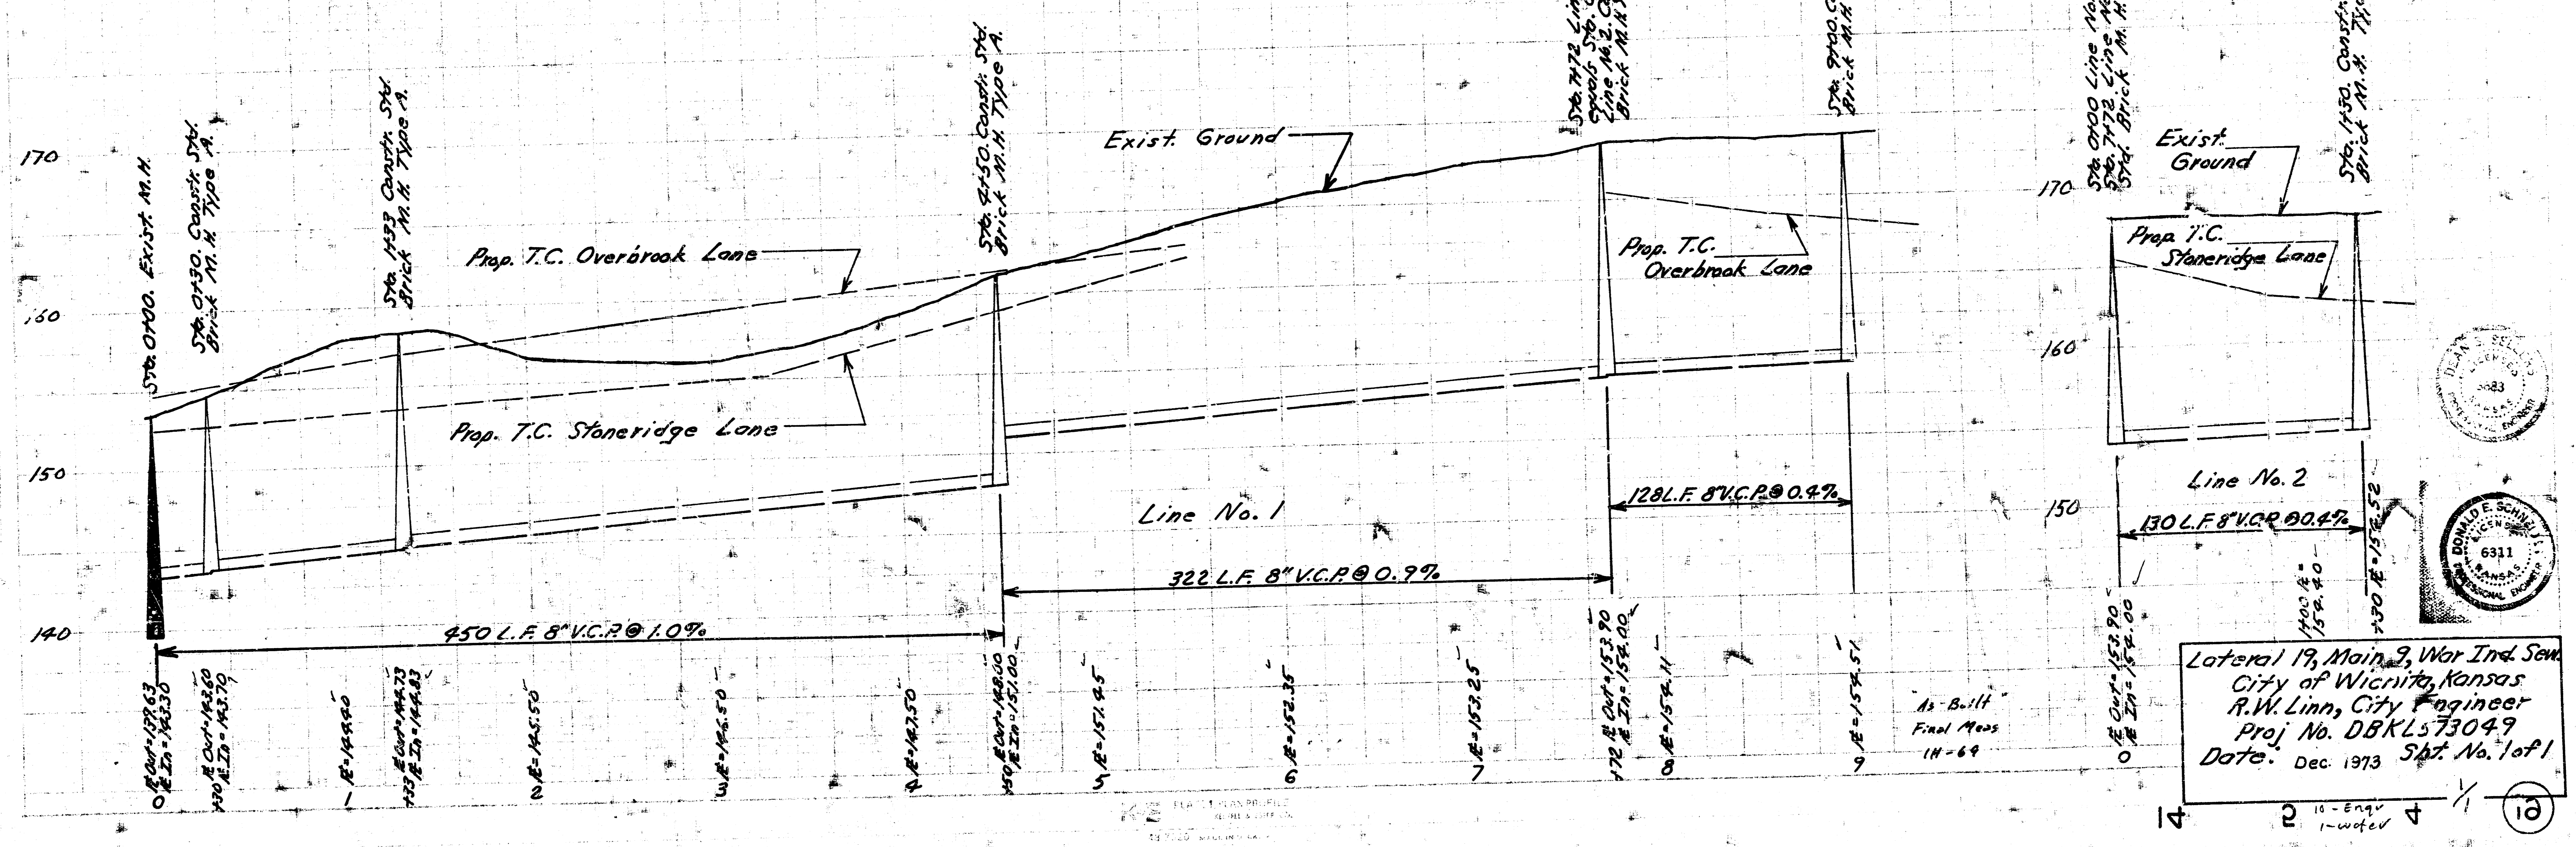

Lateral 19, Main 9, Wor Ind Sewer
 City of Wichita, Kansas
 R.W. Linn, City Engineer
 Proj No. DBKLS73049
 Date: Dec. 1973 Sht. No. 1 of 1

FILMED FROM THE BEST AVAILABLE COPY....