B.M. 1460.9 "a" Head Bolt SW Side P.P. N-Side NEW JERSEY ± 150' W. of J.L. GEORGE WASHINGTON Blvd.

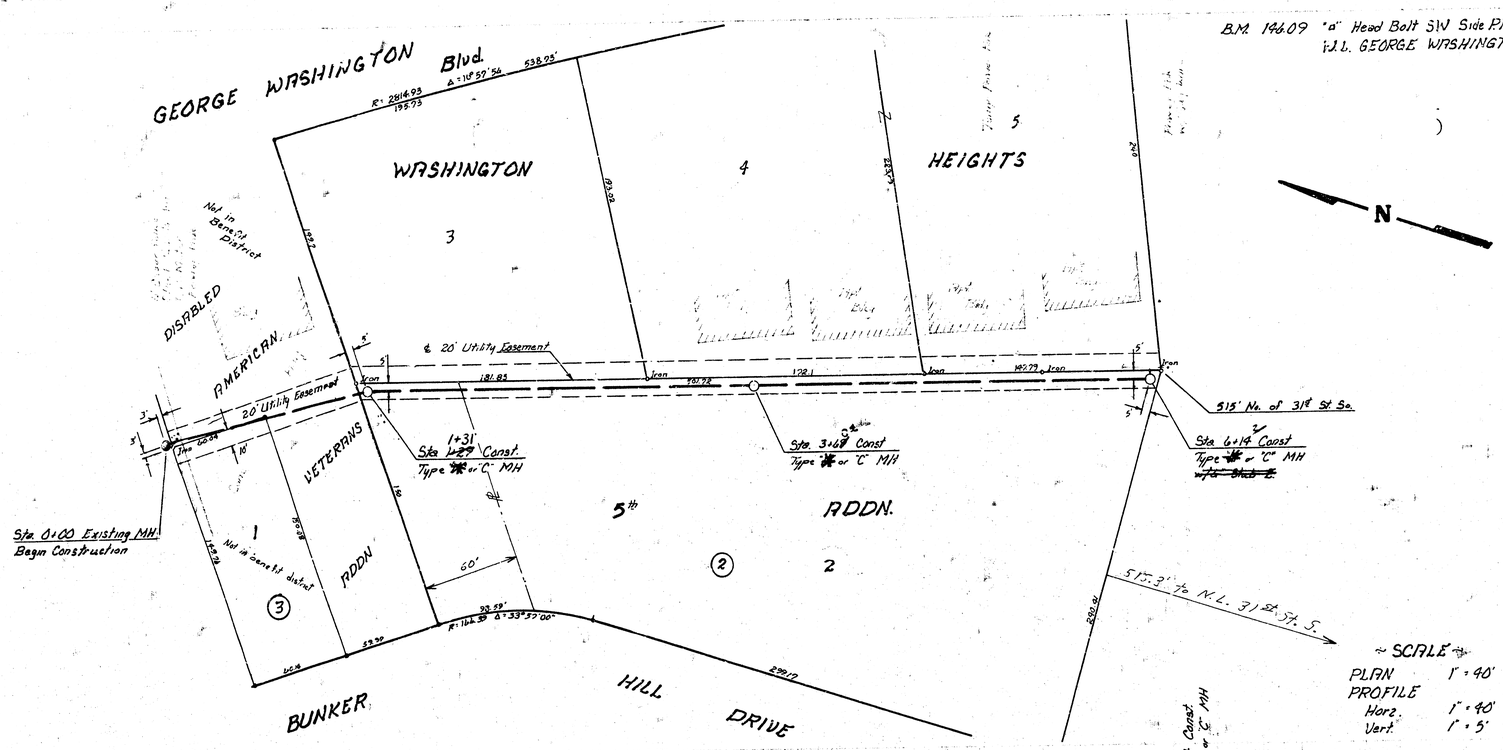

NOTE: WORK OPER ON THIS PROJECT WILL BE ISSUED AS SOON AS POSSIBLE AFTER AWARD OF CONTRACT SINCE DEVELOPER HAS BUILDINGS COMPLETED AND NEEDS THE PROPOSED SEWER FOR THESE BUILDINGS. CONTRACTOR I[illegible] ANTICIPATE BEGINNING WORK IMMEDIATELY AFTER CONTRACT HAS BEEN EXECUTED.

~ SCALE ~

PLAN	1" = 40'
PROFILE	
Horz.	1" = 40'
Vert.	1" = 5'

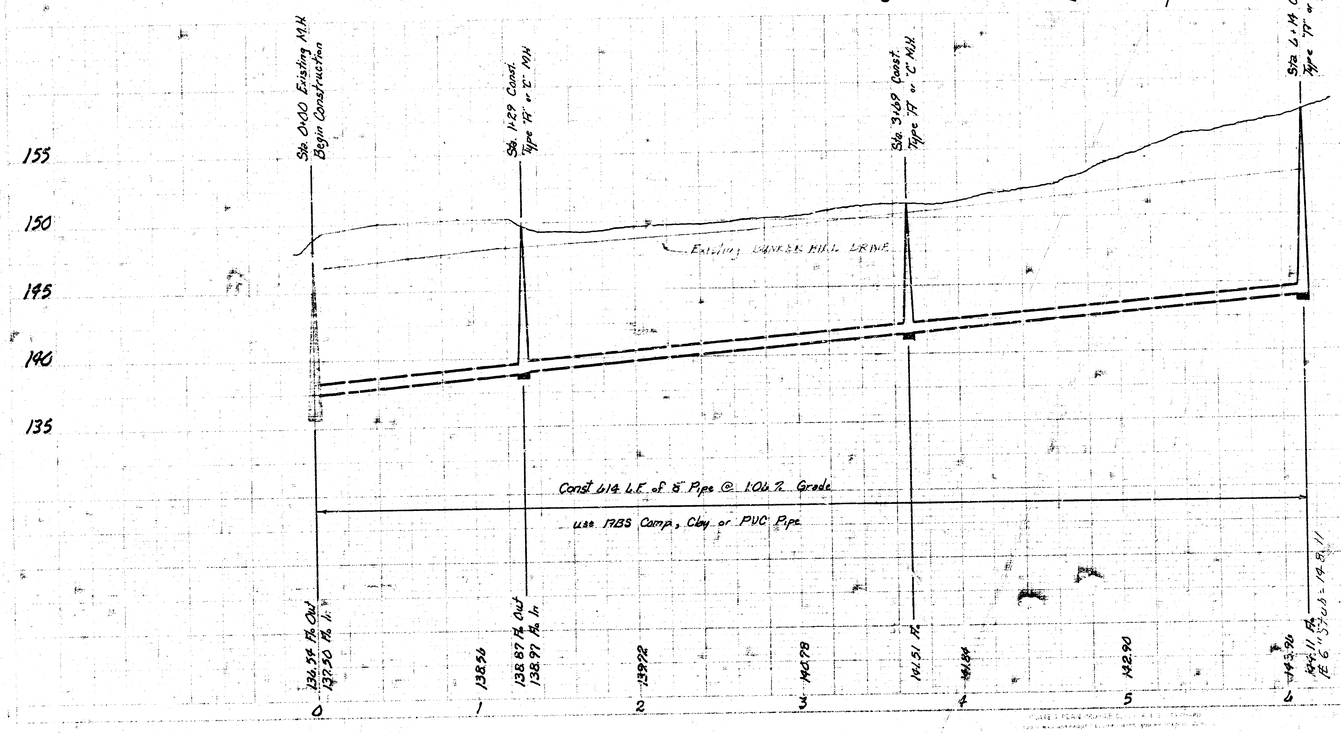

As Built
10/29/80 g.d.
E 293

DONALD E. SCHIEFELBEIN
LICENSED
6811
KANSAS
PROFESSIONAL ENGINEER

LATERAL 18, MAIN 10, WAR INDUSTRIES SEWER
Proj. No.: 468-76-245-80970-000-000-001
WICHITA, KANSAS

DEAN SELLERS ~ Acting CITY ENGINEER

DATE: _____