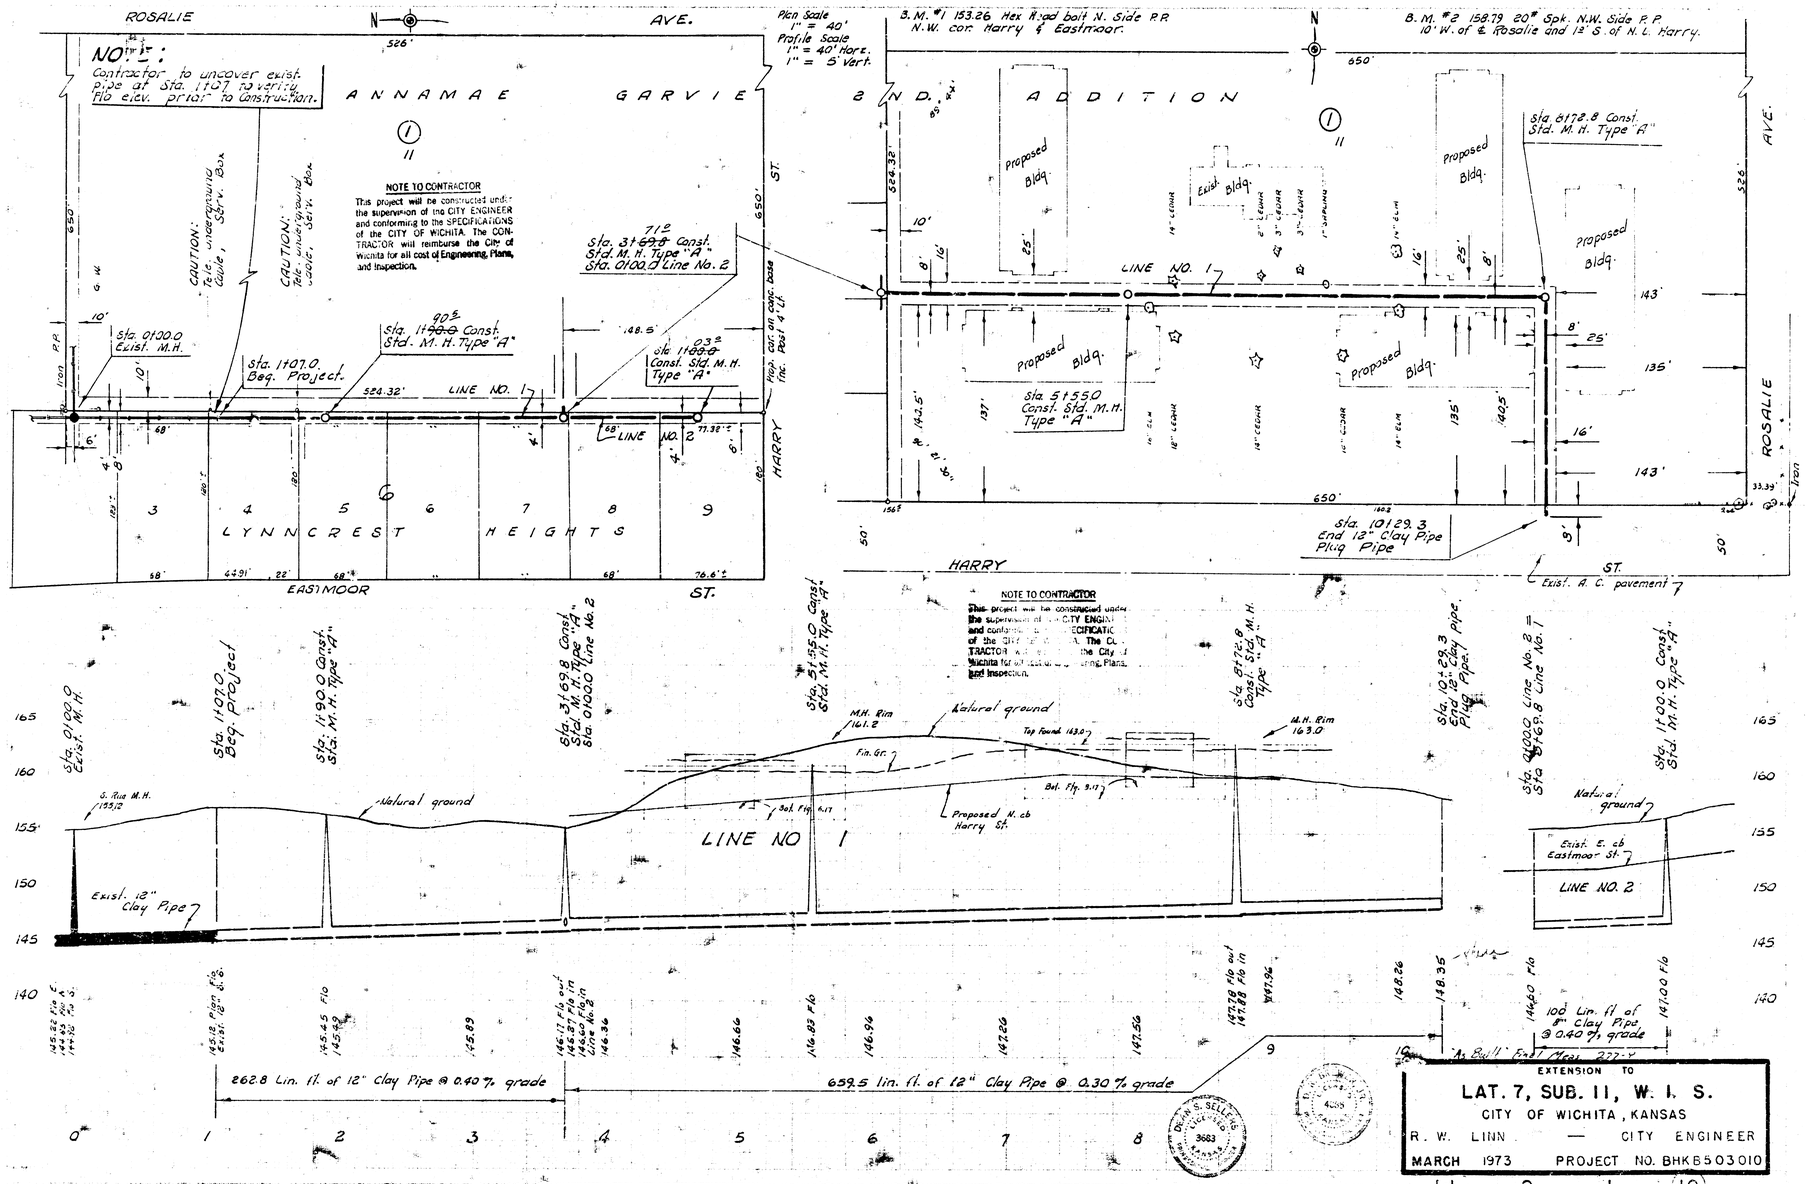
ROSALIE AVE.
NOTE:
Contractor to uncover exist. Pipe at Sta. 1+07 to verify flo elev. prior to construction.
ANNAMAE GARVIE ST.
NOTE TO CONTRACTOR
This project will be constructed under the supervision of the CITY ENGINEER and conforming to the SPECIFICATIONS of the CITY OF WICHITA. The CONTRACTOR will reimburse the City of Wichita for all cost of Engineering, Plans, and Inspection.
CAUTION: Tele. underground cable, Serv. Box
Sta. 0+00.0 Exist. M.H.
Sta. 1+07.0 Beg. Project.
Sta. 1+90.0 Const. Std. M.H. Type "A"
Sta. 3+69.8 Const. Std. M.H. Type "A" Sta. 0+00.0 Line No. 2
Sta. 1+23.2 Const. Std. M.H. Type "A"
LINE NO. 1
LINE NO. 2
524.32'
148.5'
HARRY ST.
LYNNCREST HEIGHTS
EASTMOOR ST.
Plan Scale 1" = 40'
Profile Scale 1" = 40' Horz. 1" = 5' Vert.
B.M. #1 153.26 Hex. head bolt N. Side P.P. N.W. cor. Harry & Eastmoor.
B.M. #2 158.79 20# Spk. N.W. Side P.P. 10' W. of ℄ Rosalie and 12' S. of N.L. Harry.
2ND. ADDITION
Proposed Bldg.
Exist. Bldg.
Sta. 5+55.0 Const. Std. M.H. Type "A"
Sta. 6+72.8 Const. Std. M.H. Type "A"
Sta. 10+29.3 End 12" Clay Pipe Pick Pipe
Exist. A.C. pavement
Natural ground
M.H. Rim 161.2
M.H. Rim 163.0
Top Found 163.0
Fin. Gr.
Bot. Flg. 5.17
Proposed N. cb Harry St.
Exist. 12" Clay Pipe
Exist. E. cb Eastmoor St.
100 Lin. ft. of 8" Clay Pipe @ 0.40% grade
262.8 Lin. ft. of 12" Clay Pipe @ 0.40% grade
659.5 lin. ft. of 12" Clay Pipe @ 0.30% grade
As Built Field Meas. 2-27-74
EXTENSION TO
LAT. 7, SUB. II, W. I. S.
CITY OF WICHITA, KANSAS
R. W. LINN — CITY ENGINEER
MARCH 1973 PROJECT NO. BHK 8503010
BRIAN S. SELLERS 3663 KANSAS
14 2 1 10