

Survey by C.L.G.
Plan by U.R.W.
S.K. No. 616 37

B.M. #1 171.63 "N" in Mueller on Fire Hydrant
NE Cor. Intersection of Killarney Place
and Lawrence Ln. (Est. by J. H.)
B.M. #2 169.75 "N" S. Rim M.H. 122.0' east of
E.L. Lawrence Ln. 4' 8" South of N.L.
Killarney Place.

G. W. Mc CLELLAN
2ND. ADDITION



Plan Scale 1" = 40'
Profile Scale 1" = 40' Horiz.
1" = 4' Vert.

NOTE:
Benefit district
includes all lots
in block 1.

CAUTION:
Underground
Utilities east
of Lot line.

Sta. 0+00.0 Const.
Std. M. H. Type "A"

NOTE:
Contractor is to excavate
at Sta. 0+00.0 prior to
construction so field Eng.
can verify Pipe Ho Elev.

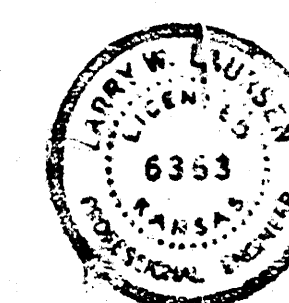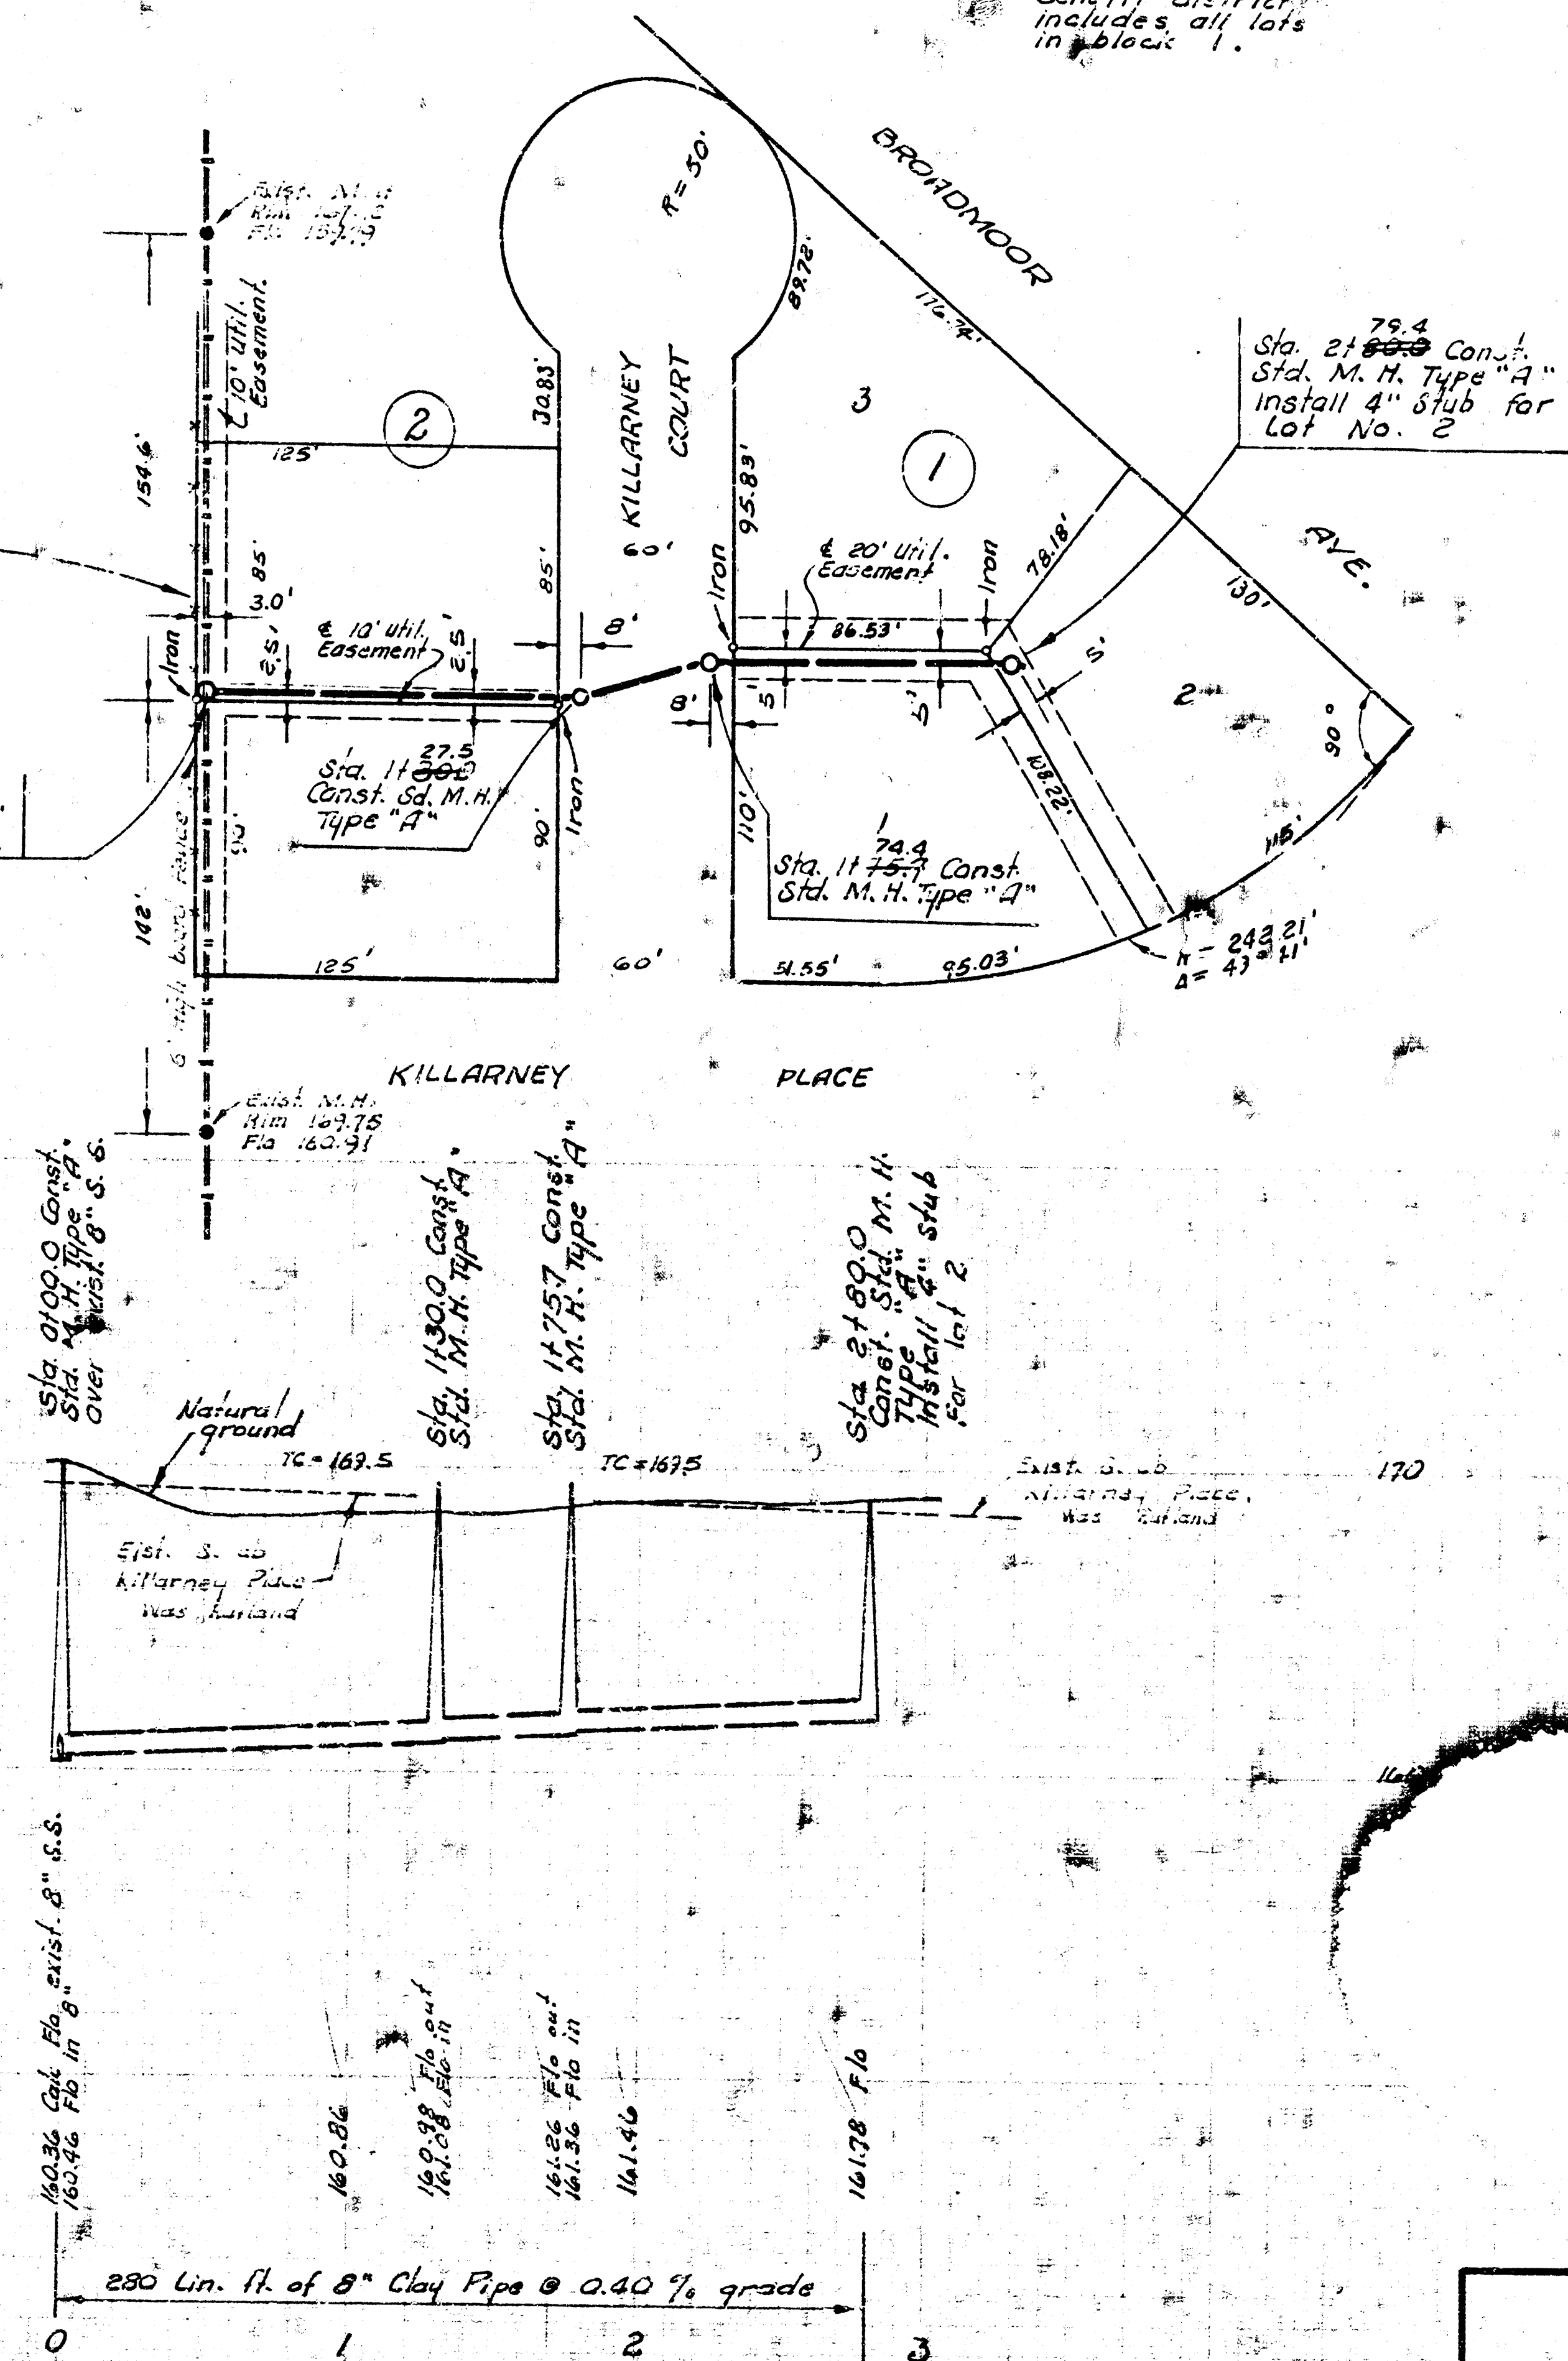

LAT. 20, MAIN 12, W. I. S.
CITY OF WICHITA, KANSAS
R. W. LINN — CITY ENGINEER
MAY 1974 PROJECT NO. DBKLS74009

FINAL MEASUREMENTS
FROM 7-27