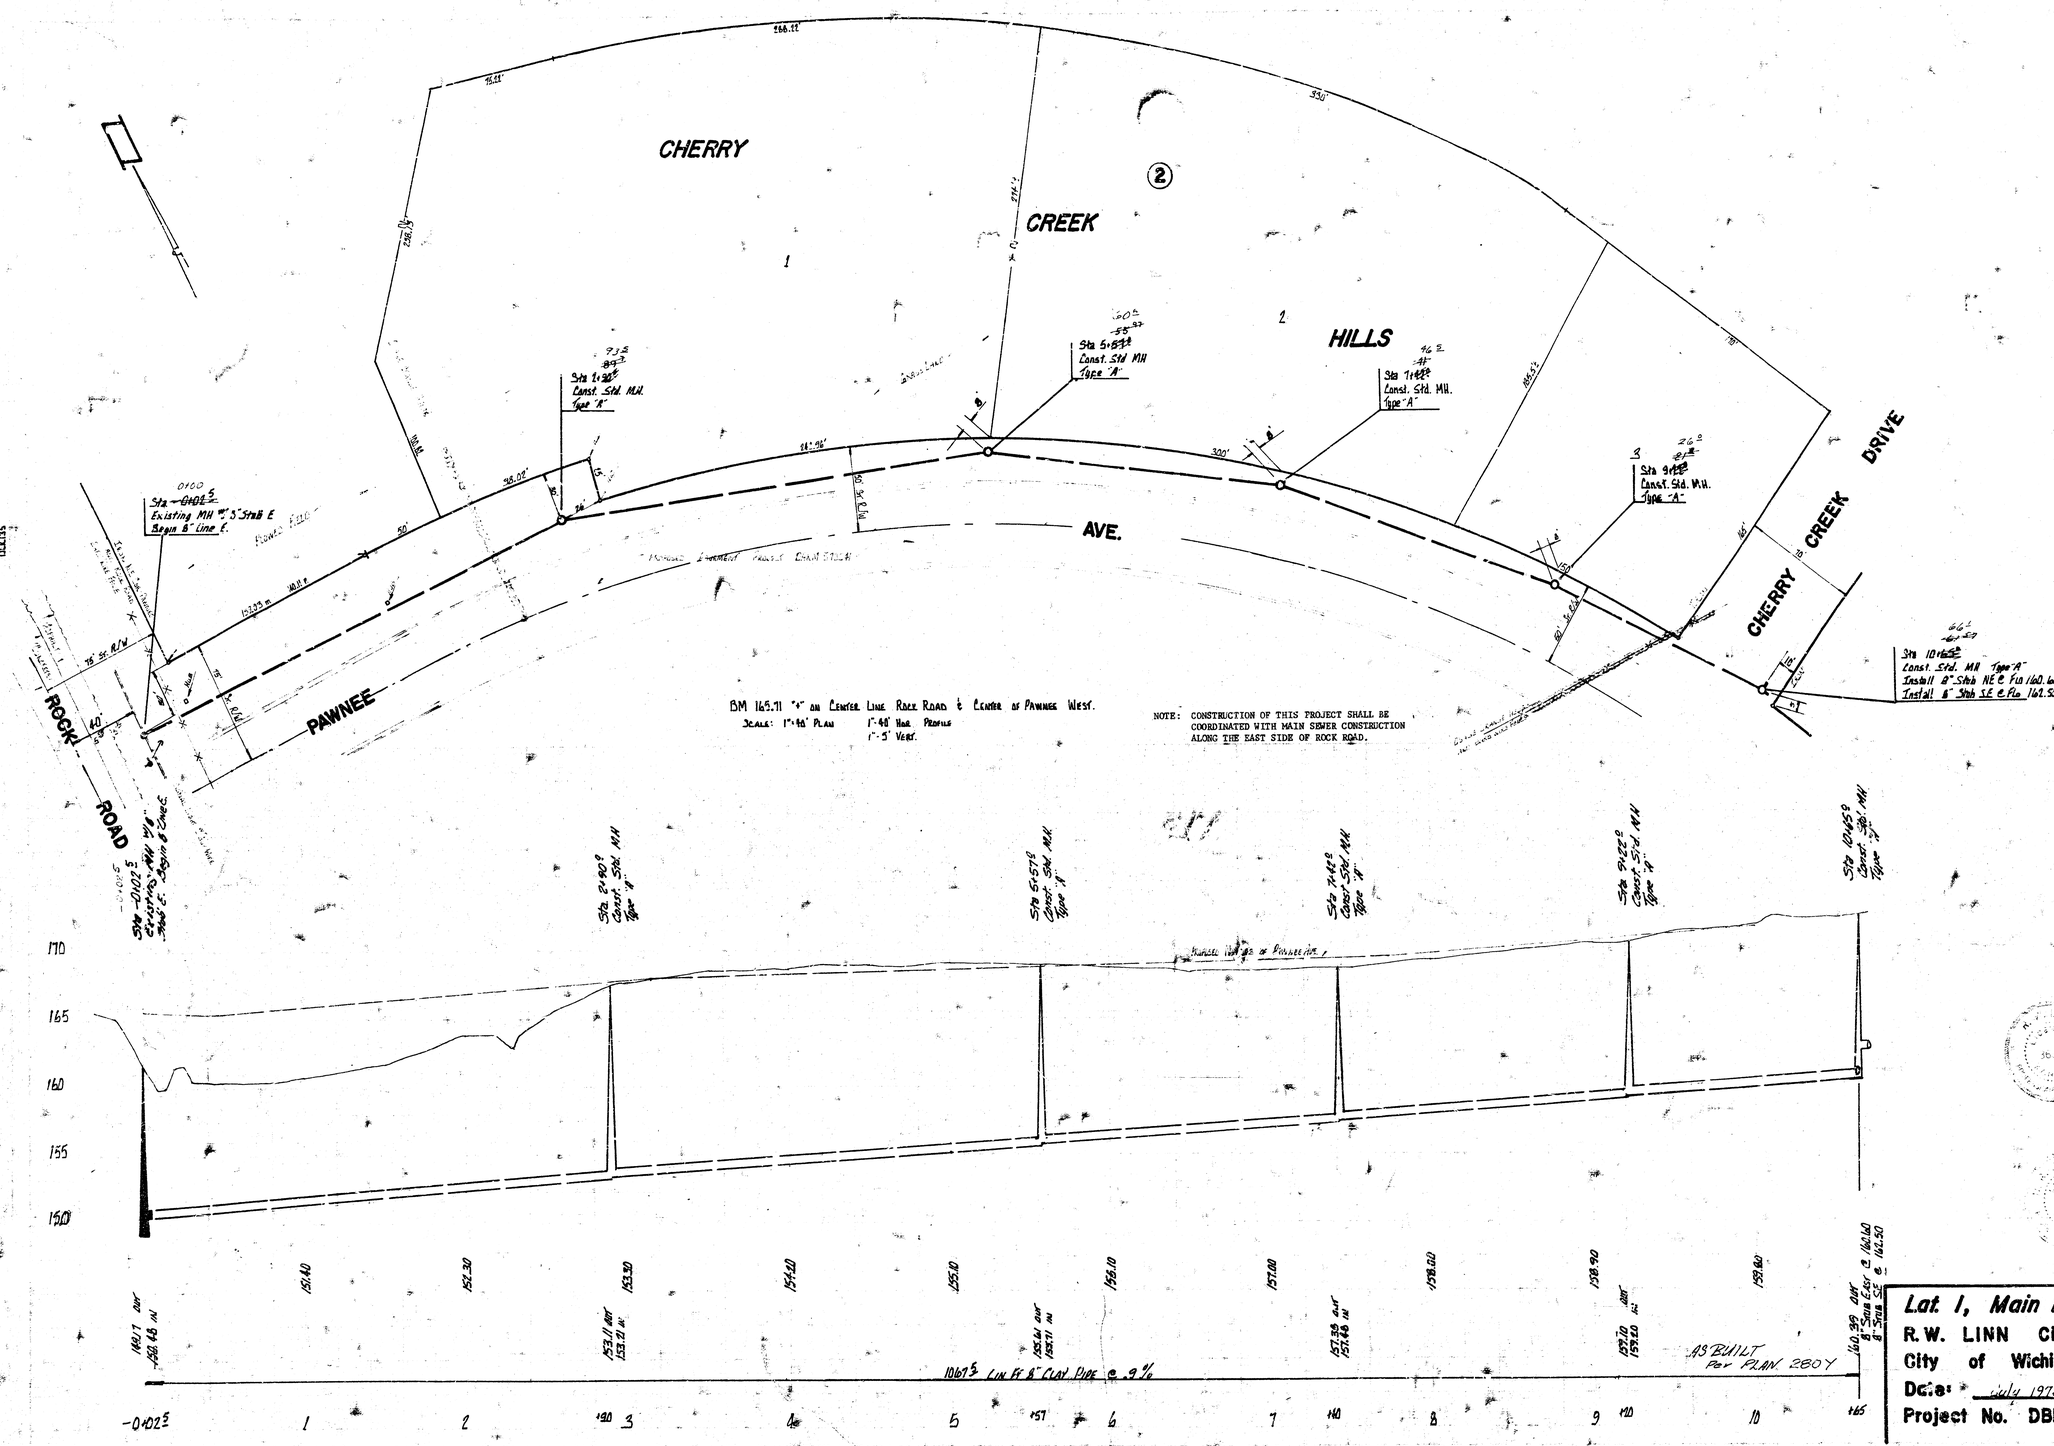

Lat. 1, Main 17, W.I.S.
R.W. LINN City Engineer
City of Wichita, Kansas
Date: July 1973
Project No. DBKL-573012

1/1