


B.M. 176.06 E. Rim manhole @ S.E. cor. 1st & Blk. B Cherry Creek Hills.
 B.M. 172.42 on North Rim manhole 109.2' East, E.L. Lori Lane & 80' North of S.E. Cherry Creek Drive.

Sta. 2100.0 Const. Std. M.H. Type "A" over exist. 8" Clay Pipe.

Plan Scale 1" = 40'
 Profile Scale 1" = 5' Vert.

Sta. 2100.0 Const. Std. M.H. Type "A" over exist. 8" Clay Pipe

Sta. 2145.0 Const. Std. M.H. Type "A"

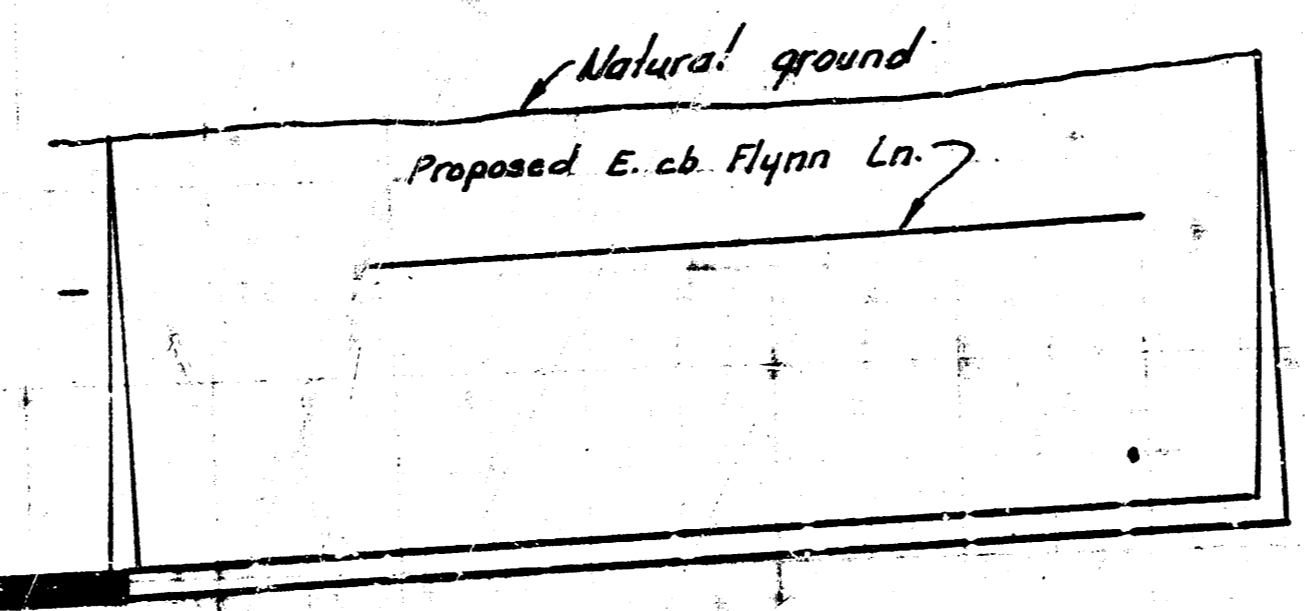

245 lin. ft. of 8" Clay Pipe @ 0.40 % grade



2 "20 EQUIT" FINAL MEAS. G-1
LAT. 9, MAIN 17, W. I. S.
 CITY OF WICHITA, KANSAS
 R. W. LINN — CITY ENGINEER
 APRIL 1974 PROJECT NO. DB K1573020