

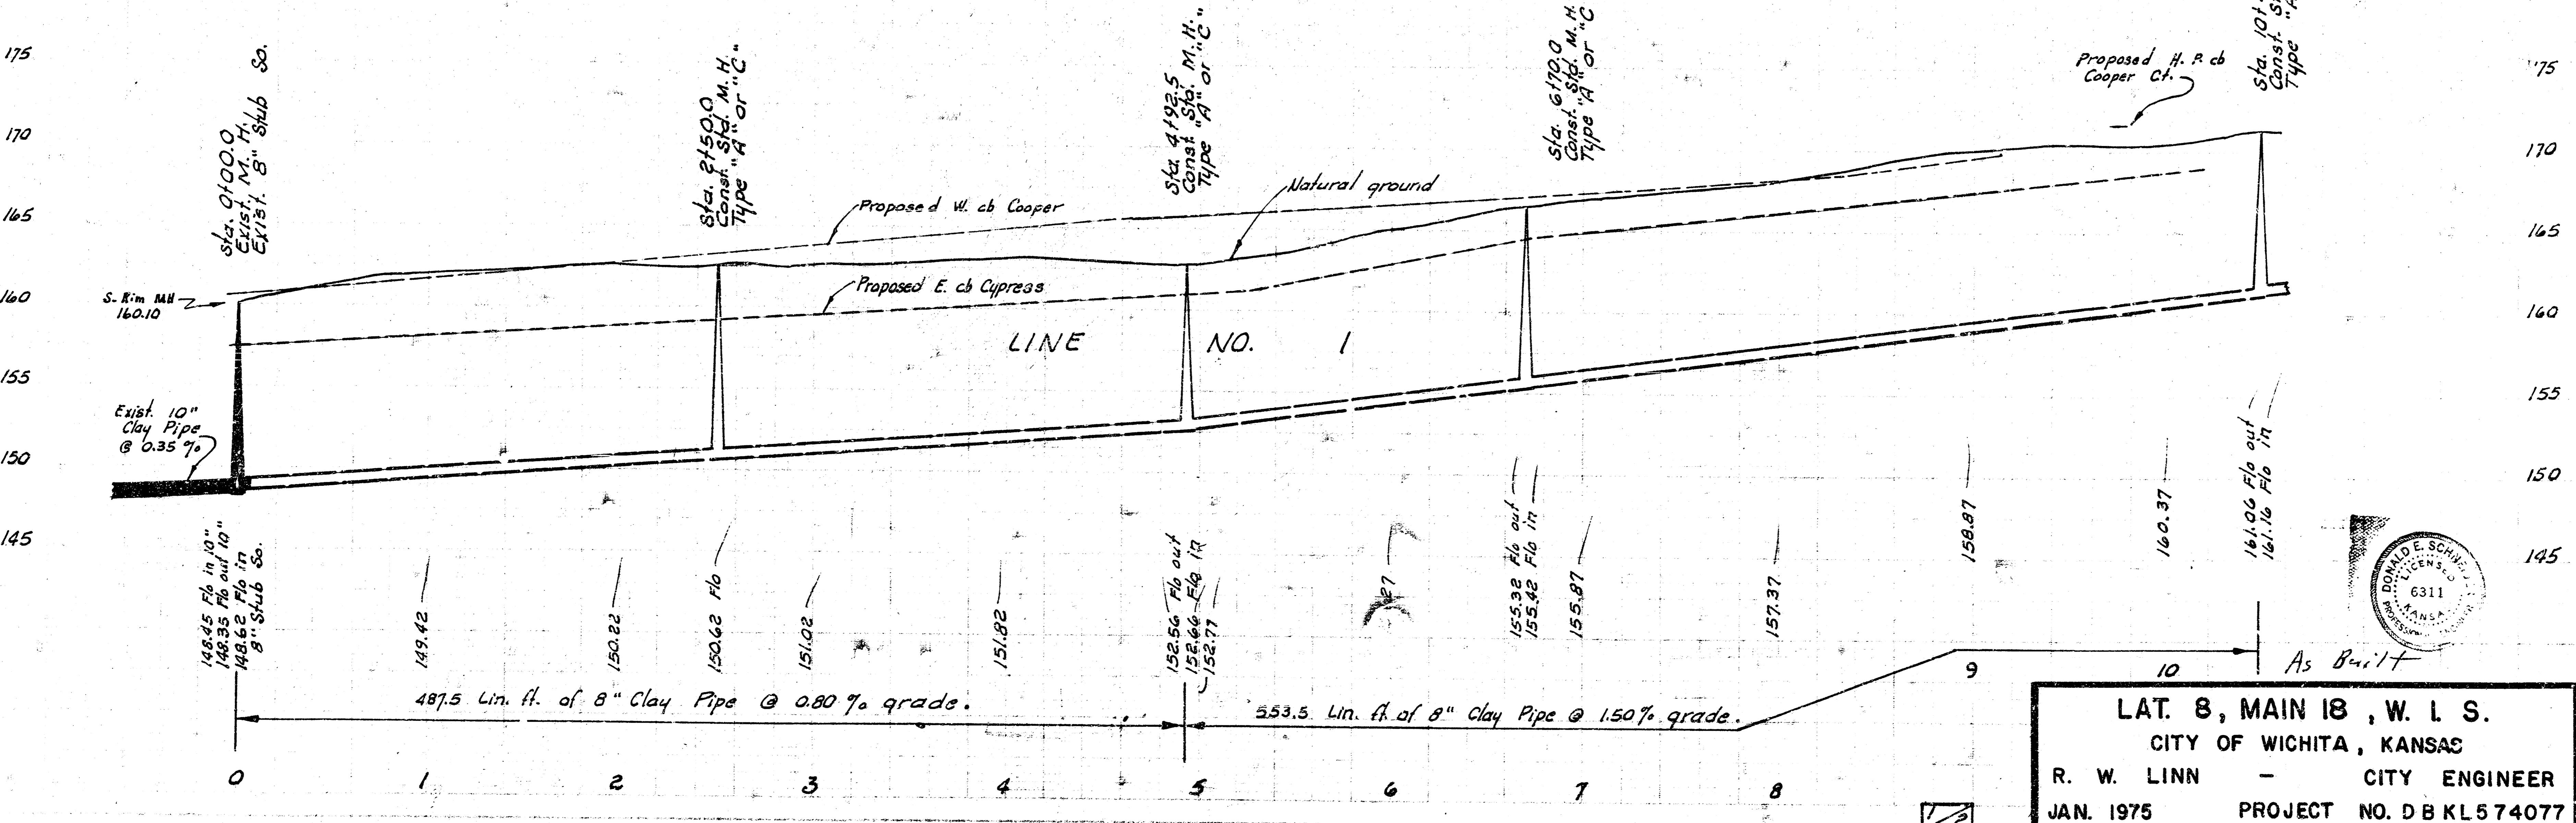
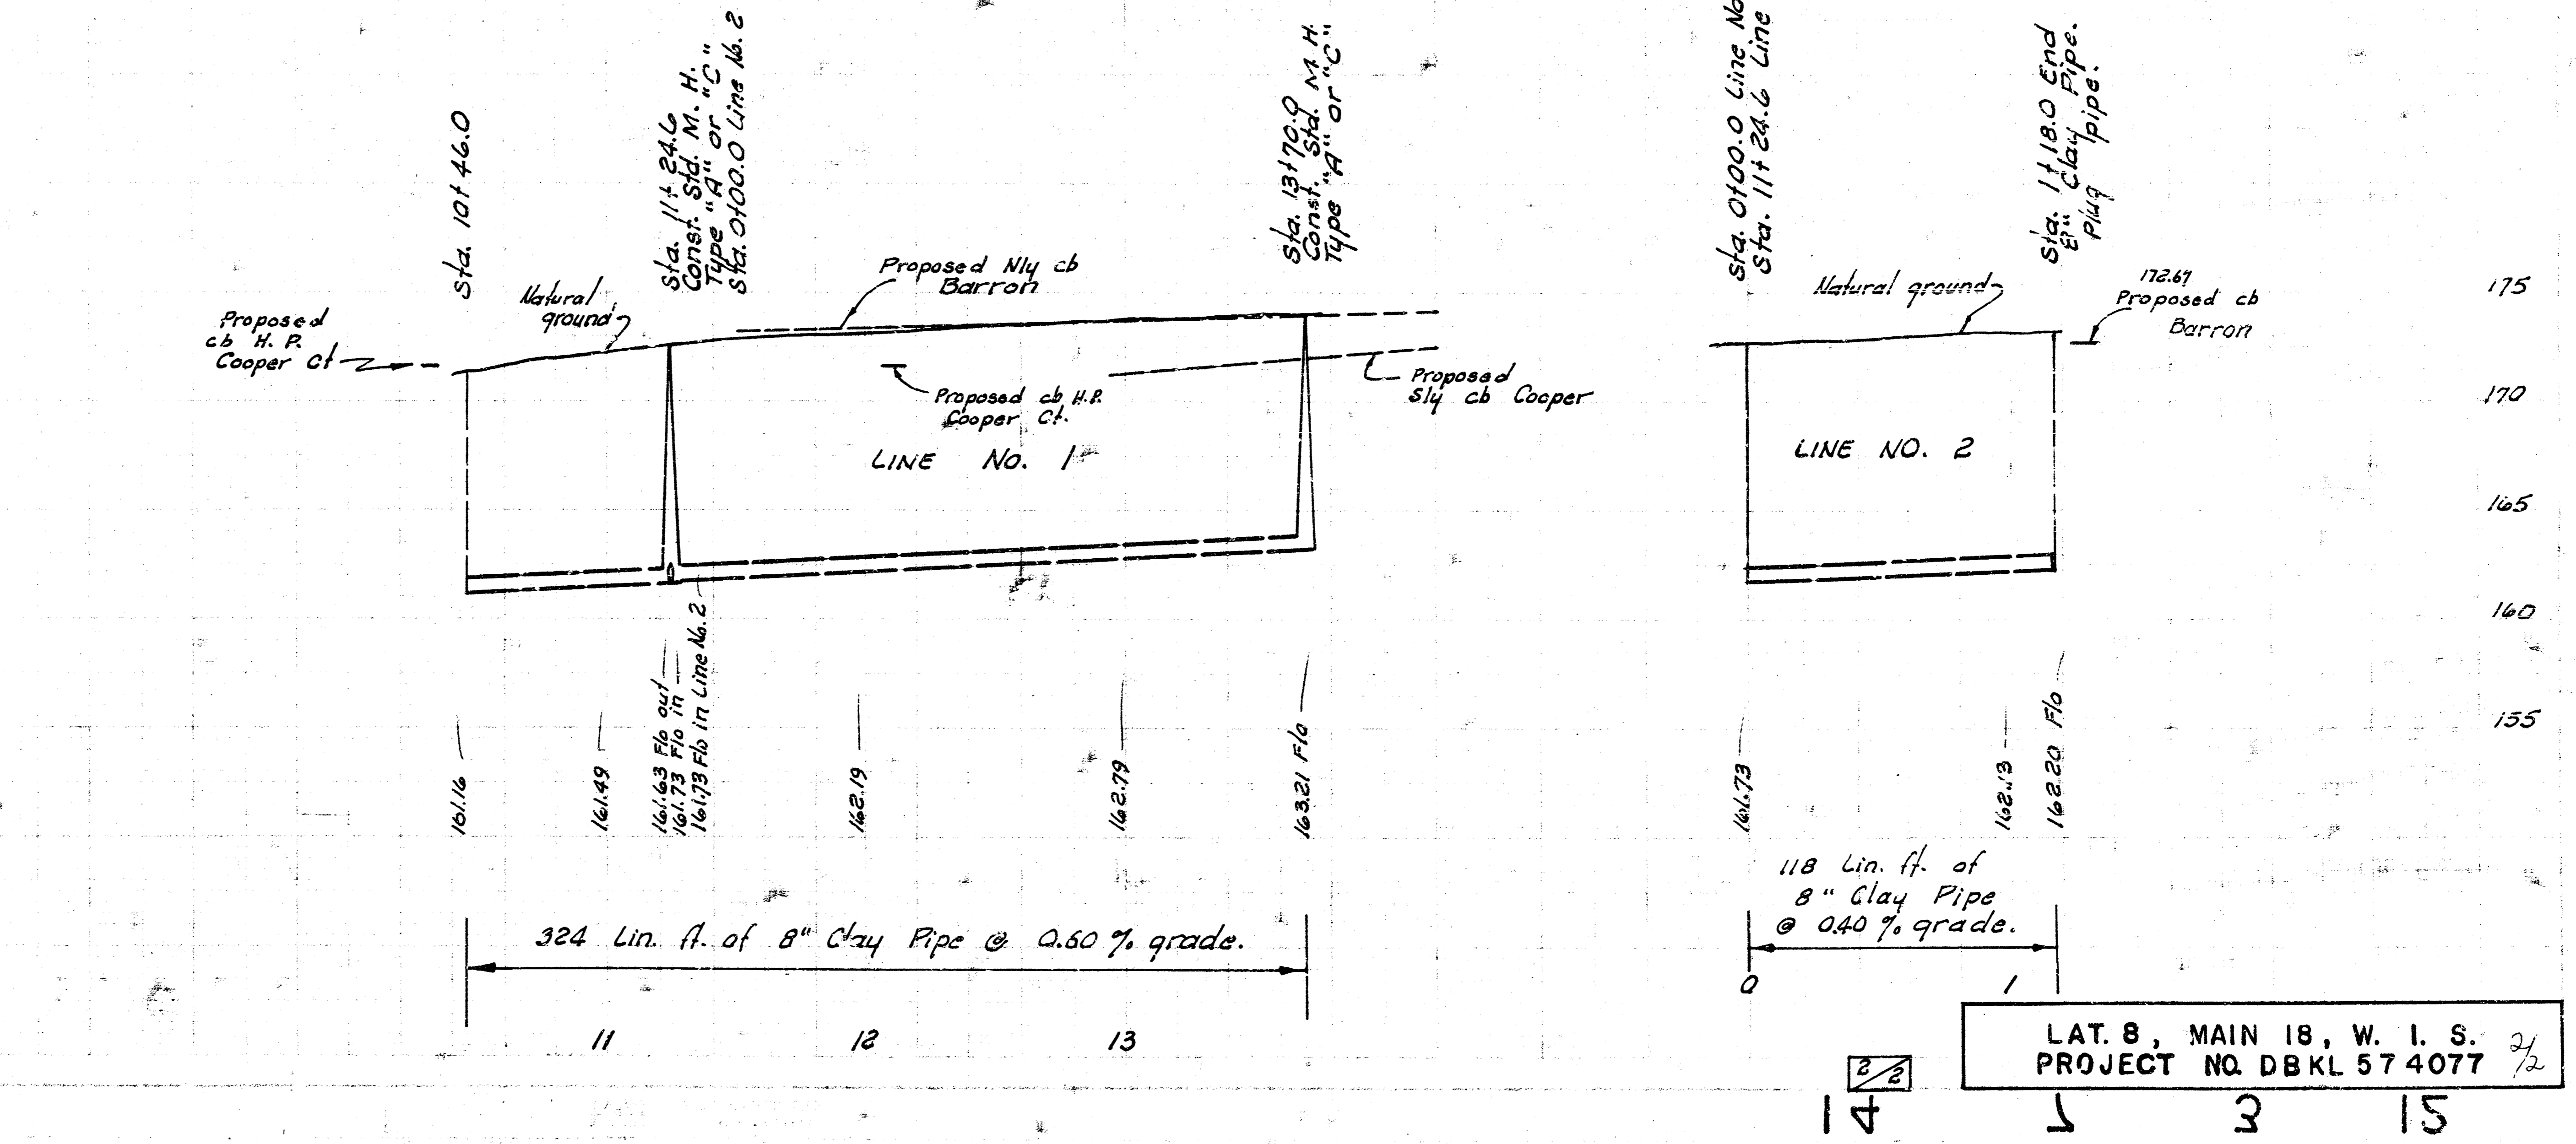


Plan Scale 1" = 40' Horiz.
Profile Scale 1" = 40' Horiz.
1" = 5' Vert.

B. M. #1 176.15 Iron in thimble @ 1/4 Sec.
Cor. Lincoln St. & Webb Rd.
B. M. #2 162.46 R.R. Spike 60. fc. R.P.
with 2 Guy Wires N. & Lincoln
approx. 1000' W. of W. L. Webb Rd.

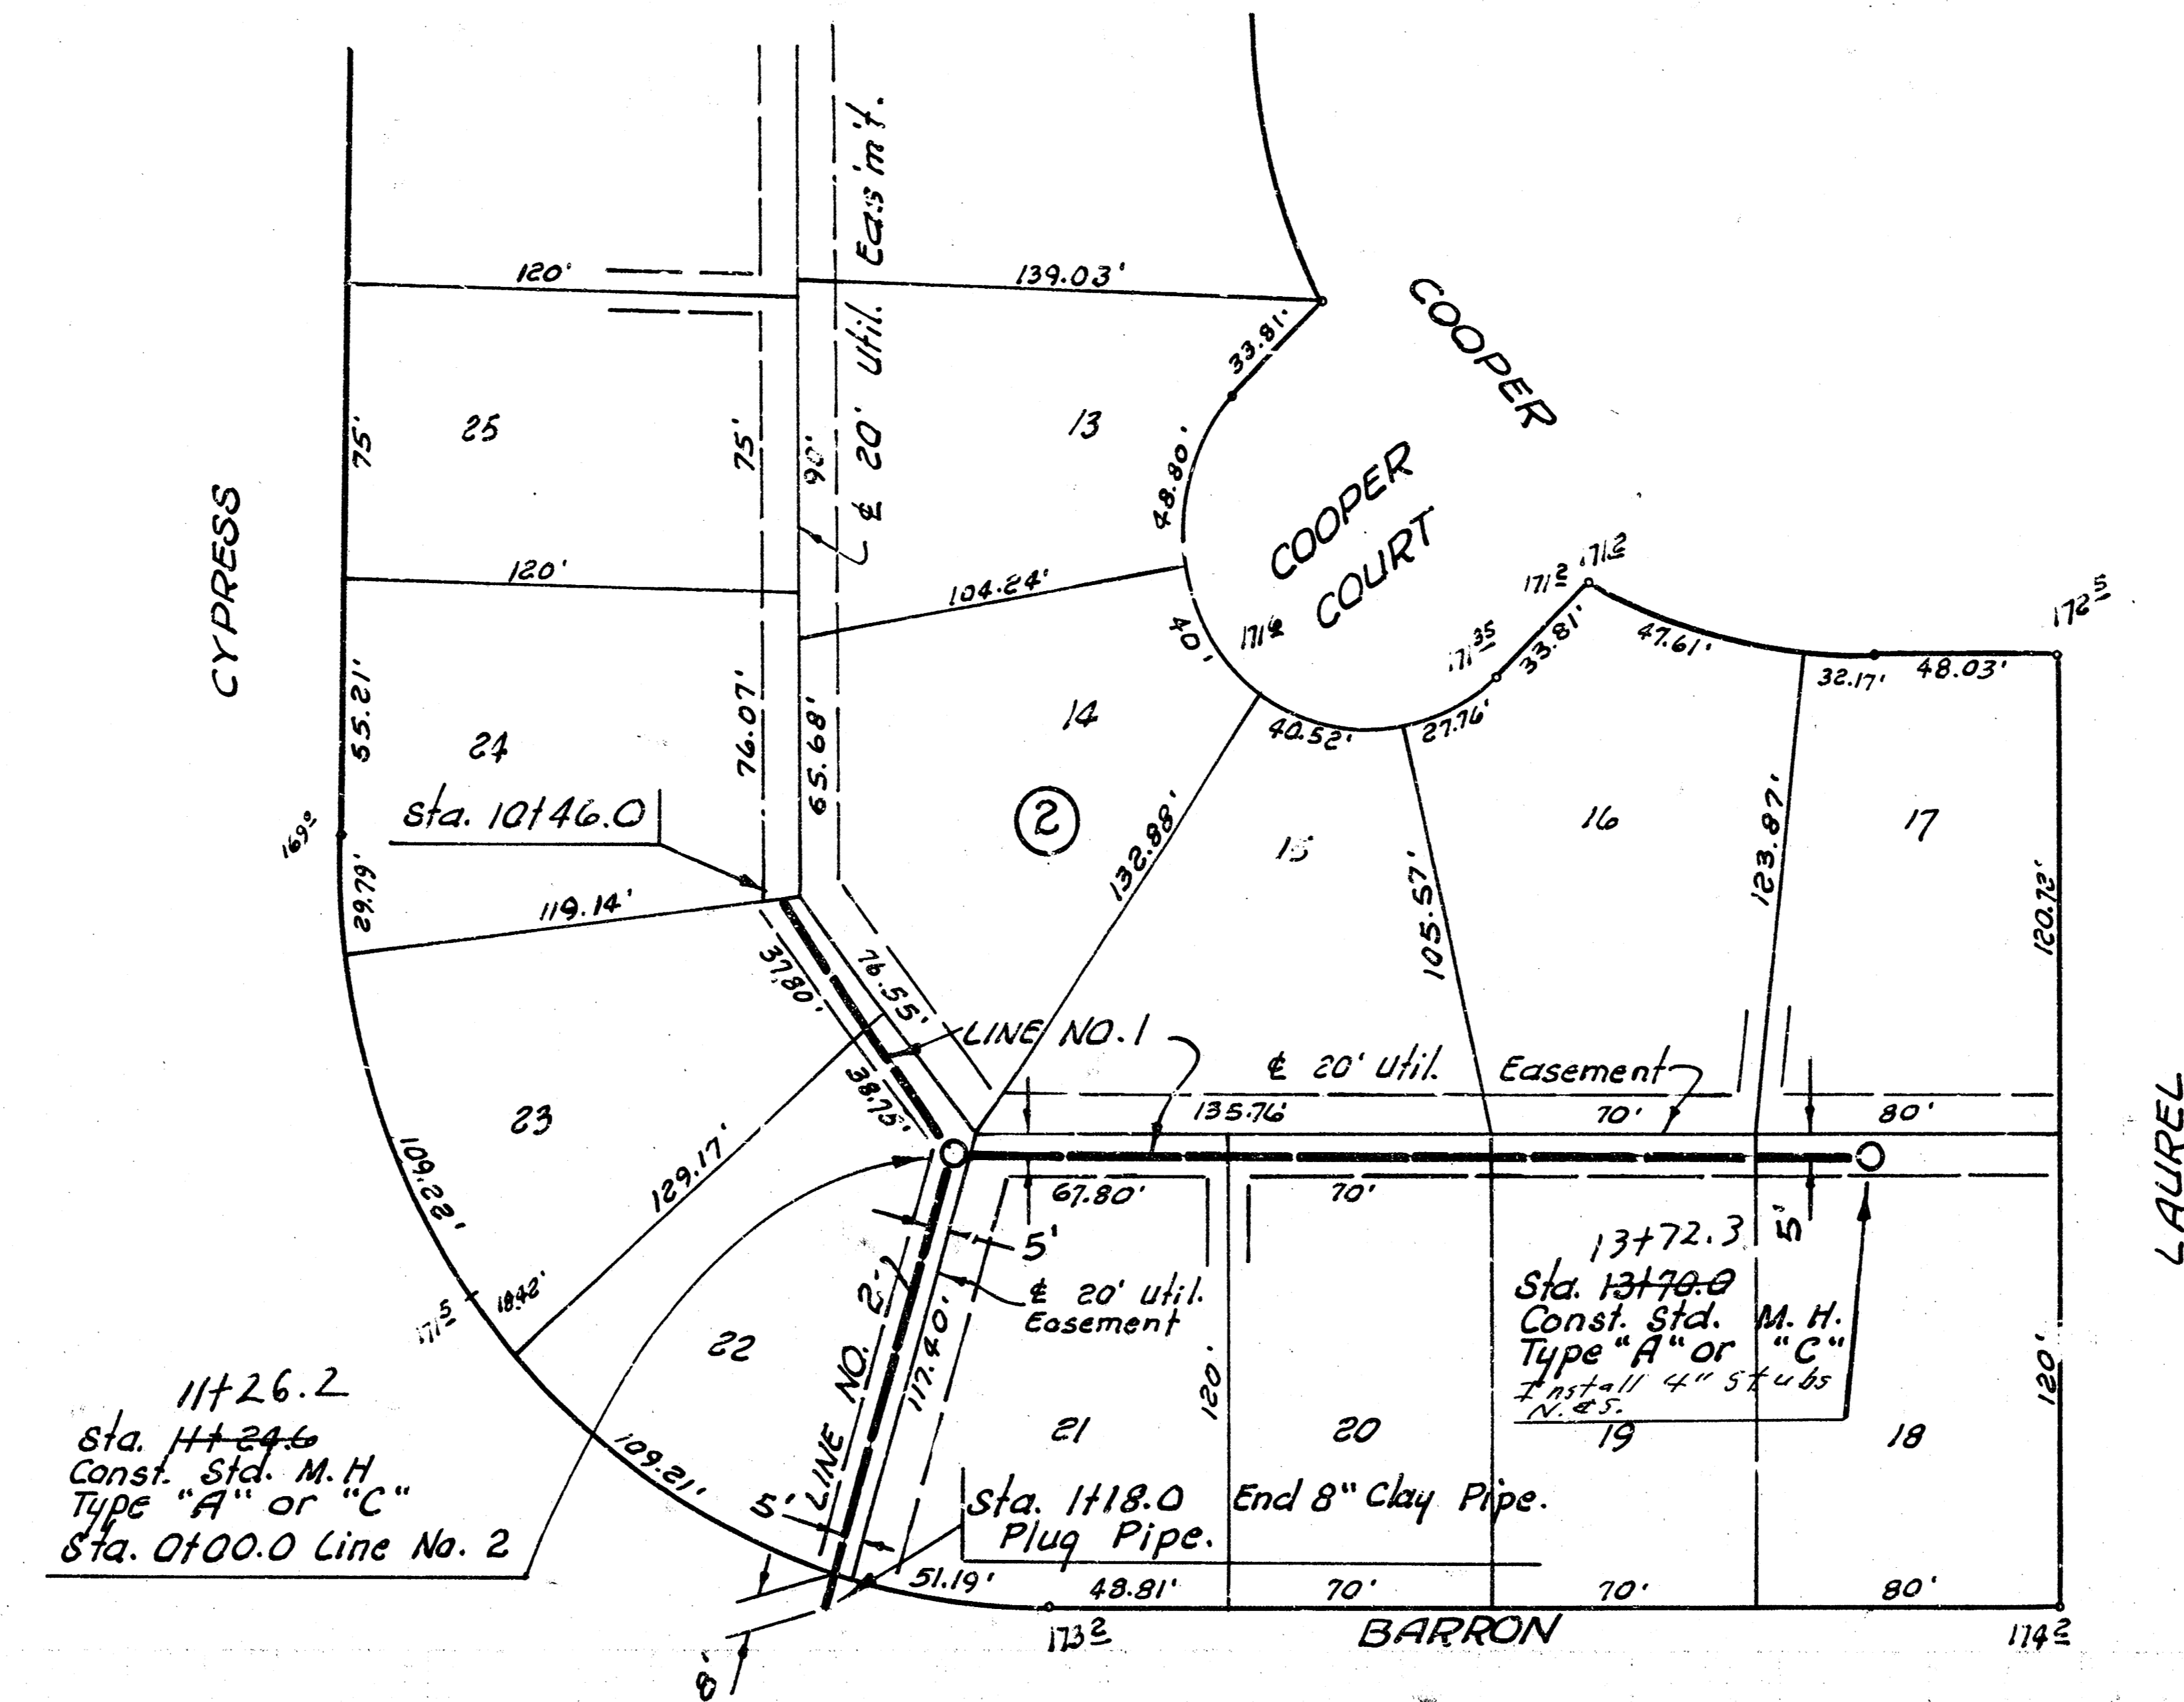

LAT. 8, MAIN 18, W. L. S.
CITY OF WICHITA, KANSAS
R. W. LINN - CITY ENGINEER
JAN. 1975 PROJECT NO. DB KL 574077

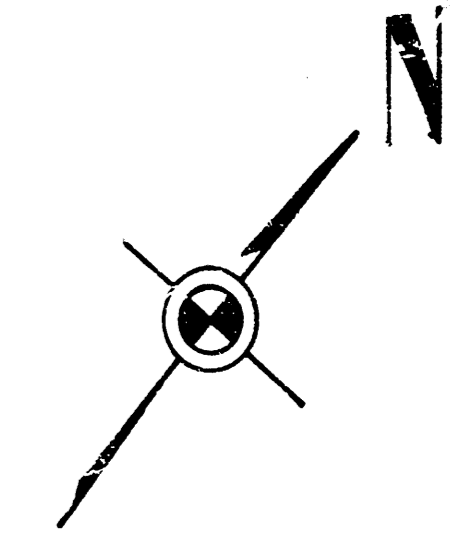

LAT. 8, MAIN 18, W. I. S. PROJECT NO. DBKL 574077 3/2

14 1 3 15