

# LATERAL 10, MAIN 20, W.I.S.


PROJECT NO.

468-76-245-80552-000-000-001


CITY OF WICHITA, KANSAS

R.W. LINN CITY ENGINEER

JULY, 1978

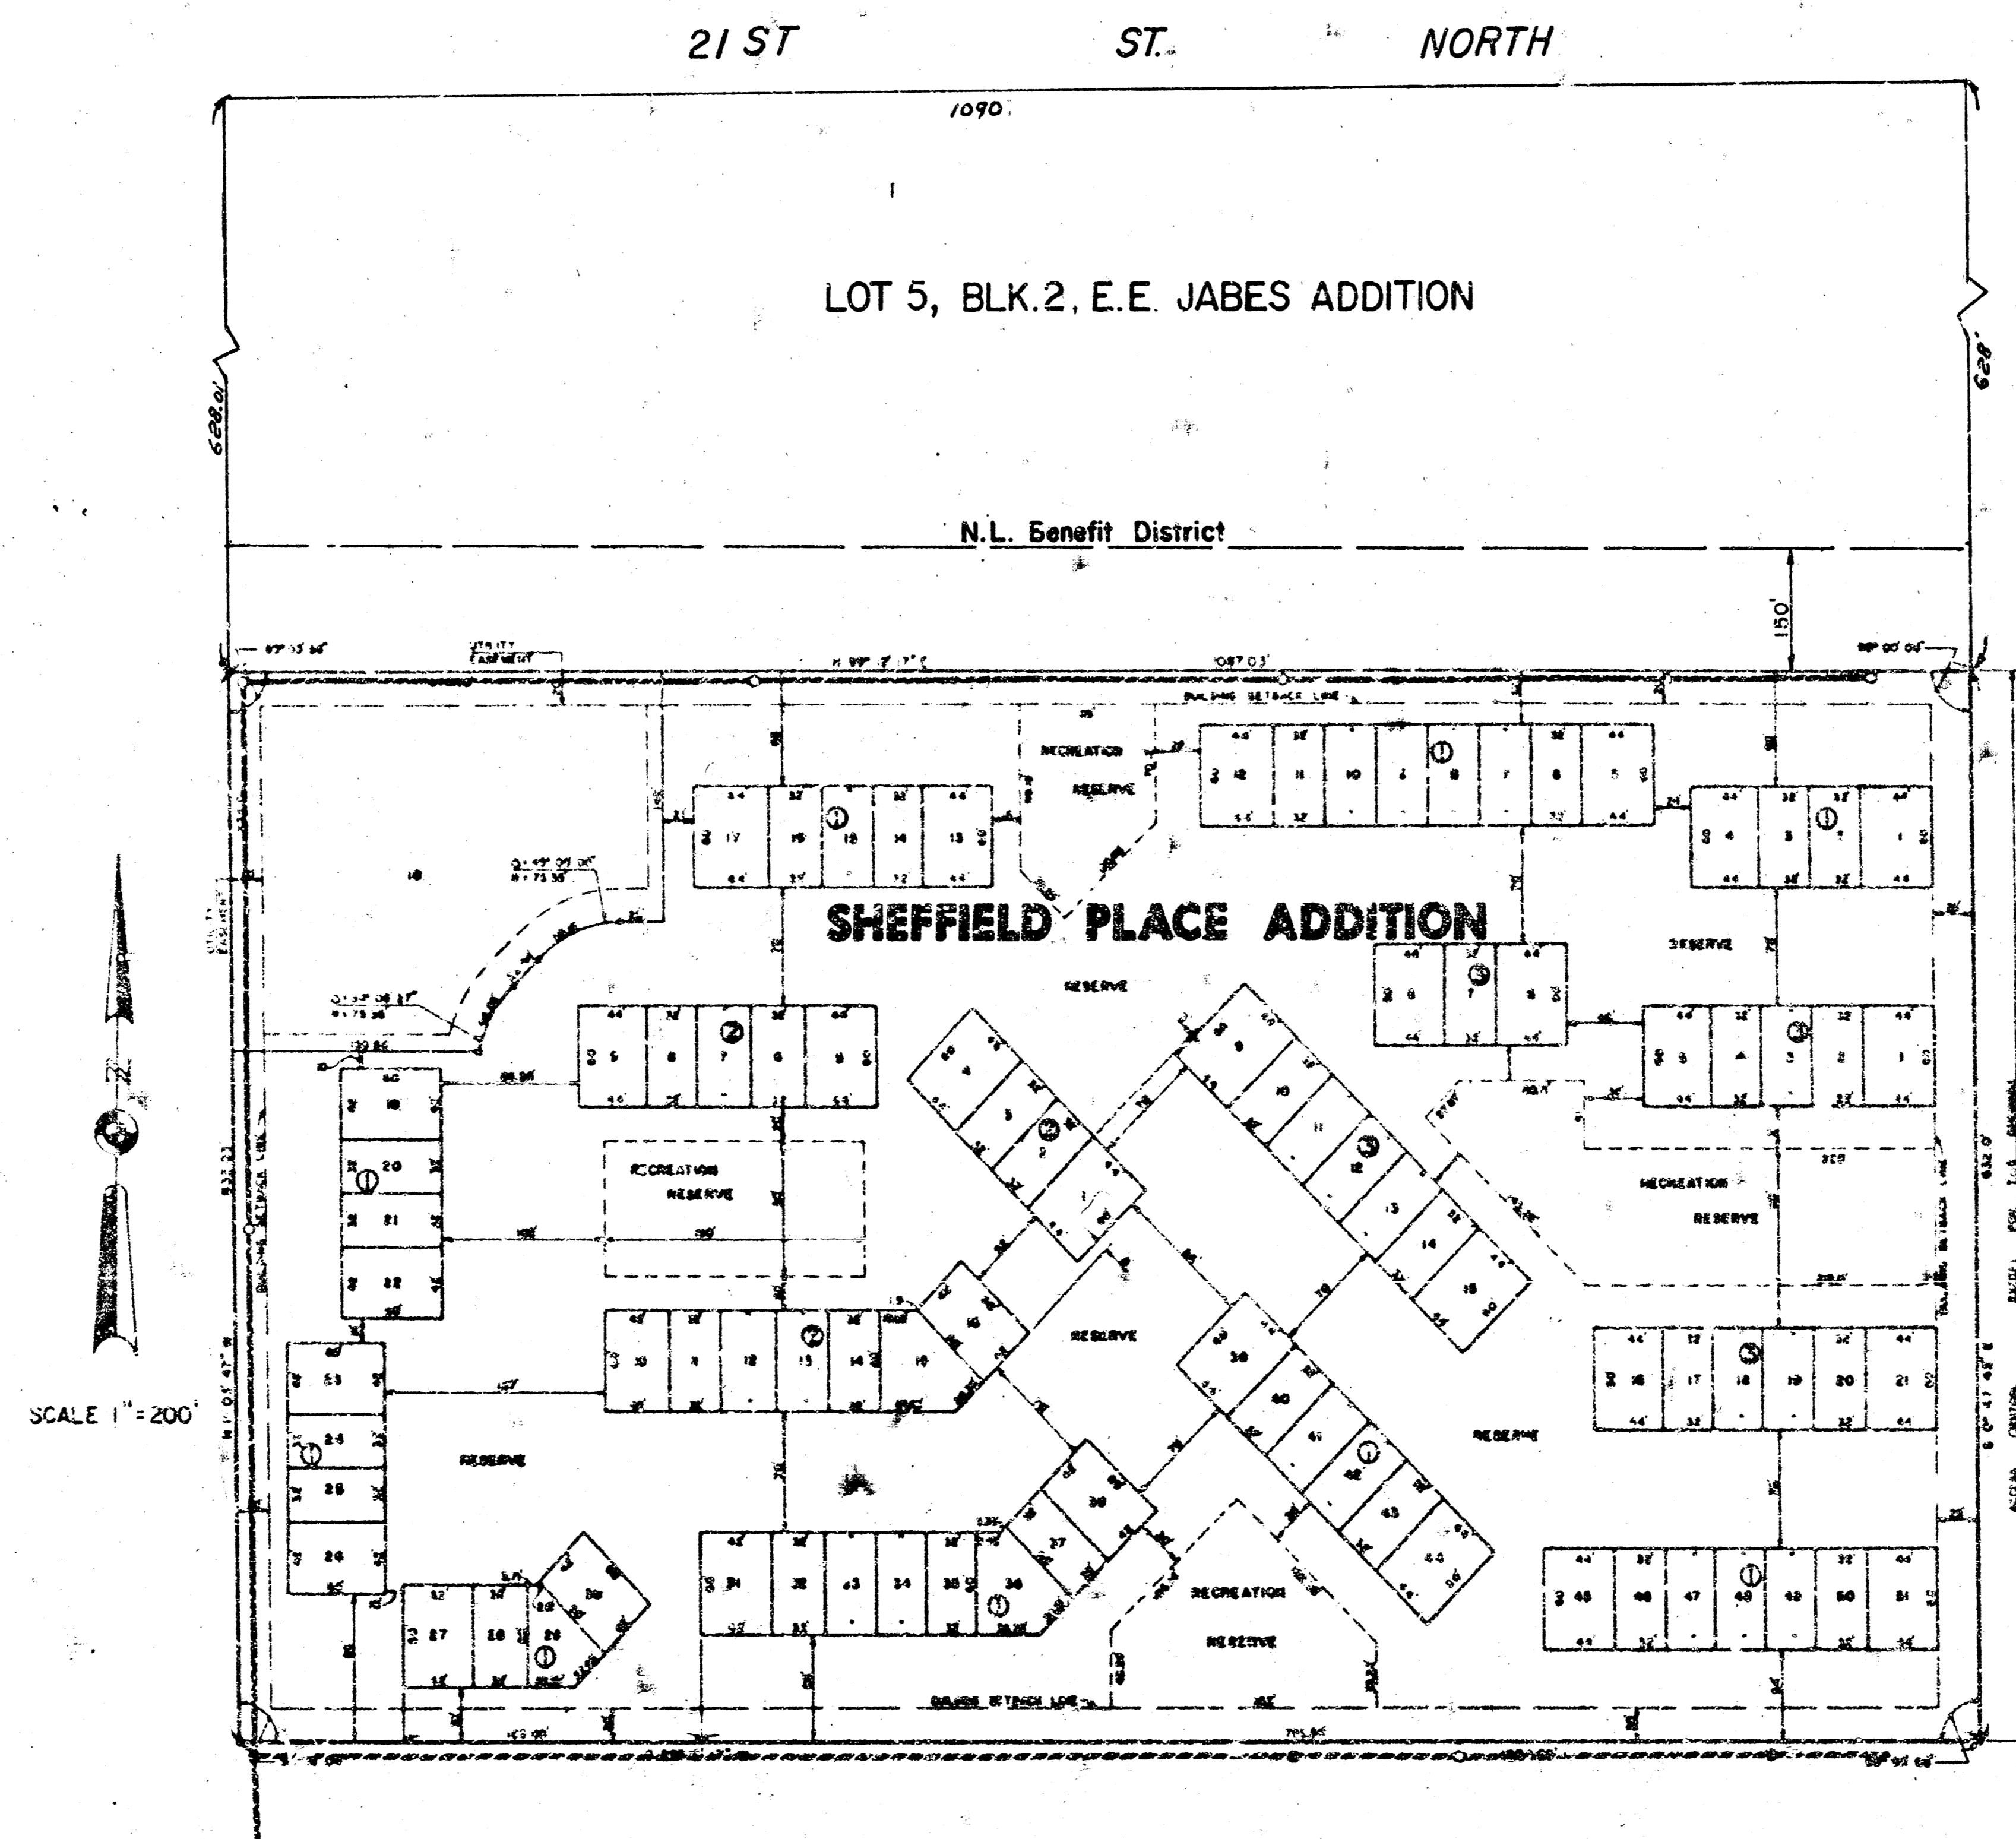

BENEFIT DISTRICT DESCRIPTION - LOTS 1 THROUGH 26 INCLUSIVE, BLOCK 1, SHEFFIELD PLACE ADDITION AND THE SOUTH 150 FEET OF LOT 5, BLOCK 2, E. E. JABES ADDITION.

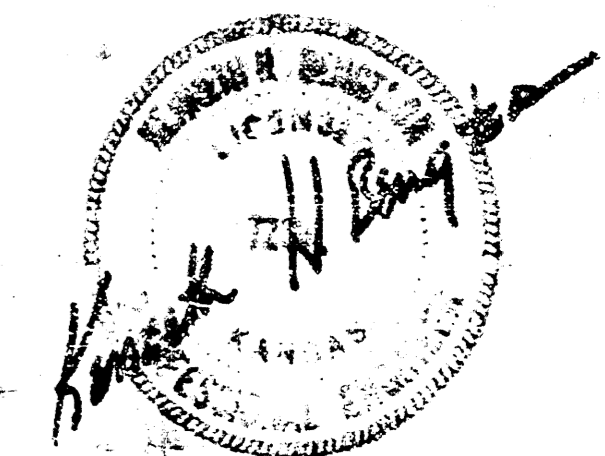


DO Buhly  
24 94  
D 41

Sta. 0+00 Line #1  
Connect to 8" Stub From  
Exist. Manhole

Sta. 3+00 Line #1  
Const. Std. Type "A" or "C"  
Manhole

SCALE: 1" = 50' Horiz.  
1" = 5' Vert.

Sta. 6+32.03 Line #1  
Const. Std. Type "A" or "C"  
Manhole With 8" Stub to N

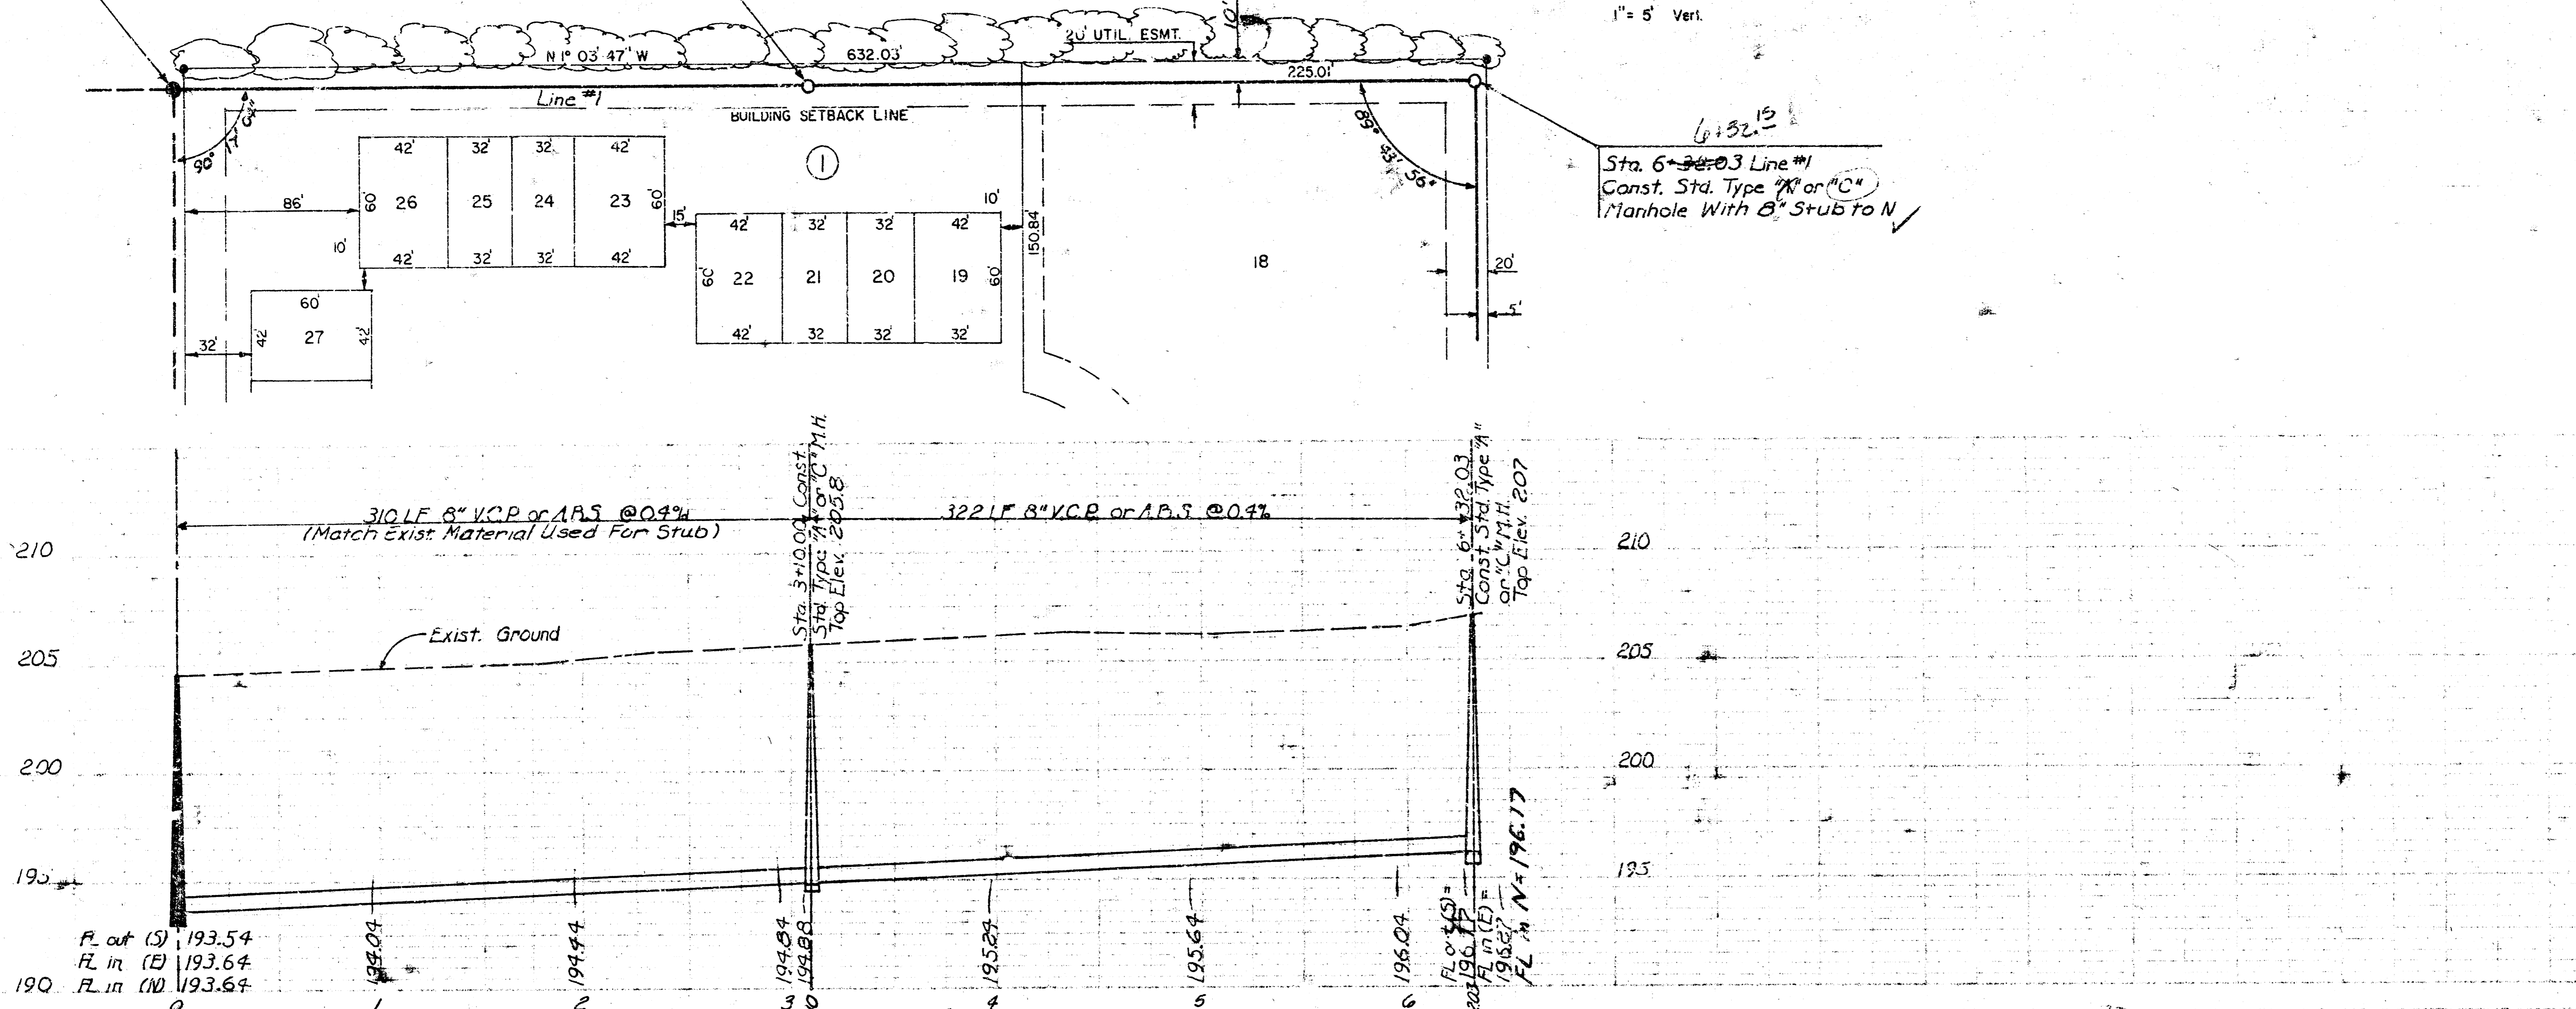



Sta. 6+32.03 Line #1  
Const. Std. Type "A" or "C"  
Manhole With 8" Stub to N

Sta. 9+50.00 Line #1  
Const. Std. Type "A" or "C"  
Manhole

Sta. 11+80.00 Line #1  
Const. Std. Type "A" or "C"  
Manhole

Sta. 14+10.00 Line #1  
Const. Std. Type "A" or "C"  
Manhole

Sta. 16+50.00 Line #1  
Const. Std. Type "A" or "C"  
Manhole With 4" Stub to SEEN.

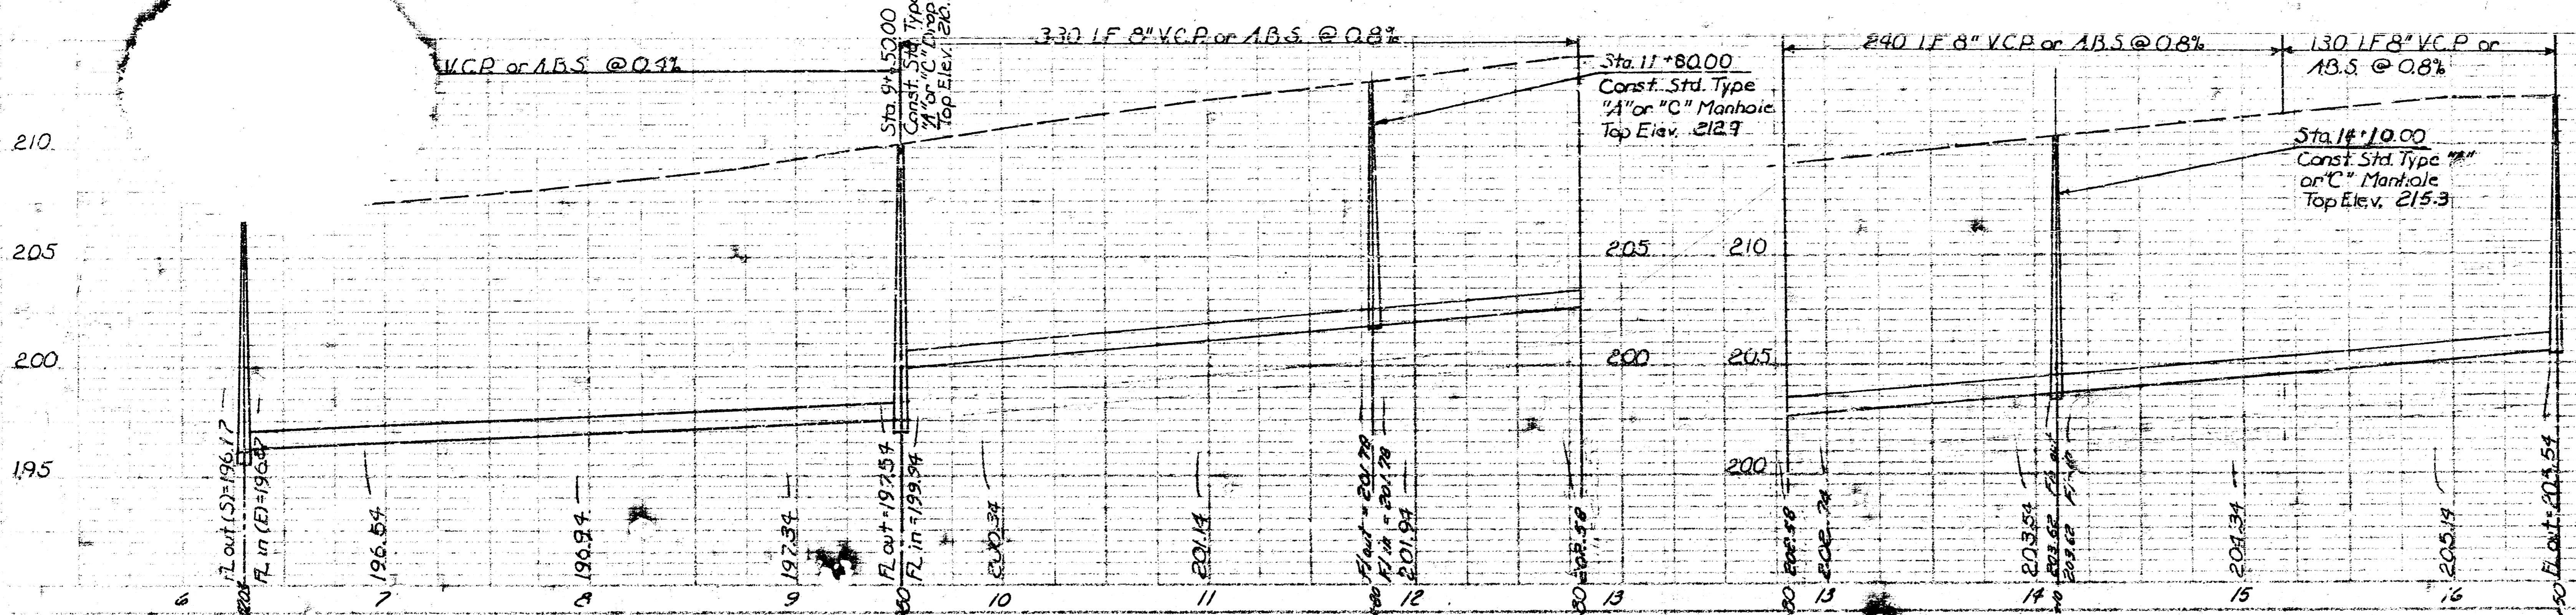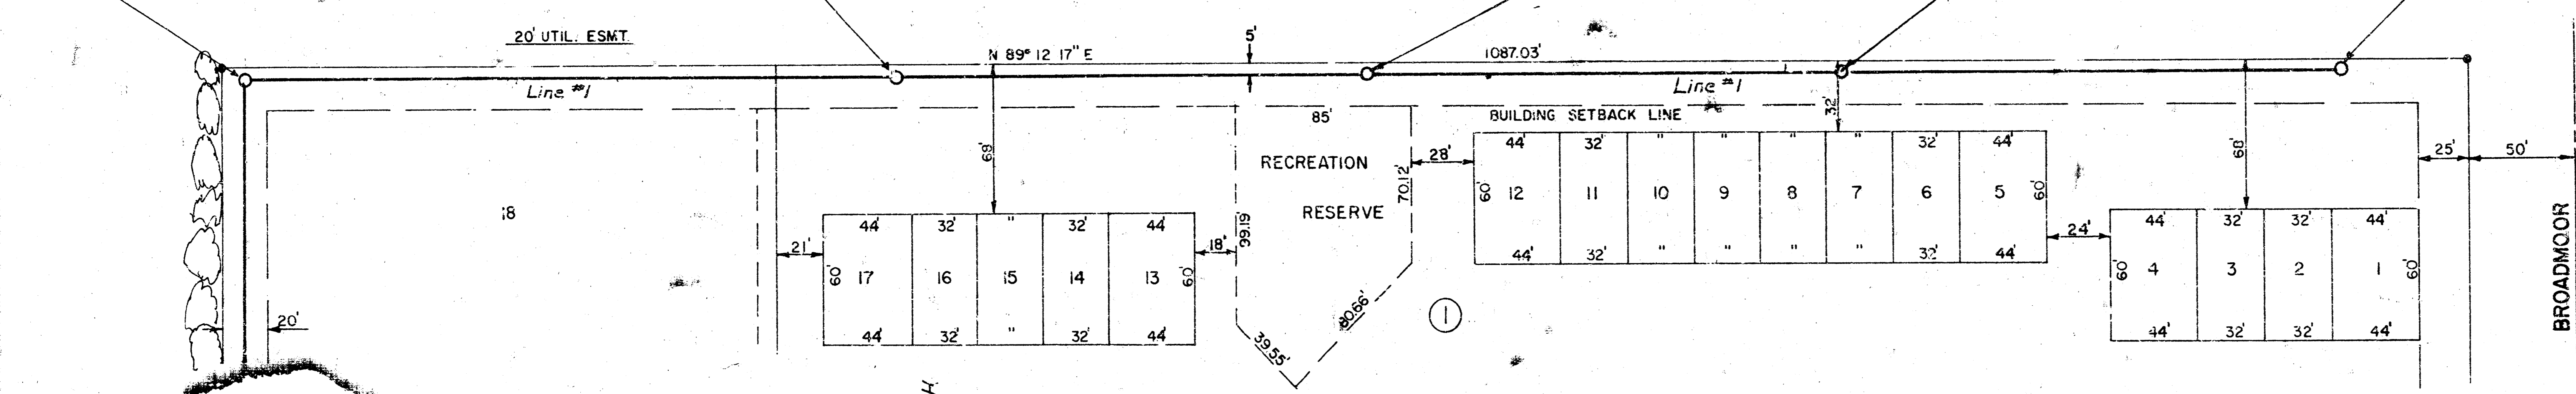

SCALE: 1" = 50' Horiz.  
1" = 5' Vert.

AD Daily  
1/2/14  
11+74  
0+41