


Plan Scale 1" = 40'

Profile Scale 1" = 40' Horiz.
 1" = 5' Vert.

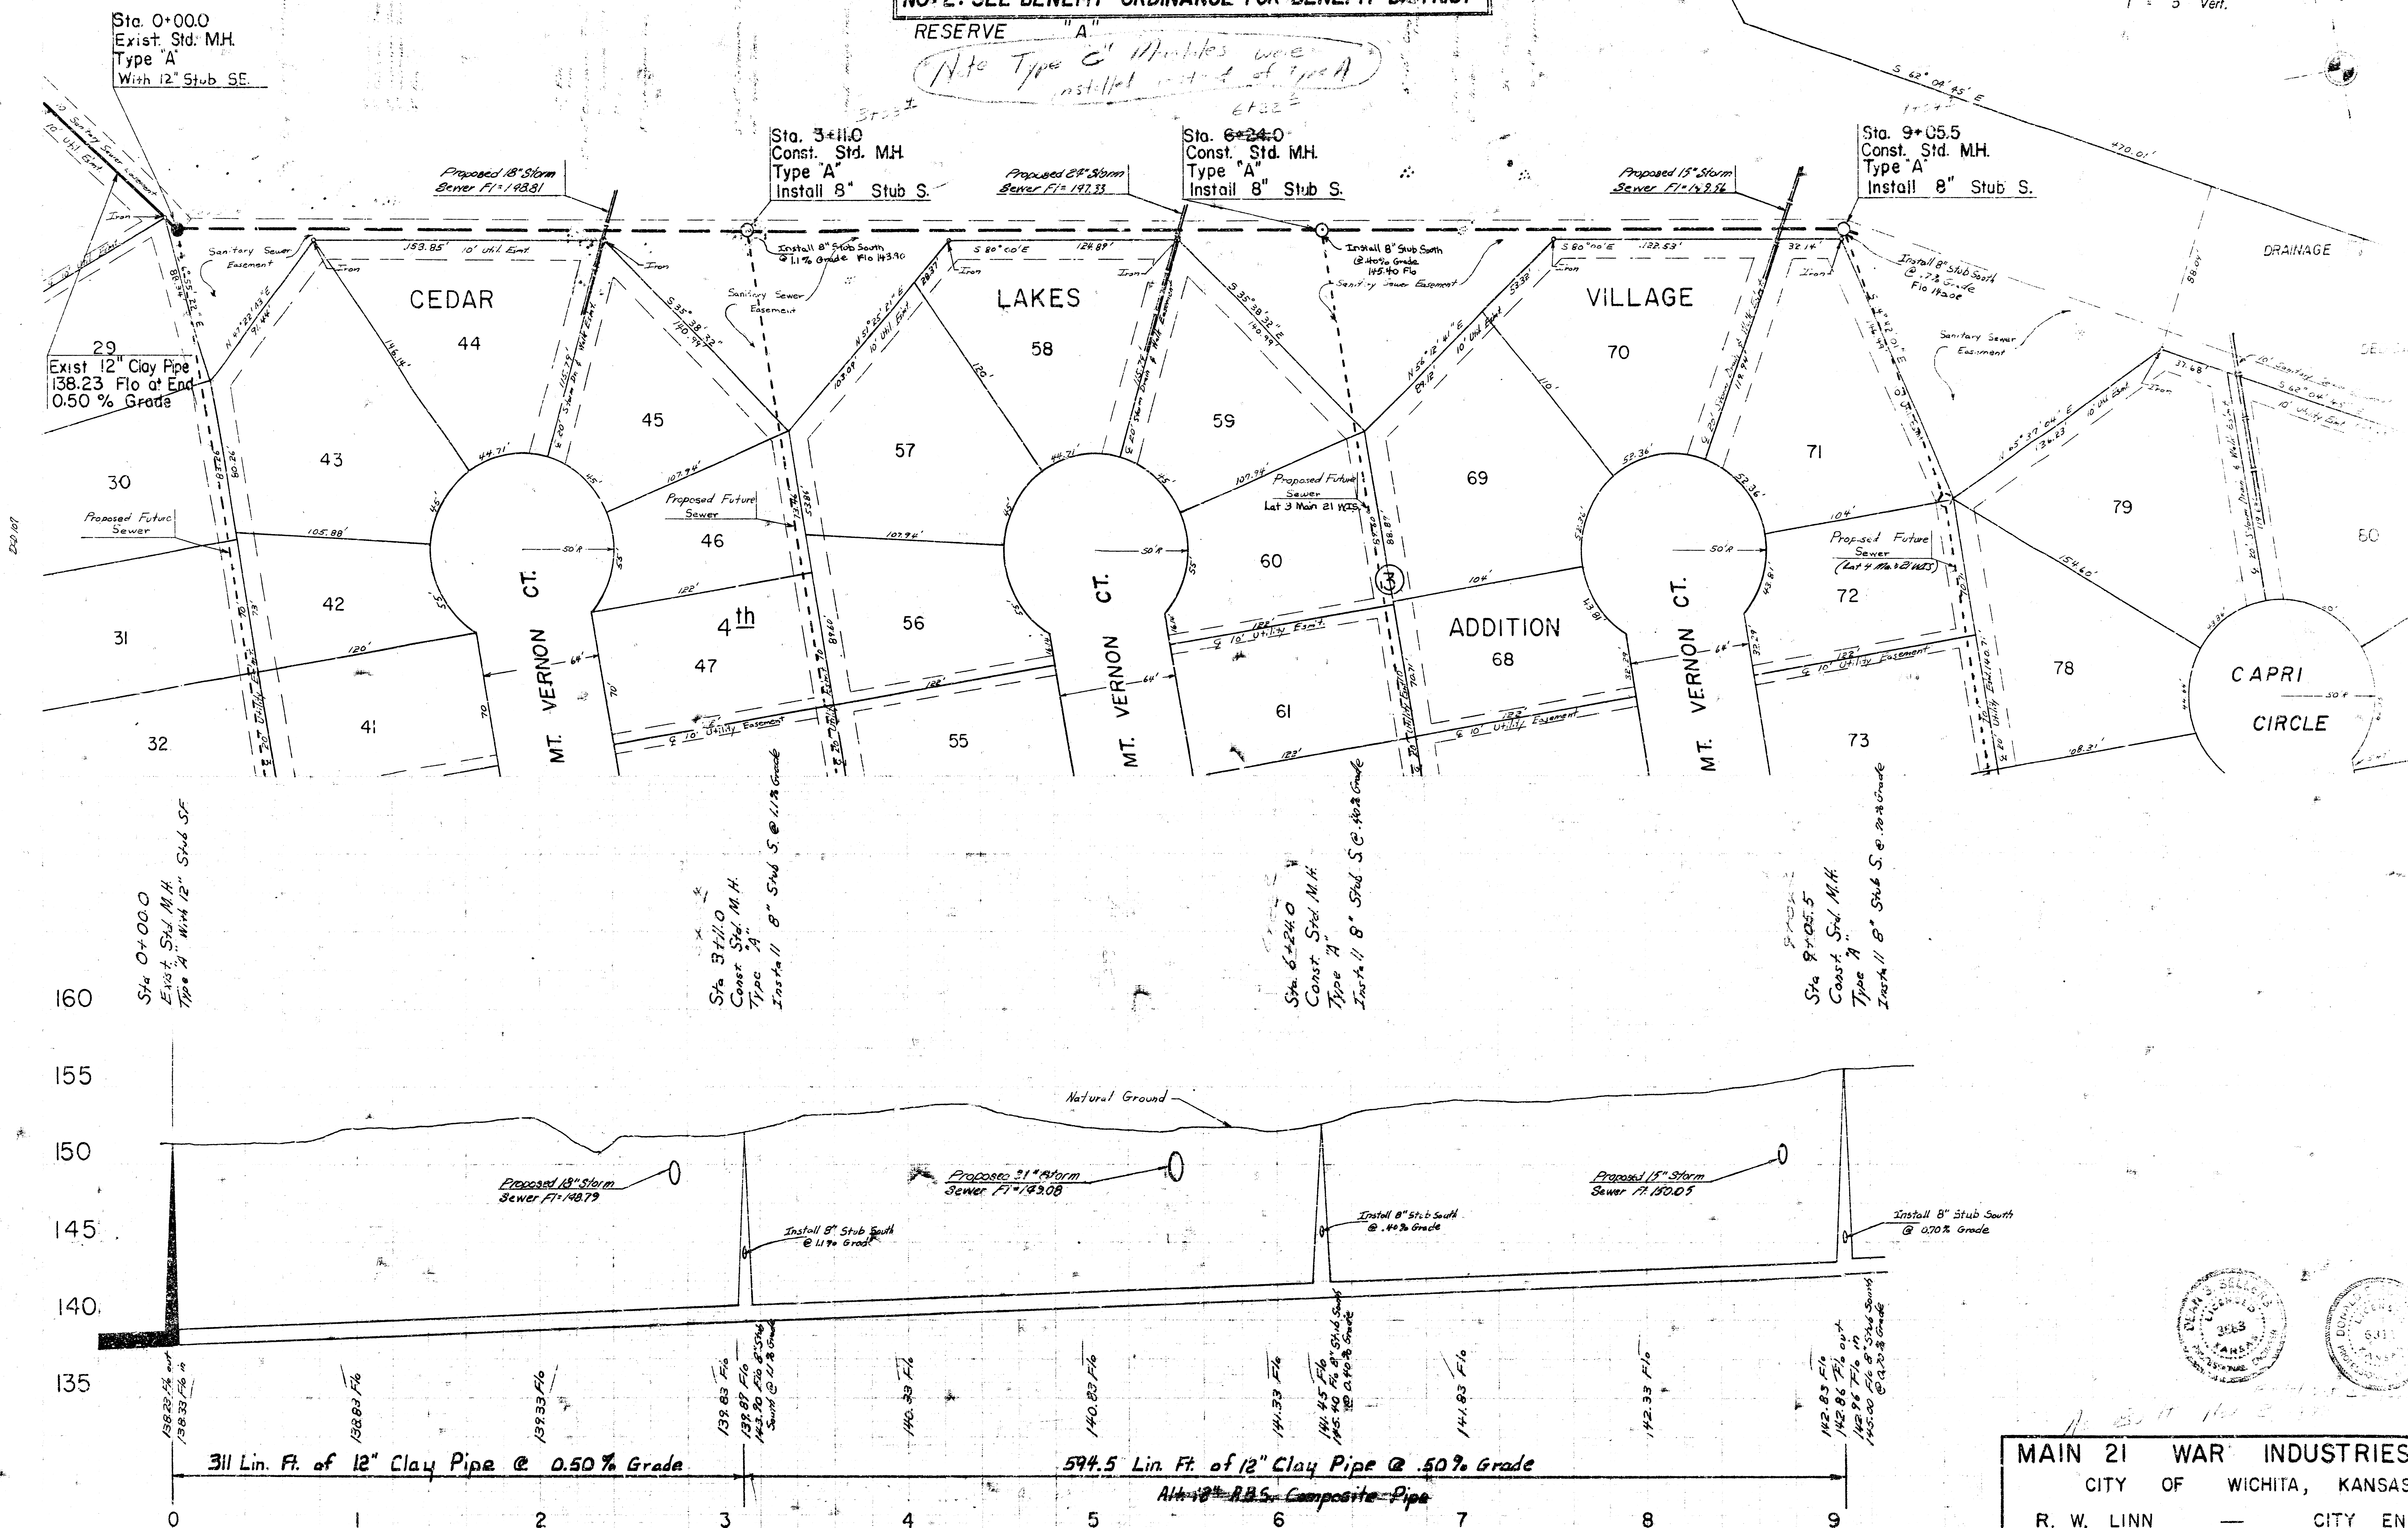

MAIN 21 WAR INDUSTRIES


CITY OF WICHITA, KANSAS

R. W. LINN — CITY ENG


PROJECT NO. DRKM 6

RESERVE

"A"

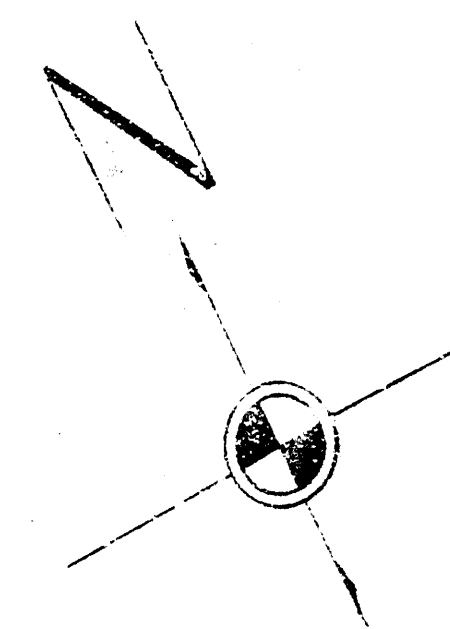

Plan Scale 1"=40'
Profile Scale 1"=40' Horiz.
1"=5' Vert.

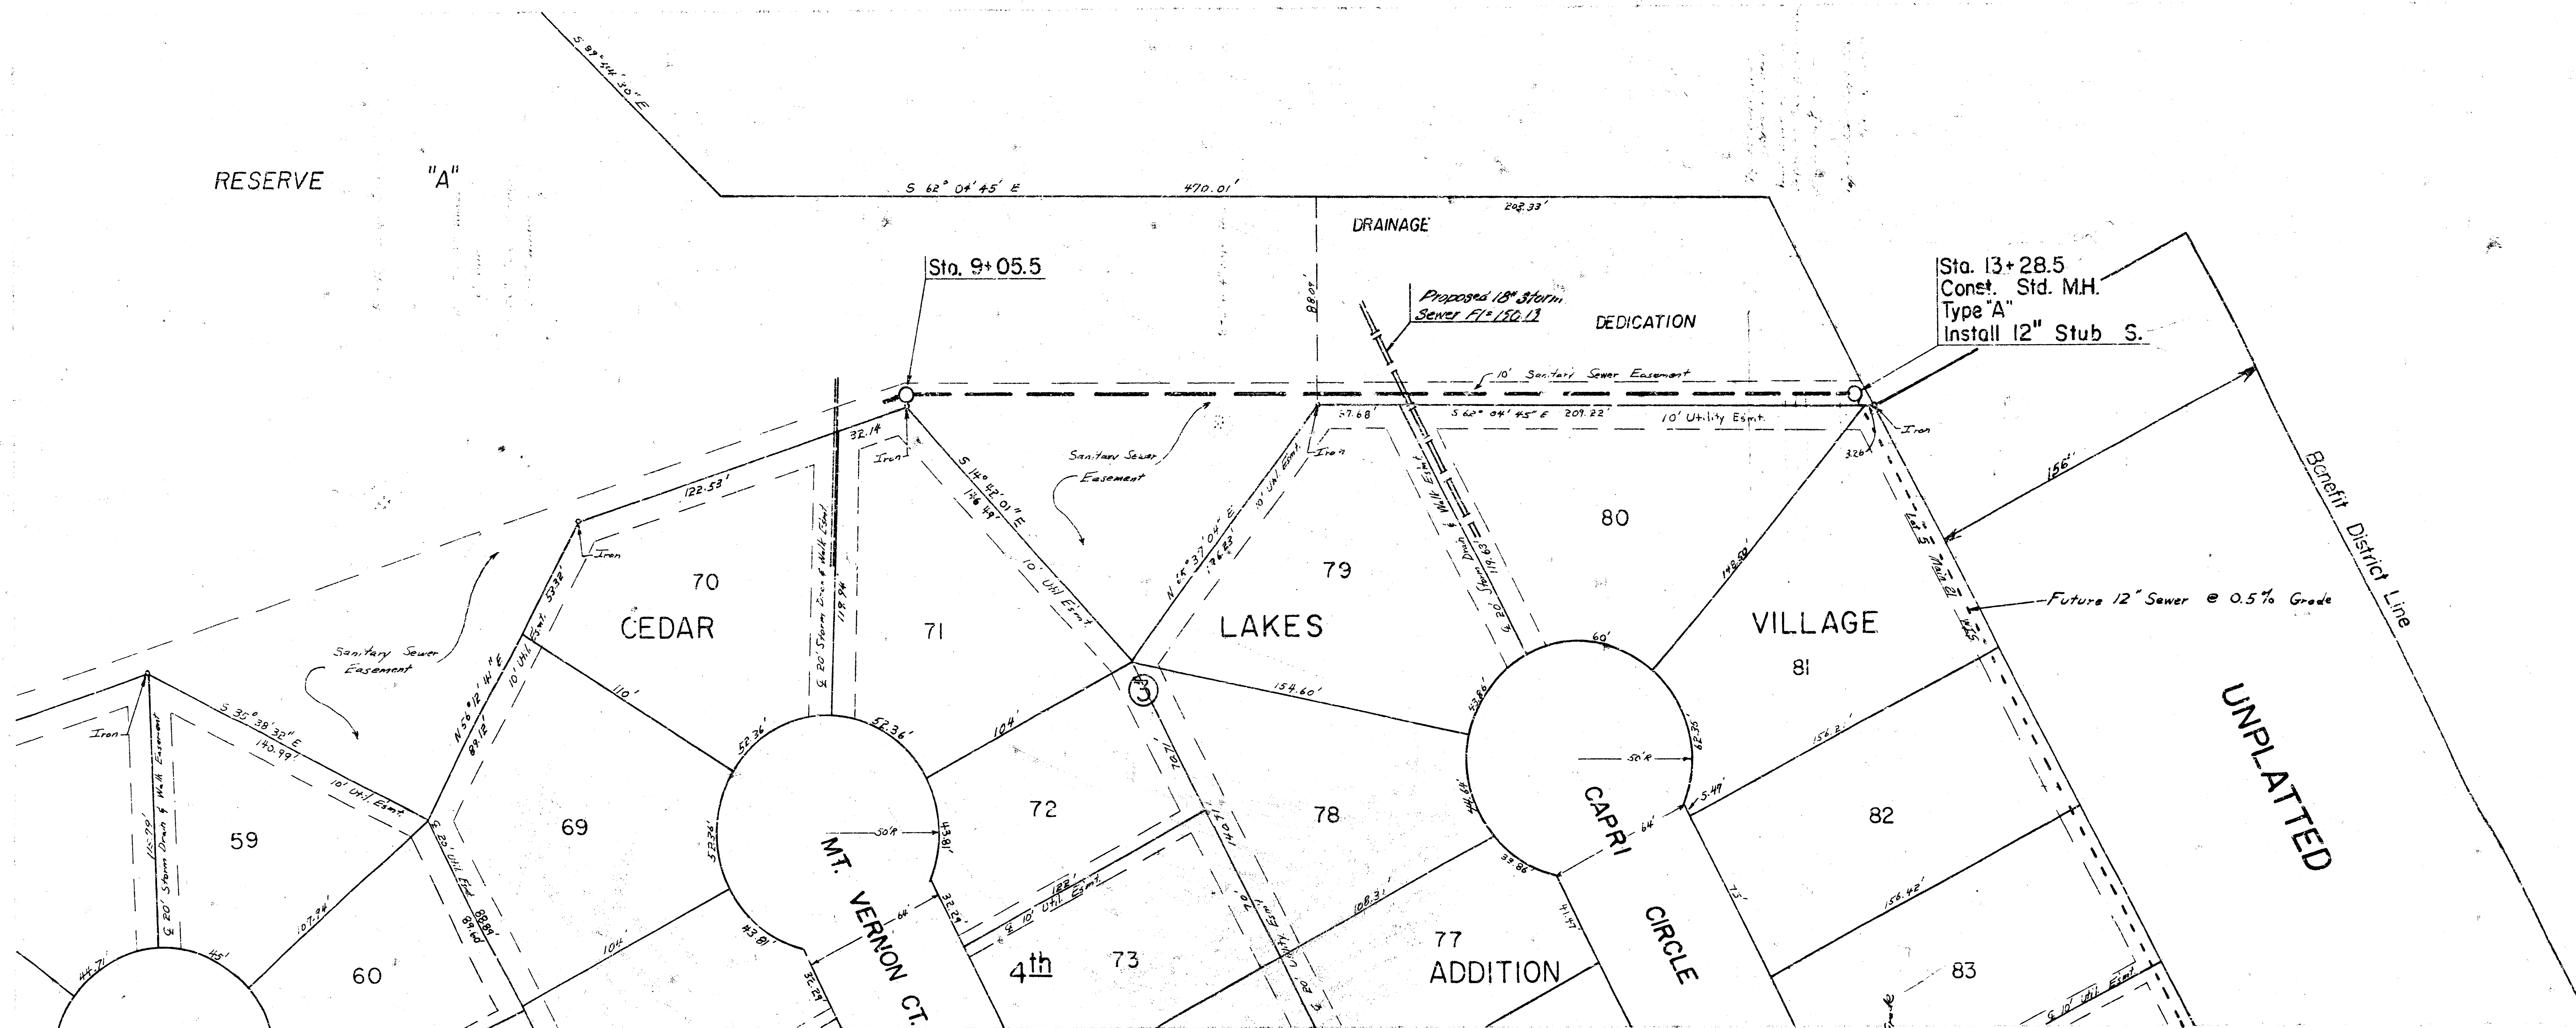

160

155

150

145

140

135

