
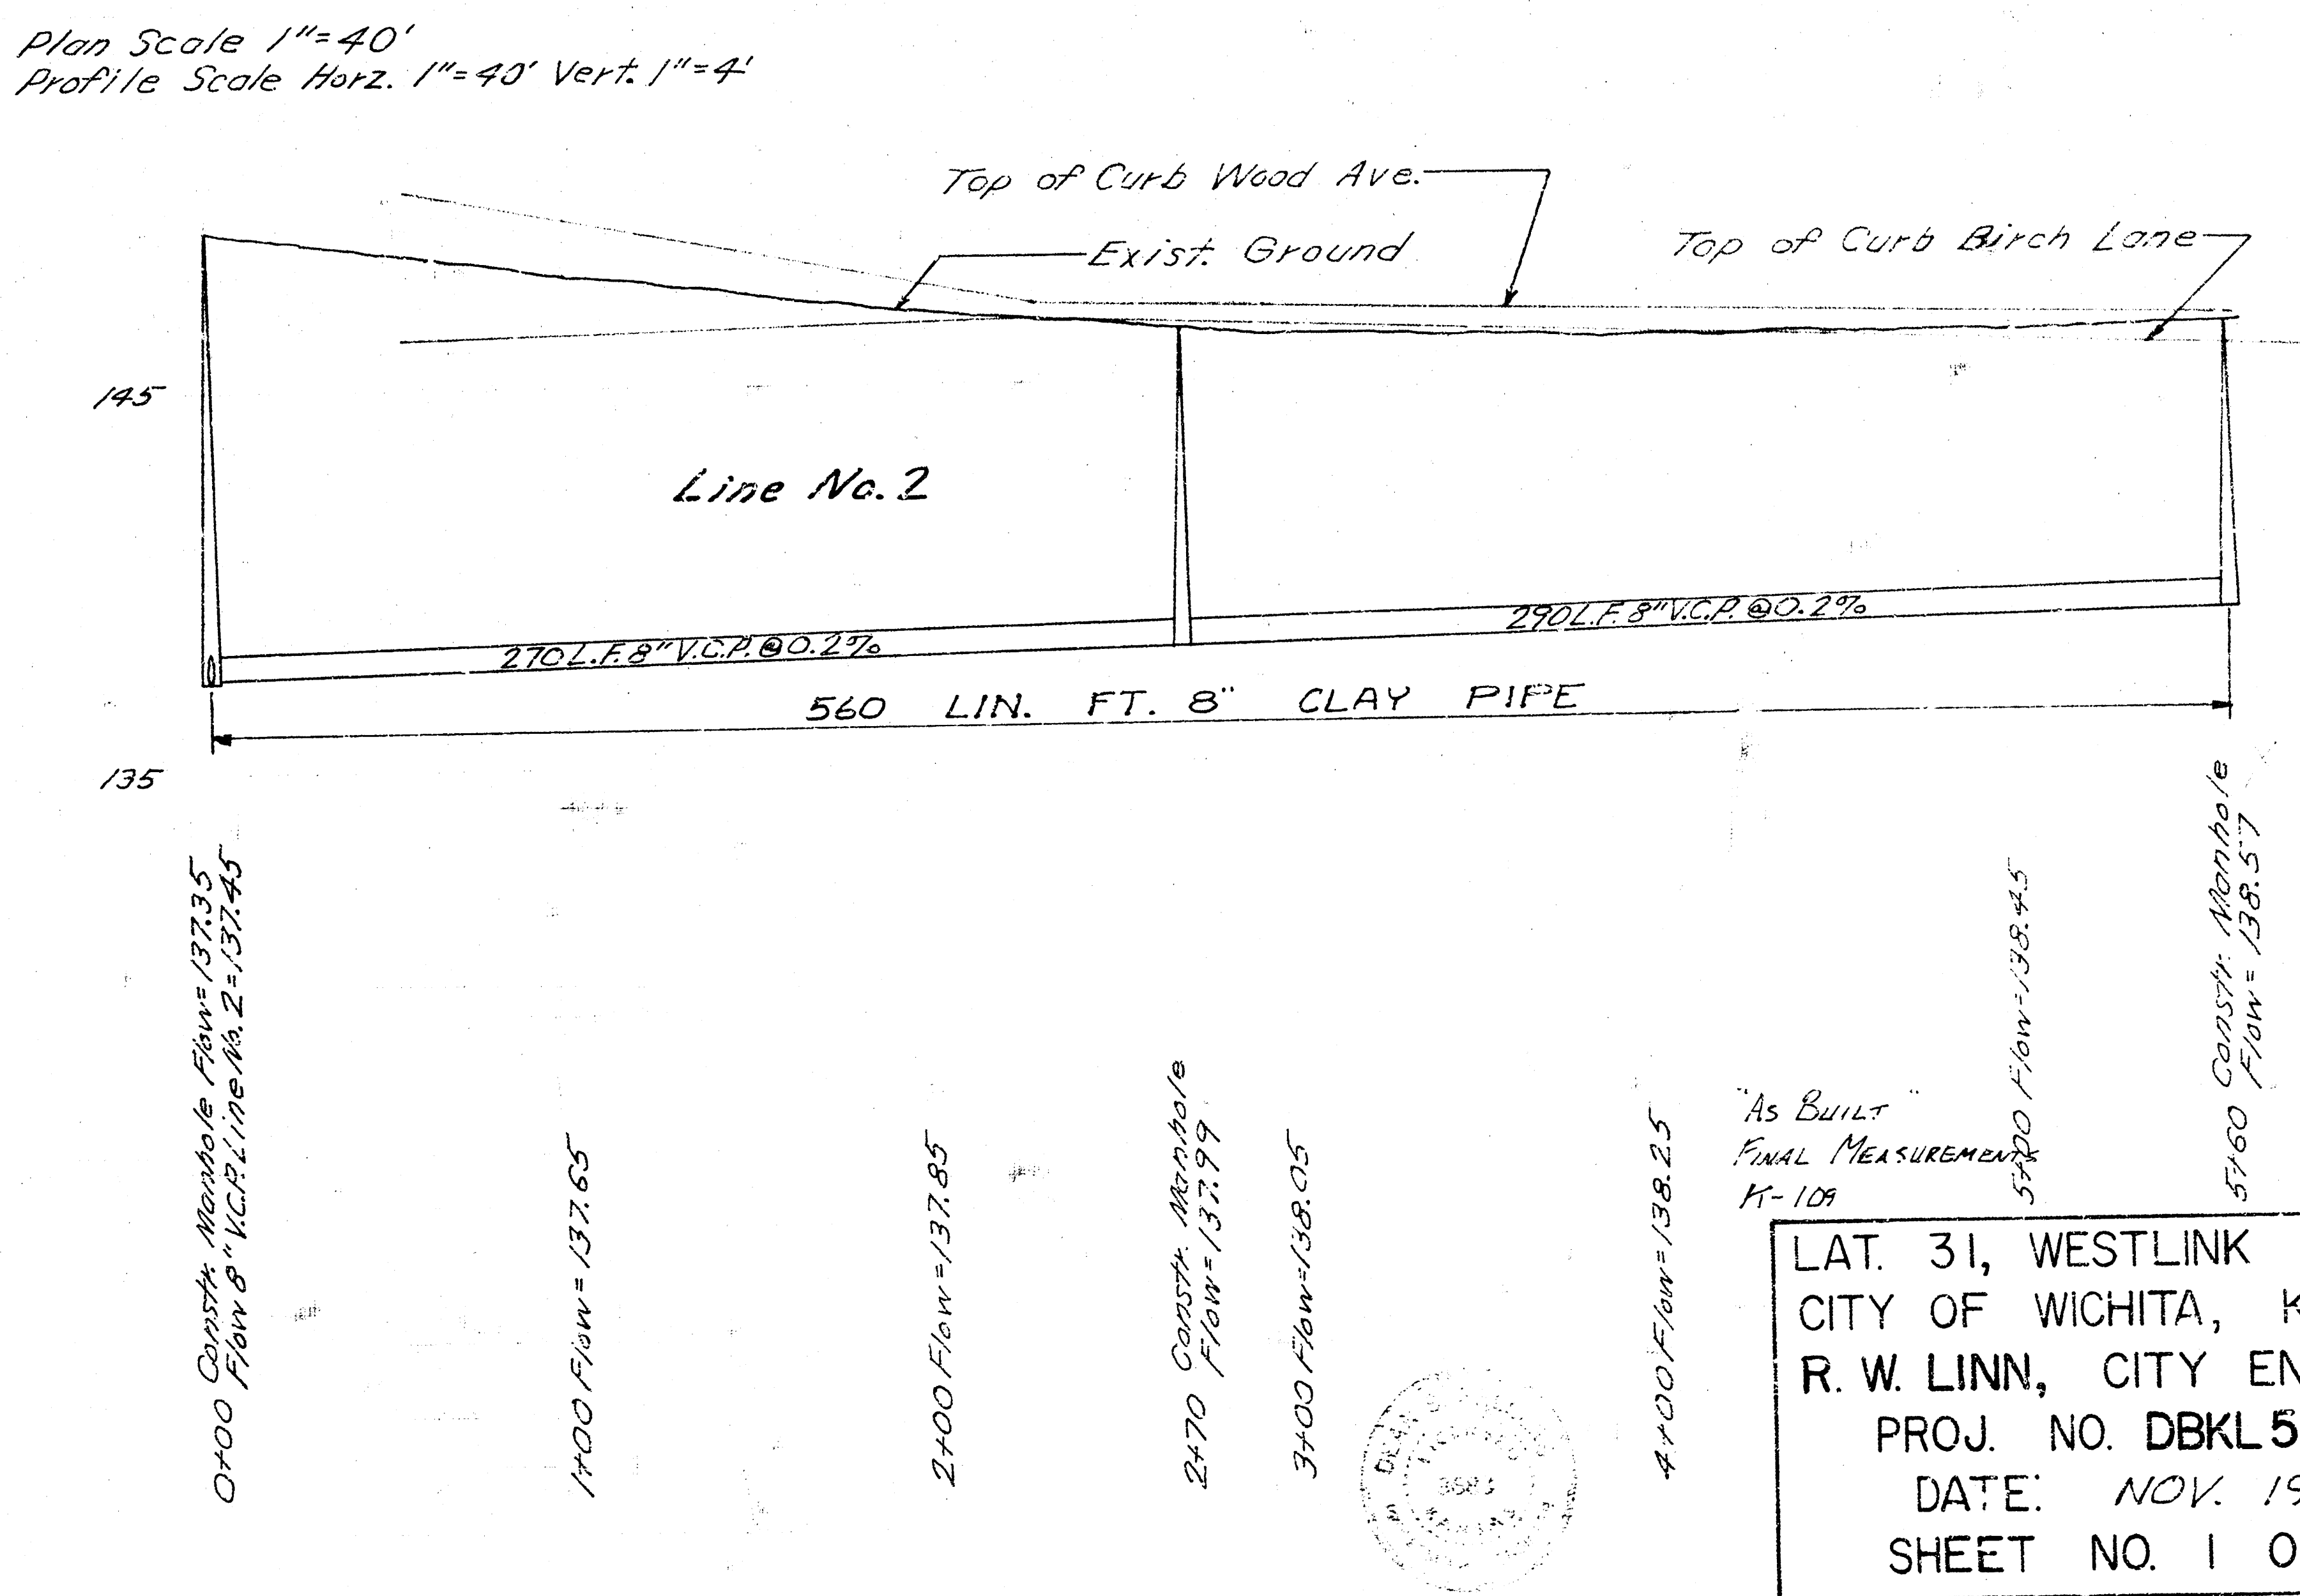
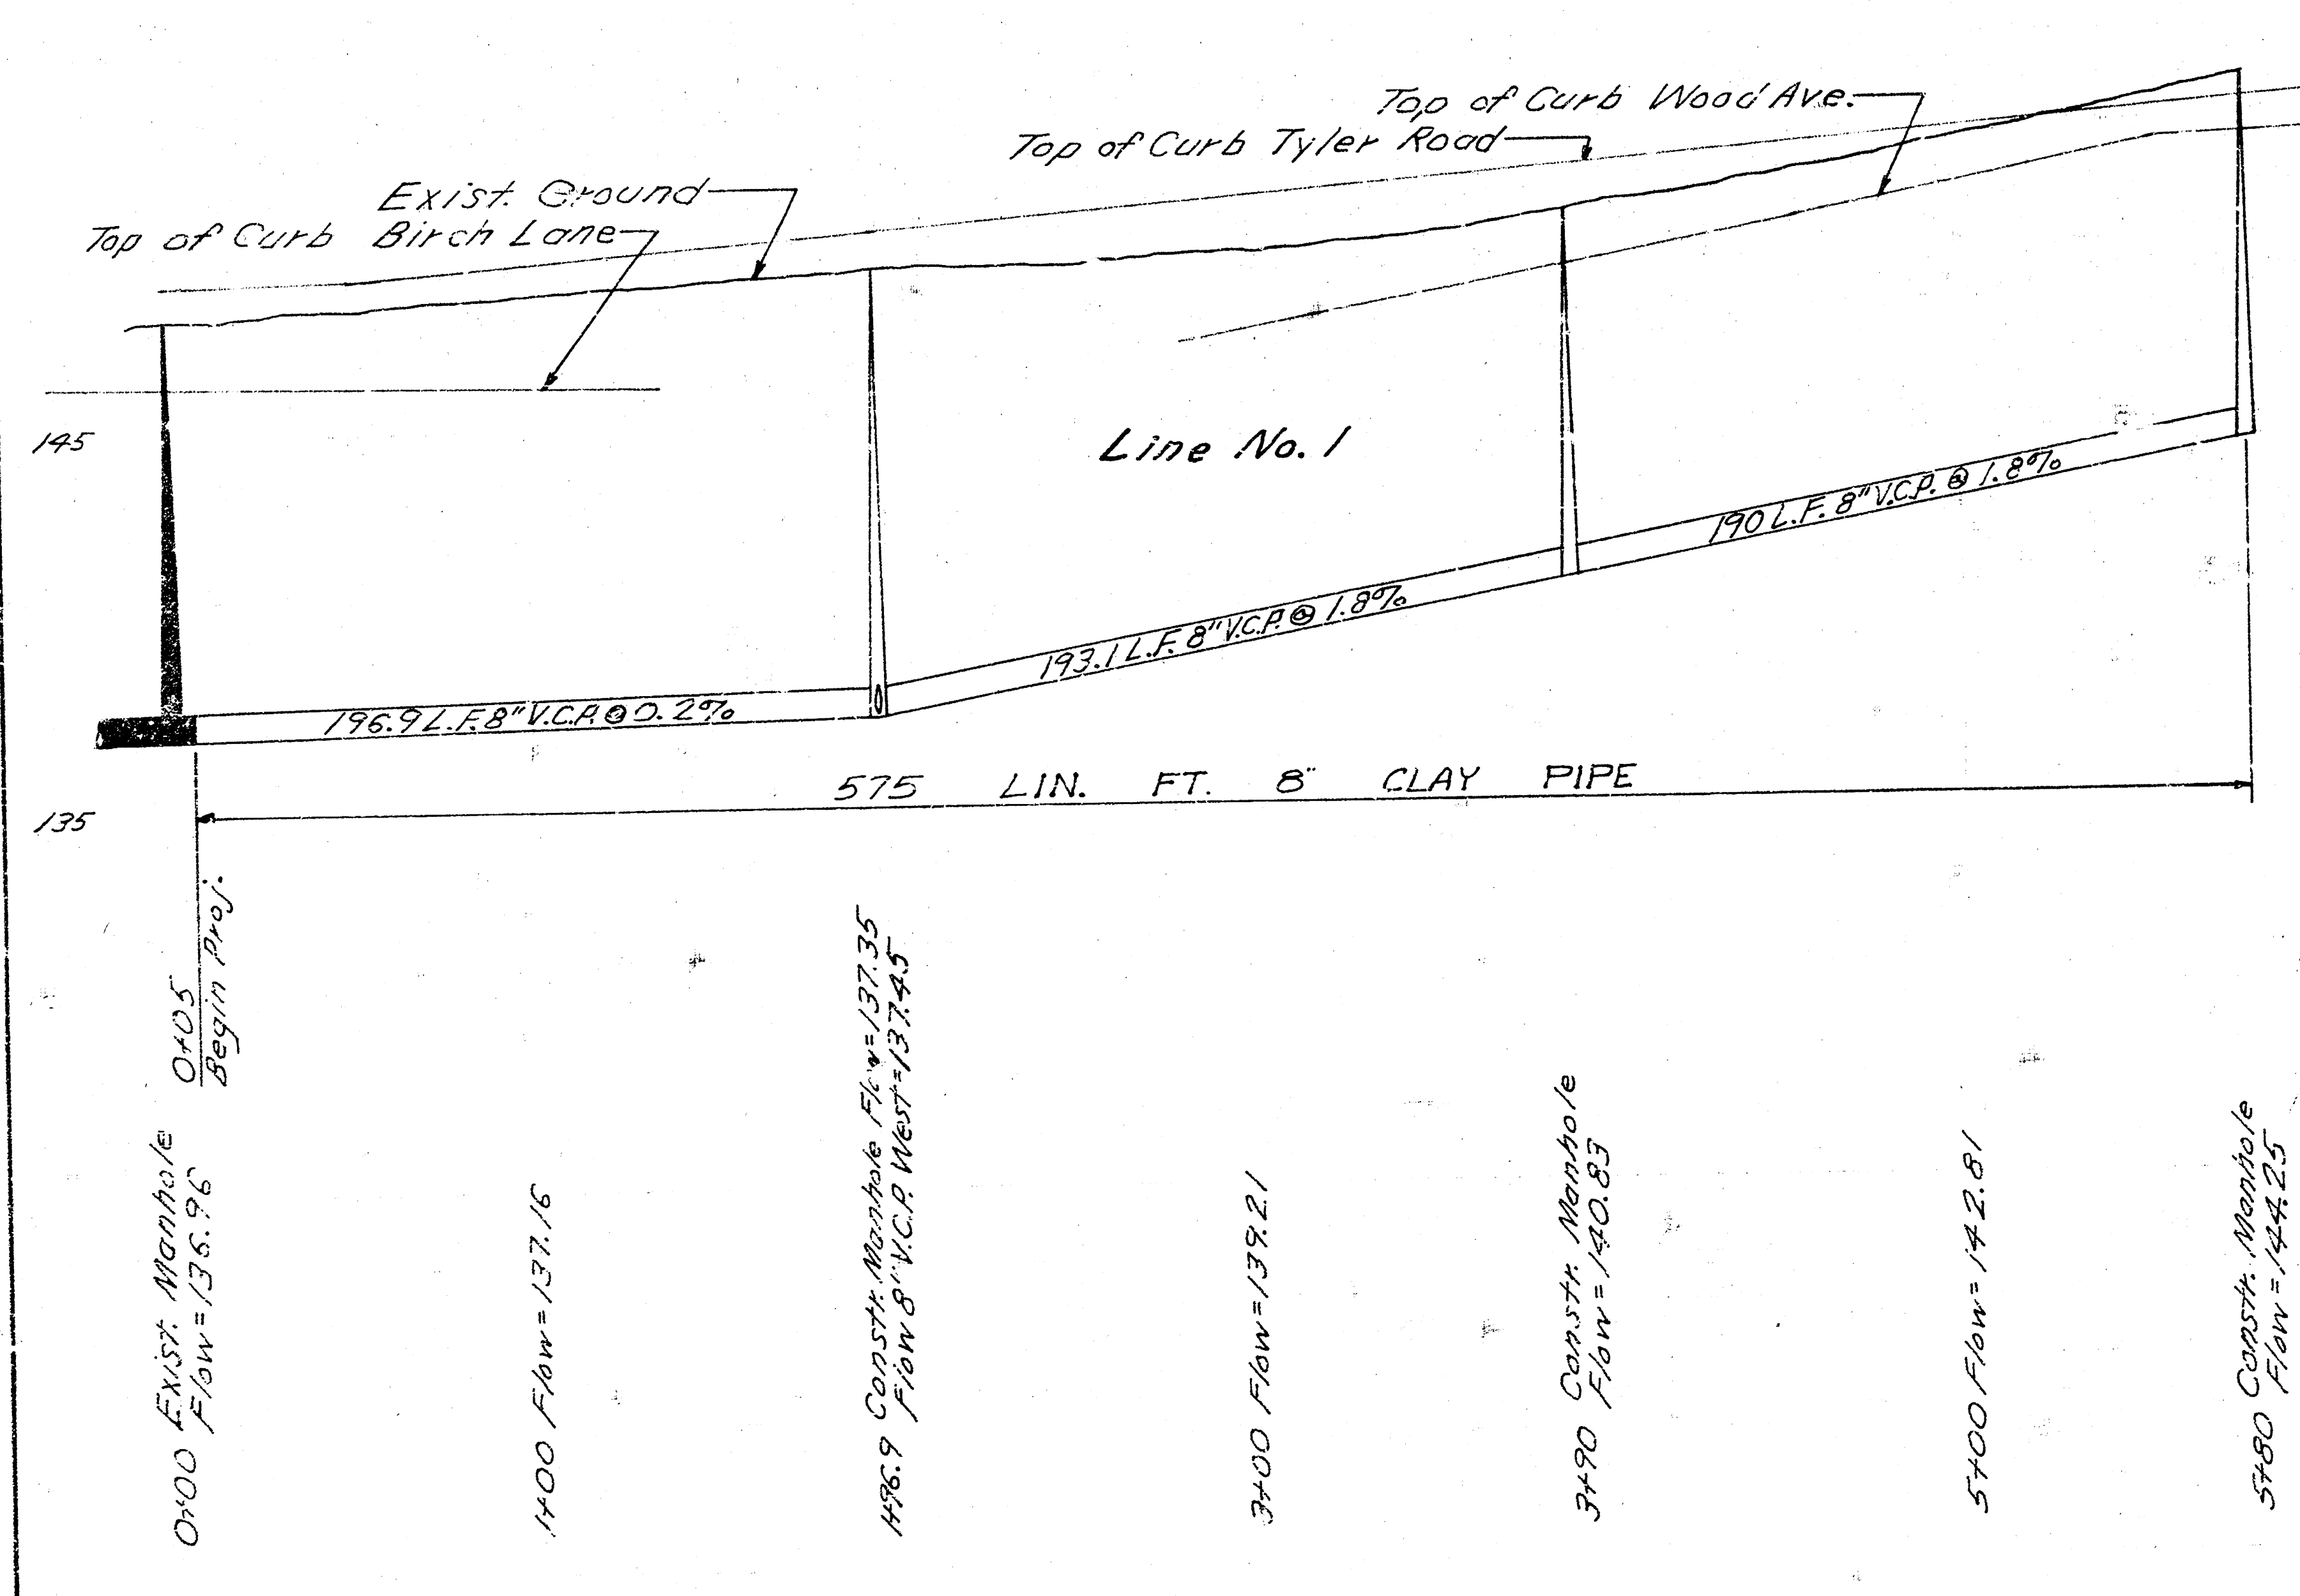


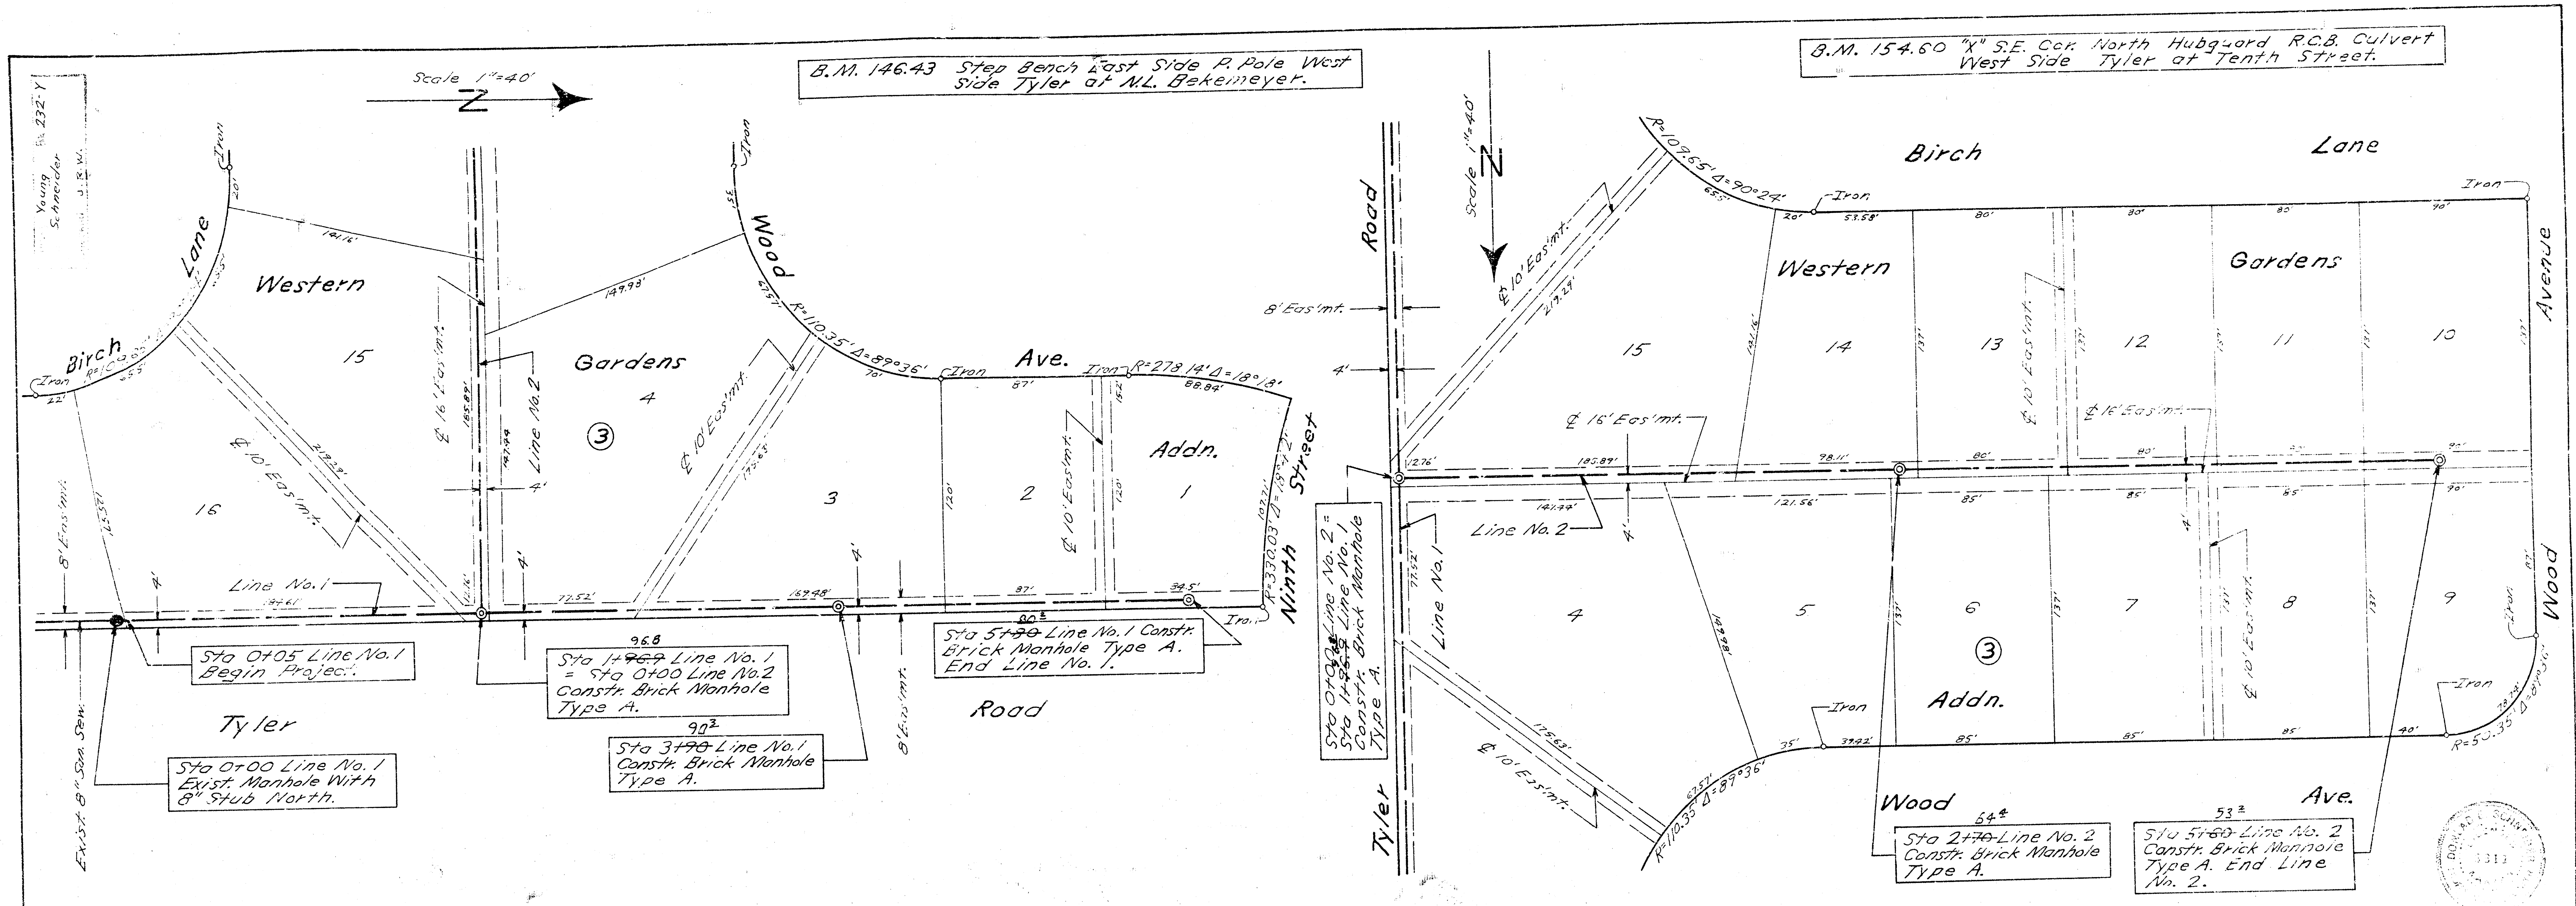

LAT. 31, WESTLINK SEWER
 CITY OF WICHITA, KANSAS
 R. W. LINN, CITY ENGINEER
 PROJ. NO. DBKL 567058
 DATE: NOV. 1972
 SHEET NO. 1 OF 1