




B. M. 155.470 "t" top west curb Chipper Lane  
at S. L. Briarwood.

B. M. 157.080 Top ball S.W. cor. H.L.P. base  
S-Side K. G. E. Westlink Sub station on 13th.

Plan Scale 1" = 40'  
Profile Scale 1" = 40' Horiz.  
1" = 5' Vert.

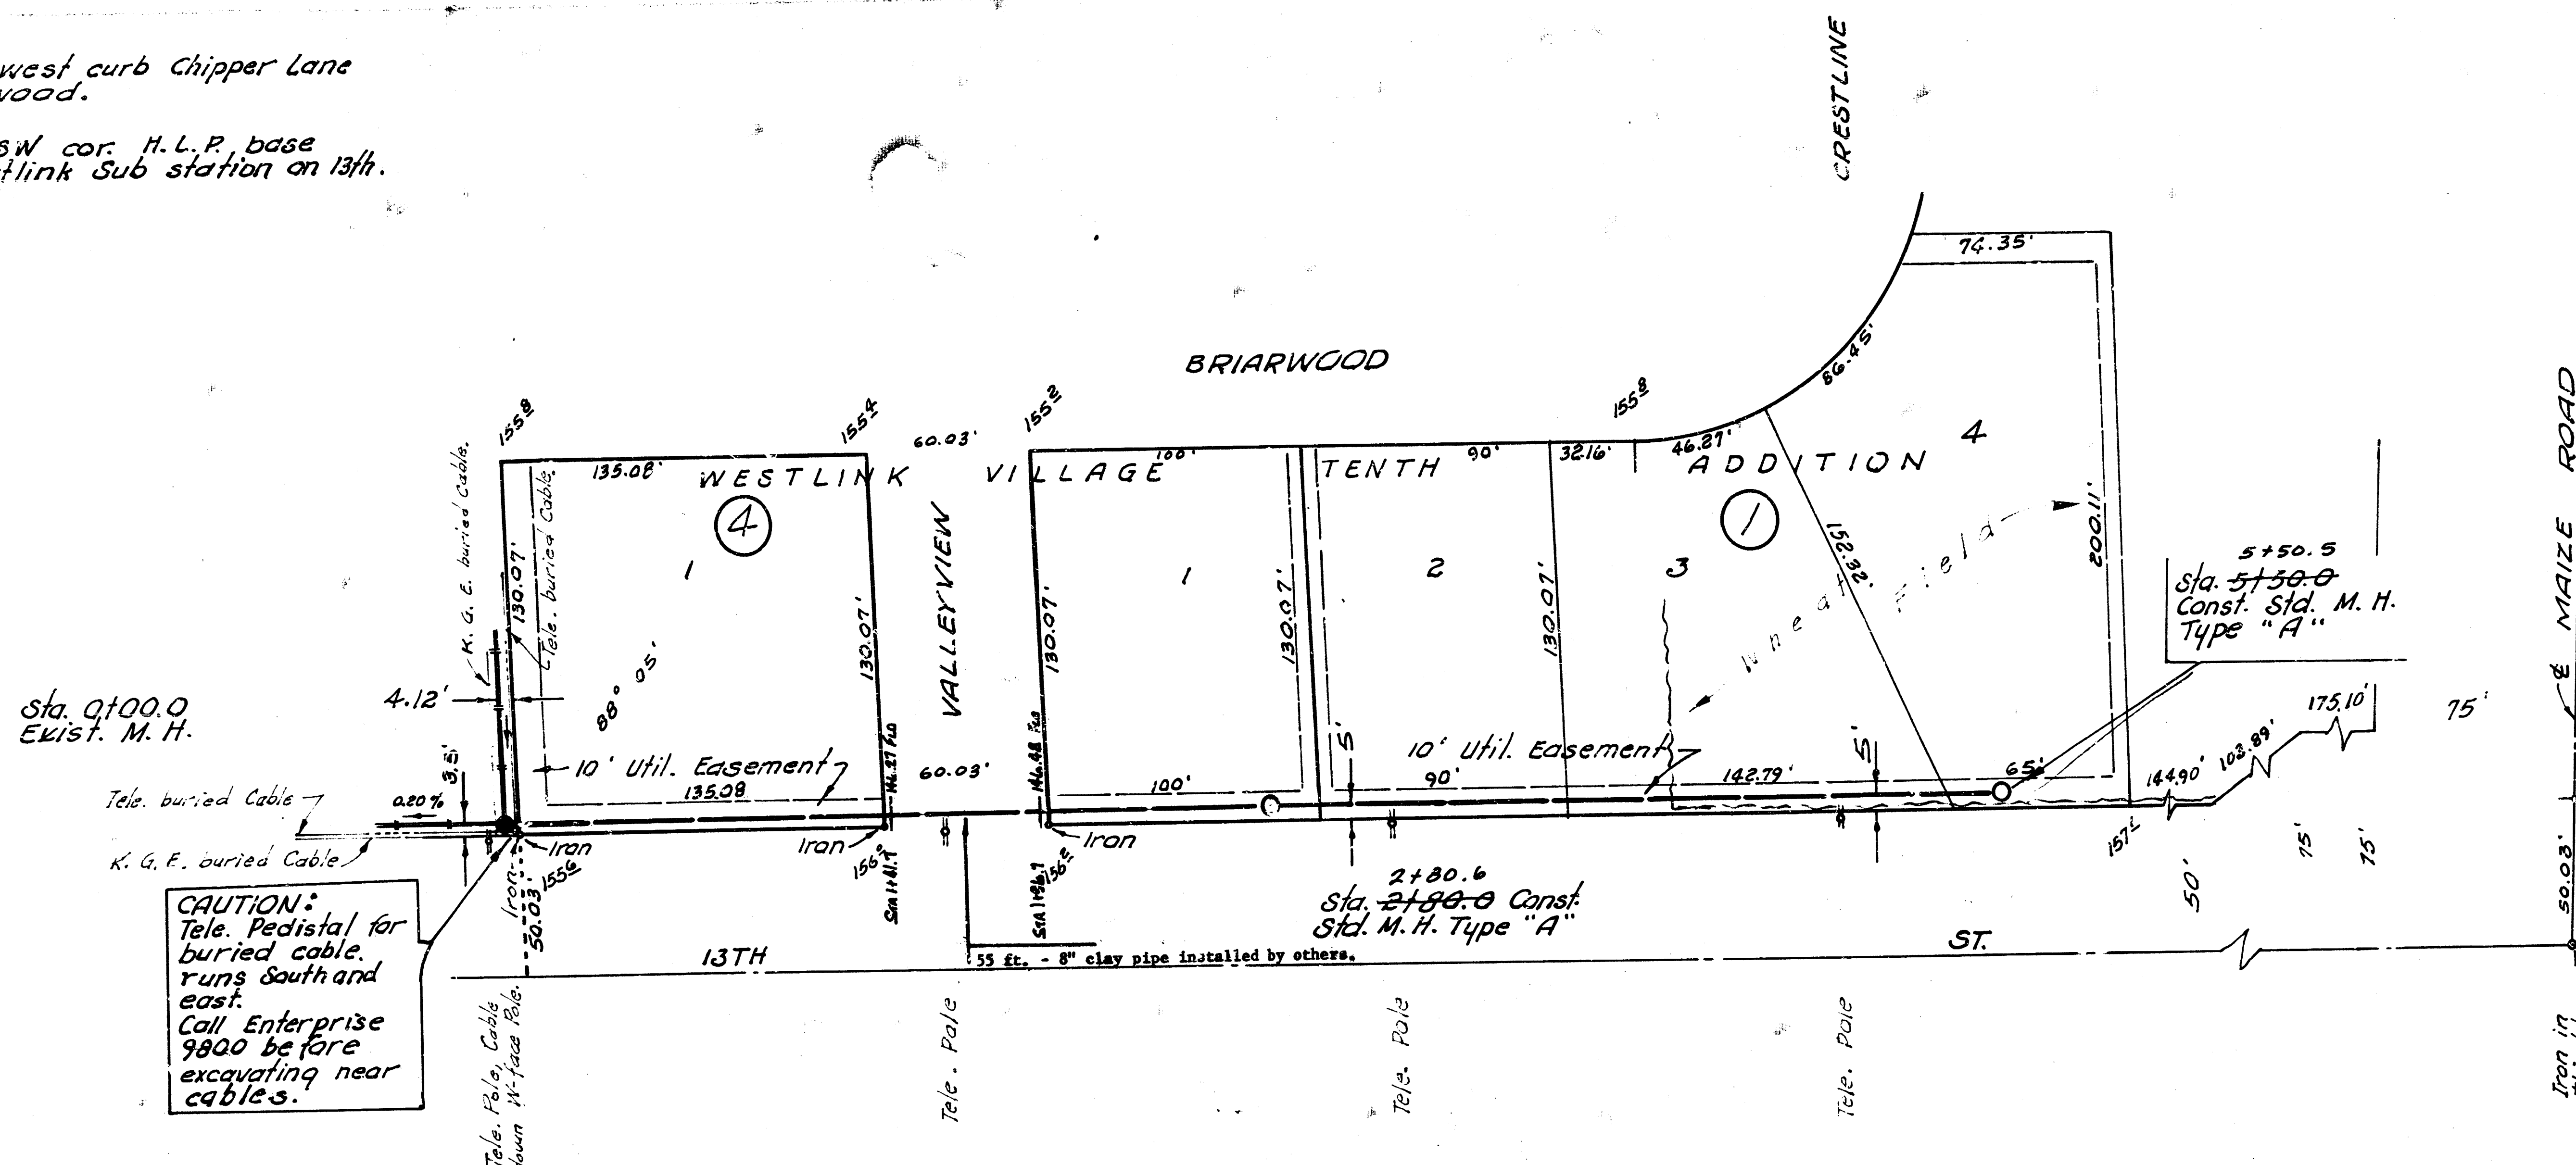

CAUTION:  
Tele. Pedestal for  
buried cable  
runs south and  
east.  
Call Enterprise  
9800 before  
excavating near  
cables.

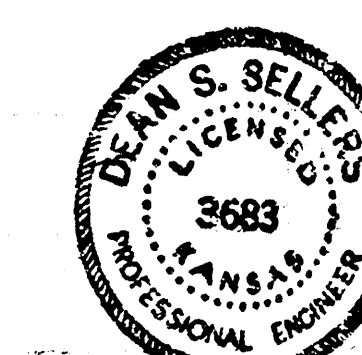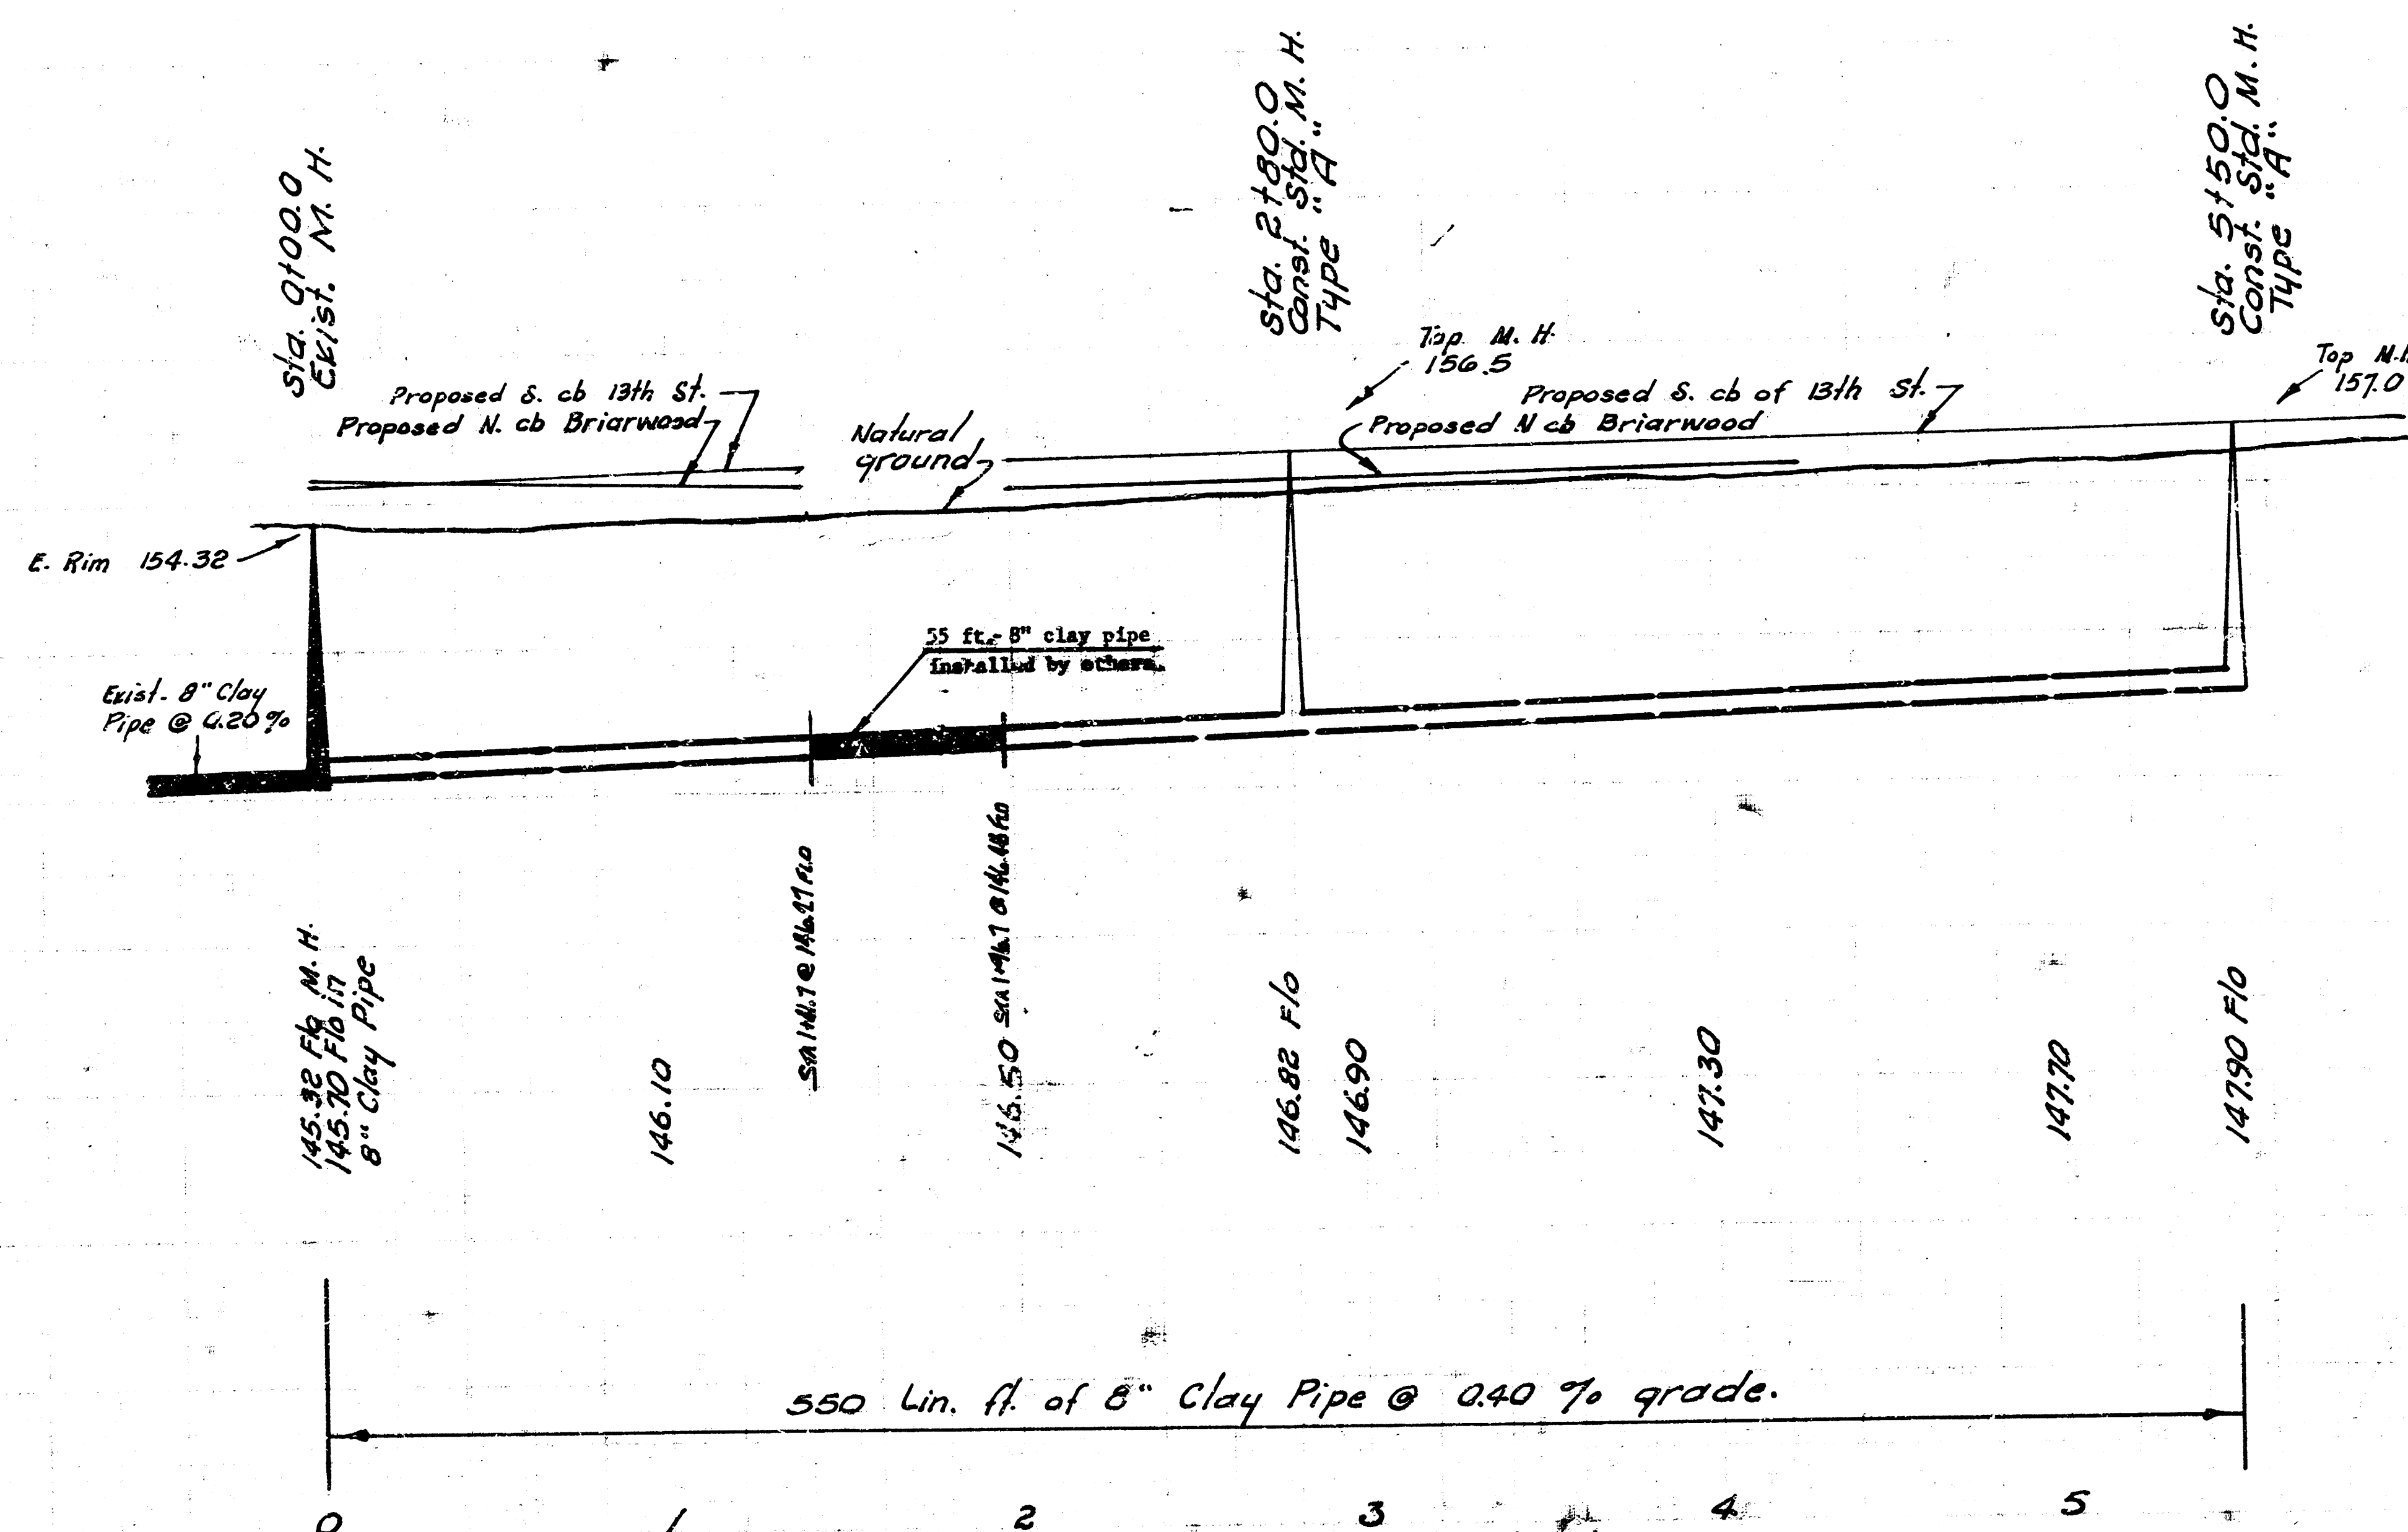

Final Prop. "A" Bv. H. E-100  
**LAT. 55, WESTLINK SEWER**  
CITY OF WICHITA, KANSAS  
R. W. LINN — CITY ENGINEER  
AUGUST 1973, PROJECT NO. DBKL572048

FILMED FROM THE BEST  
AVAILABLE COPY....