
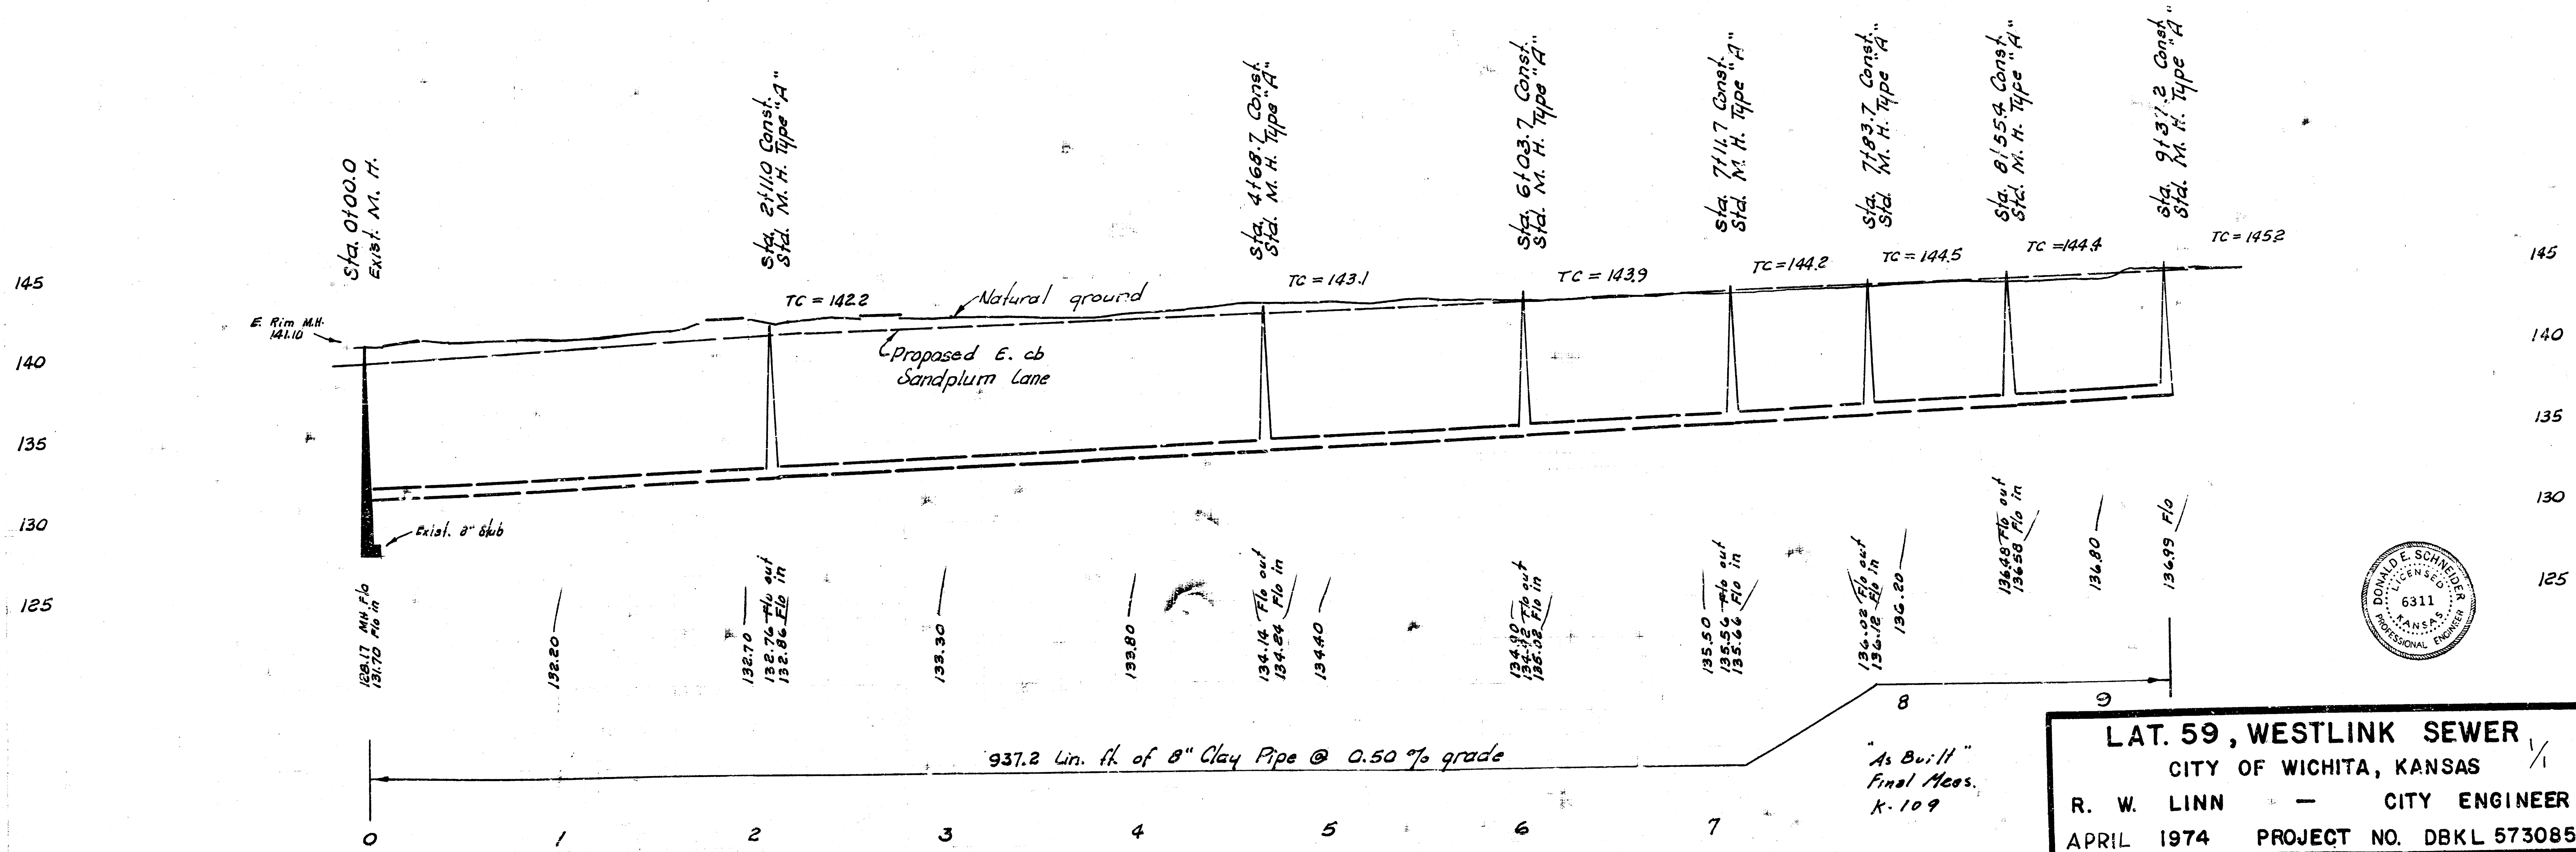


B. M. 139.19 a top curb 12' west of W. end N.W. Radius Mulberry and Sandplum.
 B. M. 145.44 "M" in Mid Kansas 12' S. of S. end S.E. Radius Sandplum & Scouller.
 B. M. 143.20 S. S. drive @ garage wall House 1218 Sandplum.

Plan Scale 1" = 40'
 Profile Scale 1" = 40' Horiz.
 1" = 5' Vert.

NOTE:
 Replace all Conc. drives.

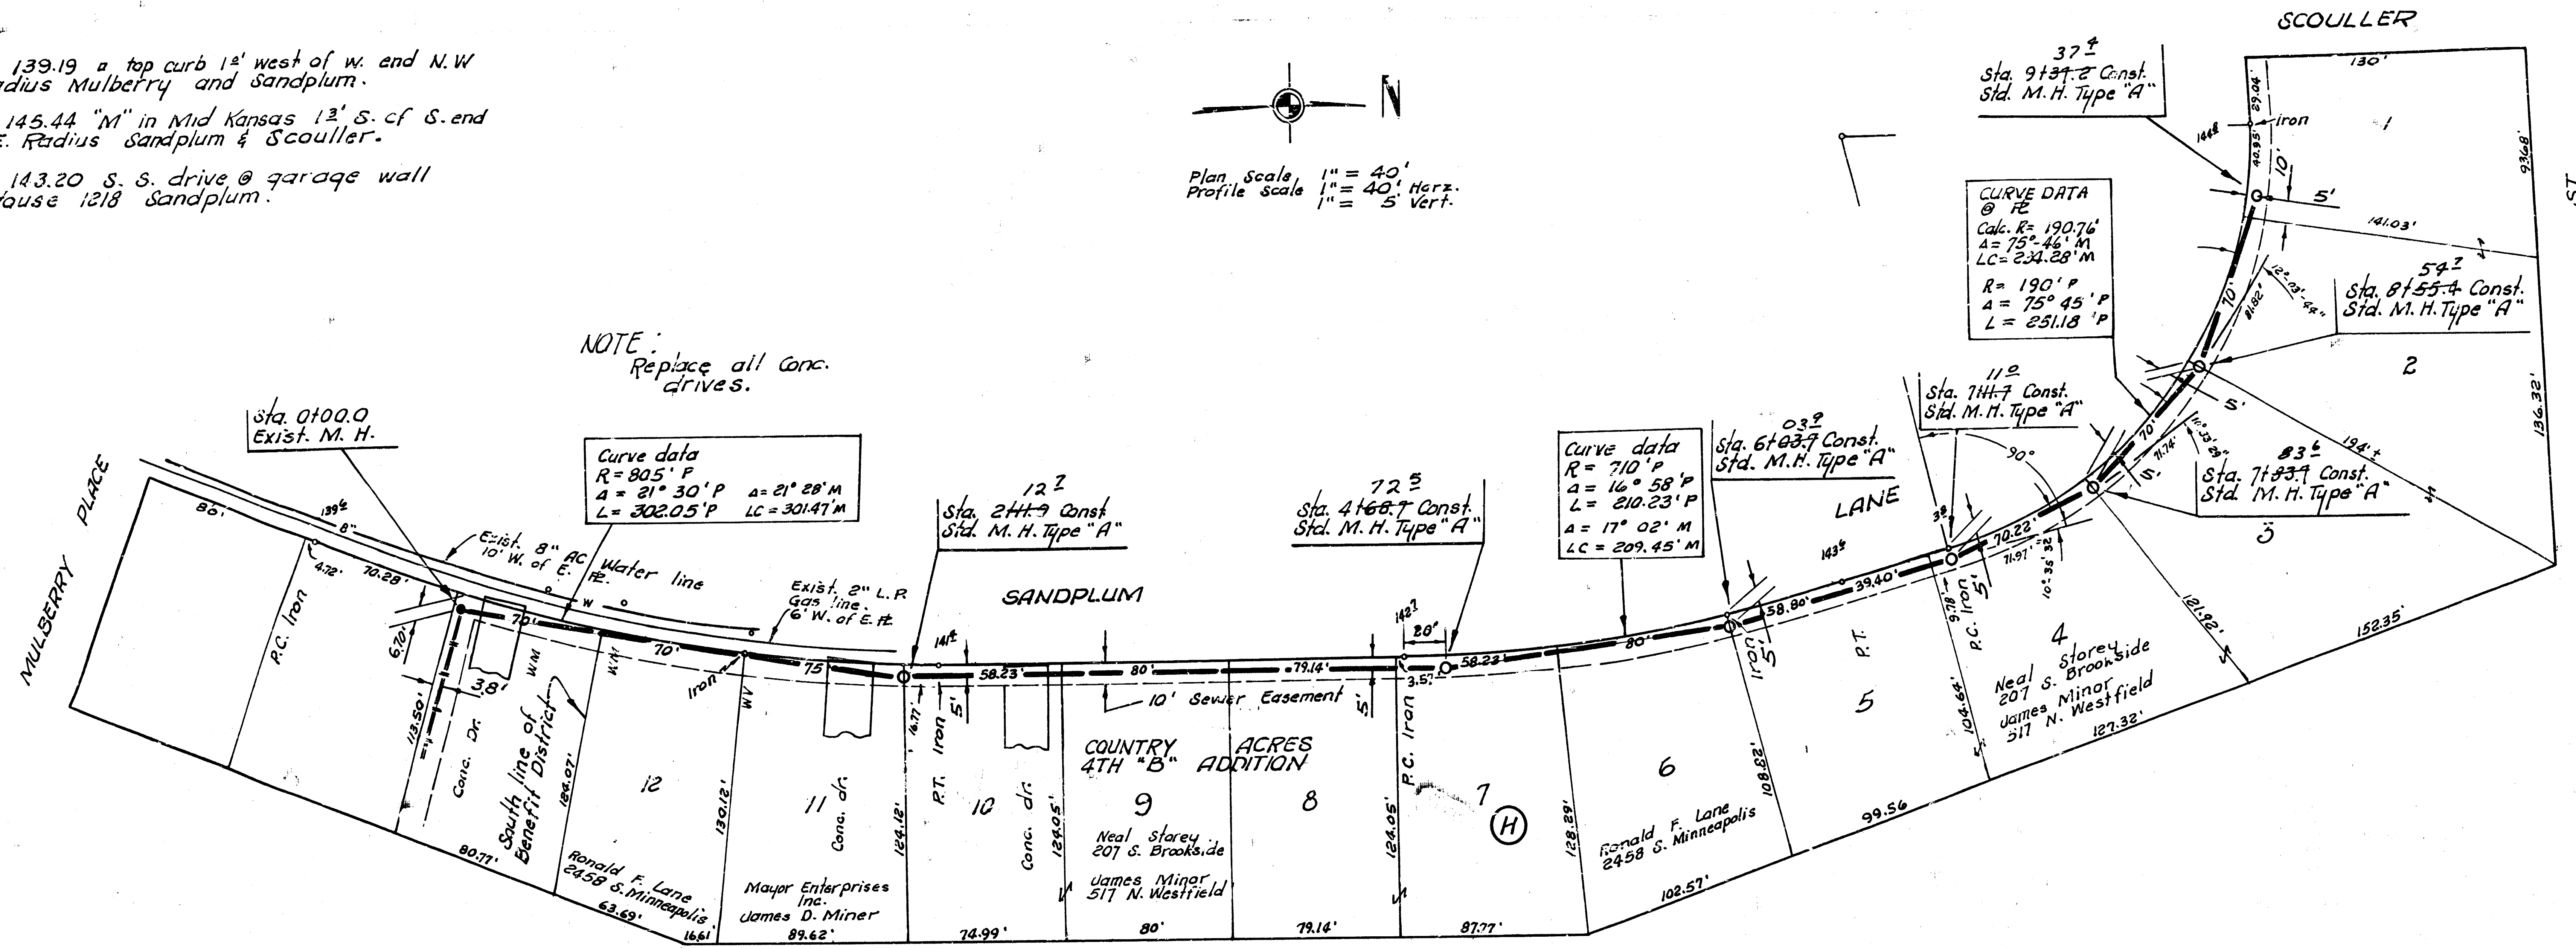

LAT. 59, WESTLINK SEWER
 CITY OF WICHITA, KANSAS
 R. W. LINN — CITY ENGINEER
 APRIL 1974 PROJECT NO. DBKL 573085