

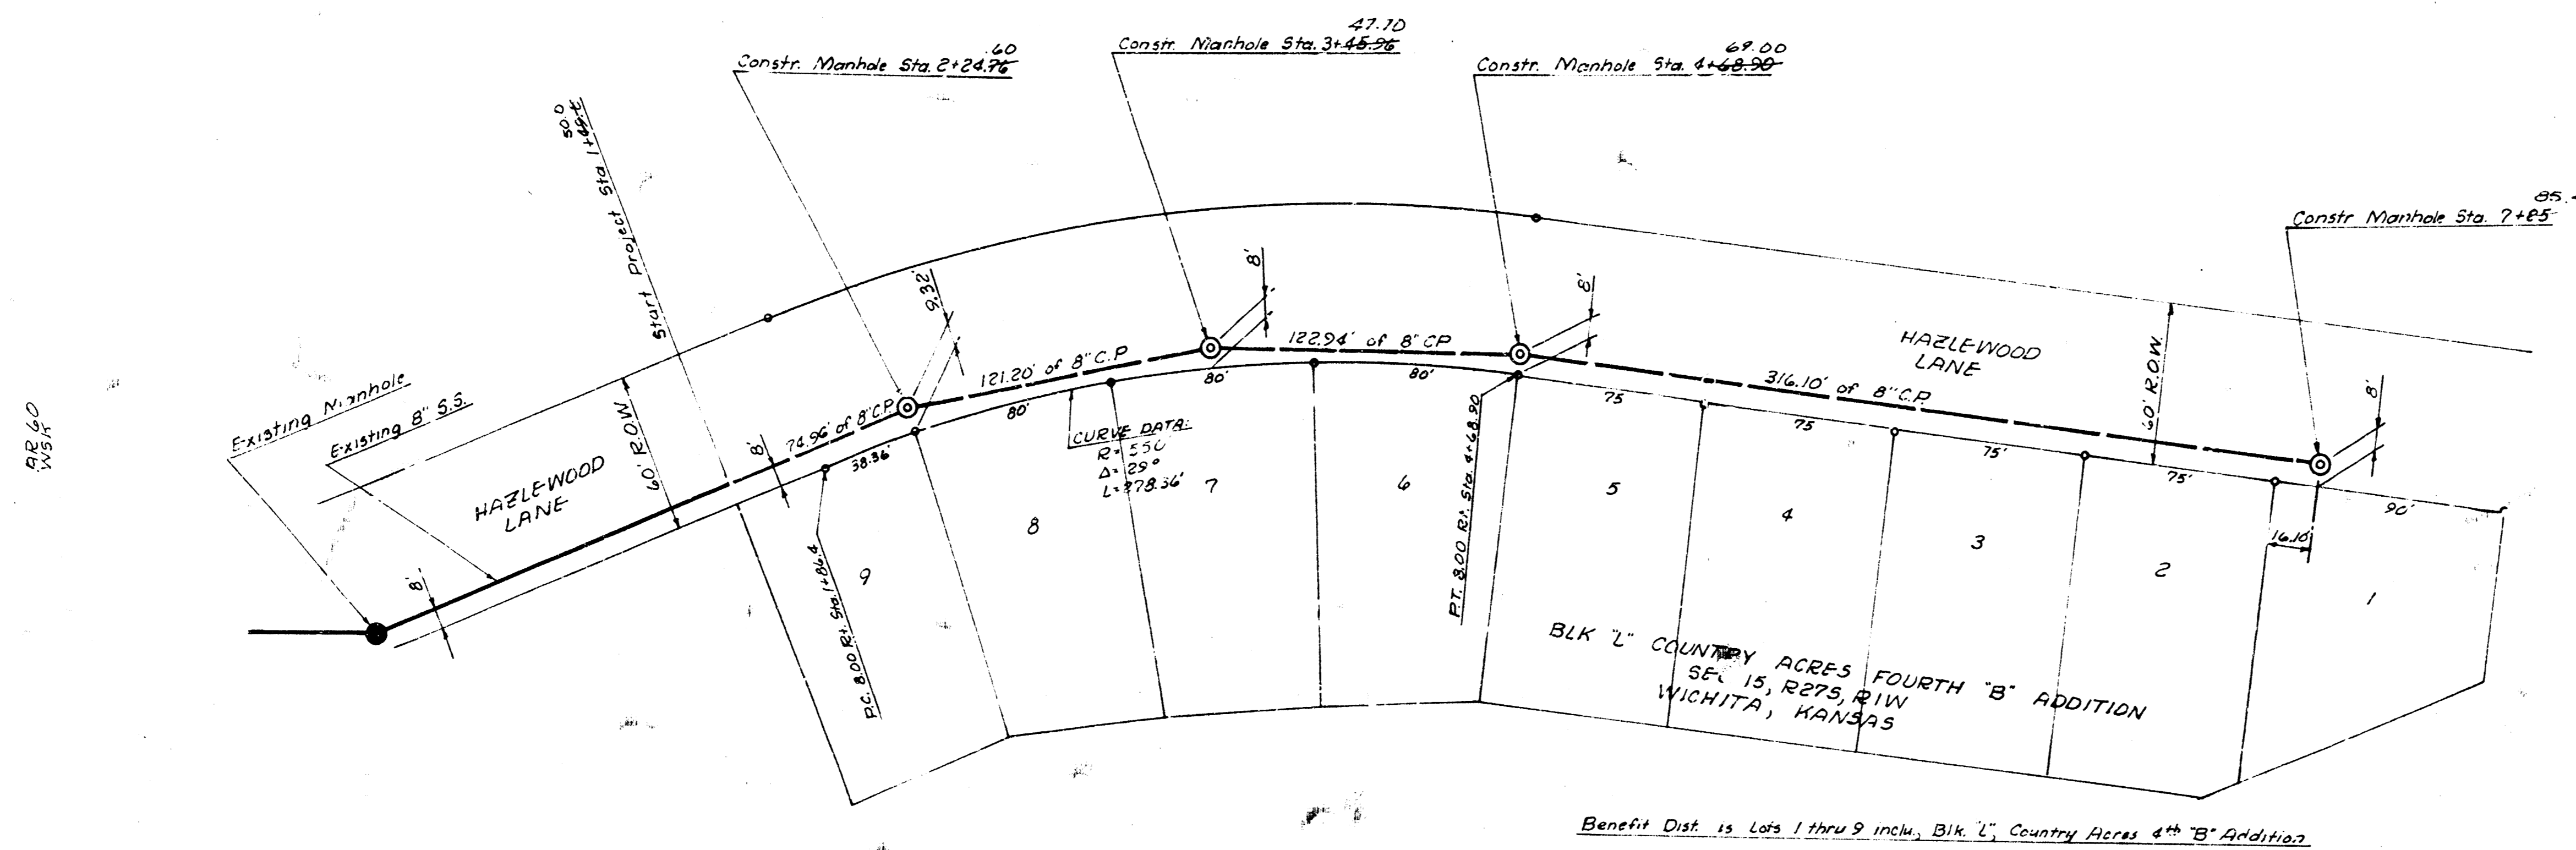


BM 129.91 "N" in Mid Kansas, N. end N.E. Return Sandplum f. School

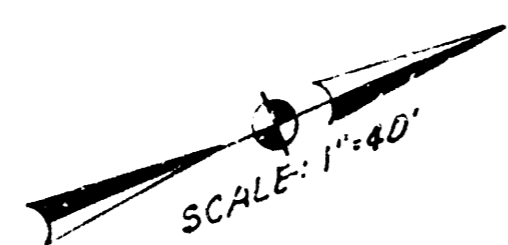

Benefit Dist. is Lots 1 thru 9 incl., Blk. L, Country Acres 4th "B" Addition.

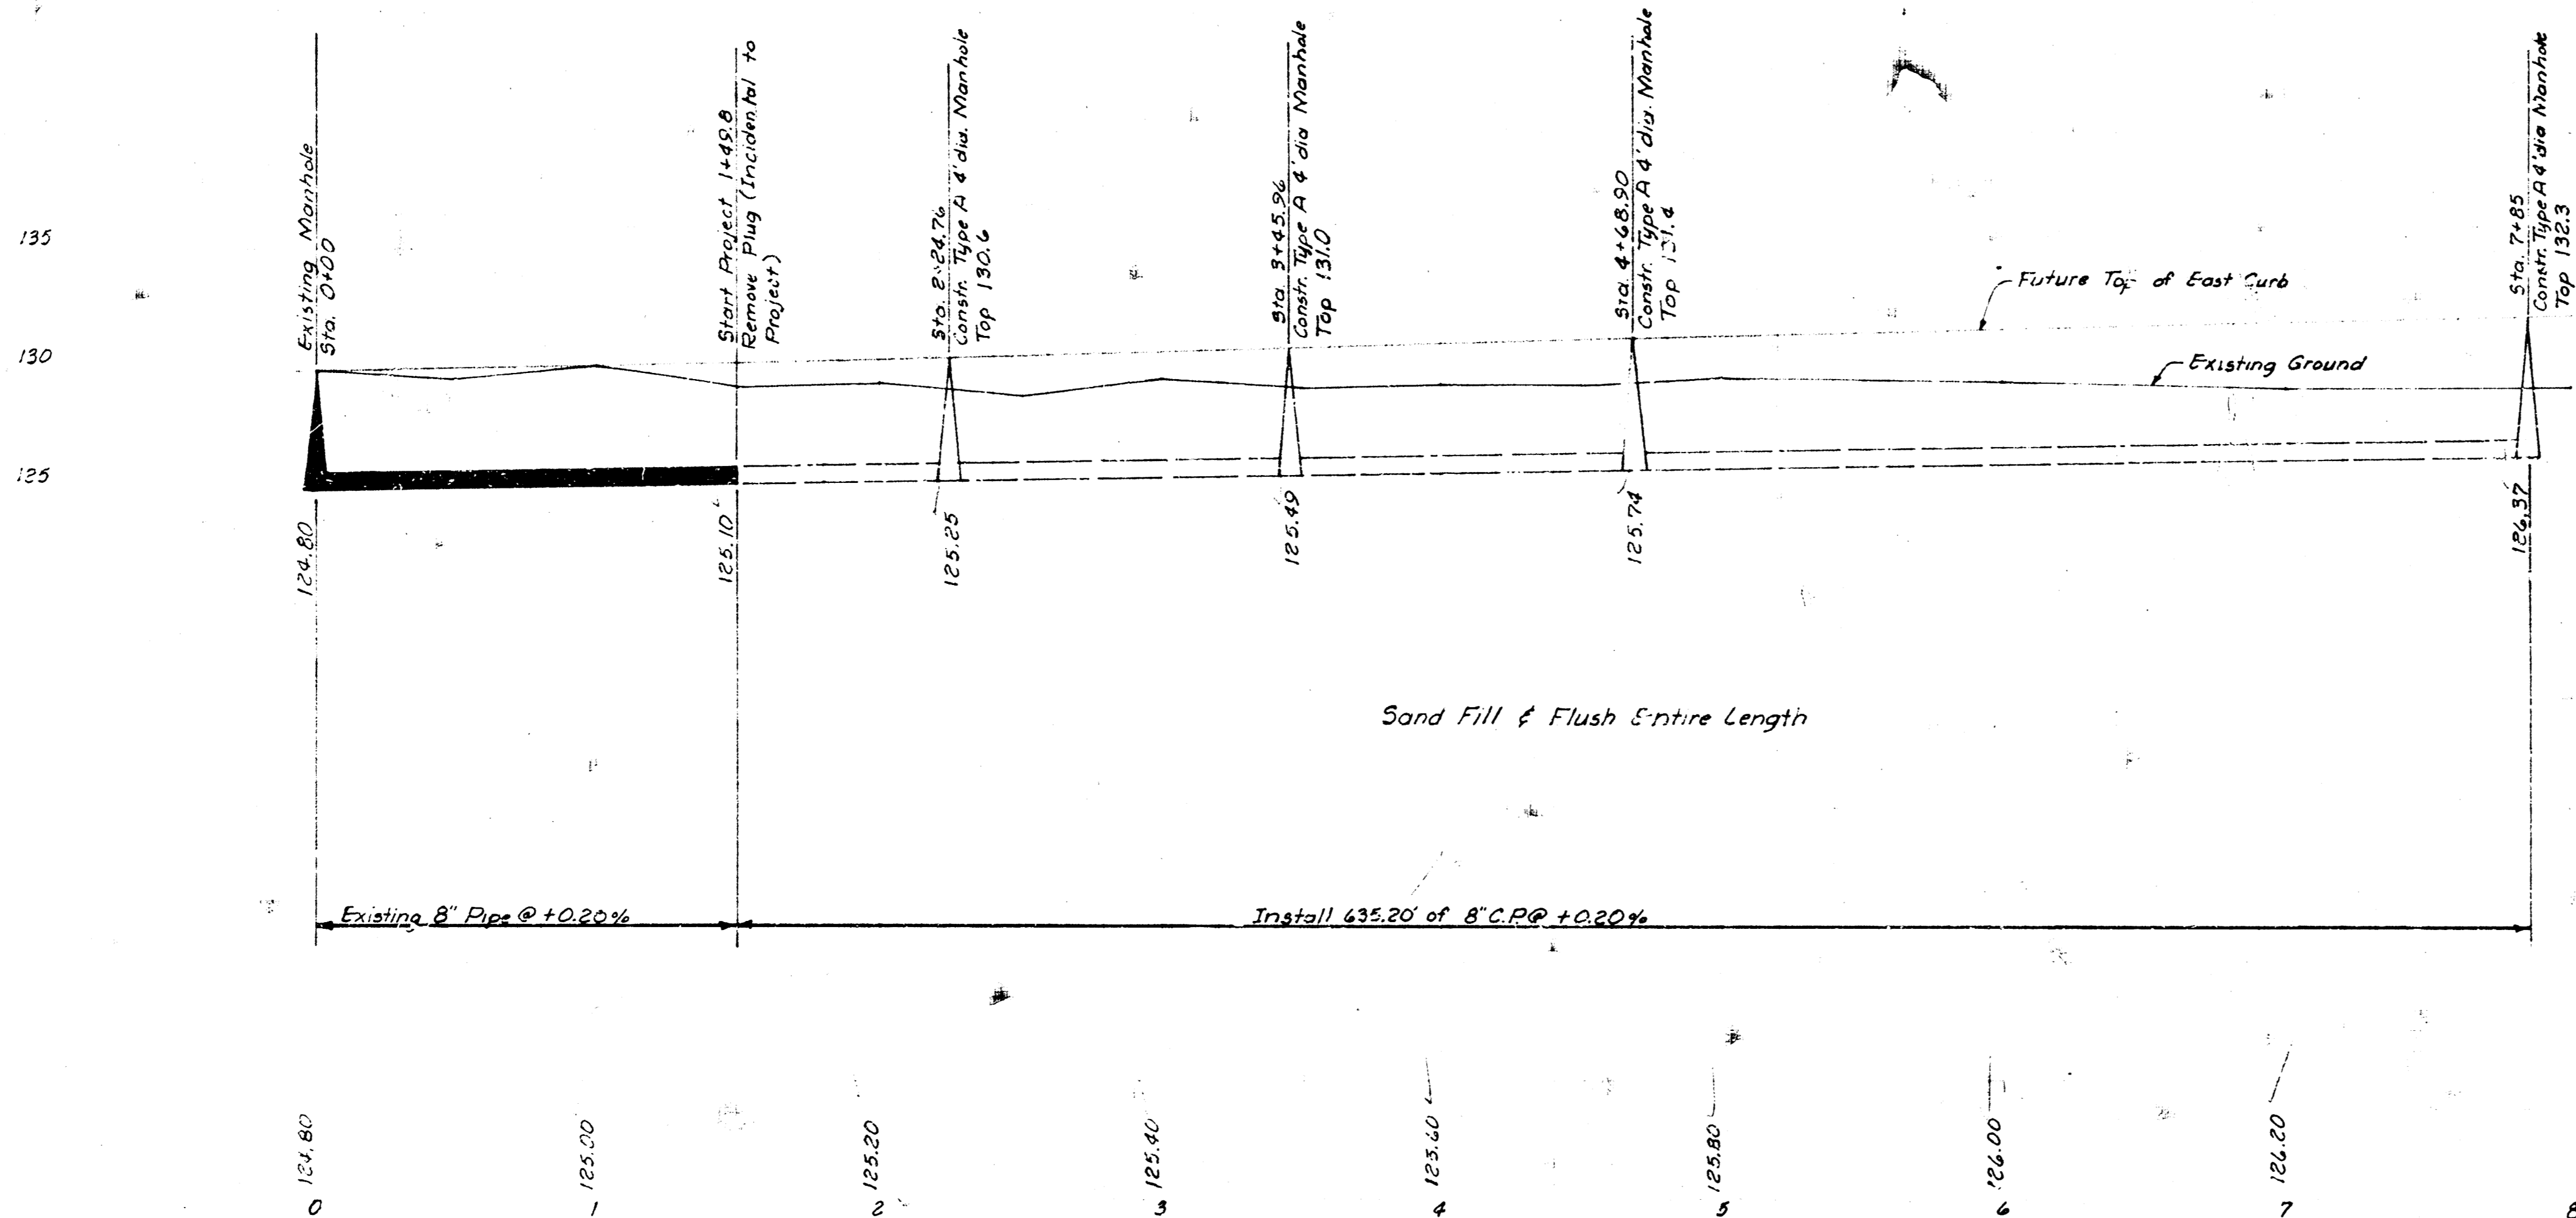

PROFILE SCALE:  
Hor. 1"=40'  
Ver. 1"=5'



FINAL MEAS. "30 B.L.T."  
LAT 61, WESTLINK SEWER  
CITY OF WICHITA, KANSAS  
R. W. LINN, City Engineer  
Project No. DBK 574023  
DATE: \_\_\_\_\_

Sheet 1 of 1

14 0 4 3