


Revised
2/16/05

BK #3

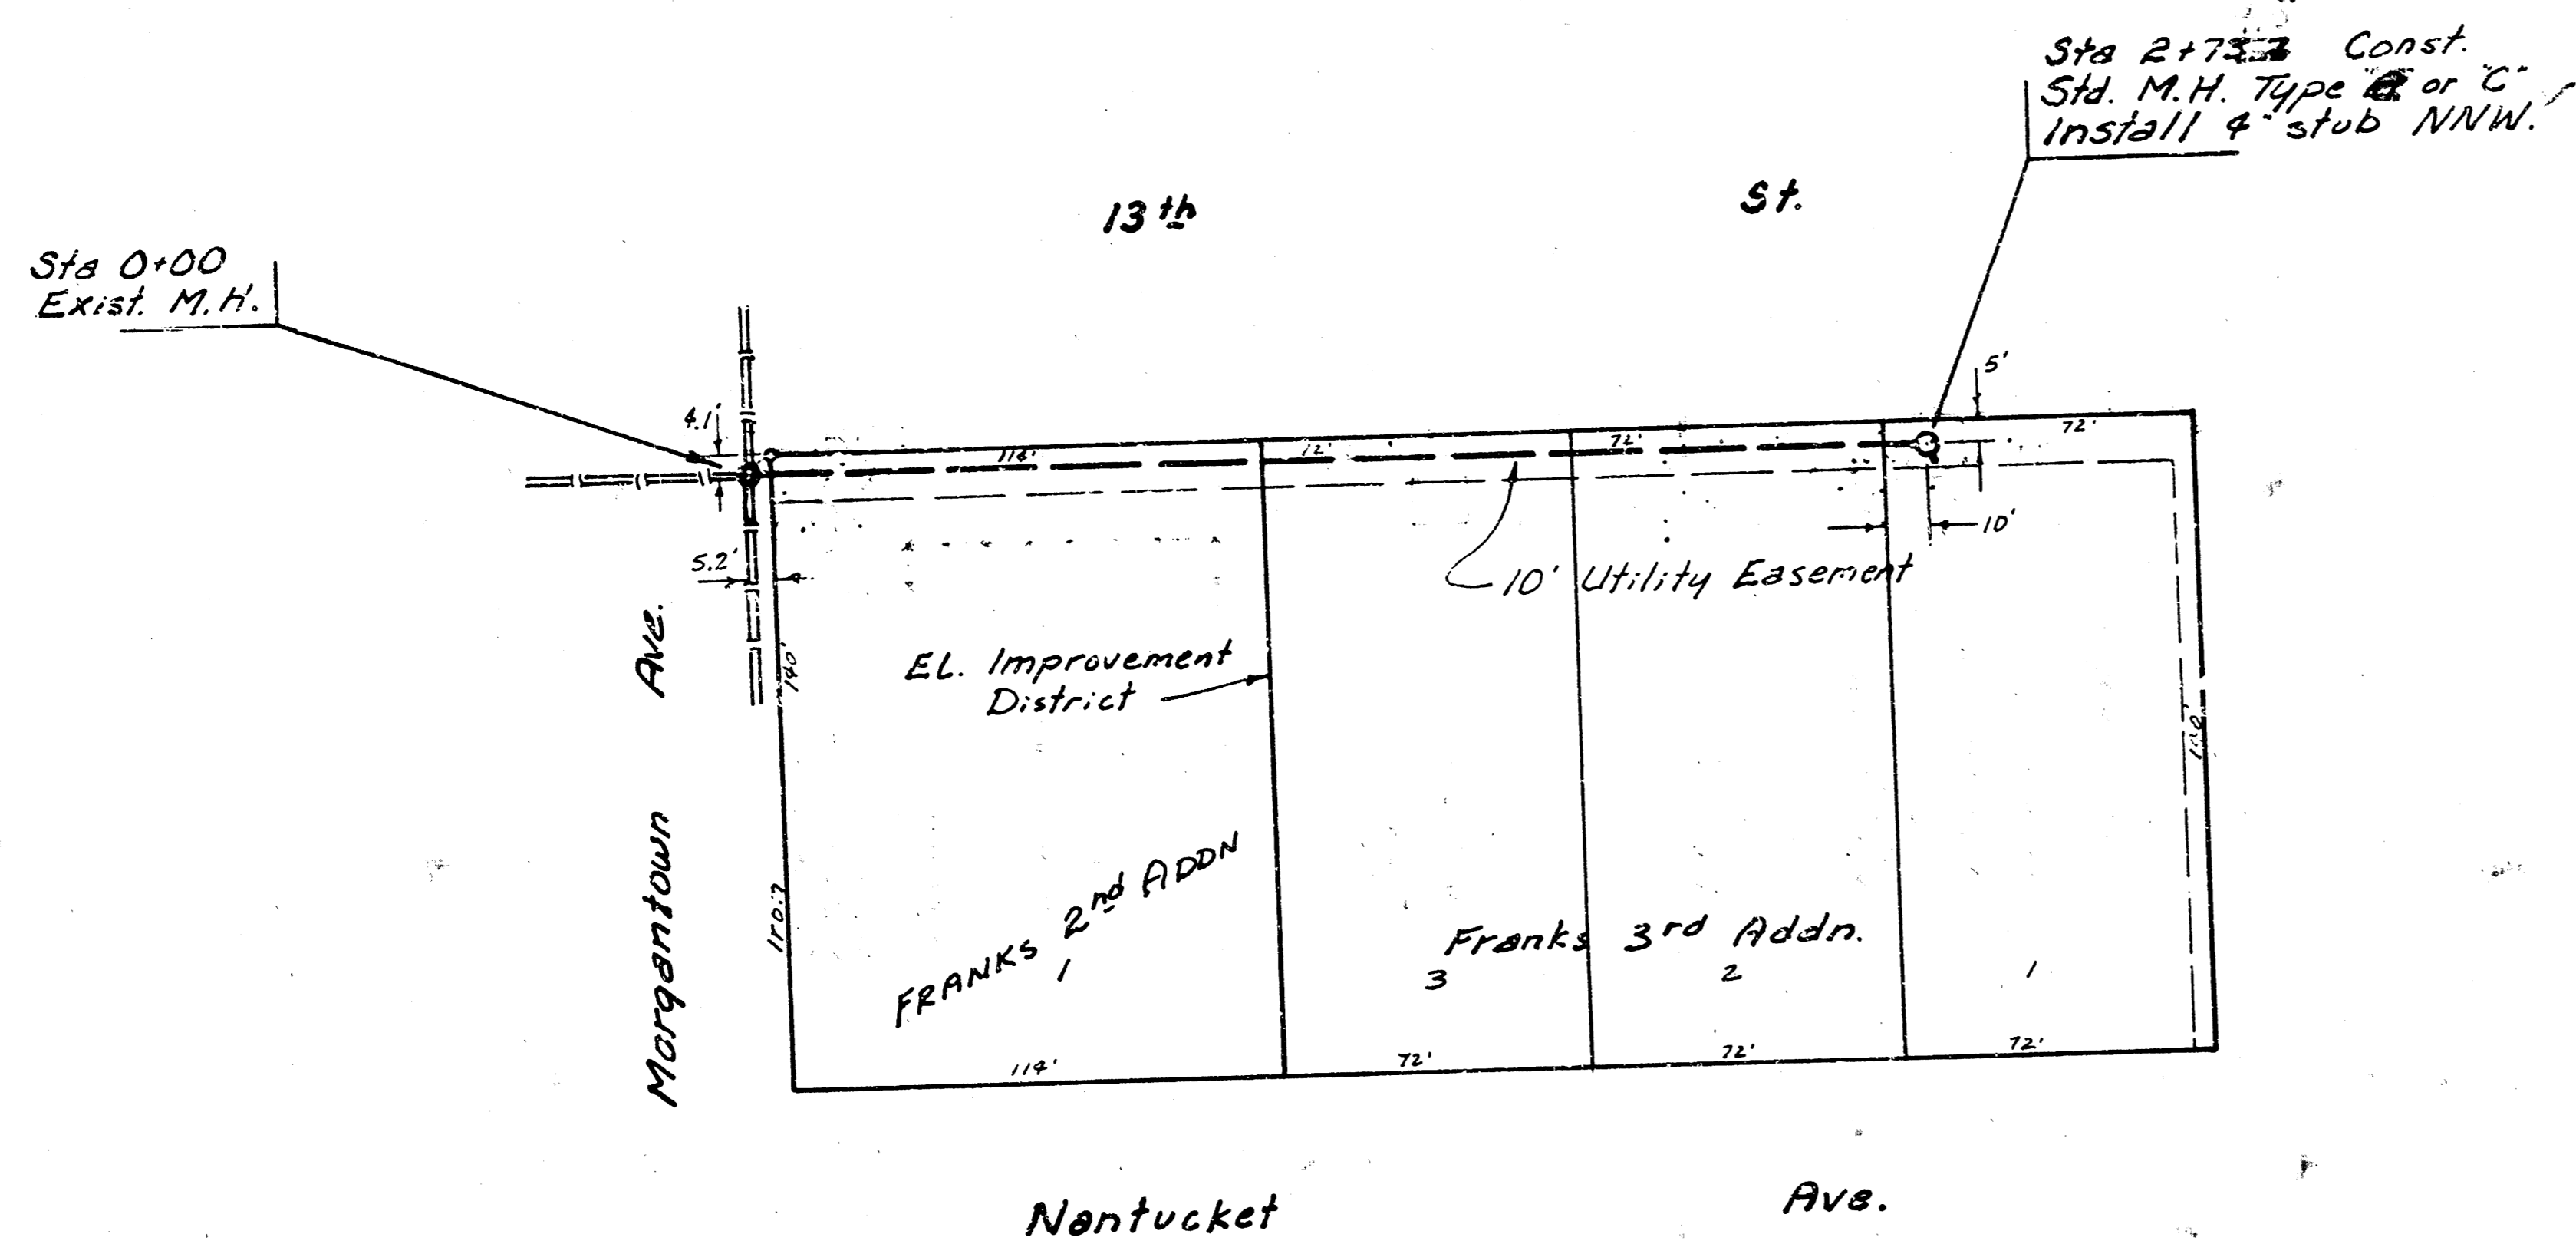




Scale Plan 1" = 40'
 Profile 1" = 40' Horiz.
 1" = 5' Vert.

NOTE: CONTRACTOR SHALL GIVE ALL PROPERTY OWNERS AND/OR TENANTS DIRECTLY AFFECTED BY THE CONSTRUCTION OF THIS PROJECT A MINIMUM ADVANCE NOTICE OF 48 HOURS PRIOR TO STARTING CONSTRUCTION.

B.M. 147.18 "a" cut W end Return @ NW corner of NW Parkway and 13th St.
 B.M. 150.22 "4" at Center of conc. walk E. End 3' S. of NW corner 13th St. & Morgantown.

155
 150
 145
 140

155
 150
 145
 140

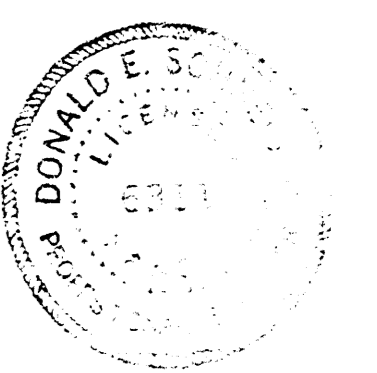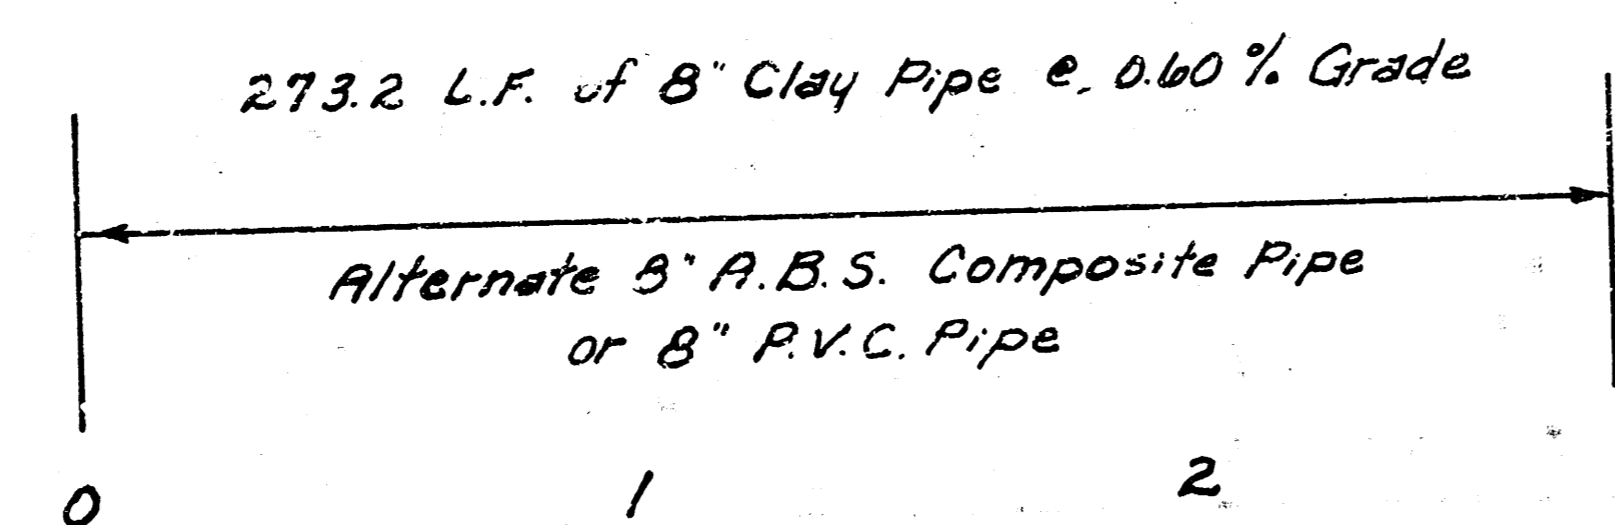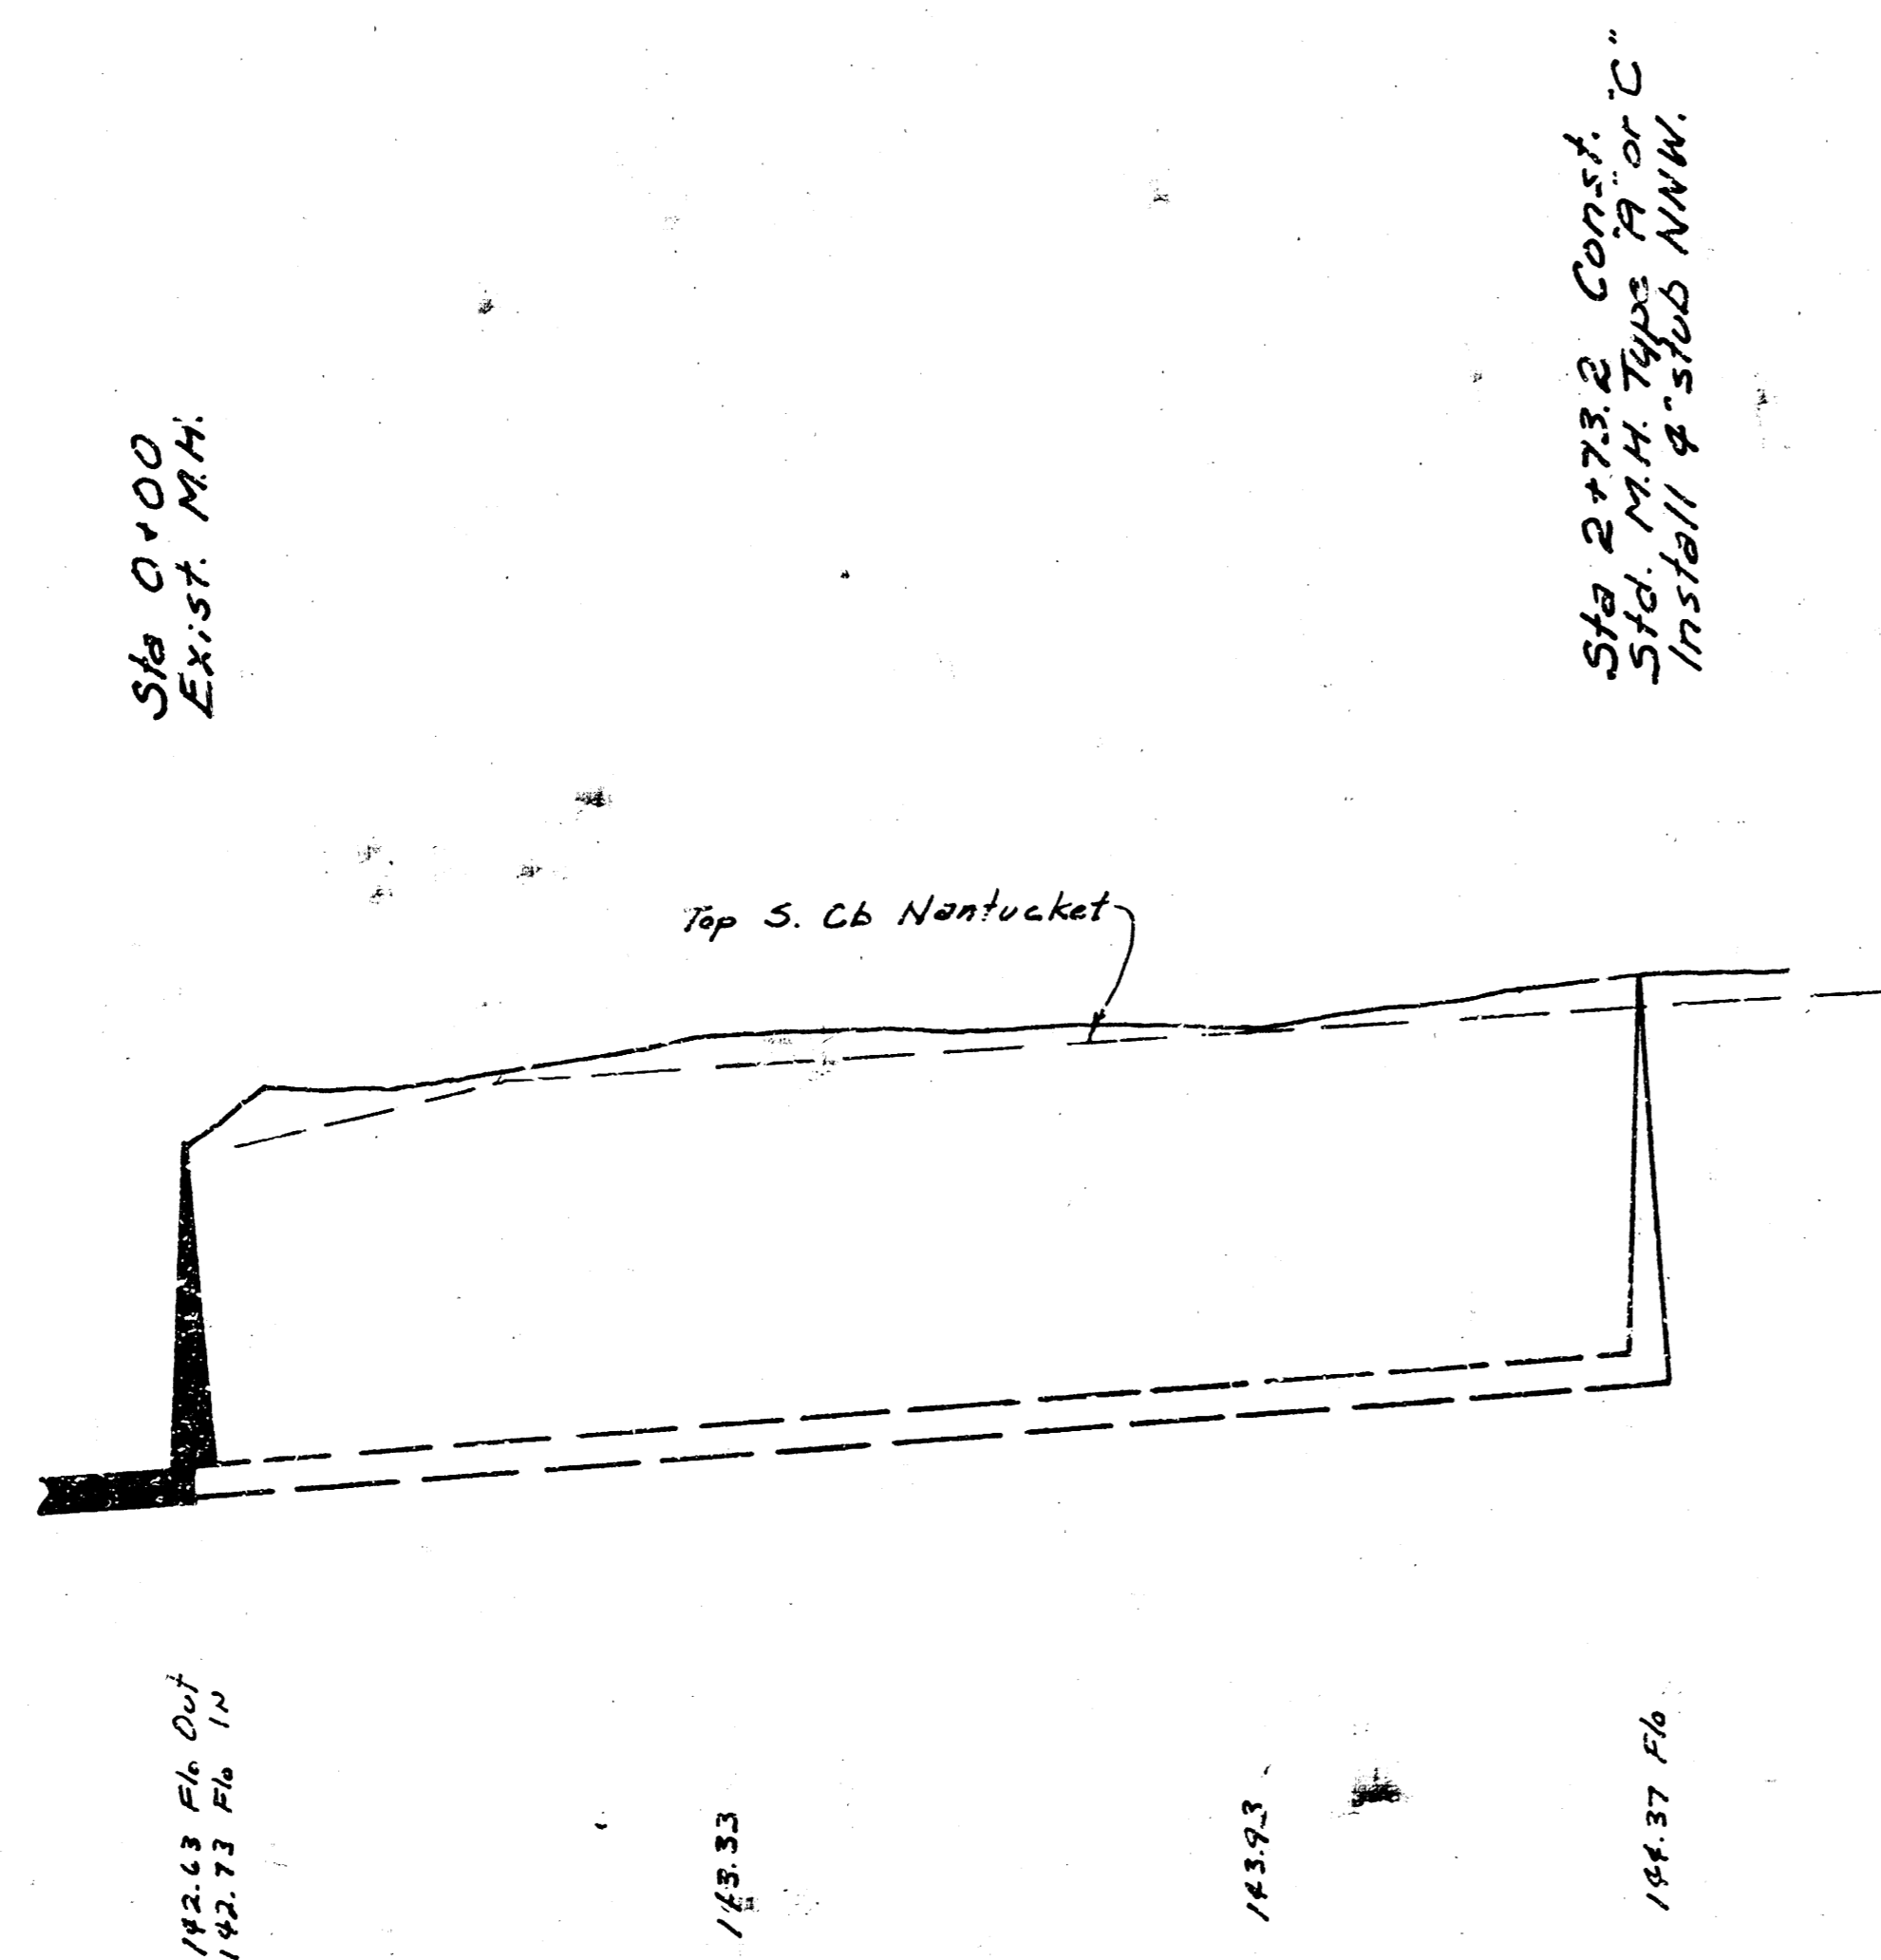

LAT 65, WESTLINK SEWER
 CITY OF WICHITA, KANSAS
 DEAN SELLERS — CITY ENGINEER
 PROJ. NO. 46876245-80867-000-000-001