# LATERAL 87 – WESTLINK INTERCEPTOR

## TO SERVE PART OF LOT 1, TIMBER GROVE LAKES ADDITION

PROJECT NO.

468-76-245-81780-000 000-001

CITY OF WICHITA, KANSAS

MICHAEL E. LINDEBAK CITY ENGINEER

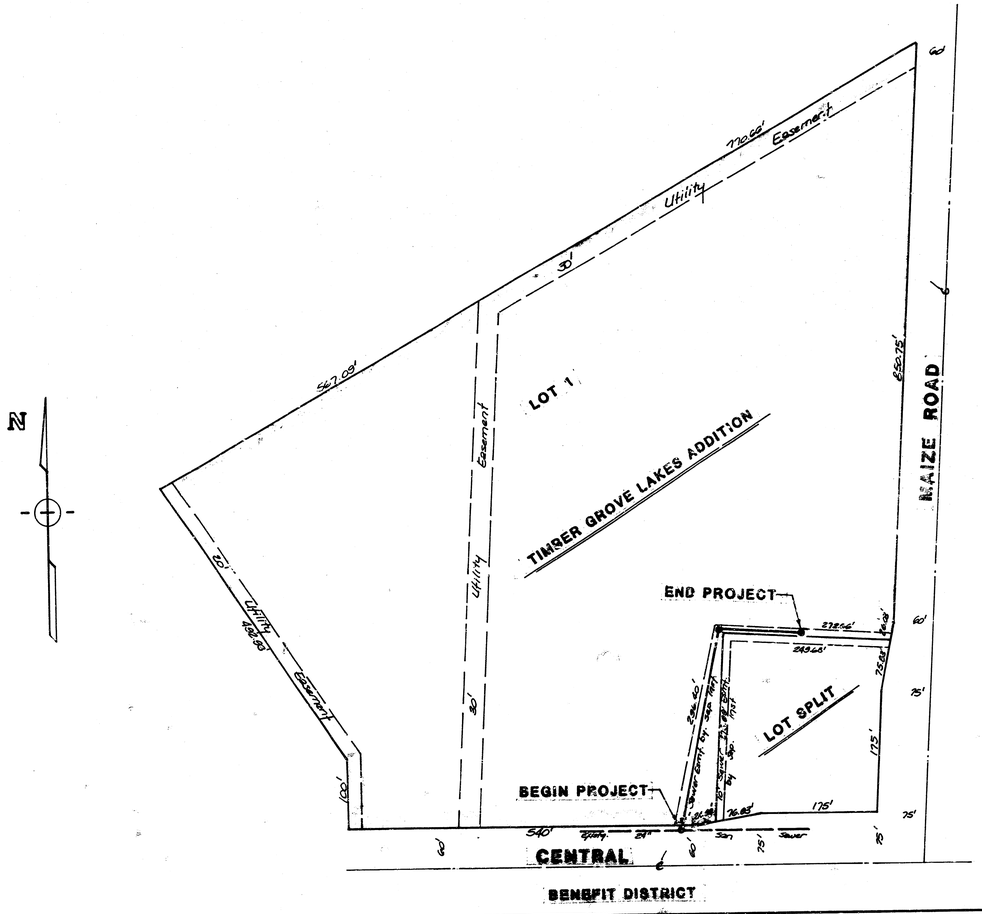


### GENERAL NOTES

1. Underground utility service lines and overhead utility pole lines are to be adjusted as necessary by others prior to construction unless the plans specifically call for their adjustment by the Contractor or unless the plans specifically identify a utility to be adjusted by its owner during construction. Existing utilities and their location, as shown on the plans, represent the best information obtainable for design. The Contractor will be required to work around existing utilities within the right-of-way which do not conflict with proposed construction.

2. The Contractor shall be responsible for maintaining continuous flow of sewage through construction. Contractor's proposed method for maintaining sewage flow shall be approved by the Engineer. Cost of maintaining flow of sewage through construction will not be paid for directly and this cost shall be considered as subsidiary to the other pay items of work.

3. The Contractor shall be responsible for preserving property irons. The Contractor will be required to re-establish any property irons which are damaged or destroyed by his construction operations. Such irons shall be re-established by a licensed land surveyor or a licensed professional engineer in accordance with state laws.

AS BUILT
12-88
RDL

M. BRENT WOOTEN LICENSED 8470 KANSAS PROFESSIONAL ENGINEER

BAUGHMAN COMPANY P. A.
SURVEYING & ENGINEERING
316/262-7271 • 315 ELLIS • WICHITA, KANSAS 67211

SC 5'89

Station 0+00 Connect to Existing Manhole. Remove and replace Concrete Walk as necessary for 20'S'ly.

Bench Mark S. Rim MH. 142.07

LOT 1 ADDITION

LAKES

TIMBER GROVE

Sewer Easement split by Lot Line

Iron

20.4'

5'

4'

60' R/W

CENTRAL AVE.

75' R/W

Existing 24" S.S.

Existing Pavement

Existing Storm Sewer

24" Storm Sewer

16.99'

Iron

Iron

Iron