

Sanitary Sewer Extensions To Serve

BERLIN ADDITION

LATERAL 28 - MAIN 1 - WESTLINK SEWER

Project No.

468-76-245-82162-000-000-001


City of Wichita, Kansas - Michael E. Lindebak, City Engineer

740993

Index

1. Title Sheet
2. Line 1 and Line 2

Scale: 1" = 50'

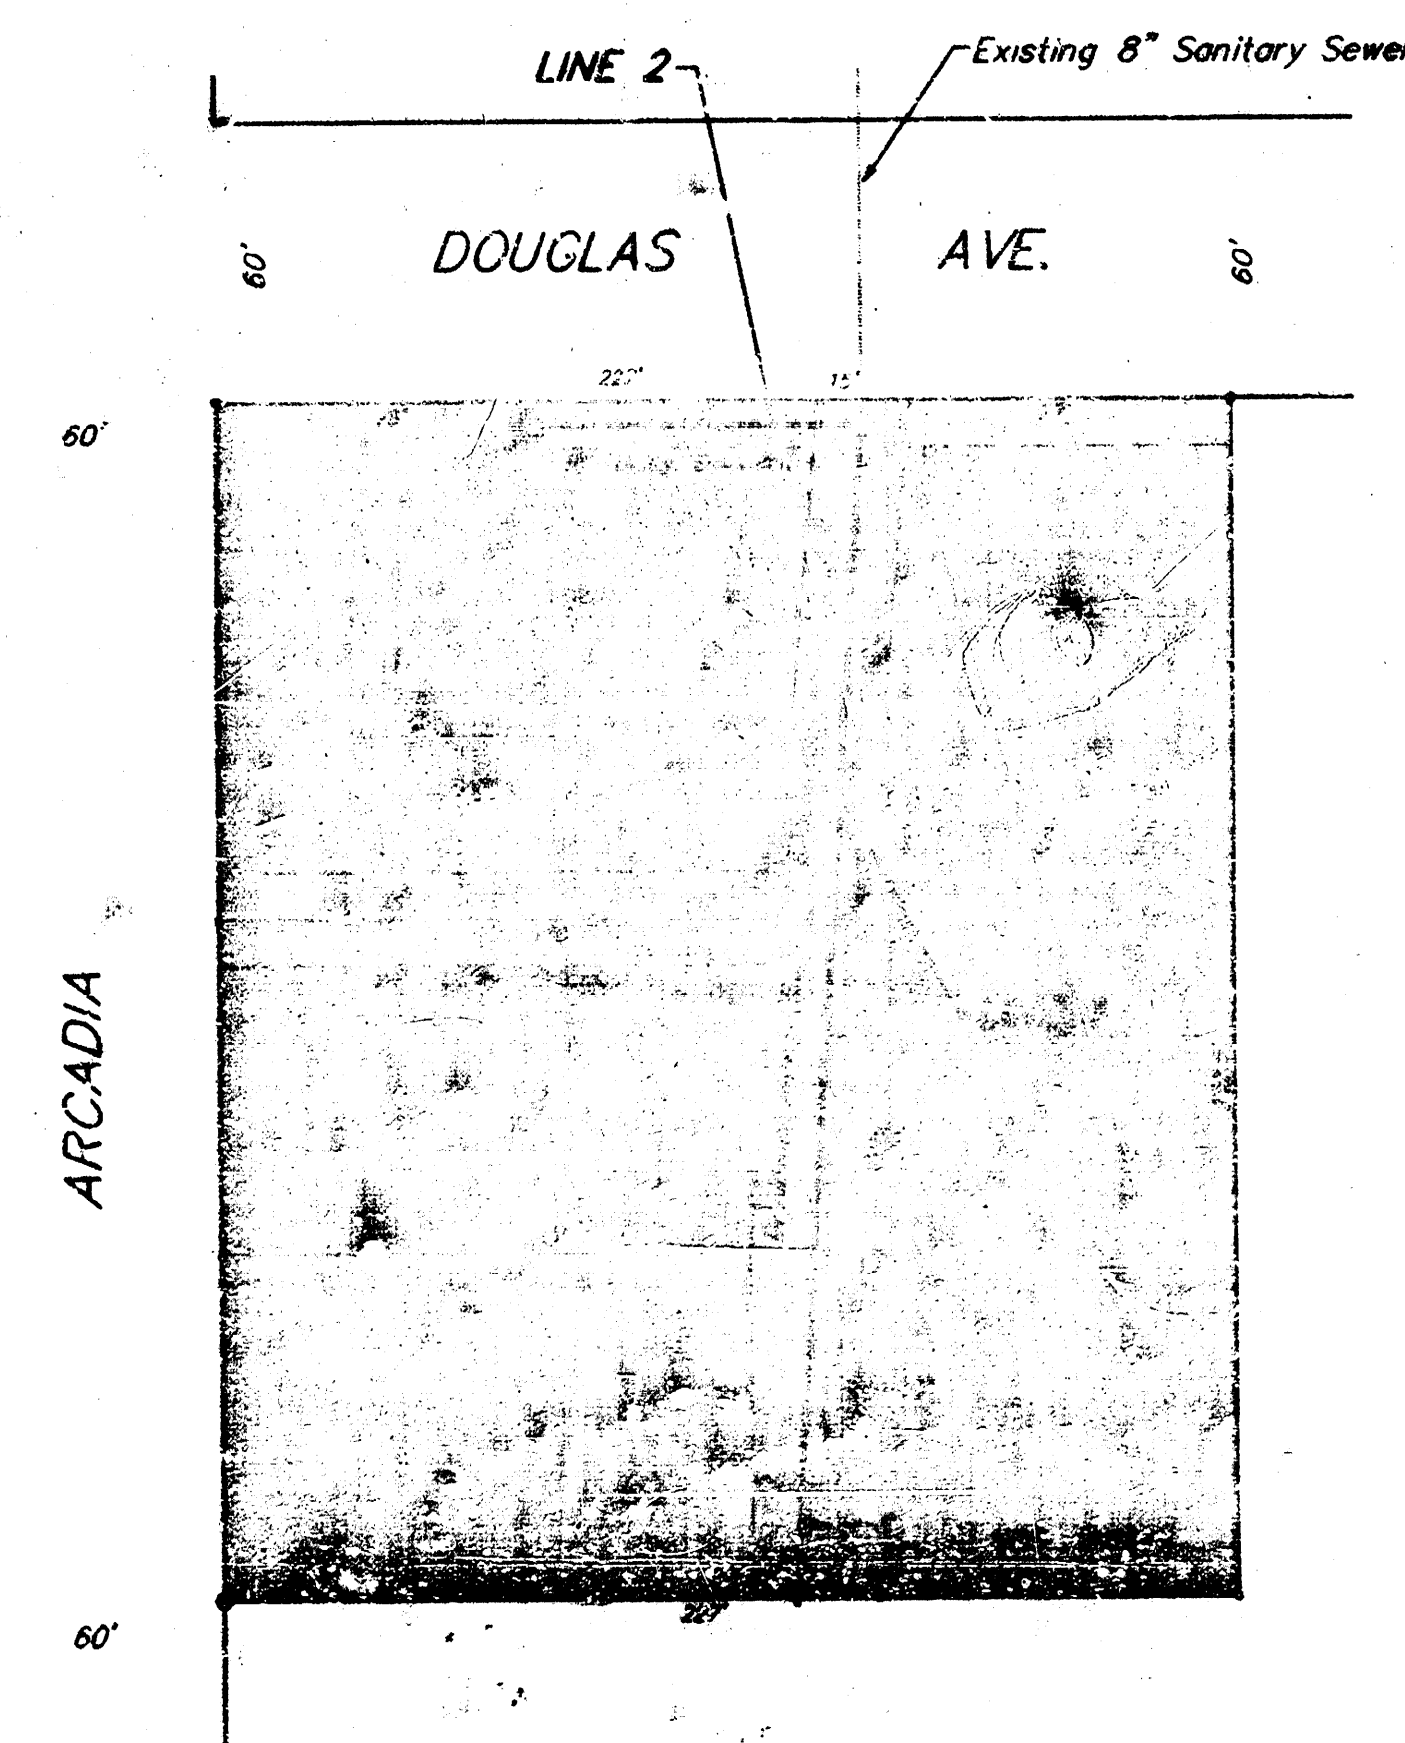

Benefit District

General Notes

1. Underground utility service lines and overhead utility lines are to be adjusted as necessary by others prior to construction unless the plans specifically call for their adjustment by the Contractor or unless the plans specifically identify a utility to be adjusted by its owner during construction. Existing utilities and their location, as shown on the plans, represent the best information obtainable for design. The Contractor will be required to work around existing utilities within the right-of-way which do not conflict with proposed construction.
2. The Contractor shall be responsible for preserving property irons. The Contractor will be required to re-establish any property irons which are damaged or destroyed by his construction operations. Such irons shall be re-established by a licensed land surveyor in accordance with state laws.



Built
PER PLAN
RDL 5-92


February, 1992

BAUGHMAN COMPANY P. A.
ENGINEERING & SURVEYING
316/262-7271 • 315 ELLIS • WICHITA, KANSAS 67211

Station 0+74.8 Line 2 - Construct Standard Manhole, Type P.C. or D Top Elevation = 145.00 4" Stub Southwest


Station 0+00 Line 1 And Existing Manhole

Bench Mark 144.00 City Datum

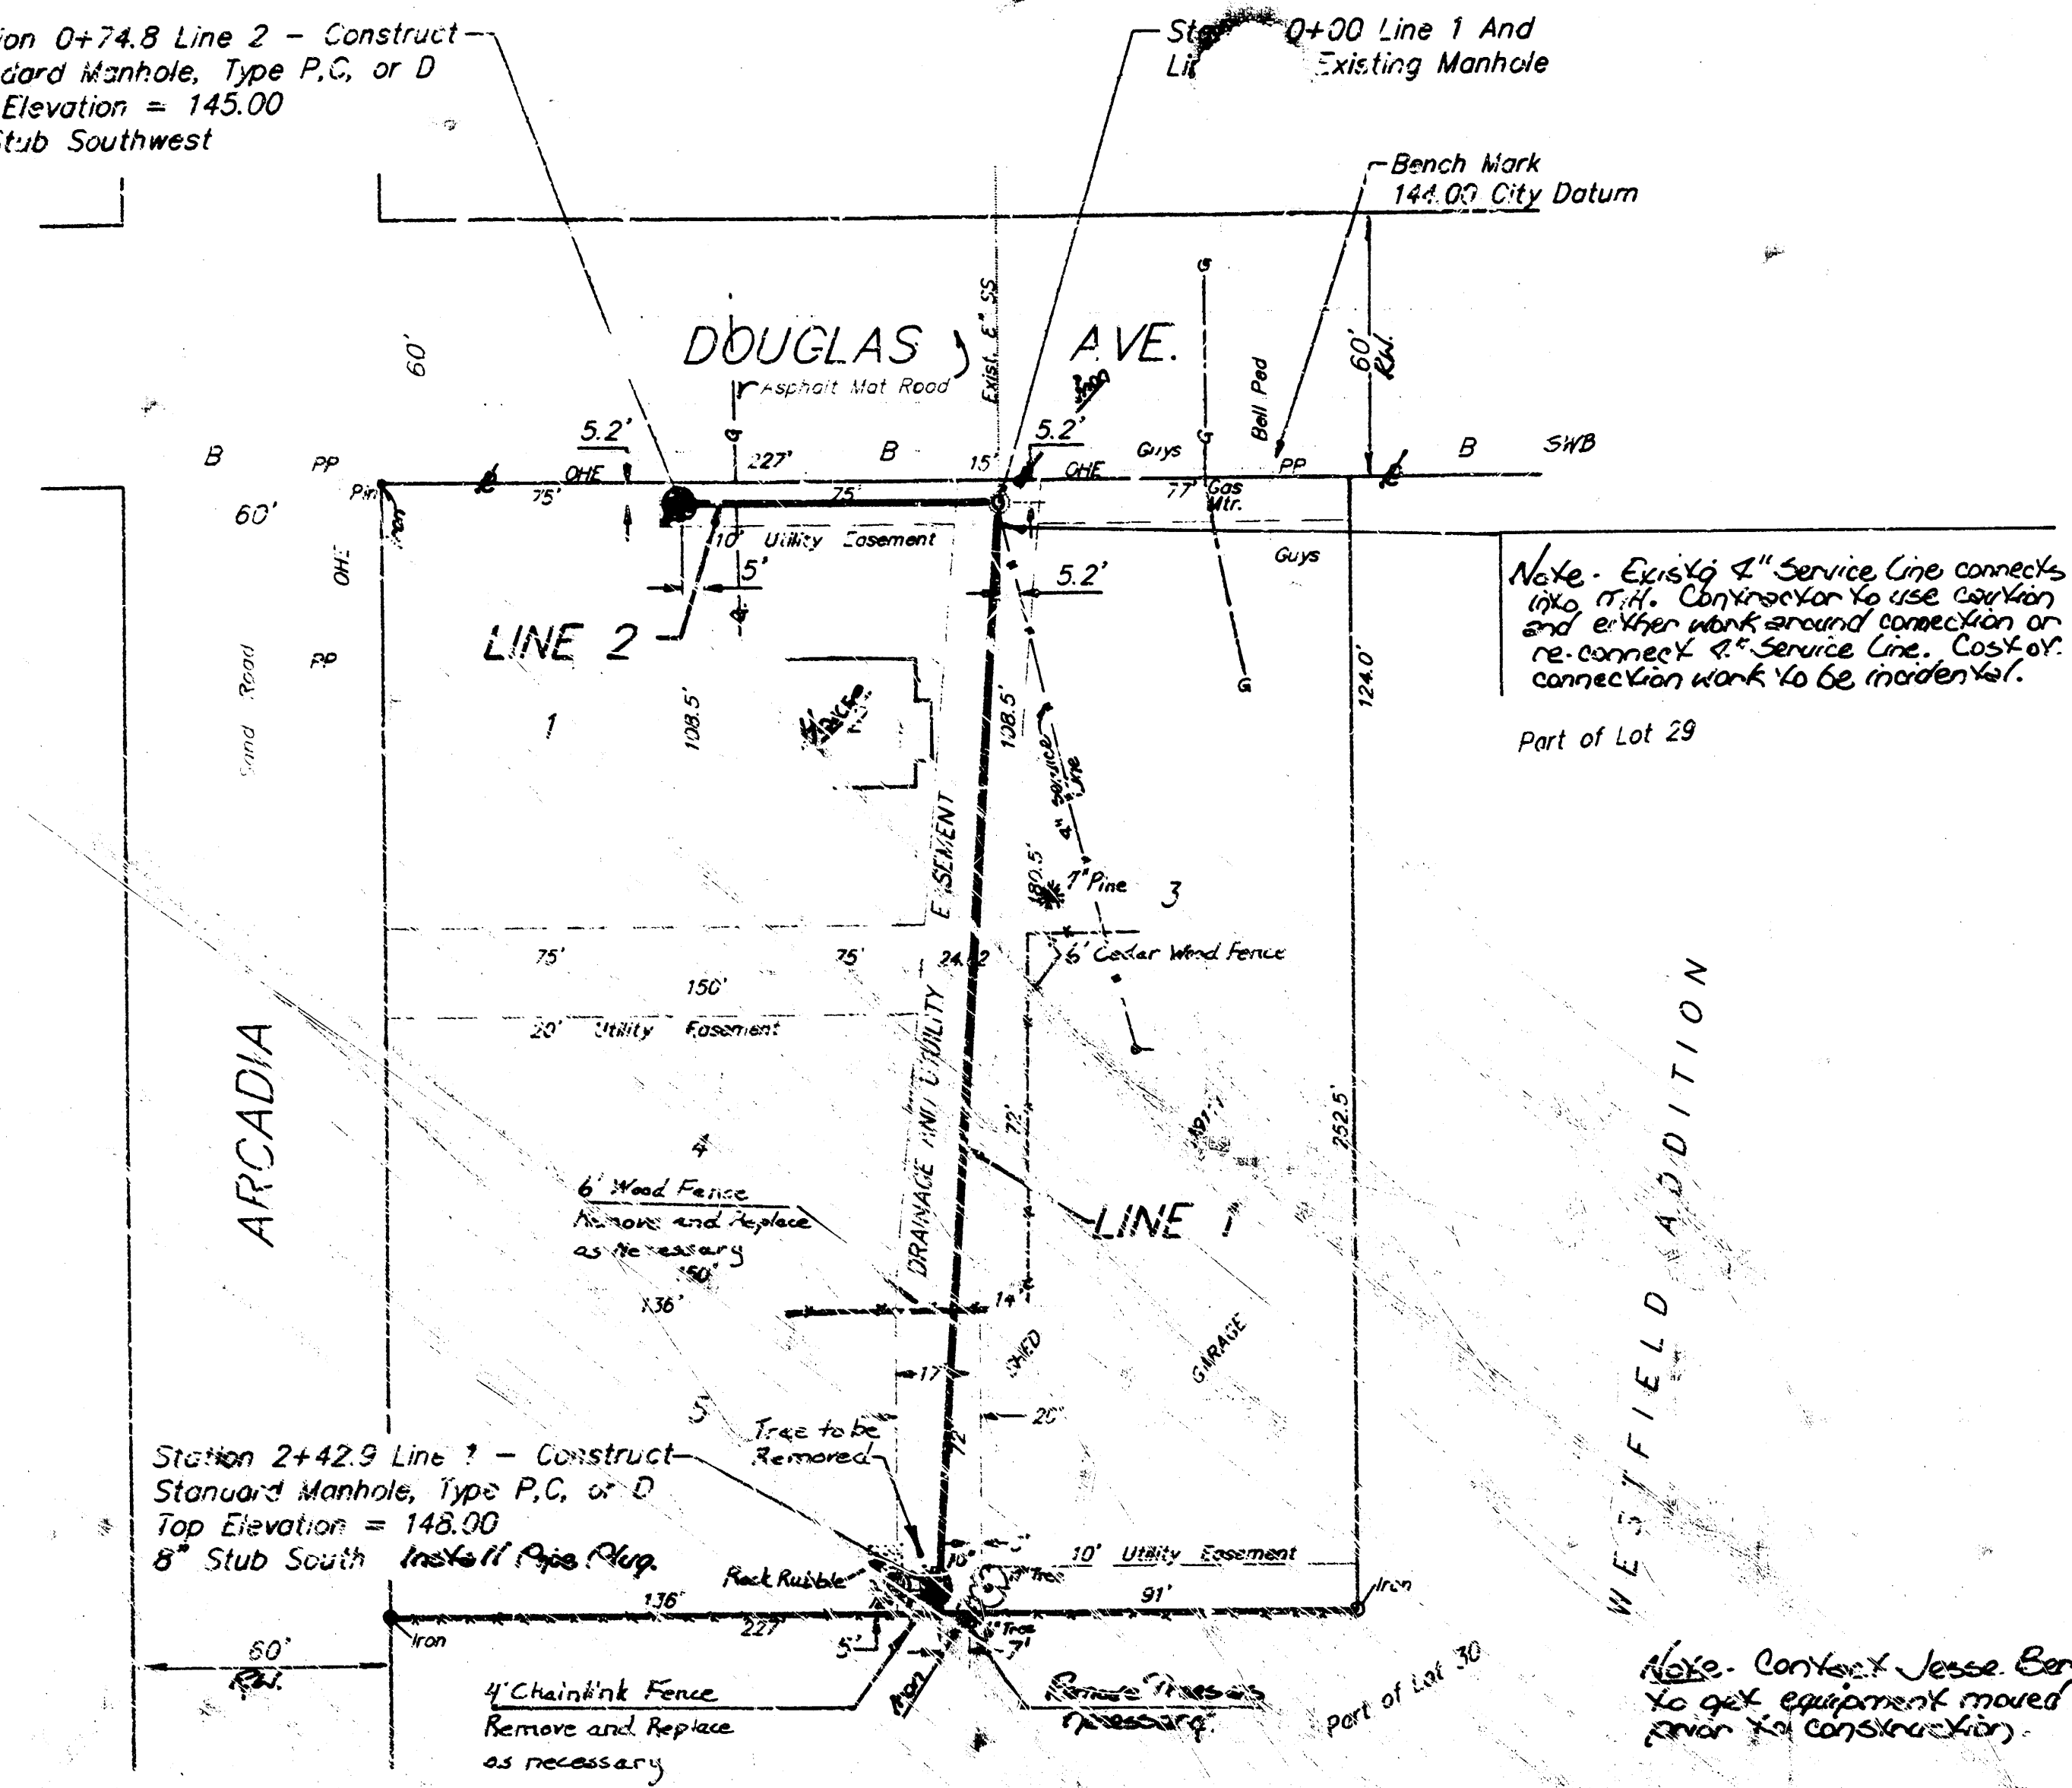

Scale: 1" = 40' Plan
1" = 5' Profile
● = Iron

Bench Mark: R.R. Spike In North Face of Power Pole Located 208 Feet East of Northwest Property Corner of Lot 1, Berlin Addition, Elevation = 144.00 City Datum

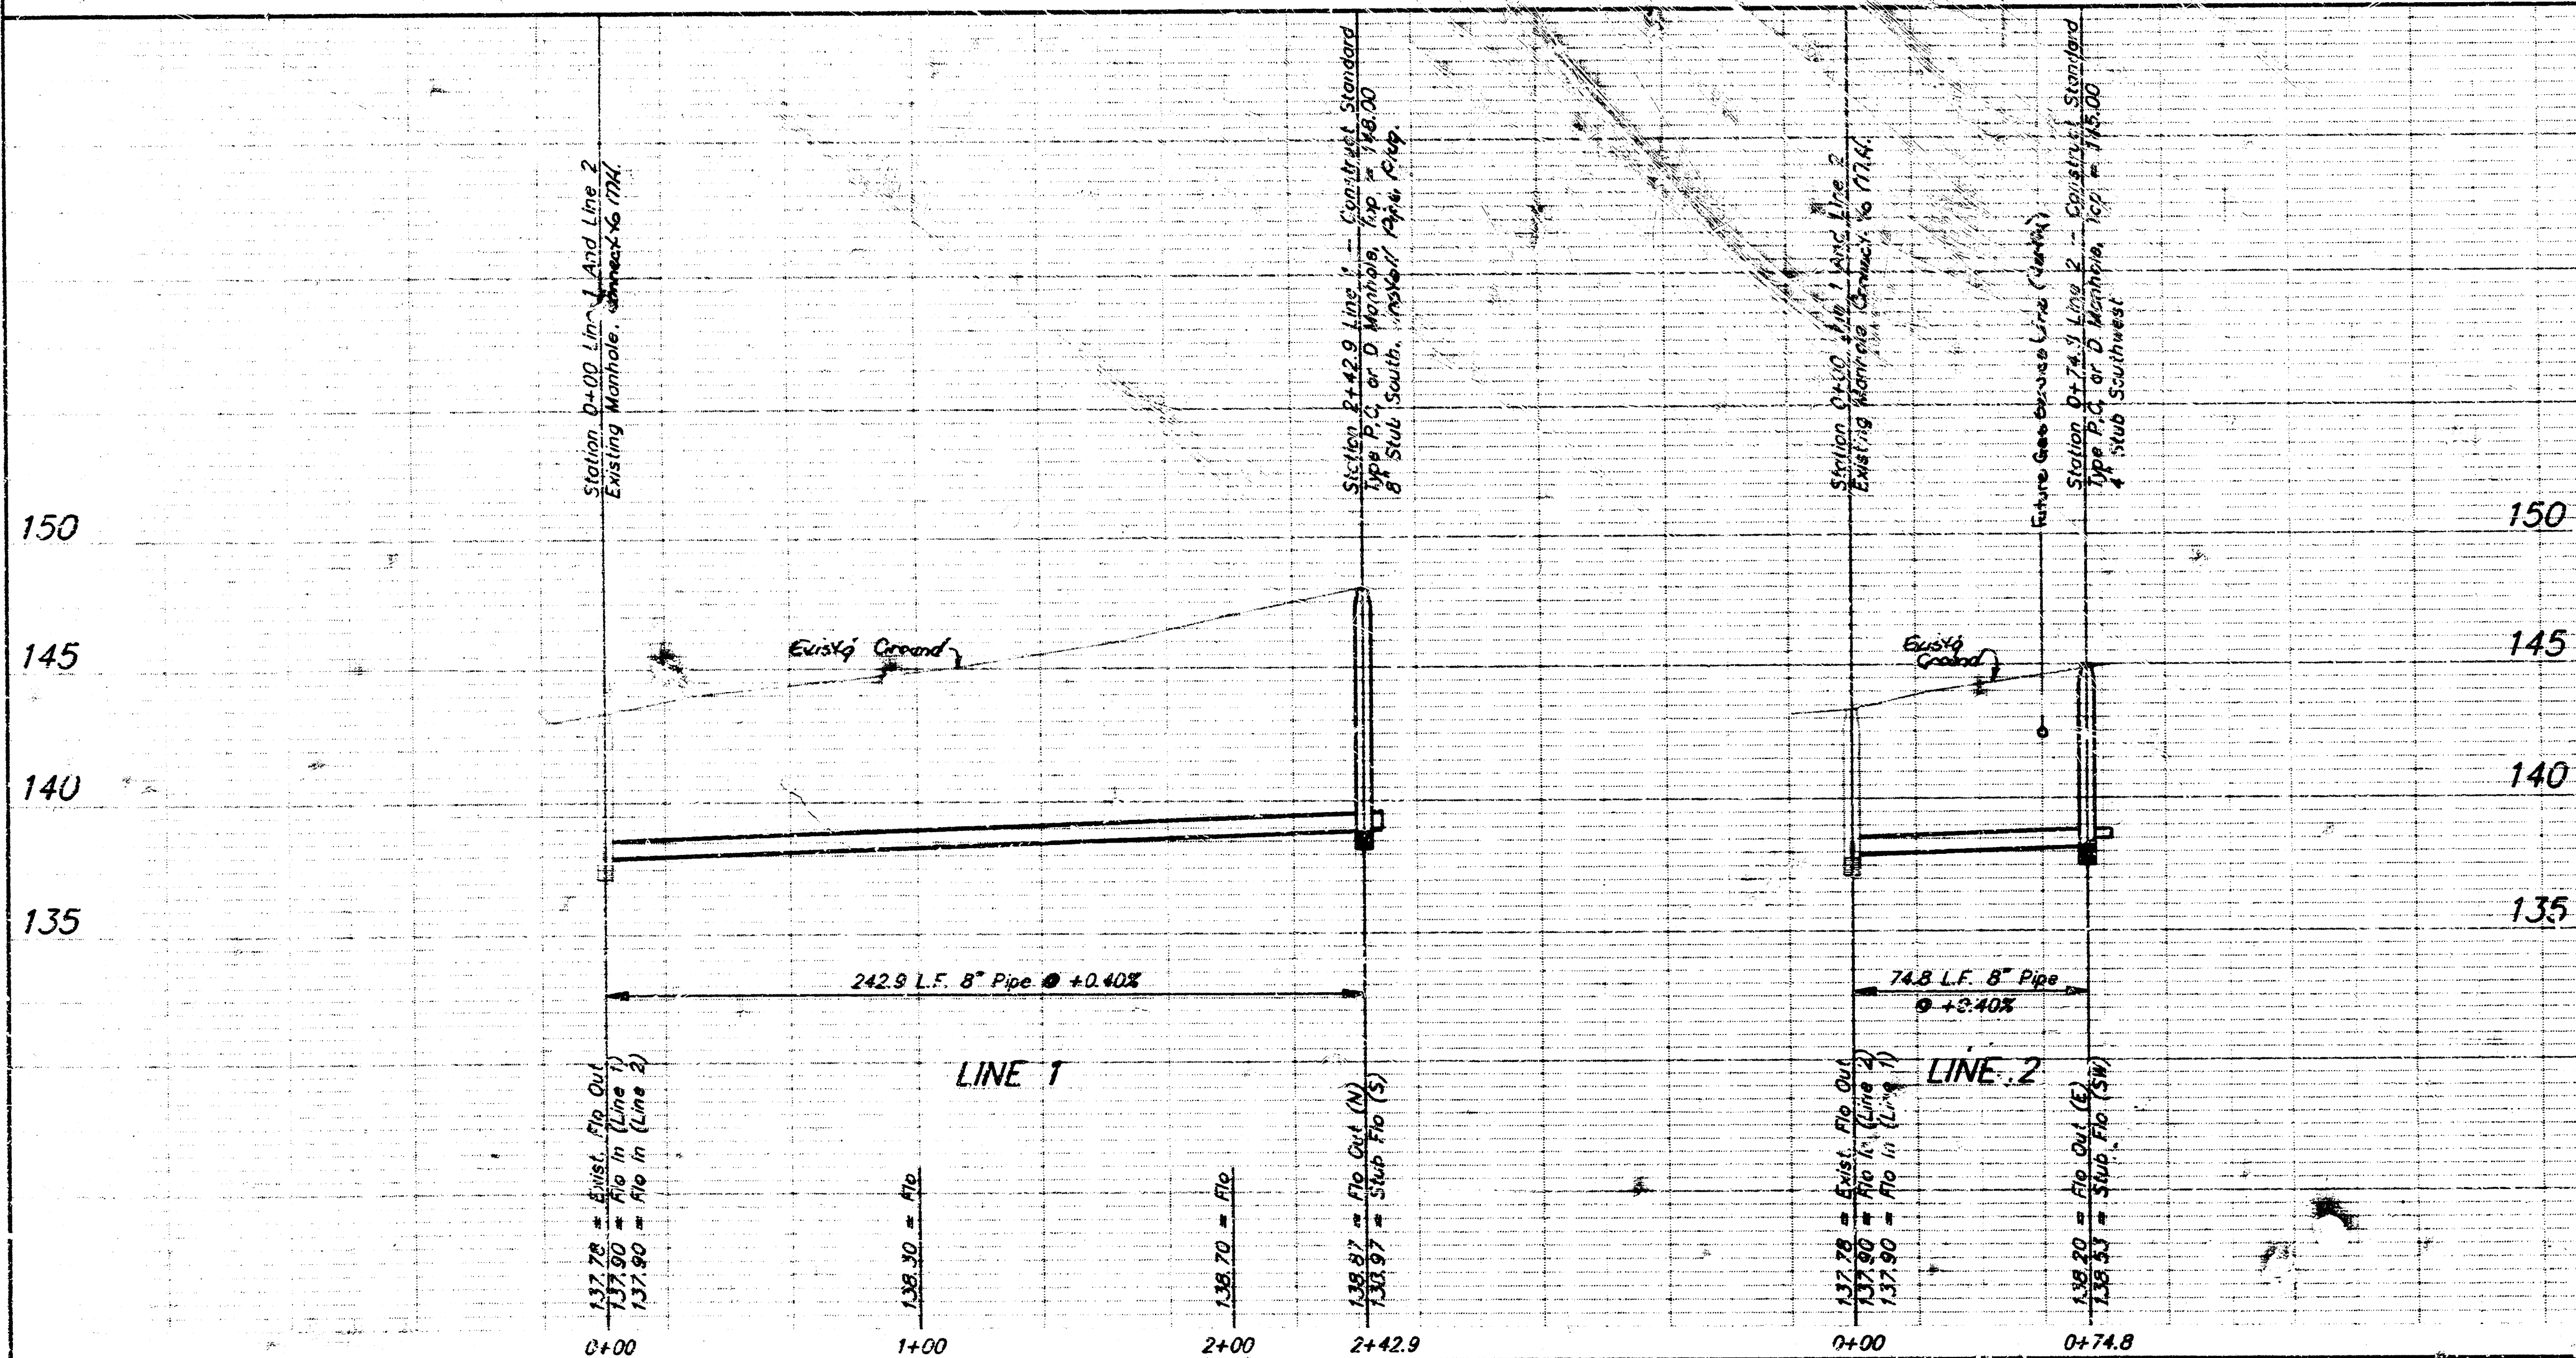

LATERAL 28 - MAIN 1 - WESTLINK SEWER TO SERVE BERLIN ADDITION				
BAUGHMAN COMPANY P. A. ENGINEERING & SURVEYING 316/282-7271 • 315 ELLIS • WICHITA, KANSAS 67211				REV.
PROJECT NUMBER 468-76-245-82162-UOC-C00-001				SHEET 2
DESIGN C. Bohm	DRAWN C. Bohm	APPROVED [Signature]	DATE Feb. 20, 1992	SCALE Noted