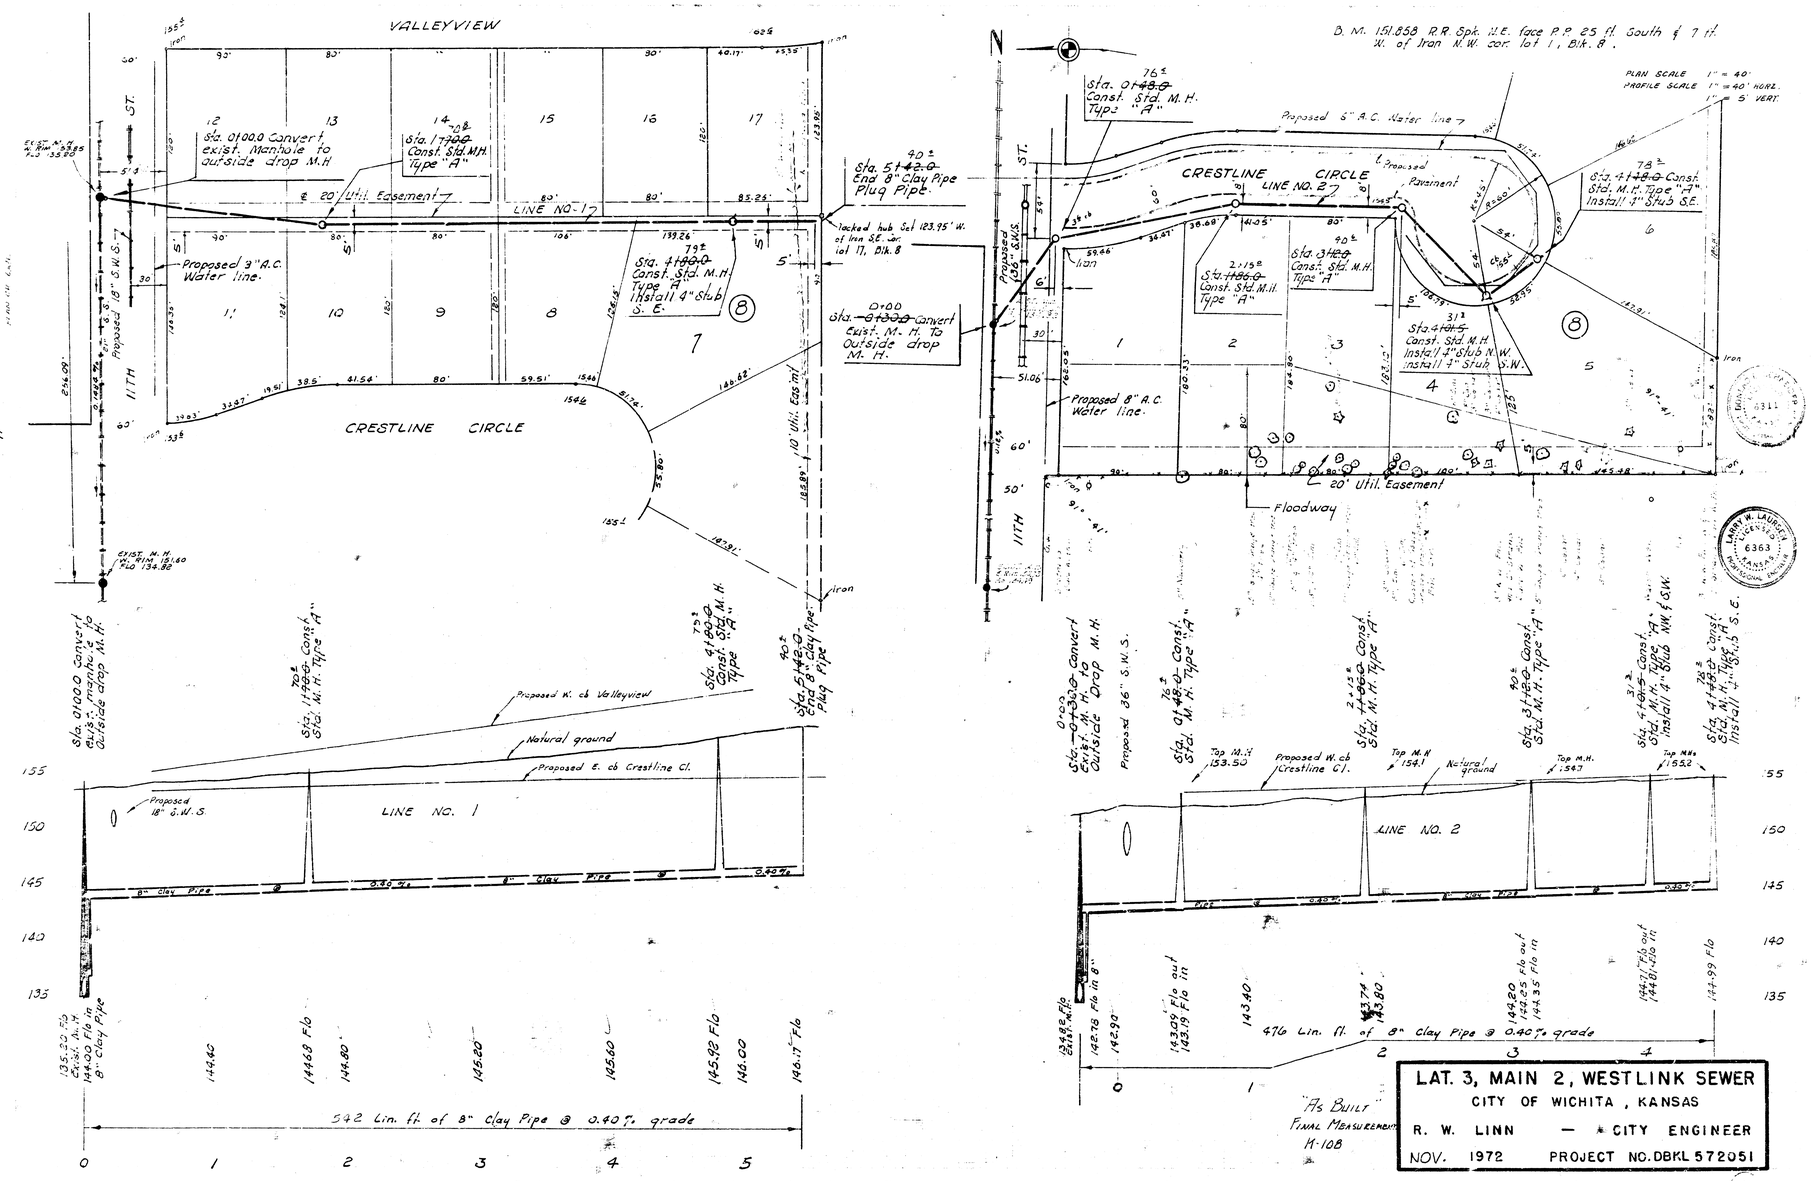
VALLEYVIEW
CRESTLINE CIRCLE
LINE NO. 1
LINE NO. 2
11TH ST.
Proposed 18" S.W.S.
Proposed 3" A.C. Water line.
Proposed 8" A.C. Water line.
Proposed 8" A.C. Water line
20' Util. Easement
Floodway
Proposed W. cb Valleyview
Natural ground
Proposed E. cb Crestline Cl.
Proposed W. cb Crestline Cl.
542 Lin. ft. of 8" Clay Pipe @ 0.40% grade
476 Lin. ft. of 8" Clay Pipe @ 0.40% grade
B. M. 151.858 R.R. Spk. N.E. face P.P. 25 ft. South & 7 ft. W. of Iron N.W. cor. lot 1, Blk. 8.
PLAN SCALE 1" = 40'
PROFILE SCALE 1" = 40' HORZ. 1" = 5' VERT.
"As Built" Final Measurement M-108
LAT. 3, MAIN 2, WESTLINK SEWER
CITY OF WICHITA, KANSAS
R. W. LINN — CITY ENGINEER
NOV. 1972 PROJECT NO. DBKL 572051