
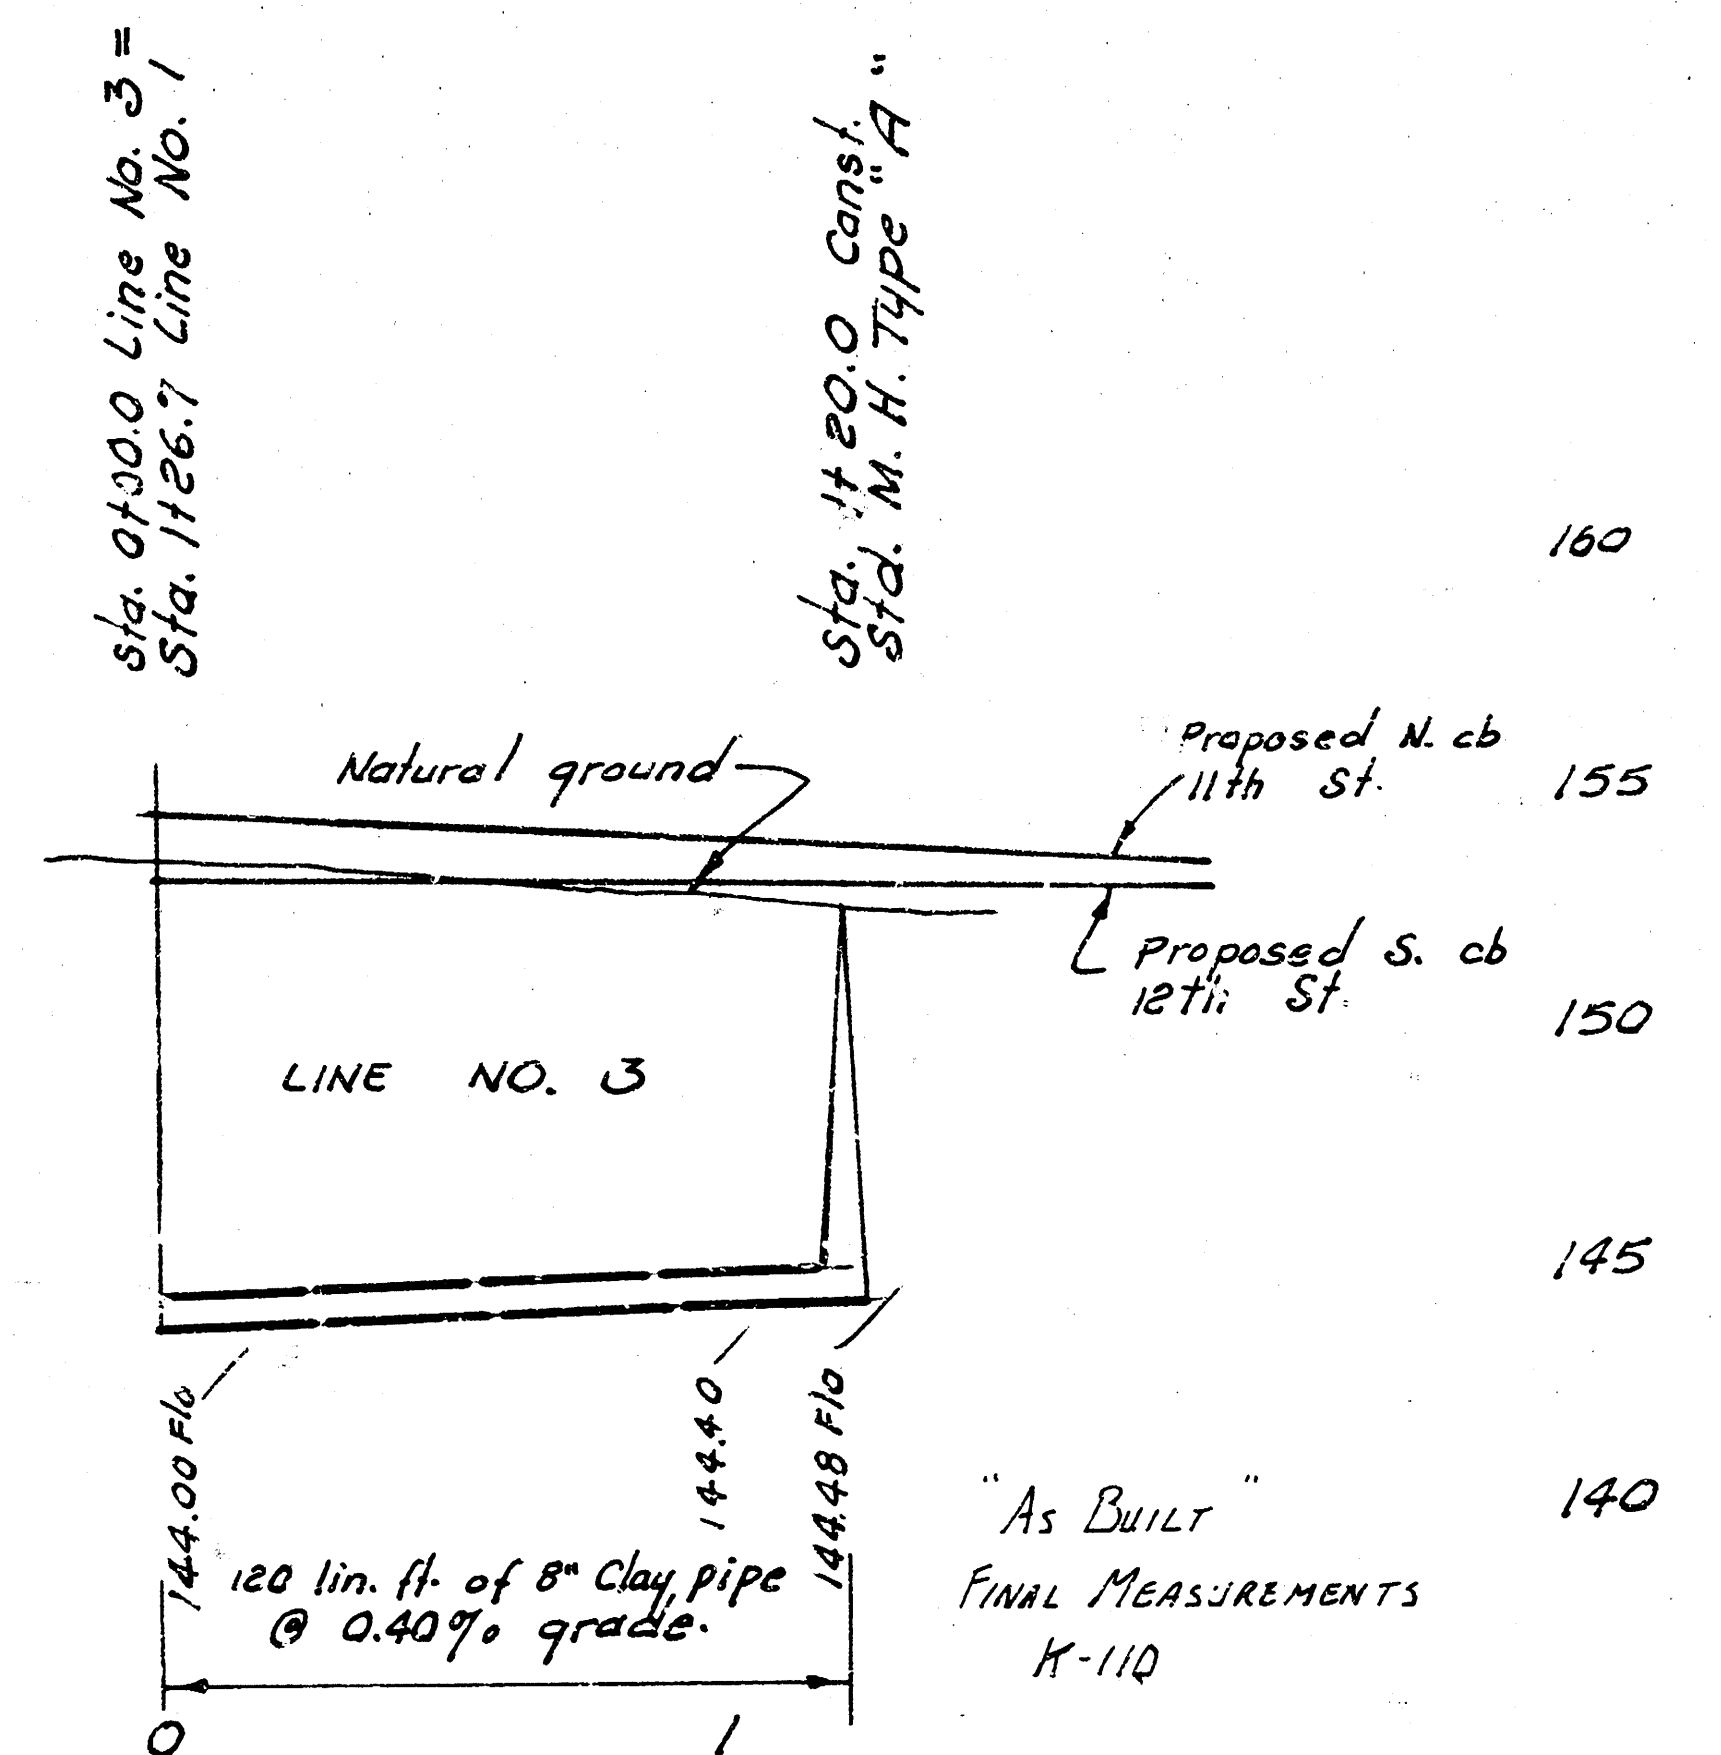
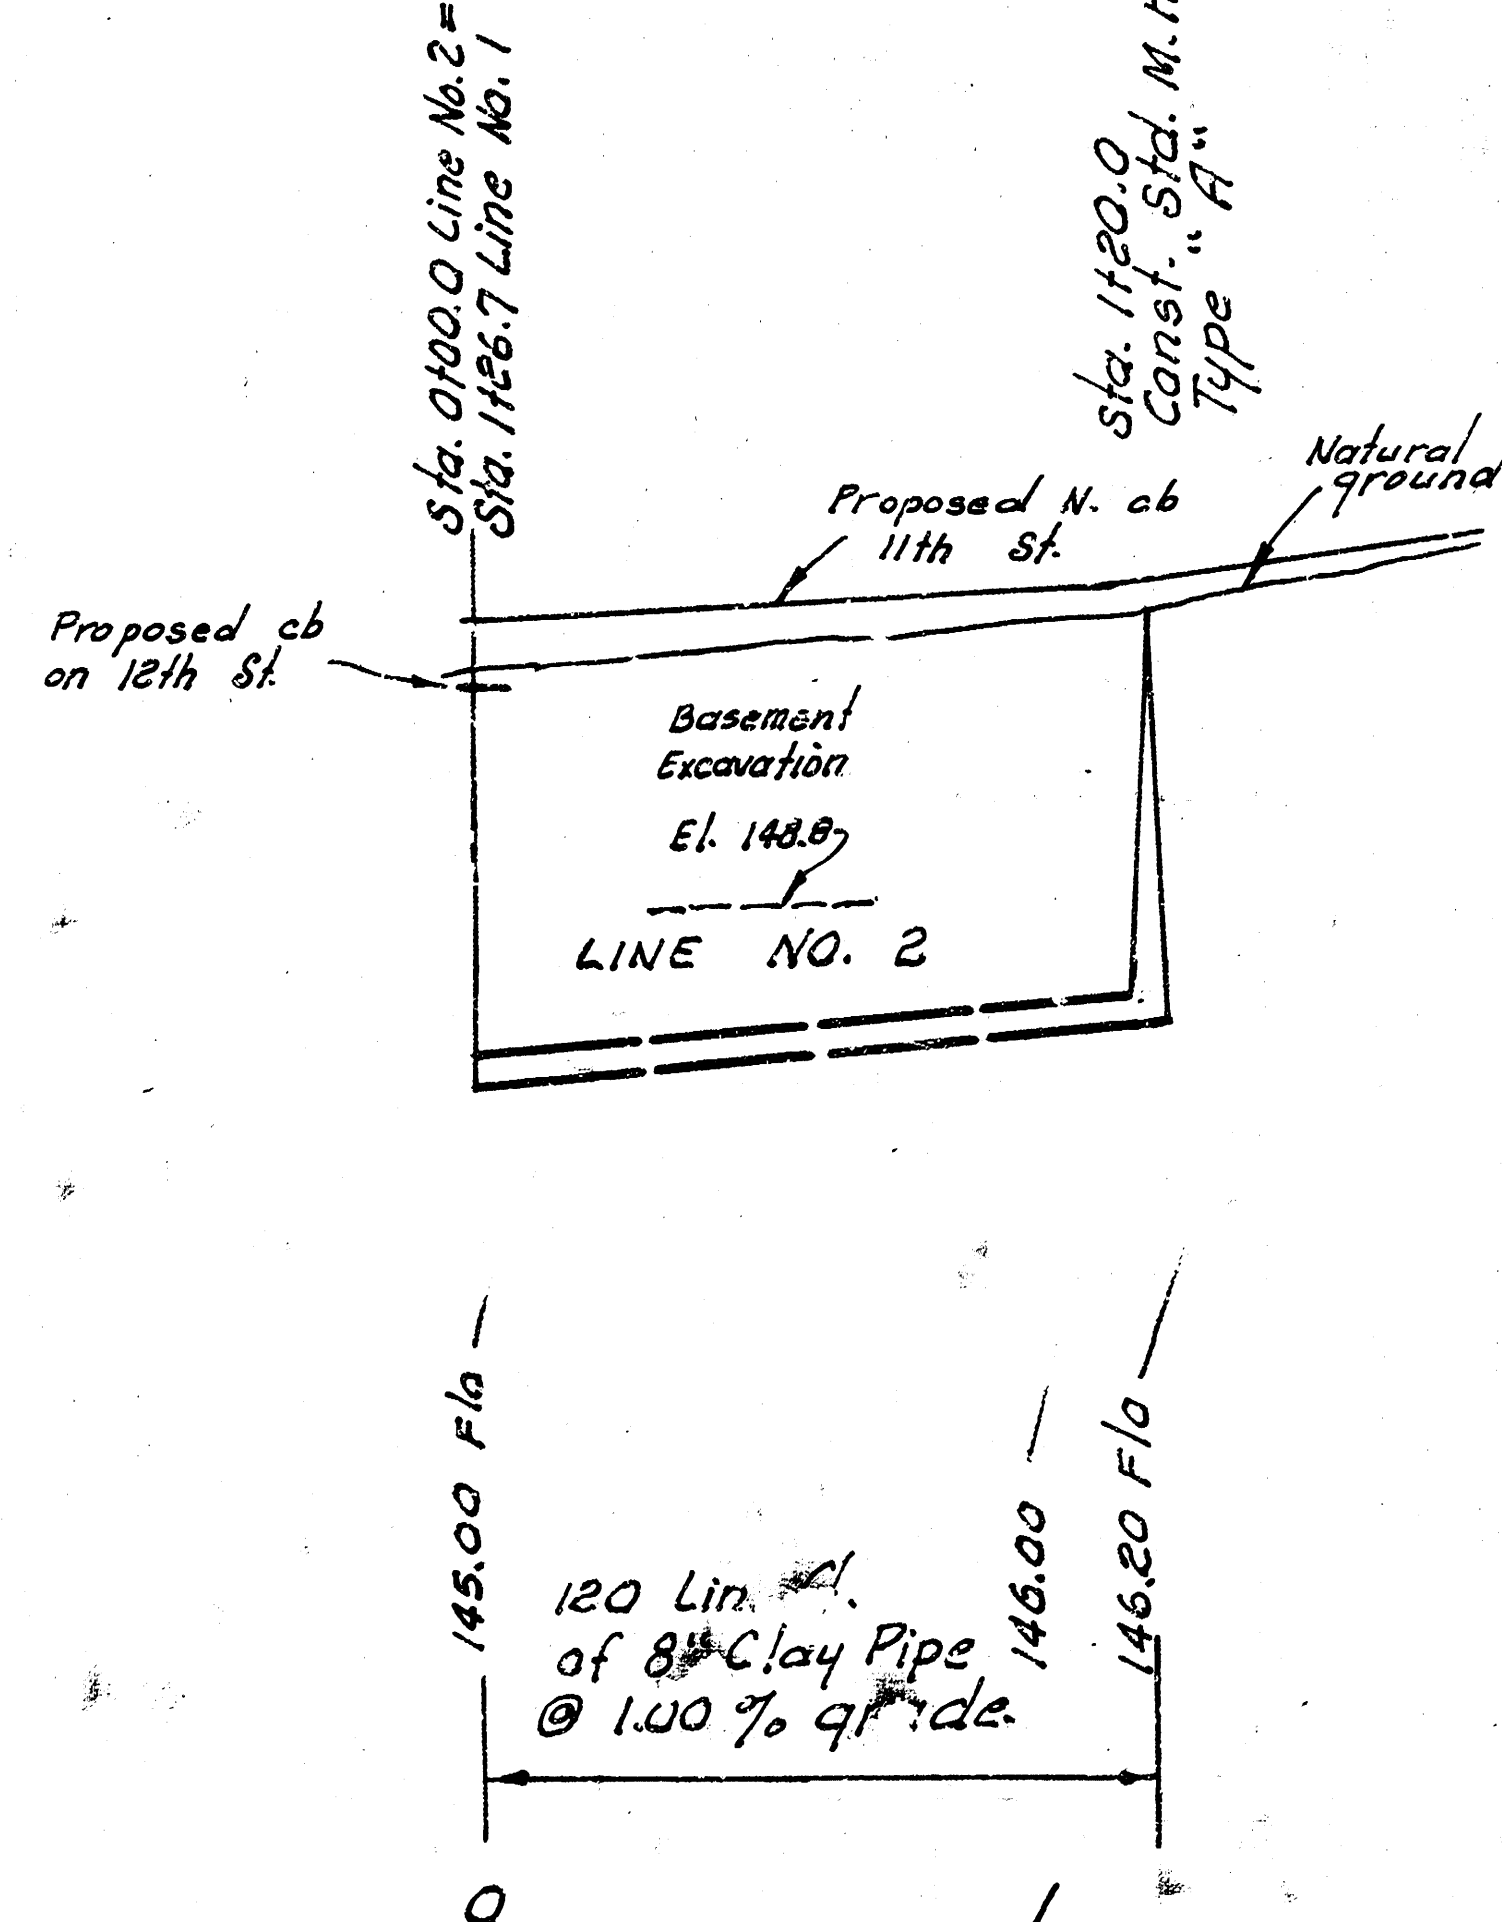
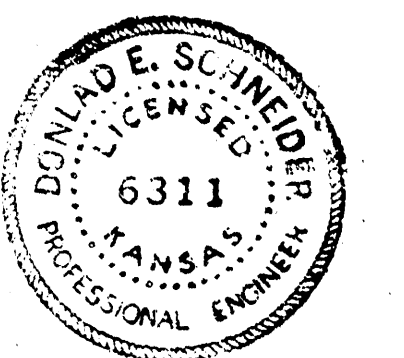


B. M. 151.858 R.R. Spk. NE Face P. P. 25 ft.
S. and 7 ft. west of iron NW cor.
lot 1. Block 8.

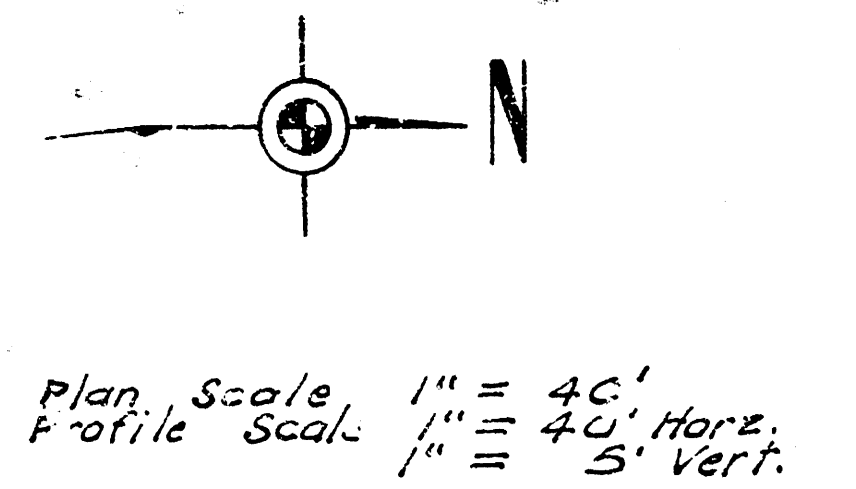

LAT. 4, MAIN 2, WESTLINK SEWER
CITY OF WICHITA, KANSAS
R. W. LINN — CITY ENGINEER
NOV. 1972 PROJECT NO. DRKL572052

FILMED FROM THE BEST