



NOTE: PIPE BETWEEN STA. 0+00 AND STA. 1+71 ON LINE 1 SHALL BE THE SAME TYPE OF PIPE AS THAT WHICH IS TO BE INSTALLED BY CONTRACTOR FOR LATERAL 8, MAIN 3, WESTLINK SEWER.

BM. 172.48 City Std. SE. corner of 17th St. North and Tyler Road
BM. 158.75 SE. corner concrete porch 9116 Nantucket

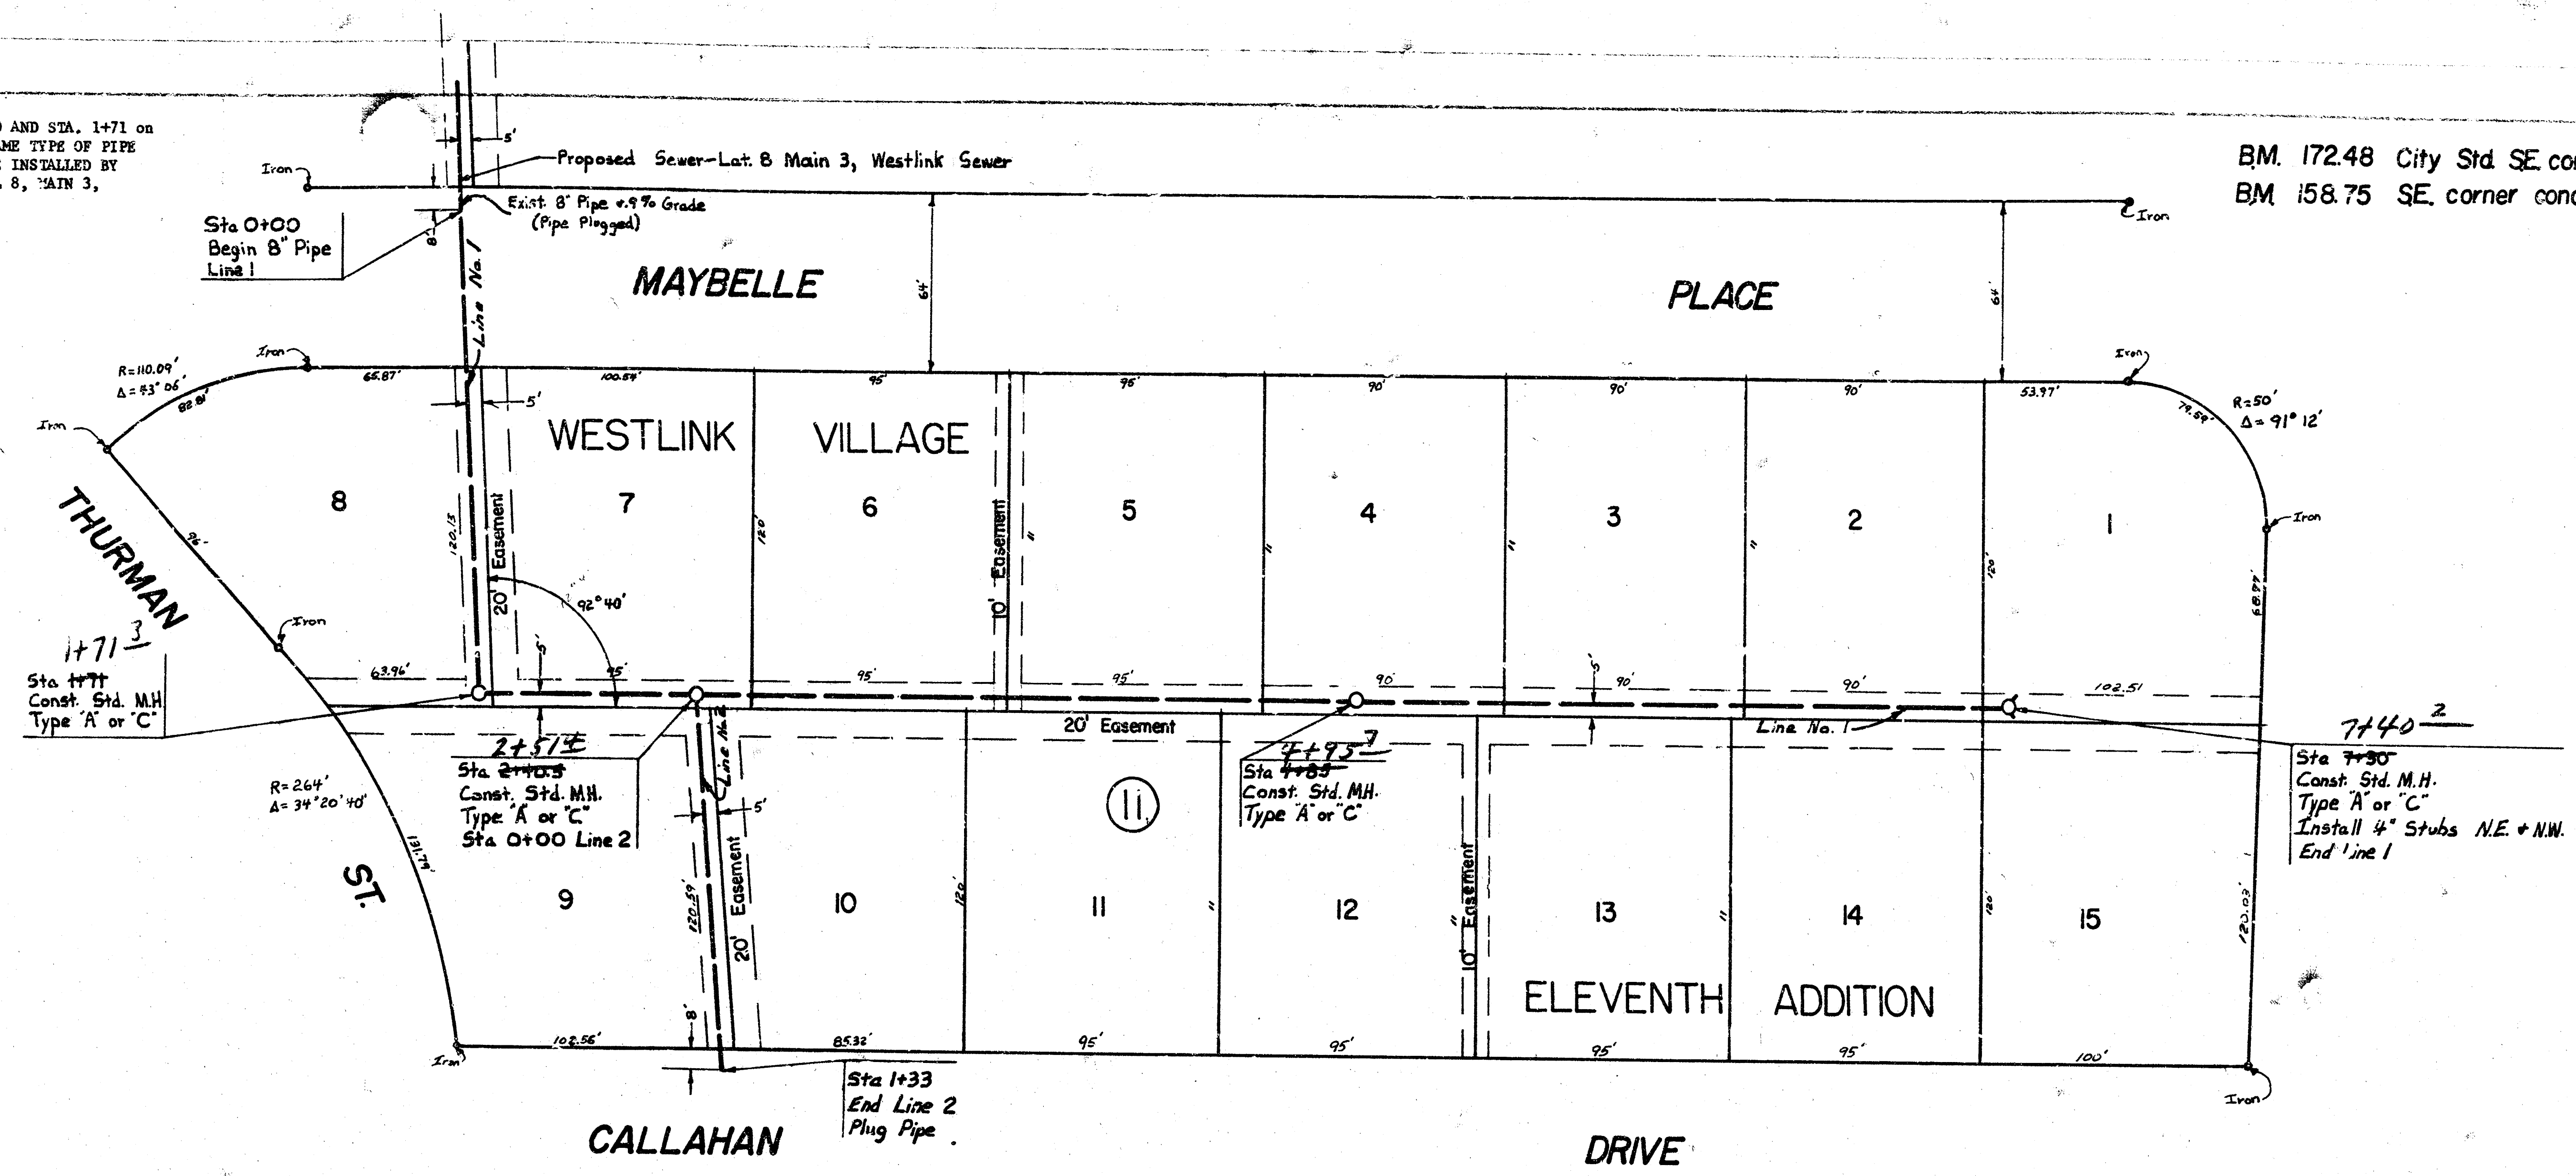

Plan Scale 1" = 40'
Profile Scale 1" = 40' Horz.
1" = 5' Vert.

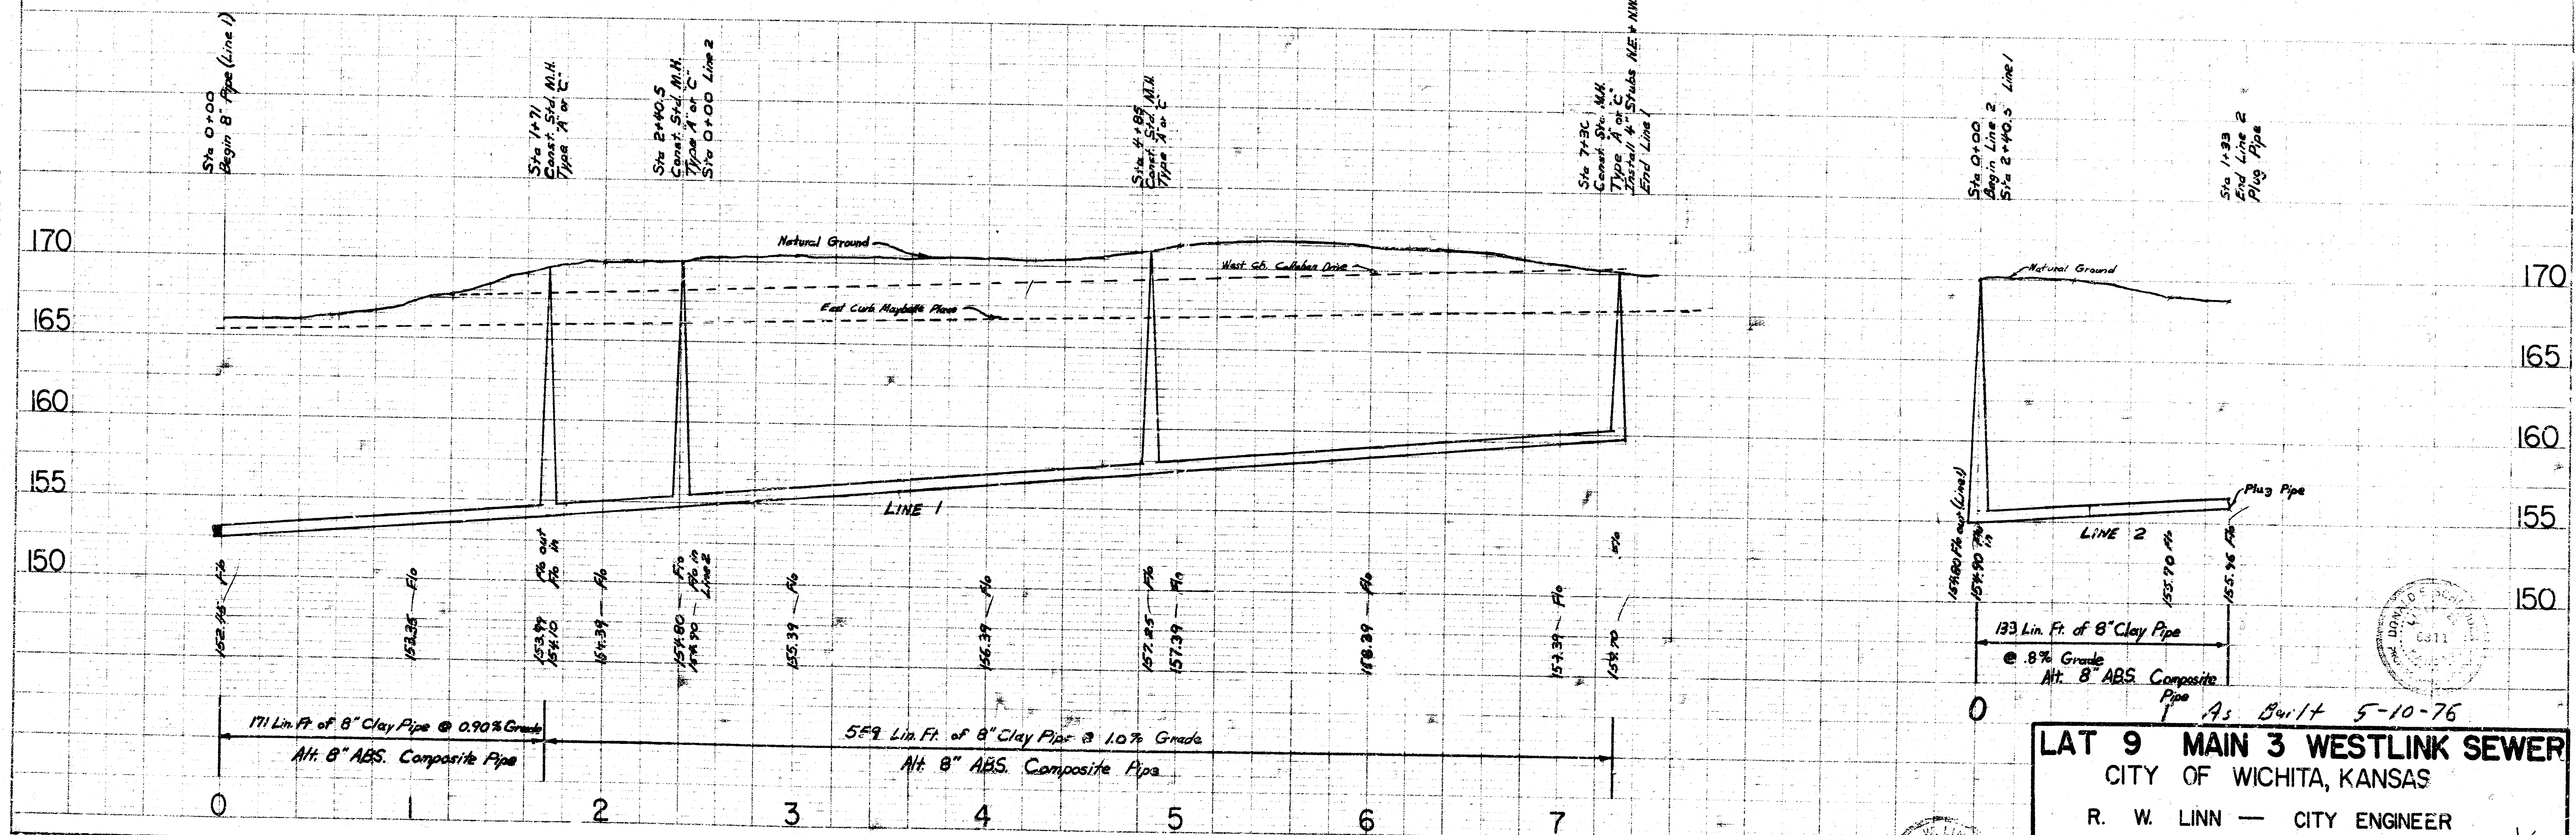

LAT 9 MAIN 3 WESTLINK SEWER
CITY OF WICHITA, KANSAS
R. W. LINN — CITY ENGINEER
Project No. DBKL 574033