

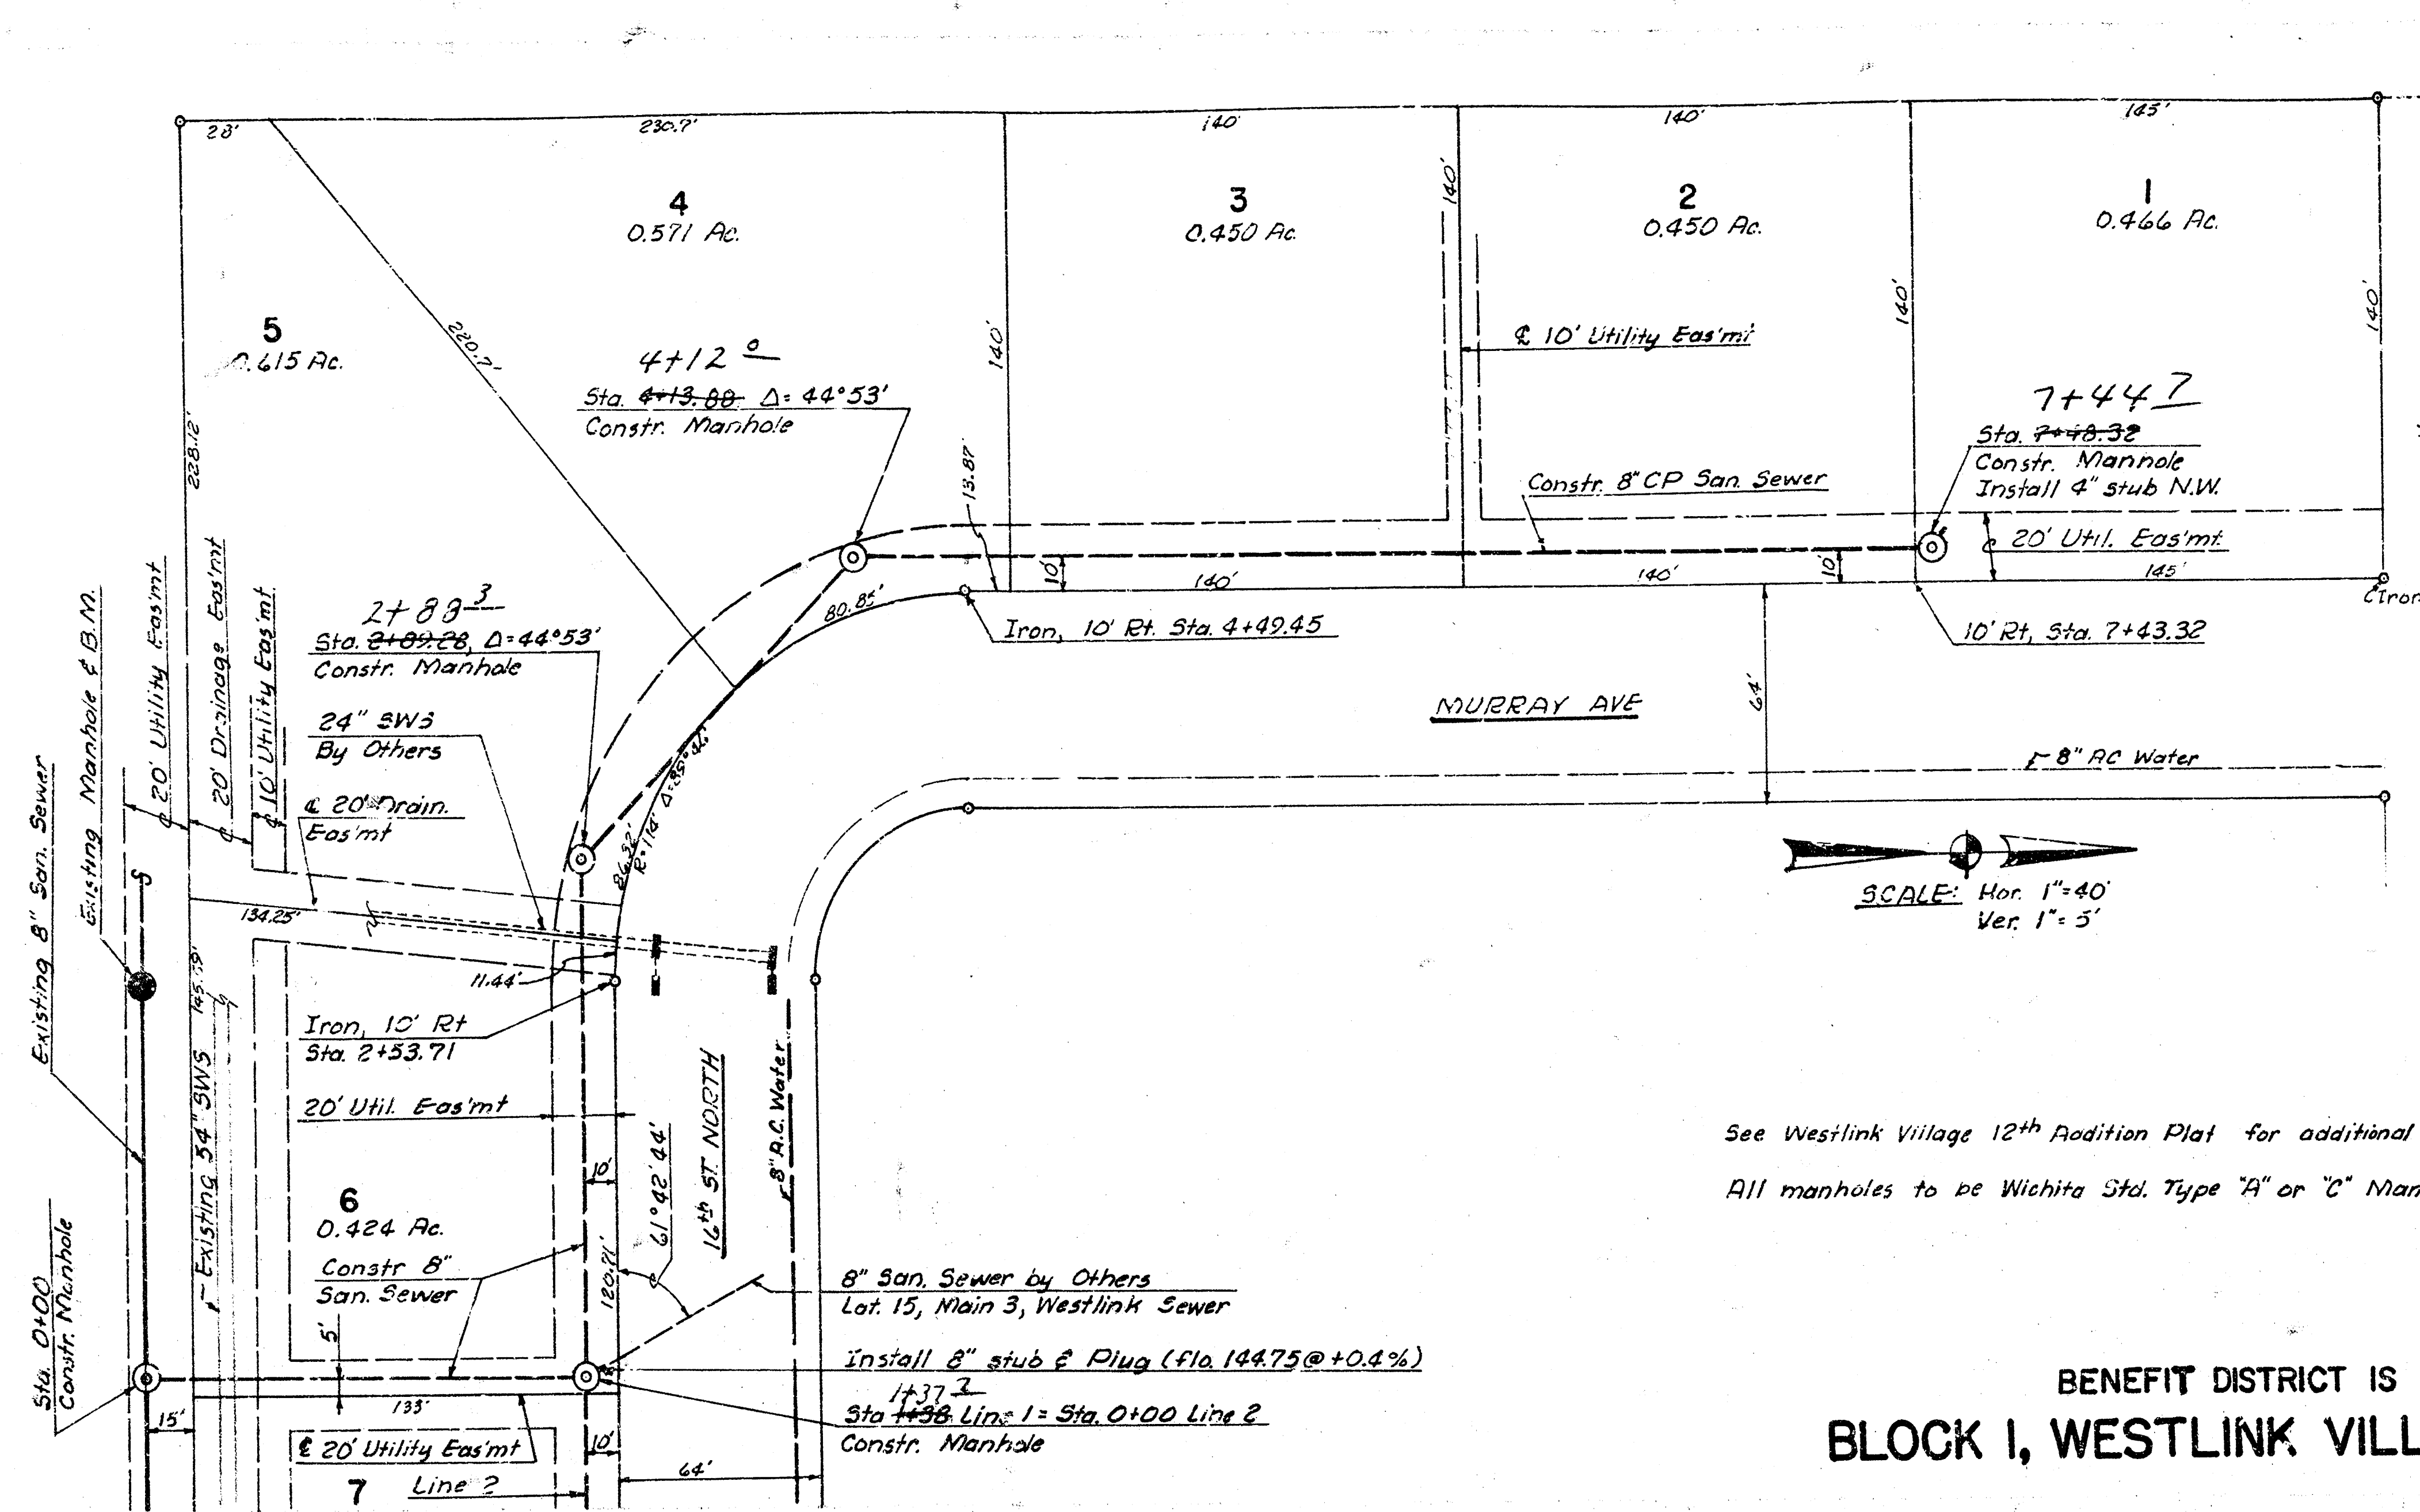
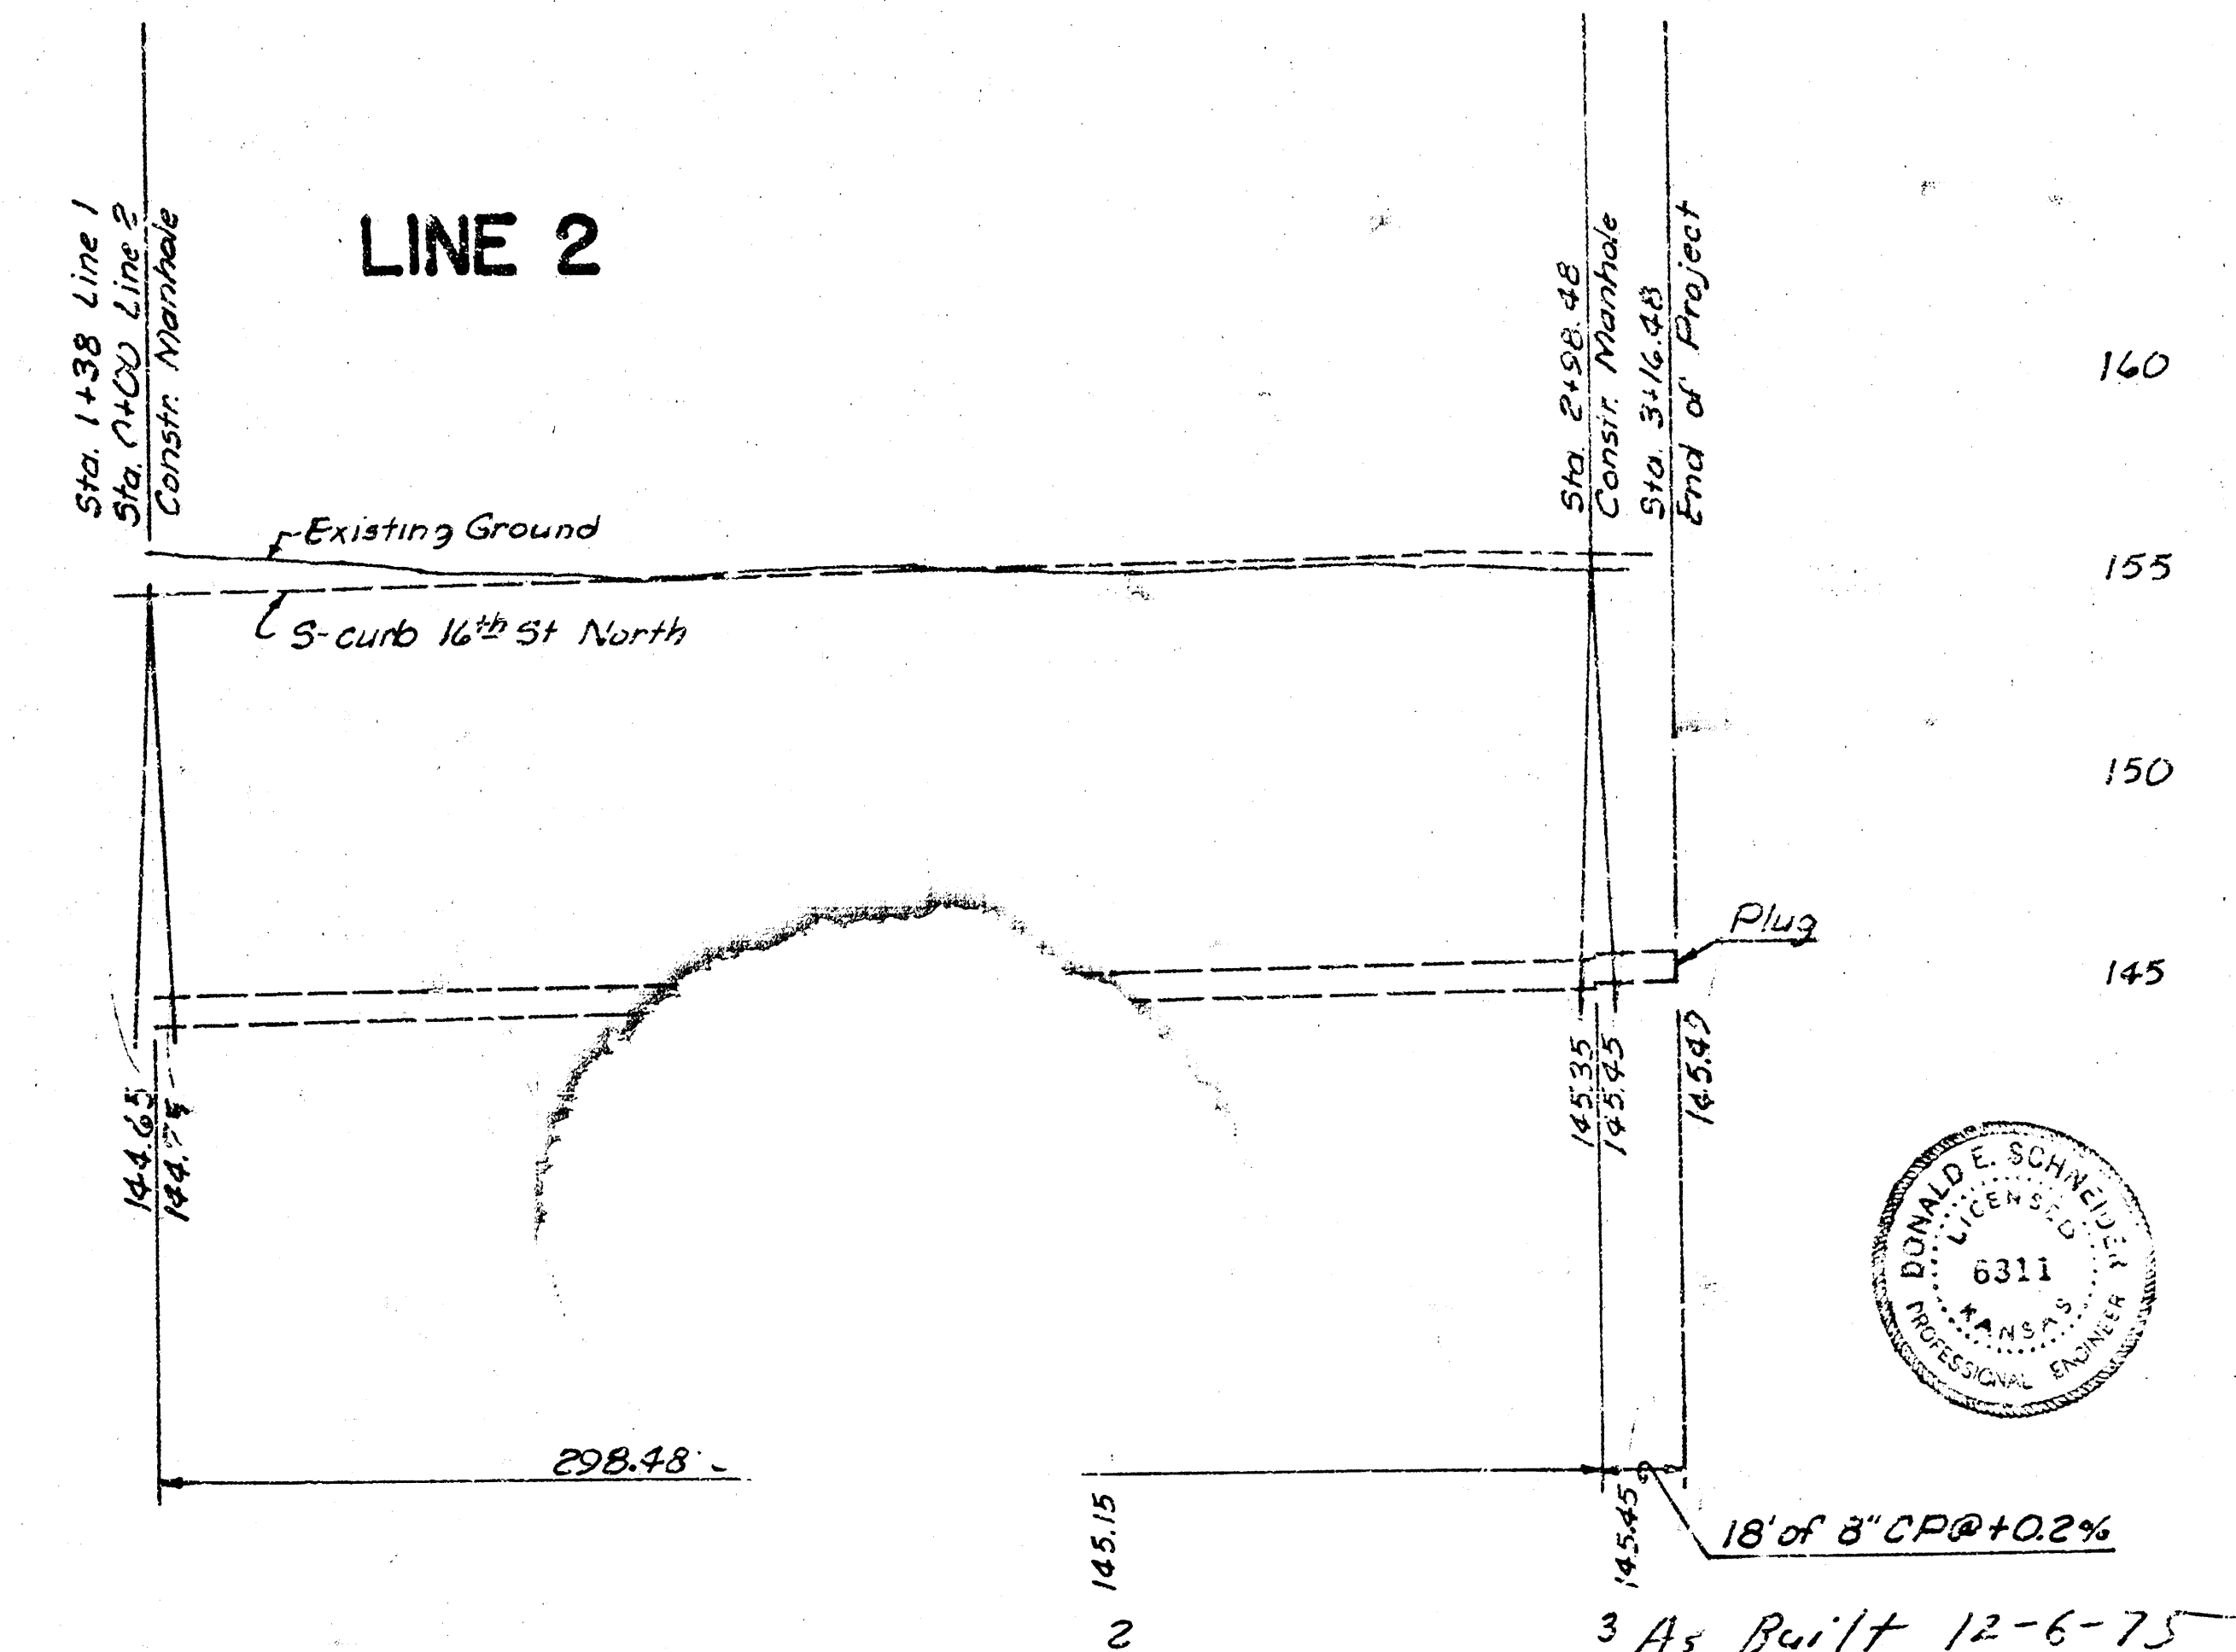


JFC-184 (L&S-2)
WSK

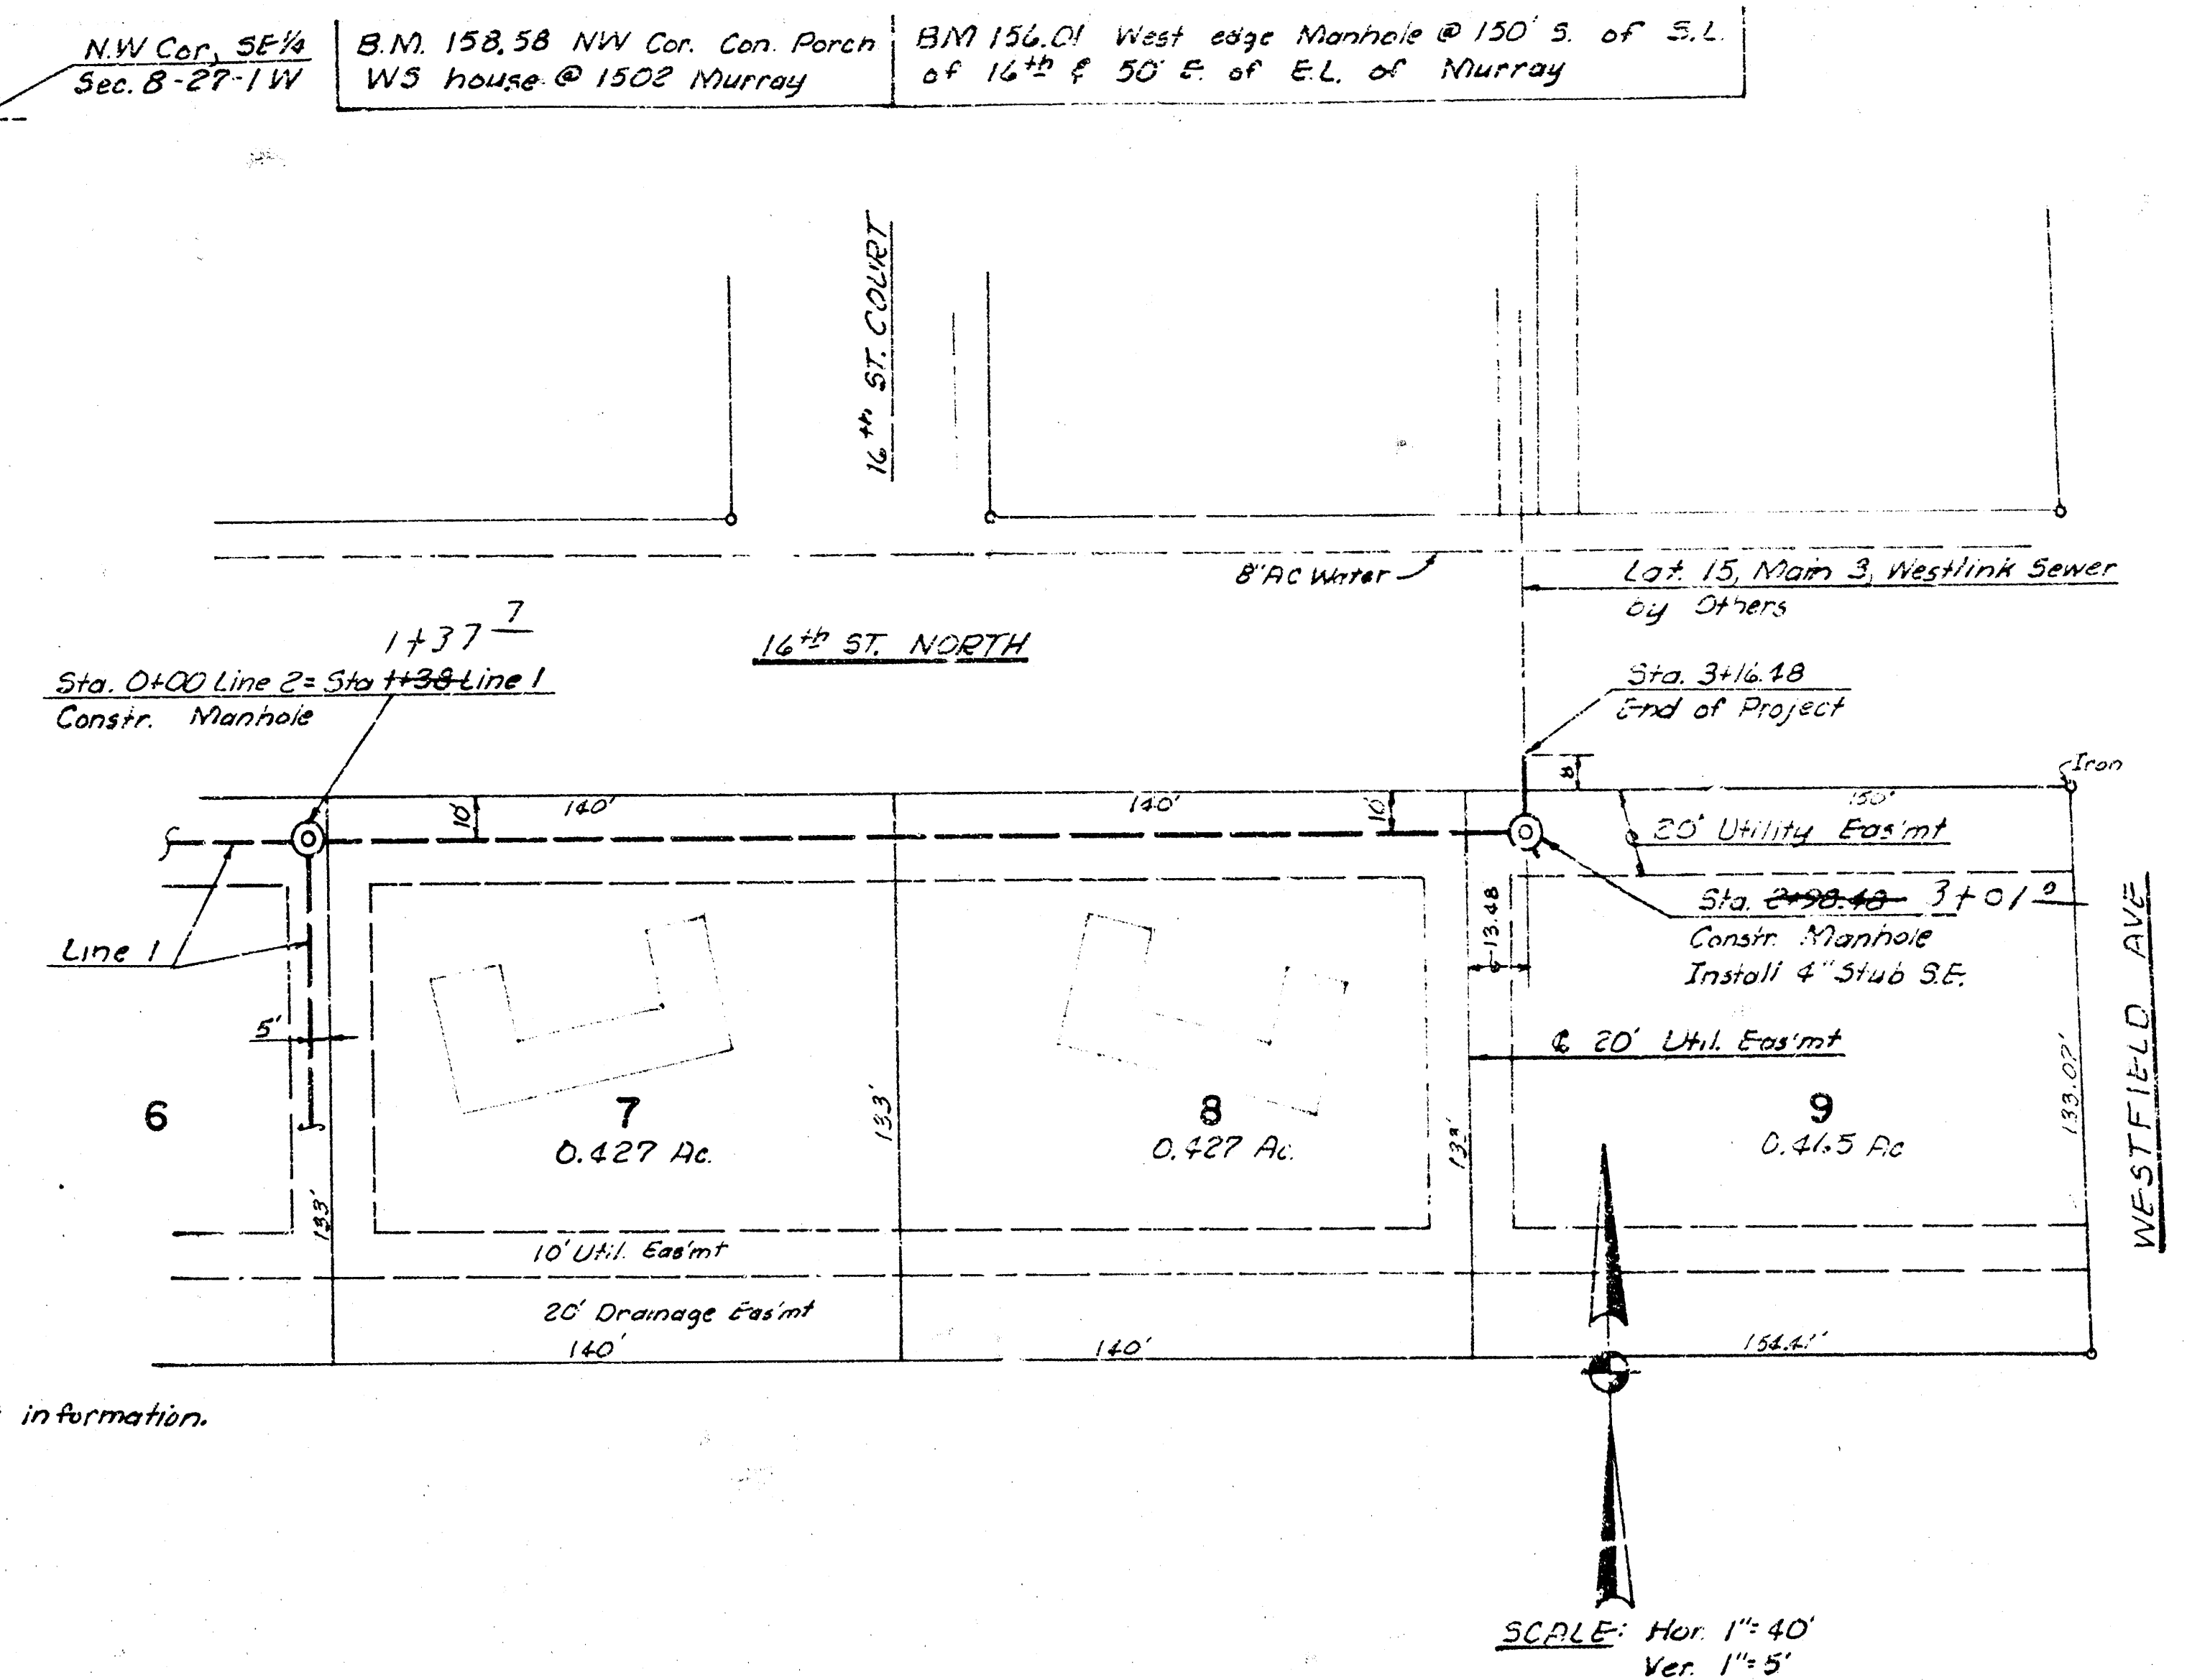

See Westlink Village 12th Addition Plat for additional layout information.
All manholes to be Wichita Std. Type "A" or "C" Manholes.

BENEFIT DISTRICT IS
BLOCK I, WESTLINK VILLAGE TWELFTH ADDITION

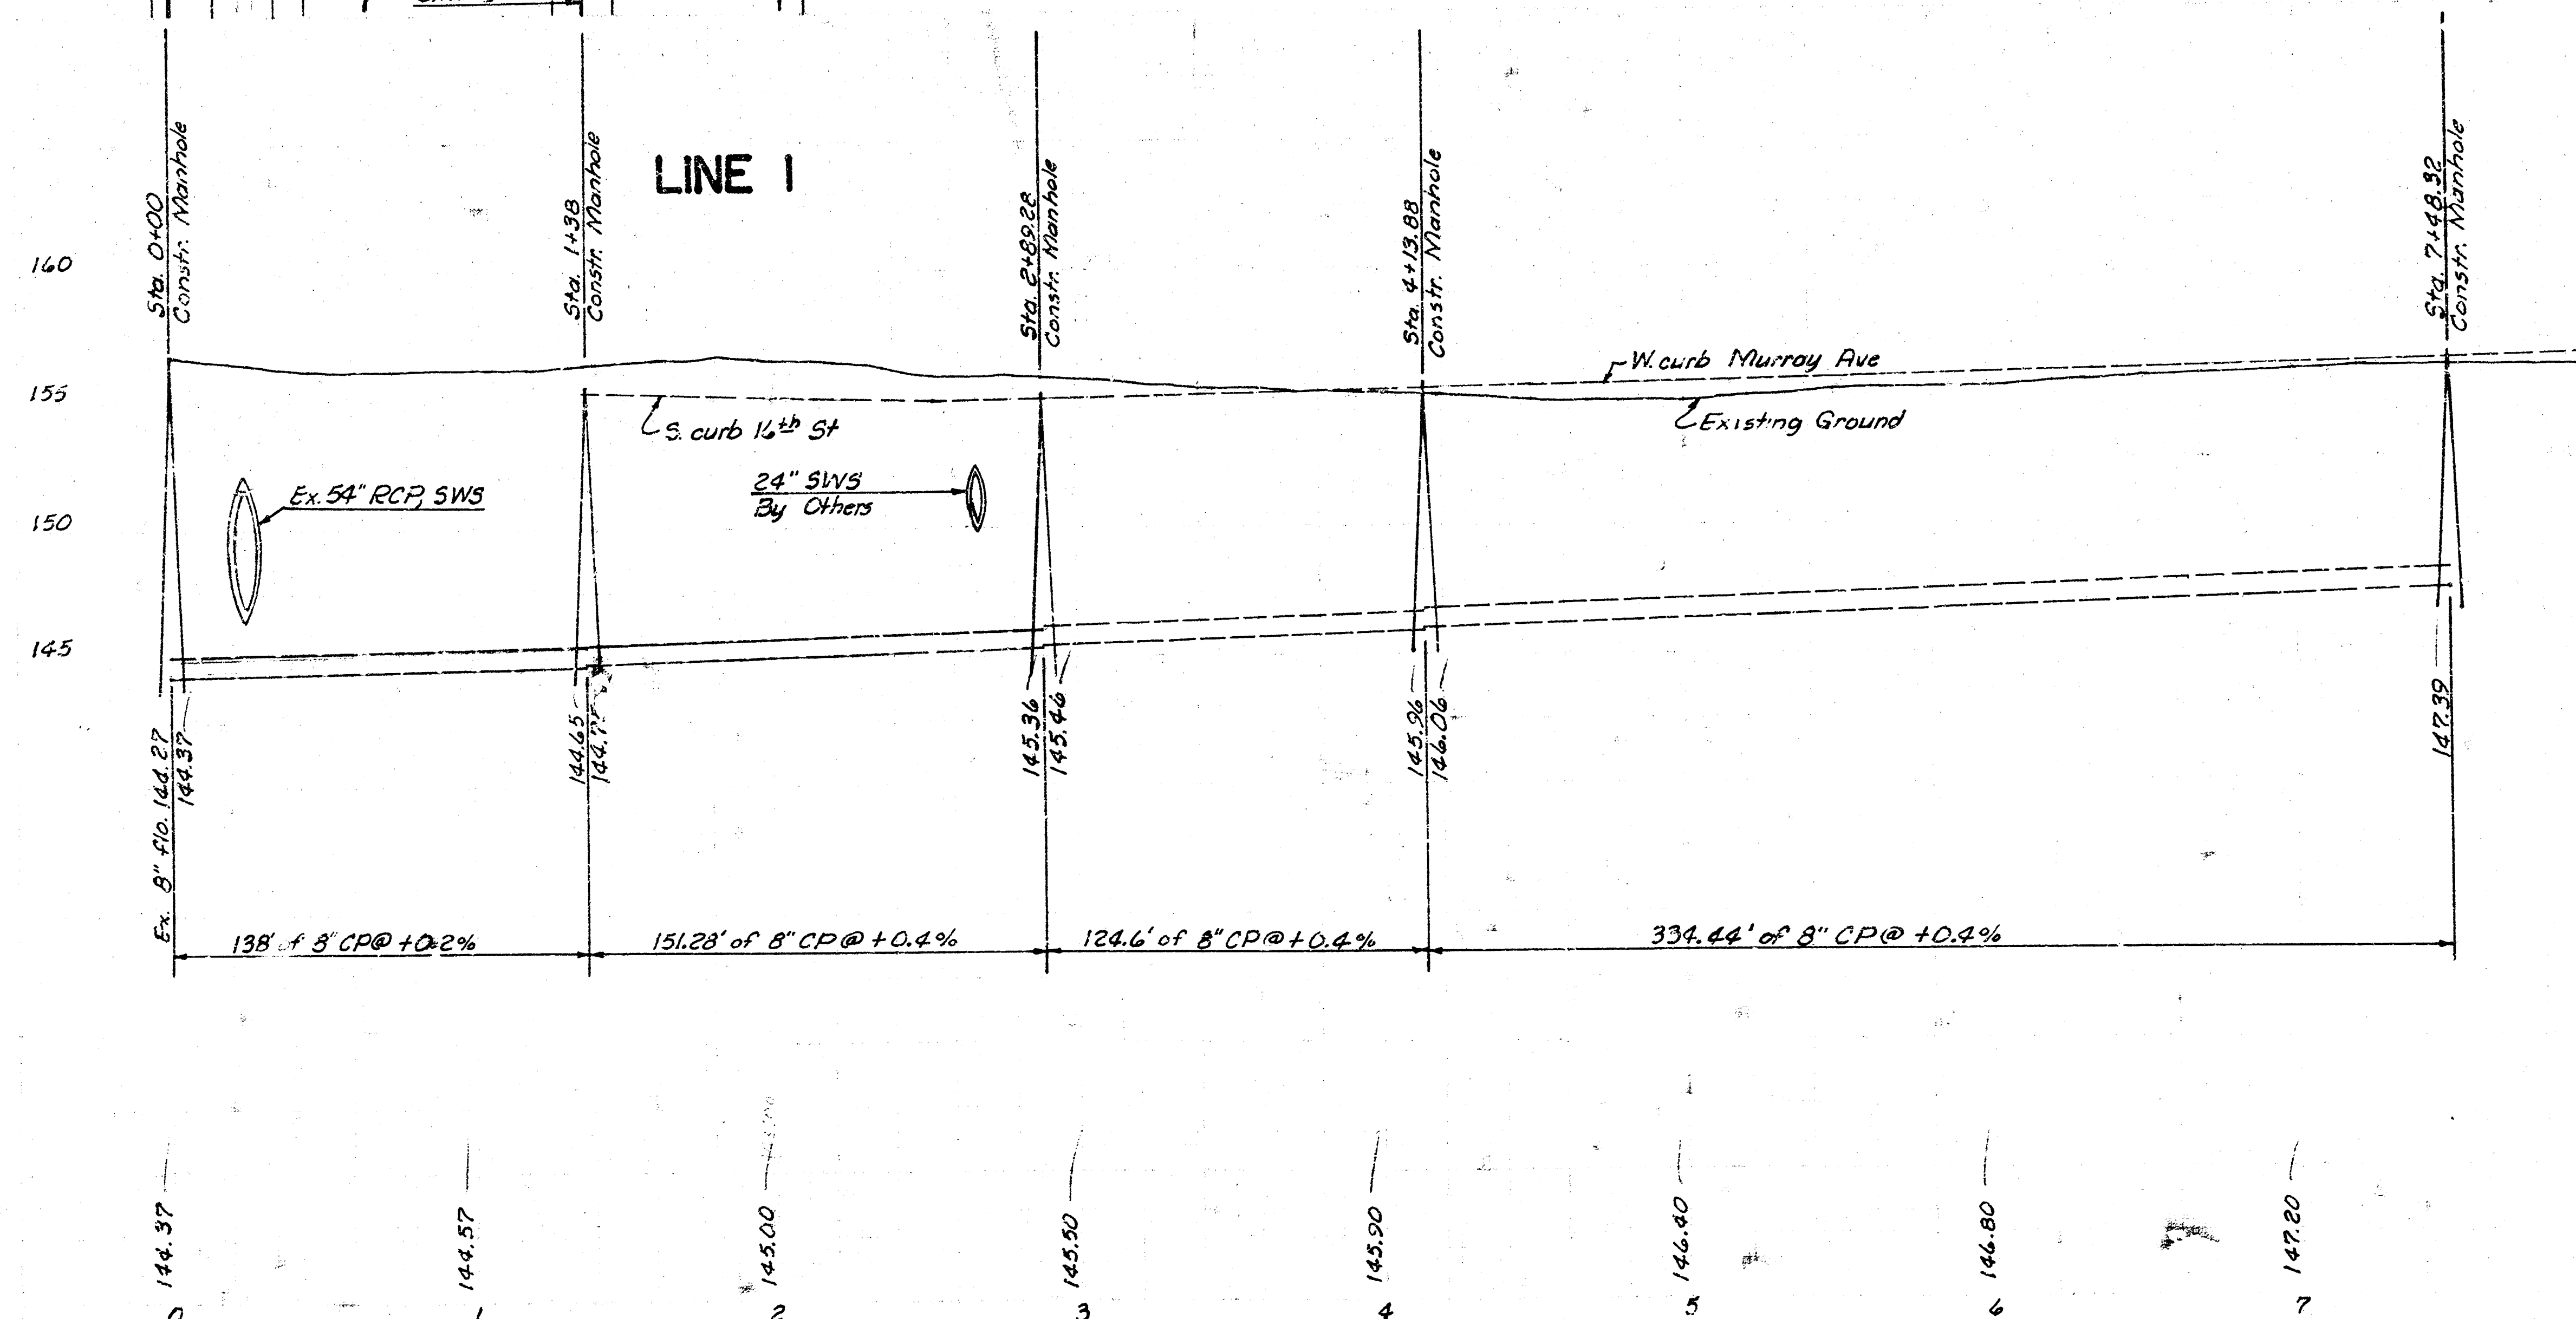

LAT. 14, MAIN 3, WESTLINK SEWER
CITY OF WICHITA, KANSAS
R. W. LINN, CITY ENGINEER
PROJECT NO. DBKL 575039
DATE 8-12-80 SHEET 1 OF 1