





# LATERAL 17, MAIN 3 WESTLINK SEWER

City of WICHITA, KANSAS Dean Sellers — City Engineer

Project No. 468-76-245-80206-000-000-001 Date: \_\_\_\_\_

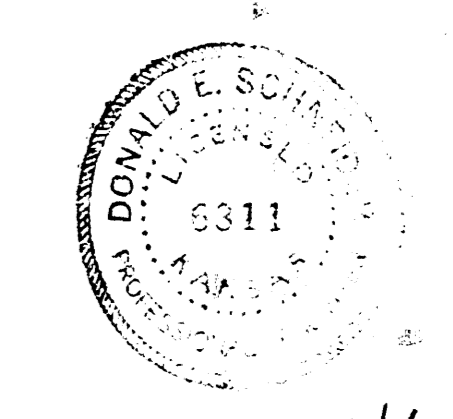

SUNSHINE PLANNING 10/19  
MS/11

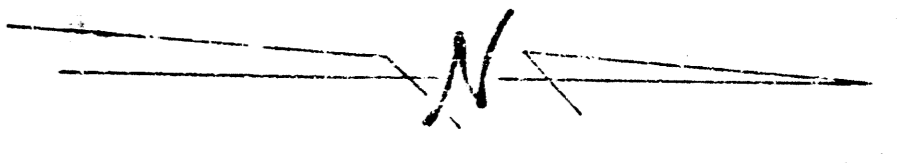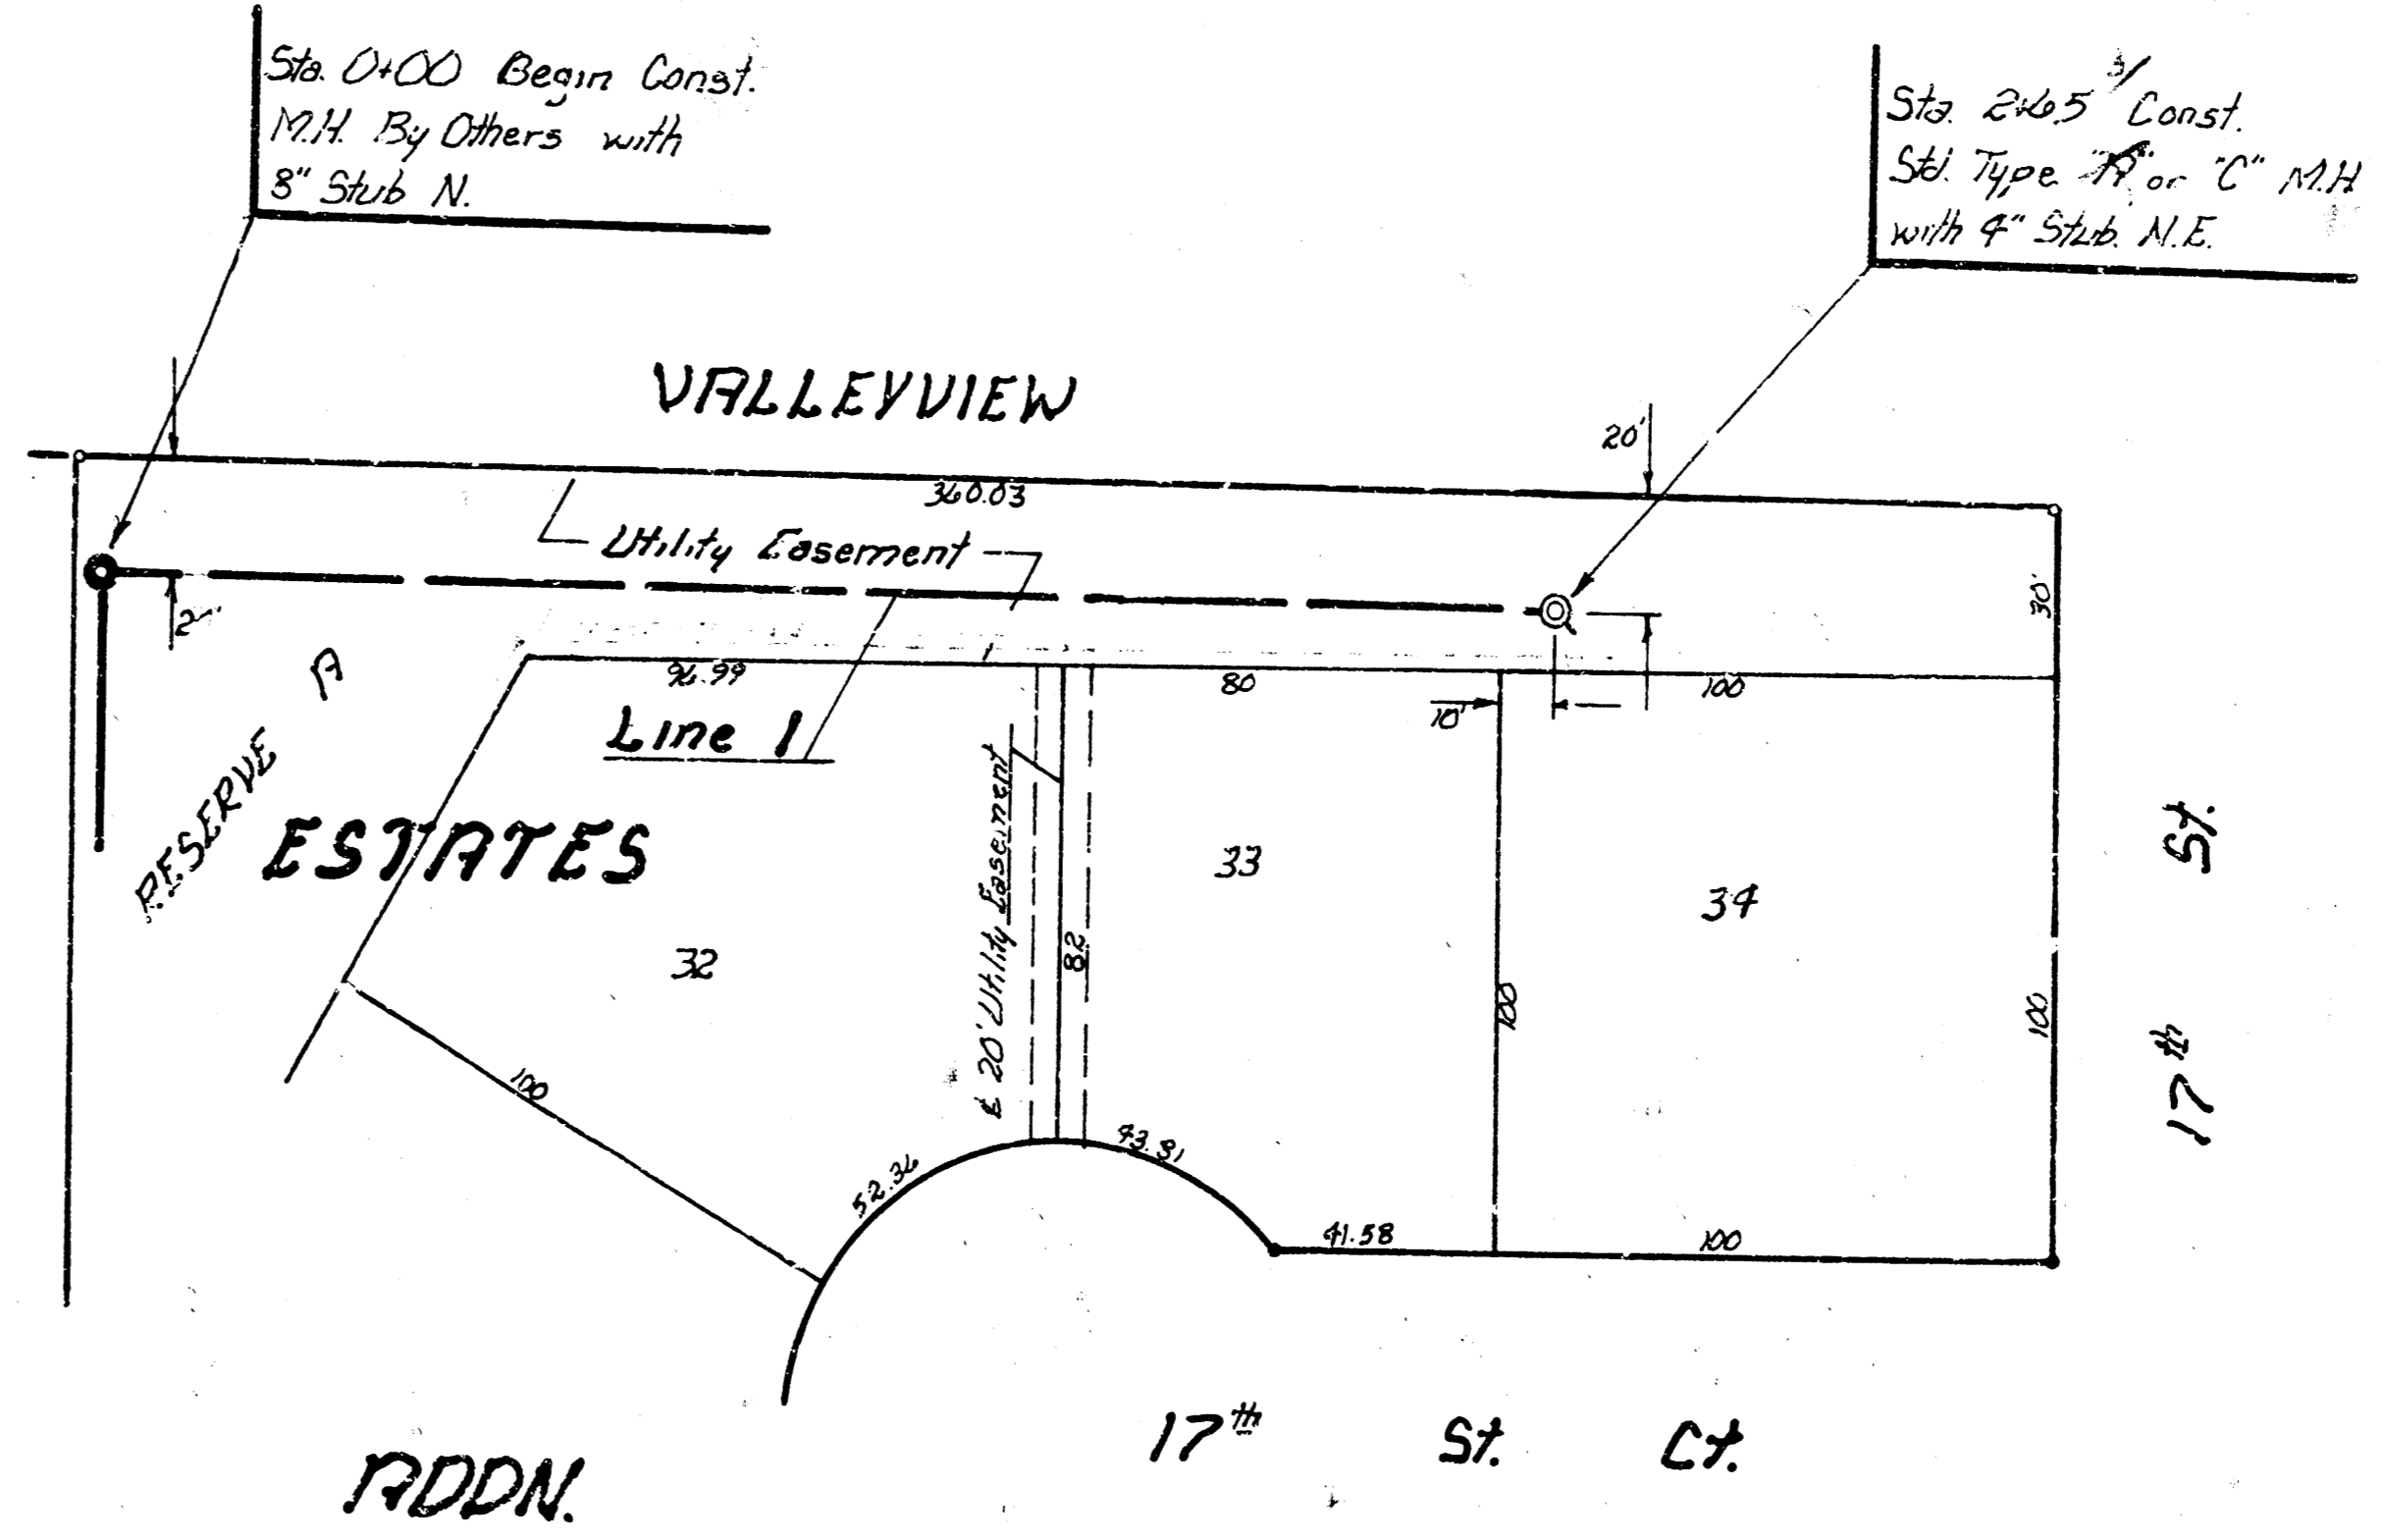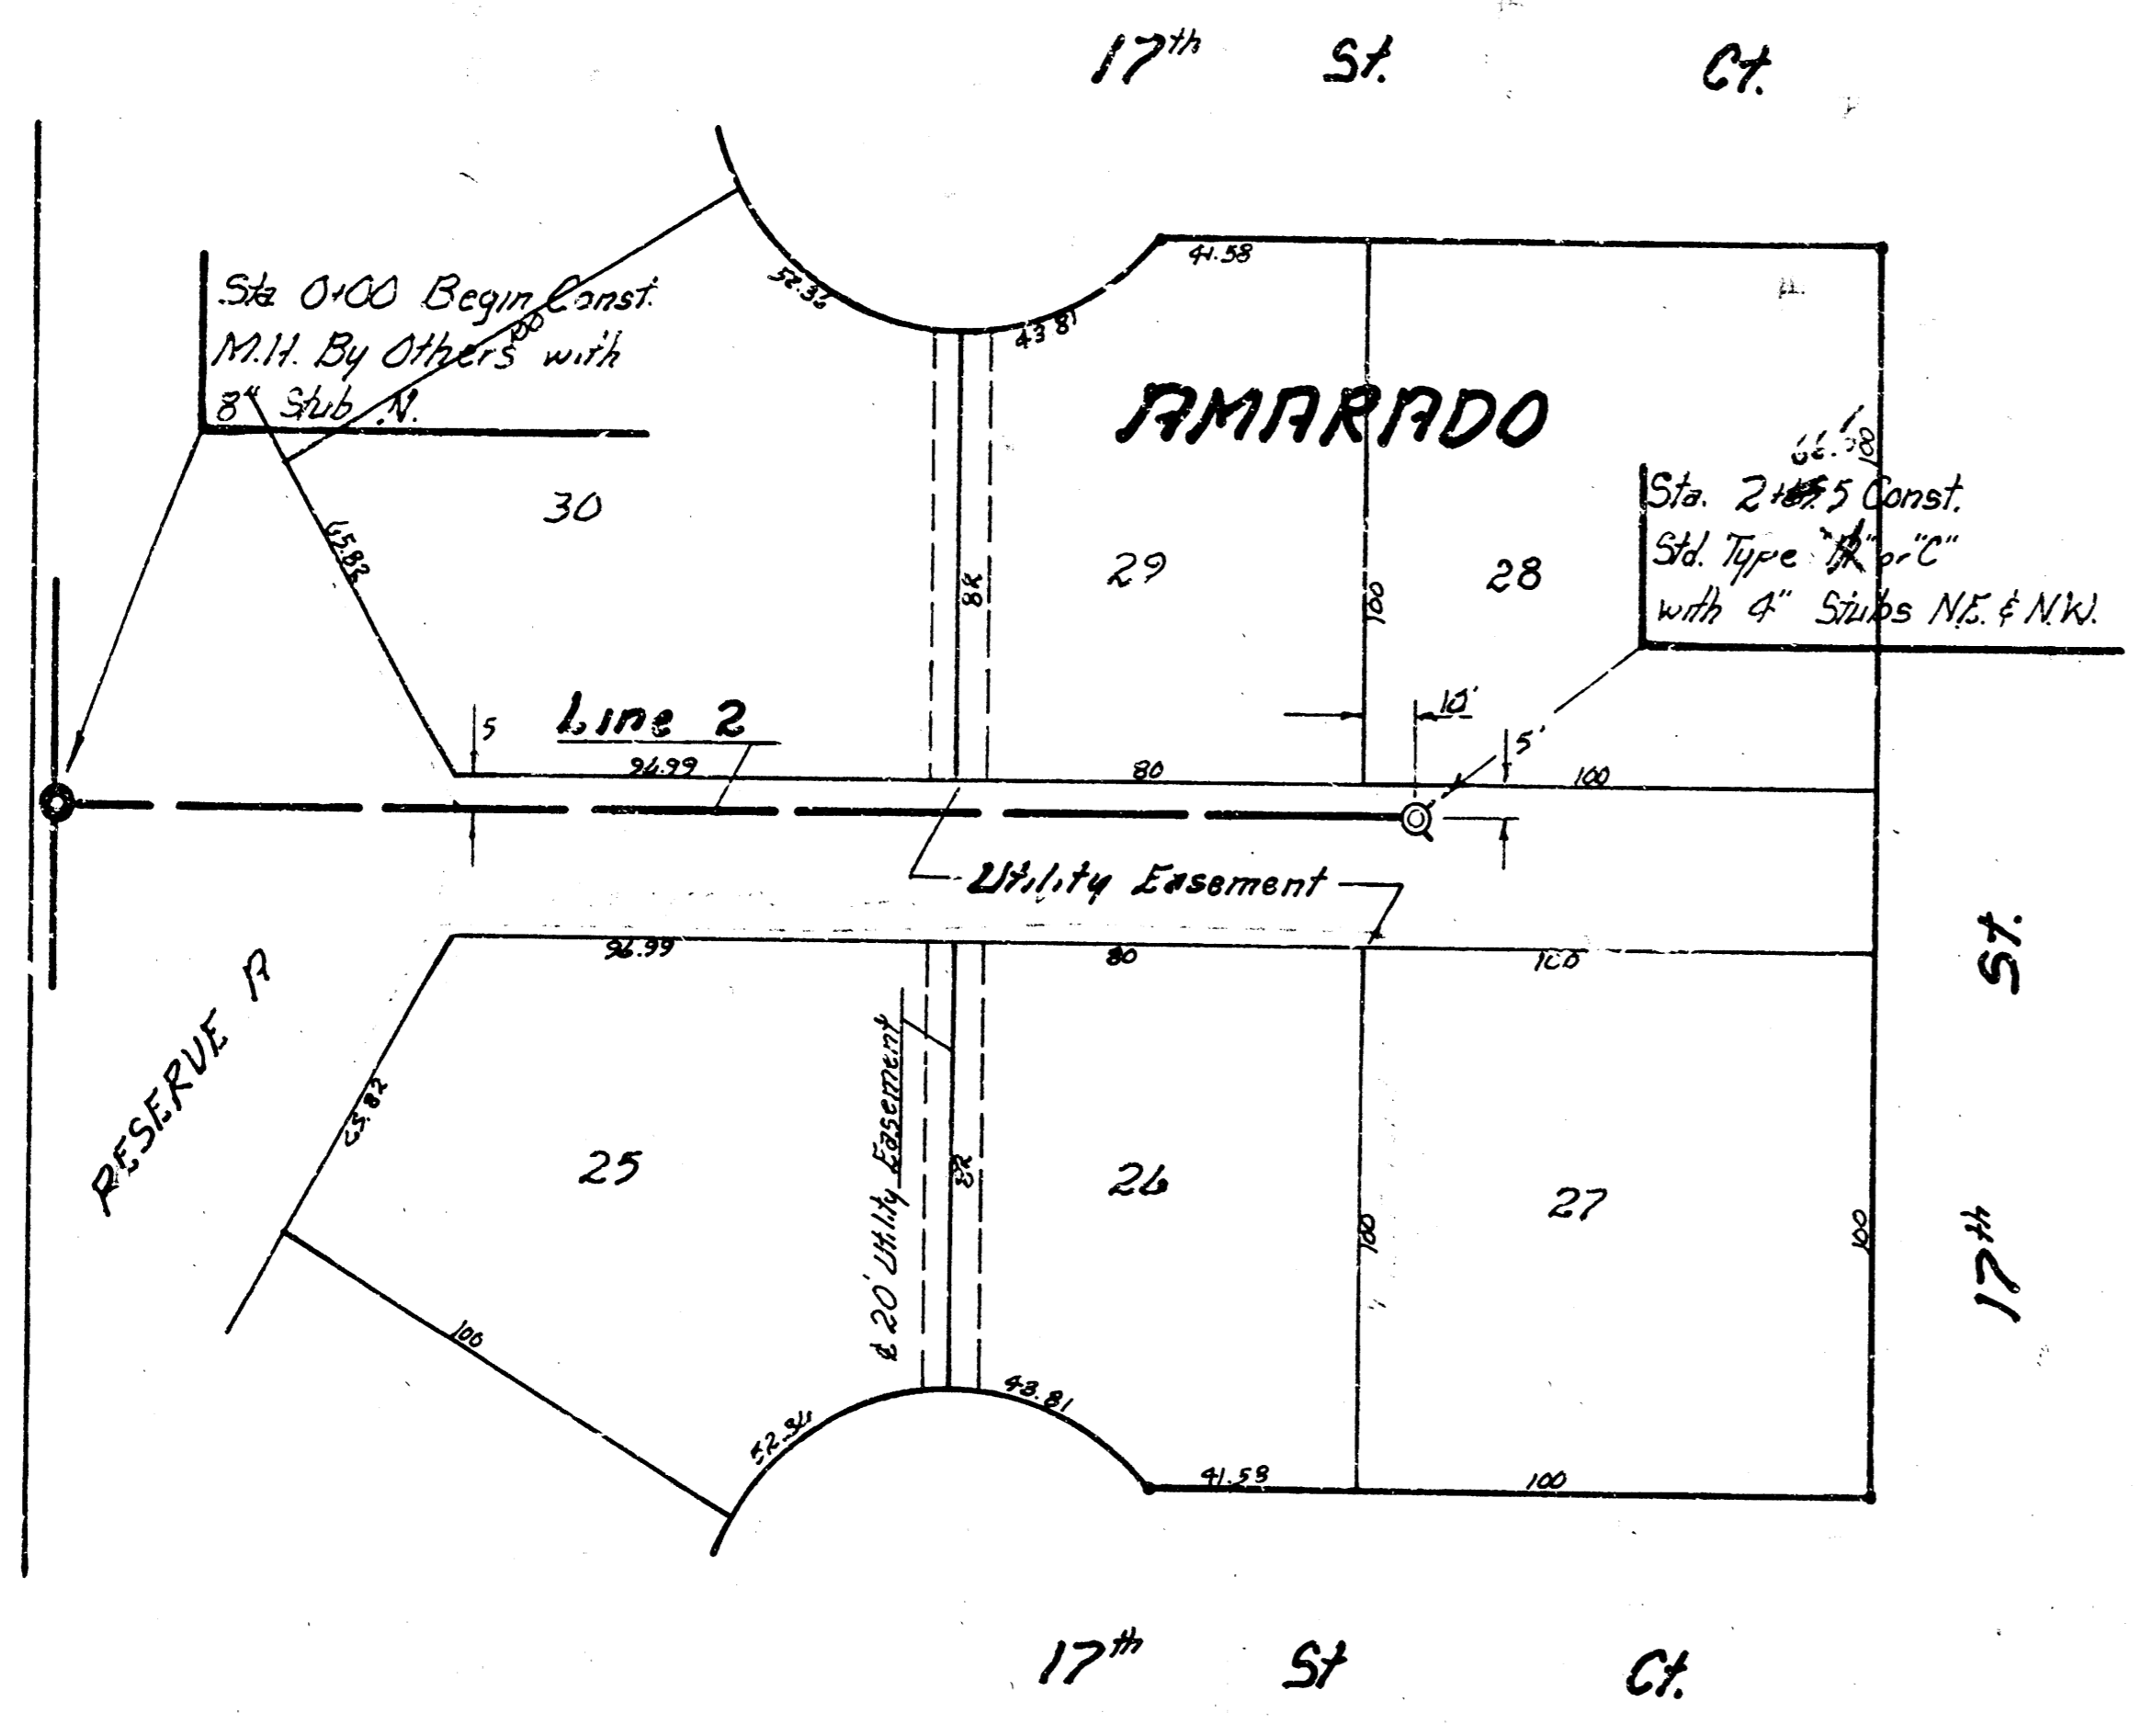



Sta 0+00 Begin Const.  
M.H. By Others with  
8" Stub N.

Sta 2+65 Const.  

Sta 0+00 Begin Const.  
M.H. By Others with  
8" Stub N.

Sta 2+65 Const.  

SCALE  
Plan 1" = 20'  
Profile 1" = 5'  
Horz 1" = 20'

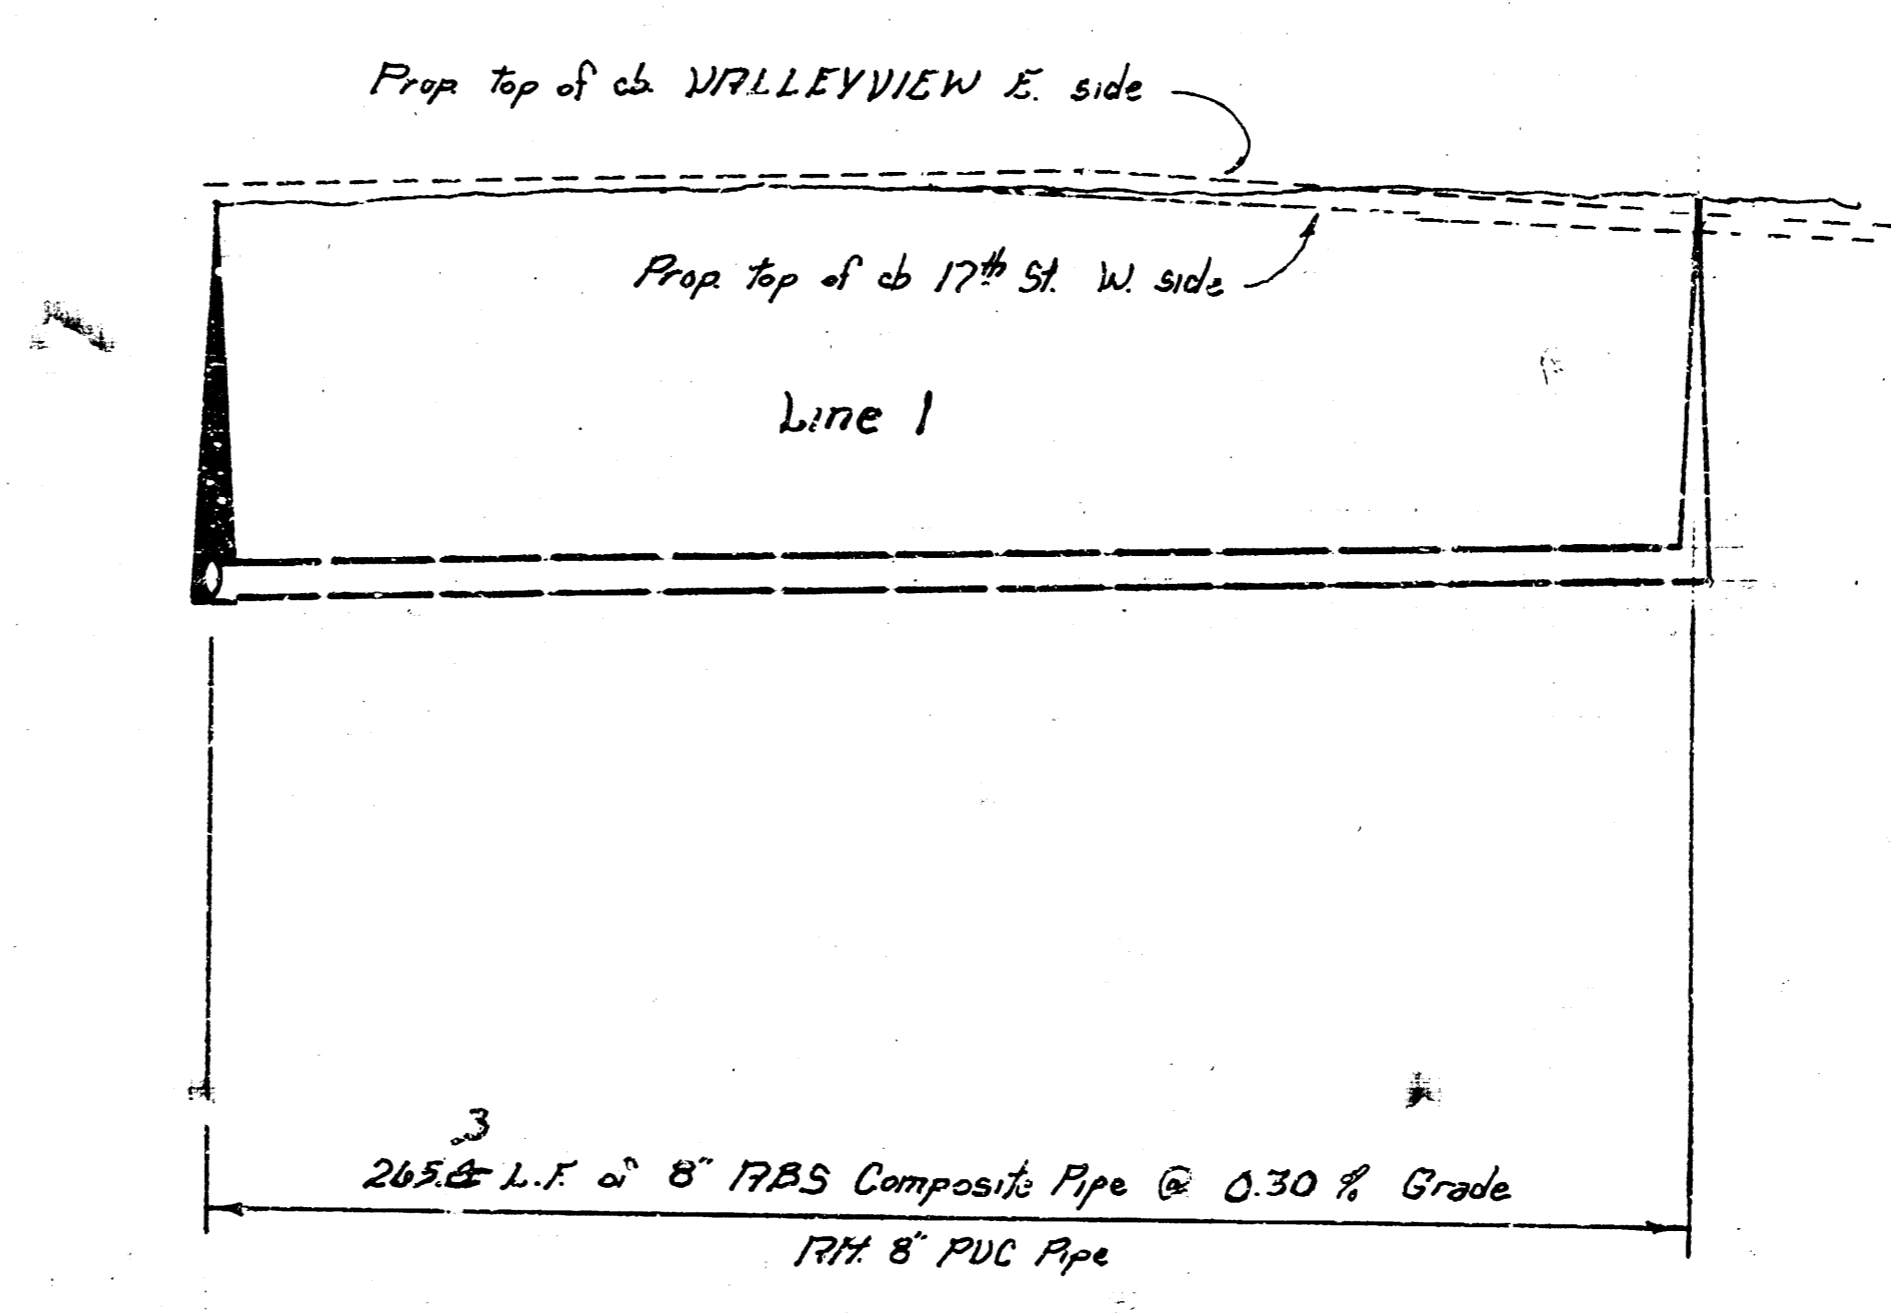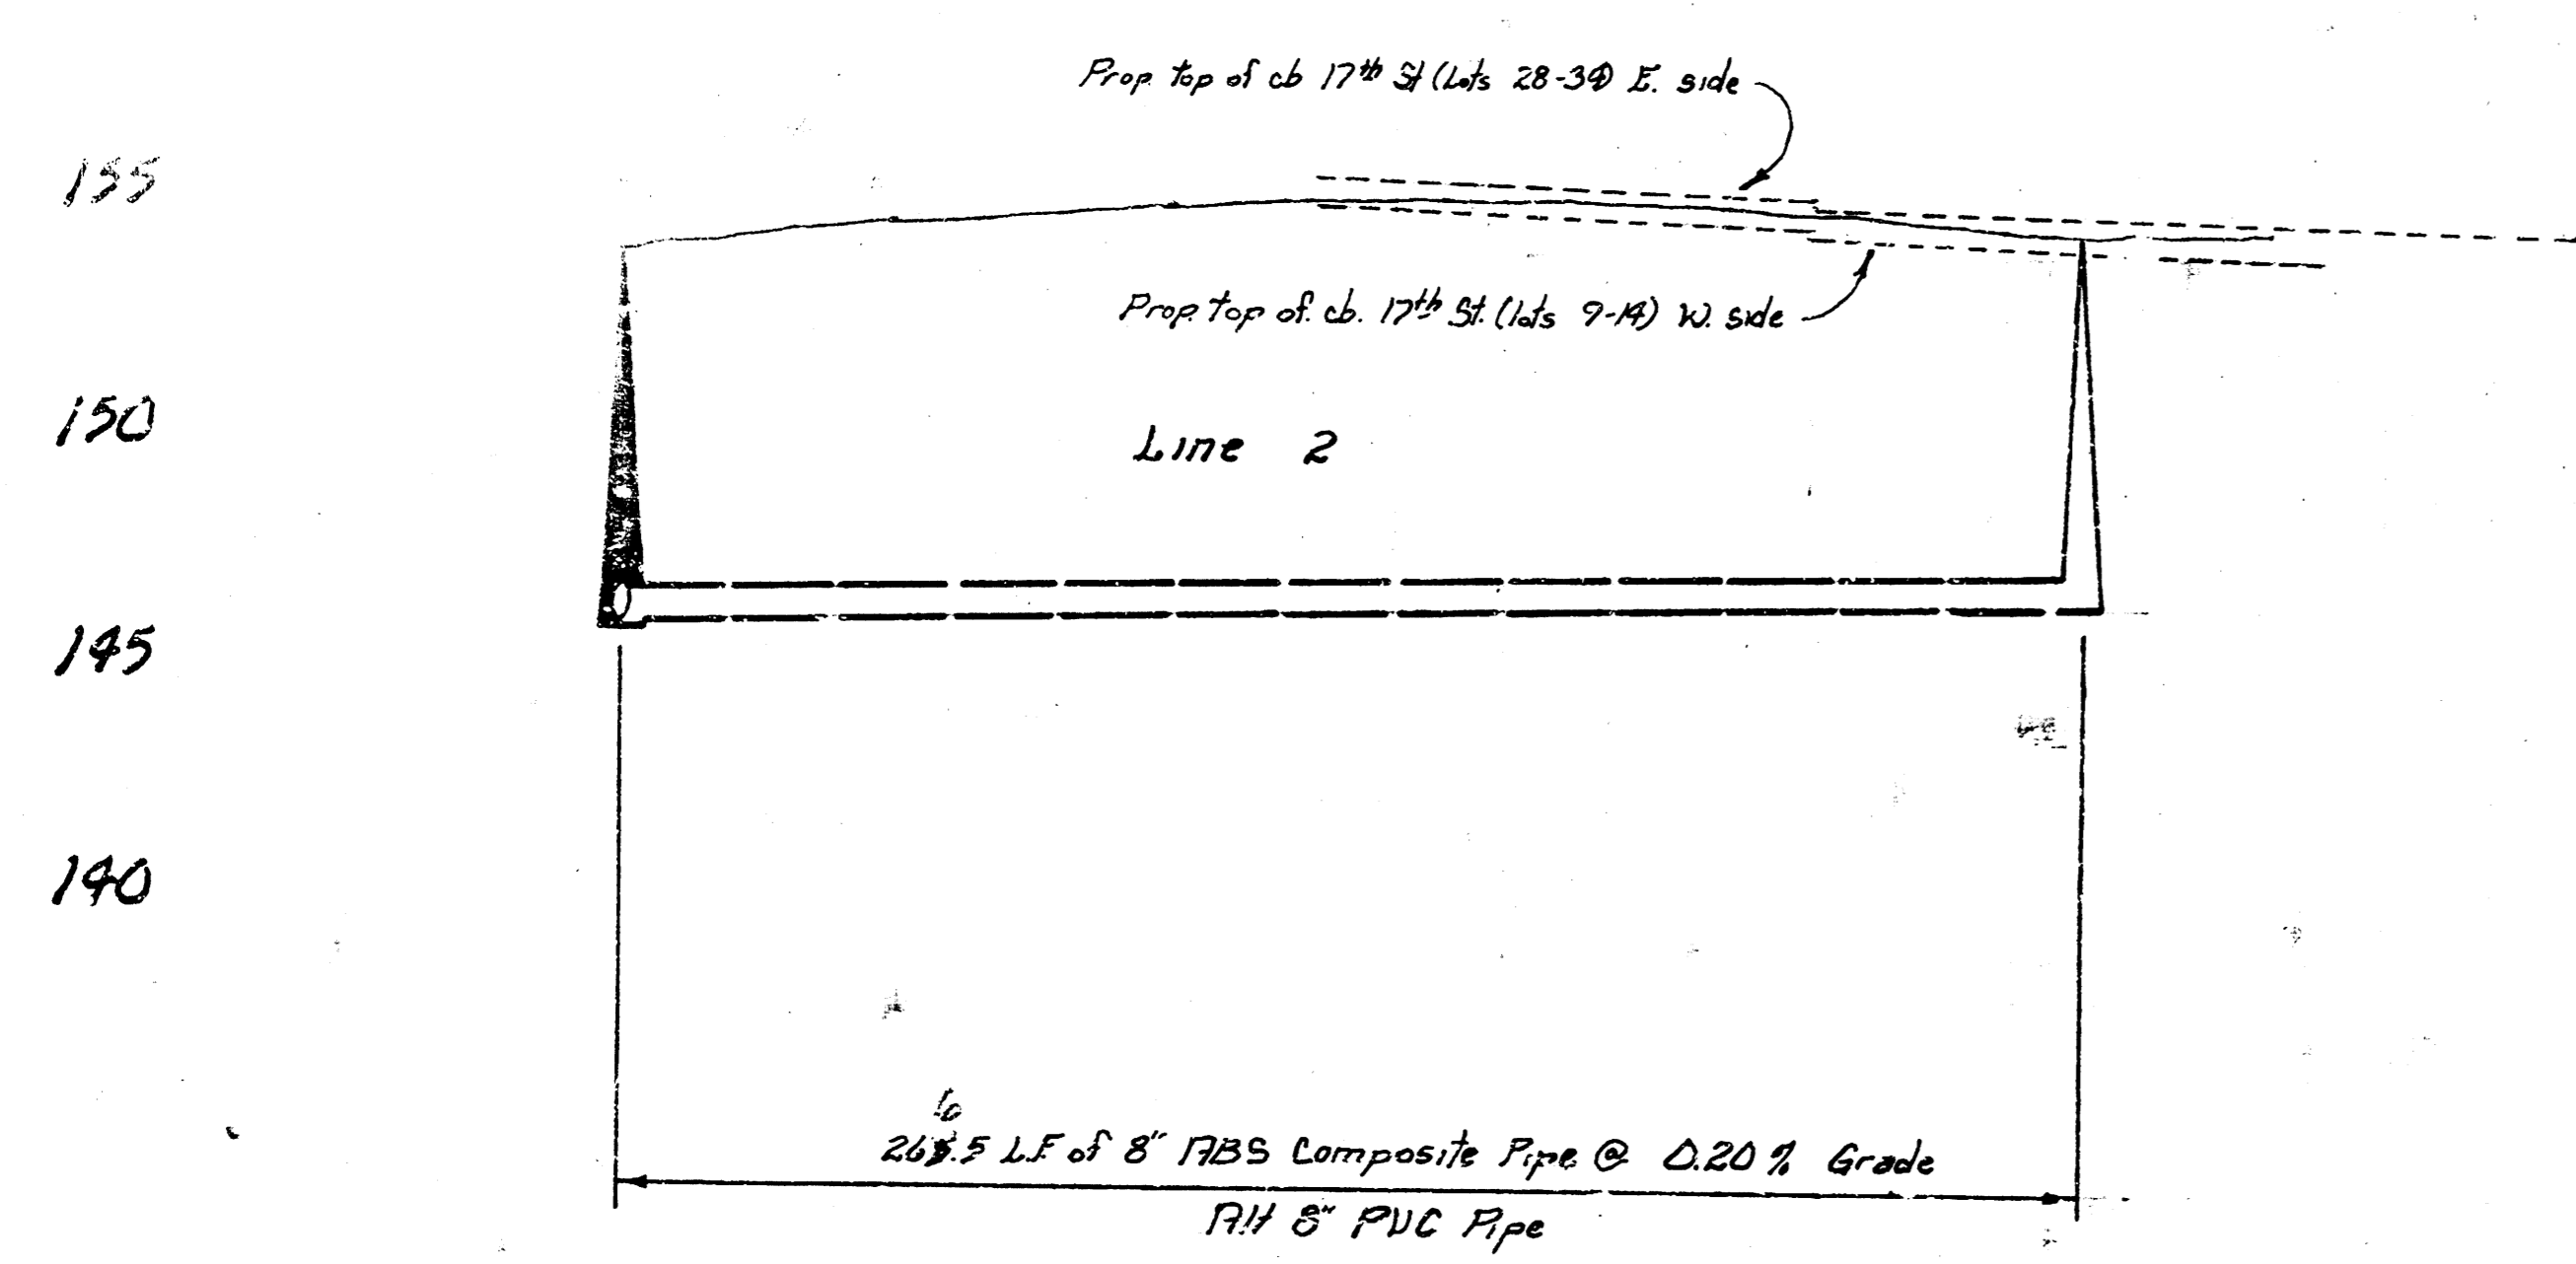

146.93 14 Out  
147.03 14 In

147.23

147.63



147.56

142.78 14 Out  
142.98 14 In



143.18


143.68

143.68 14

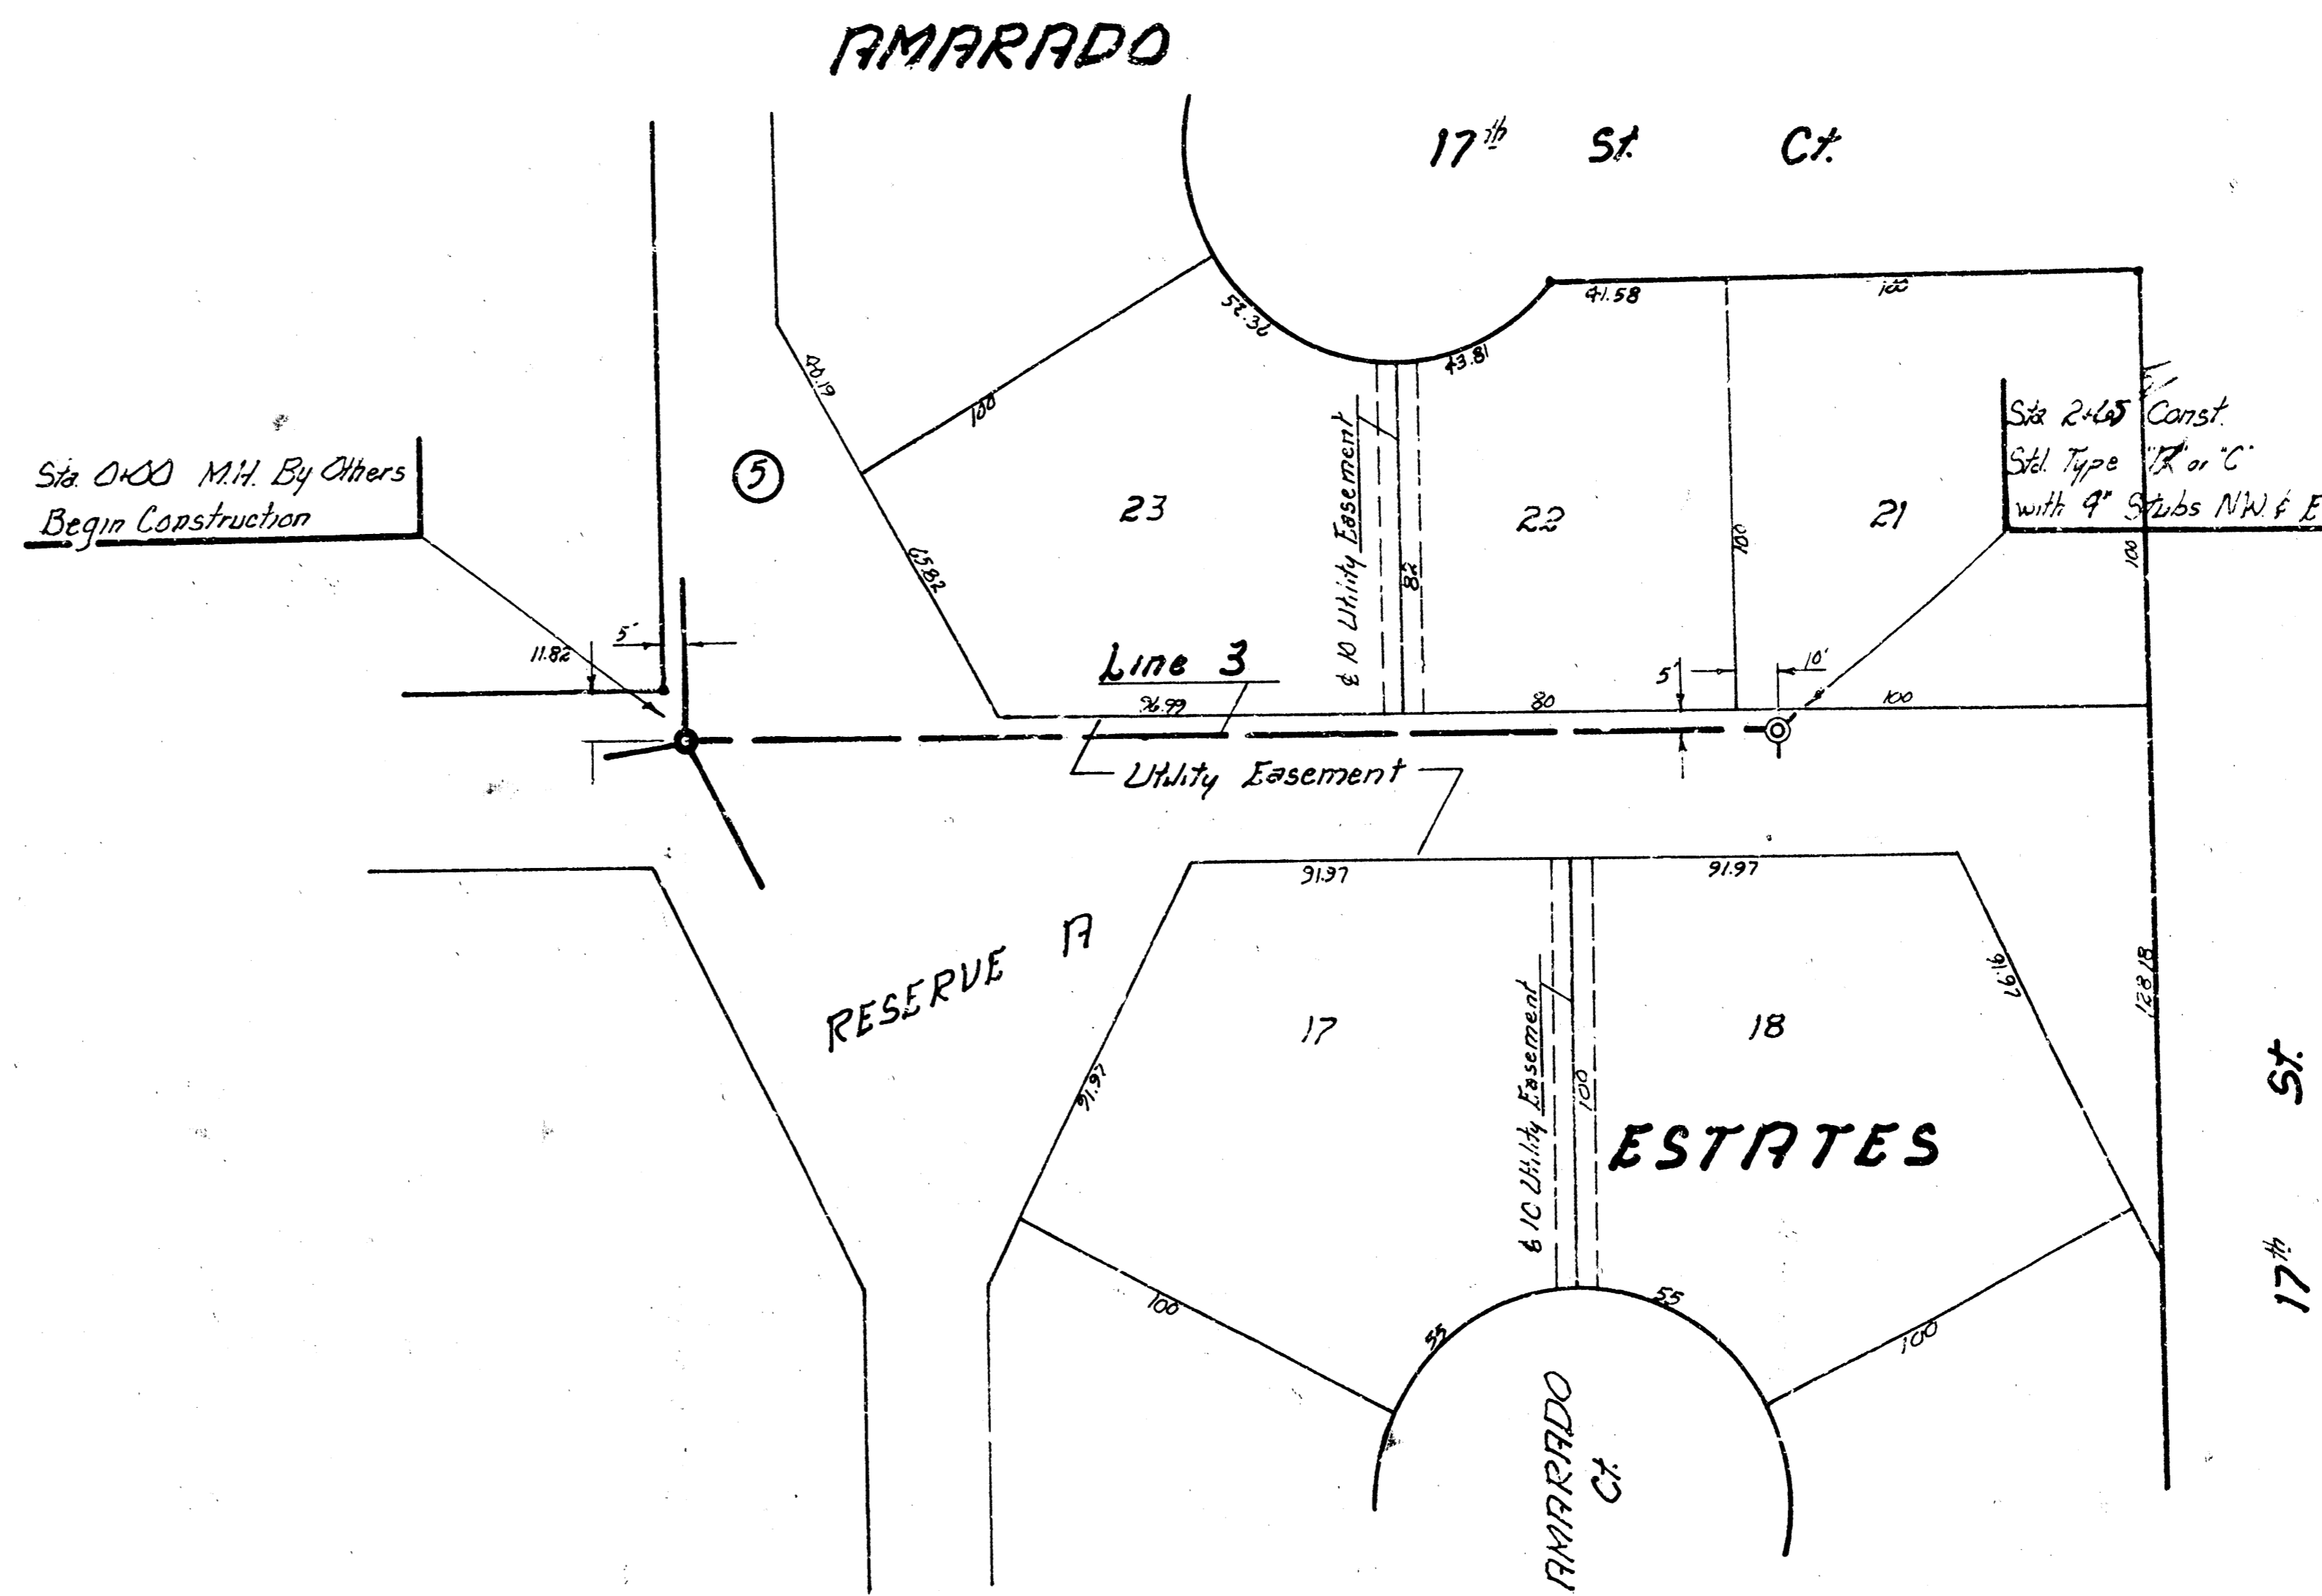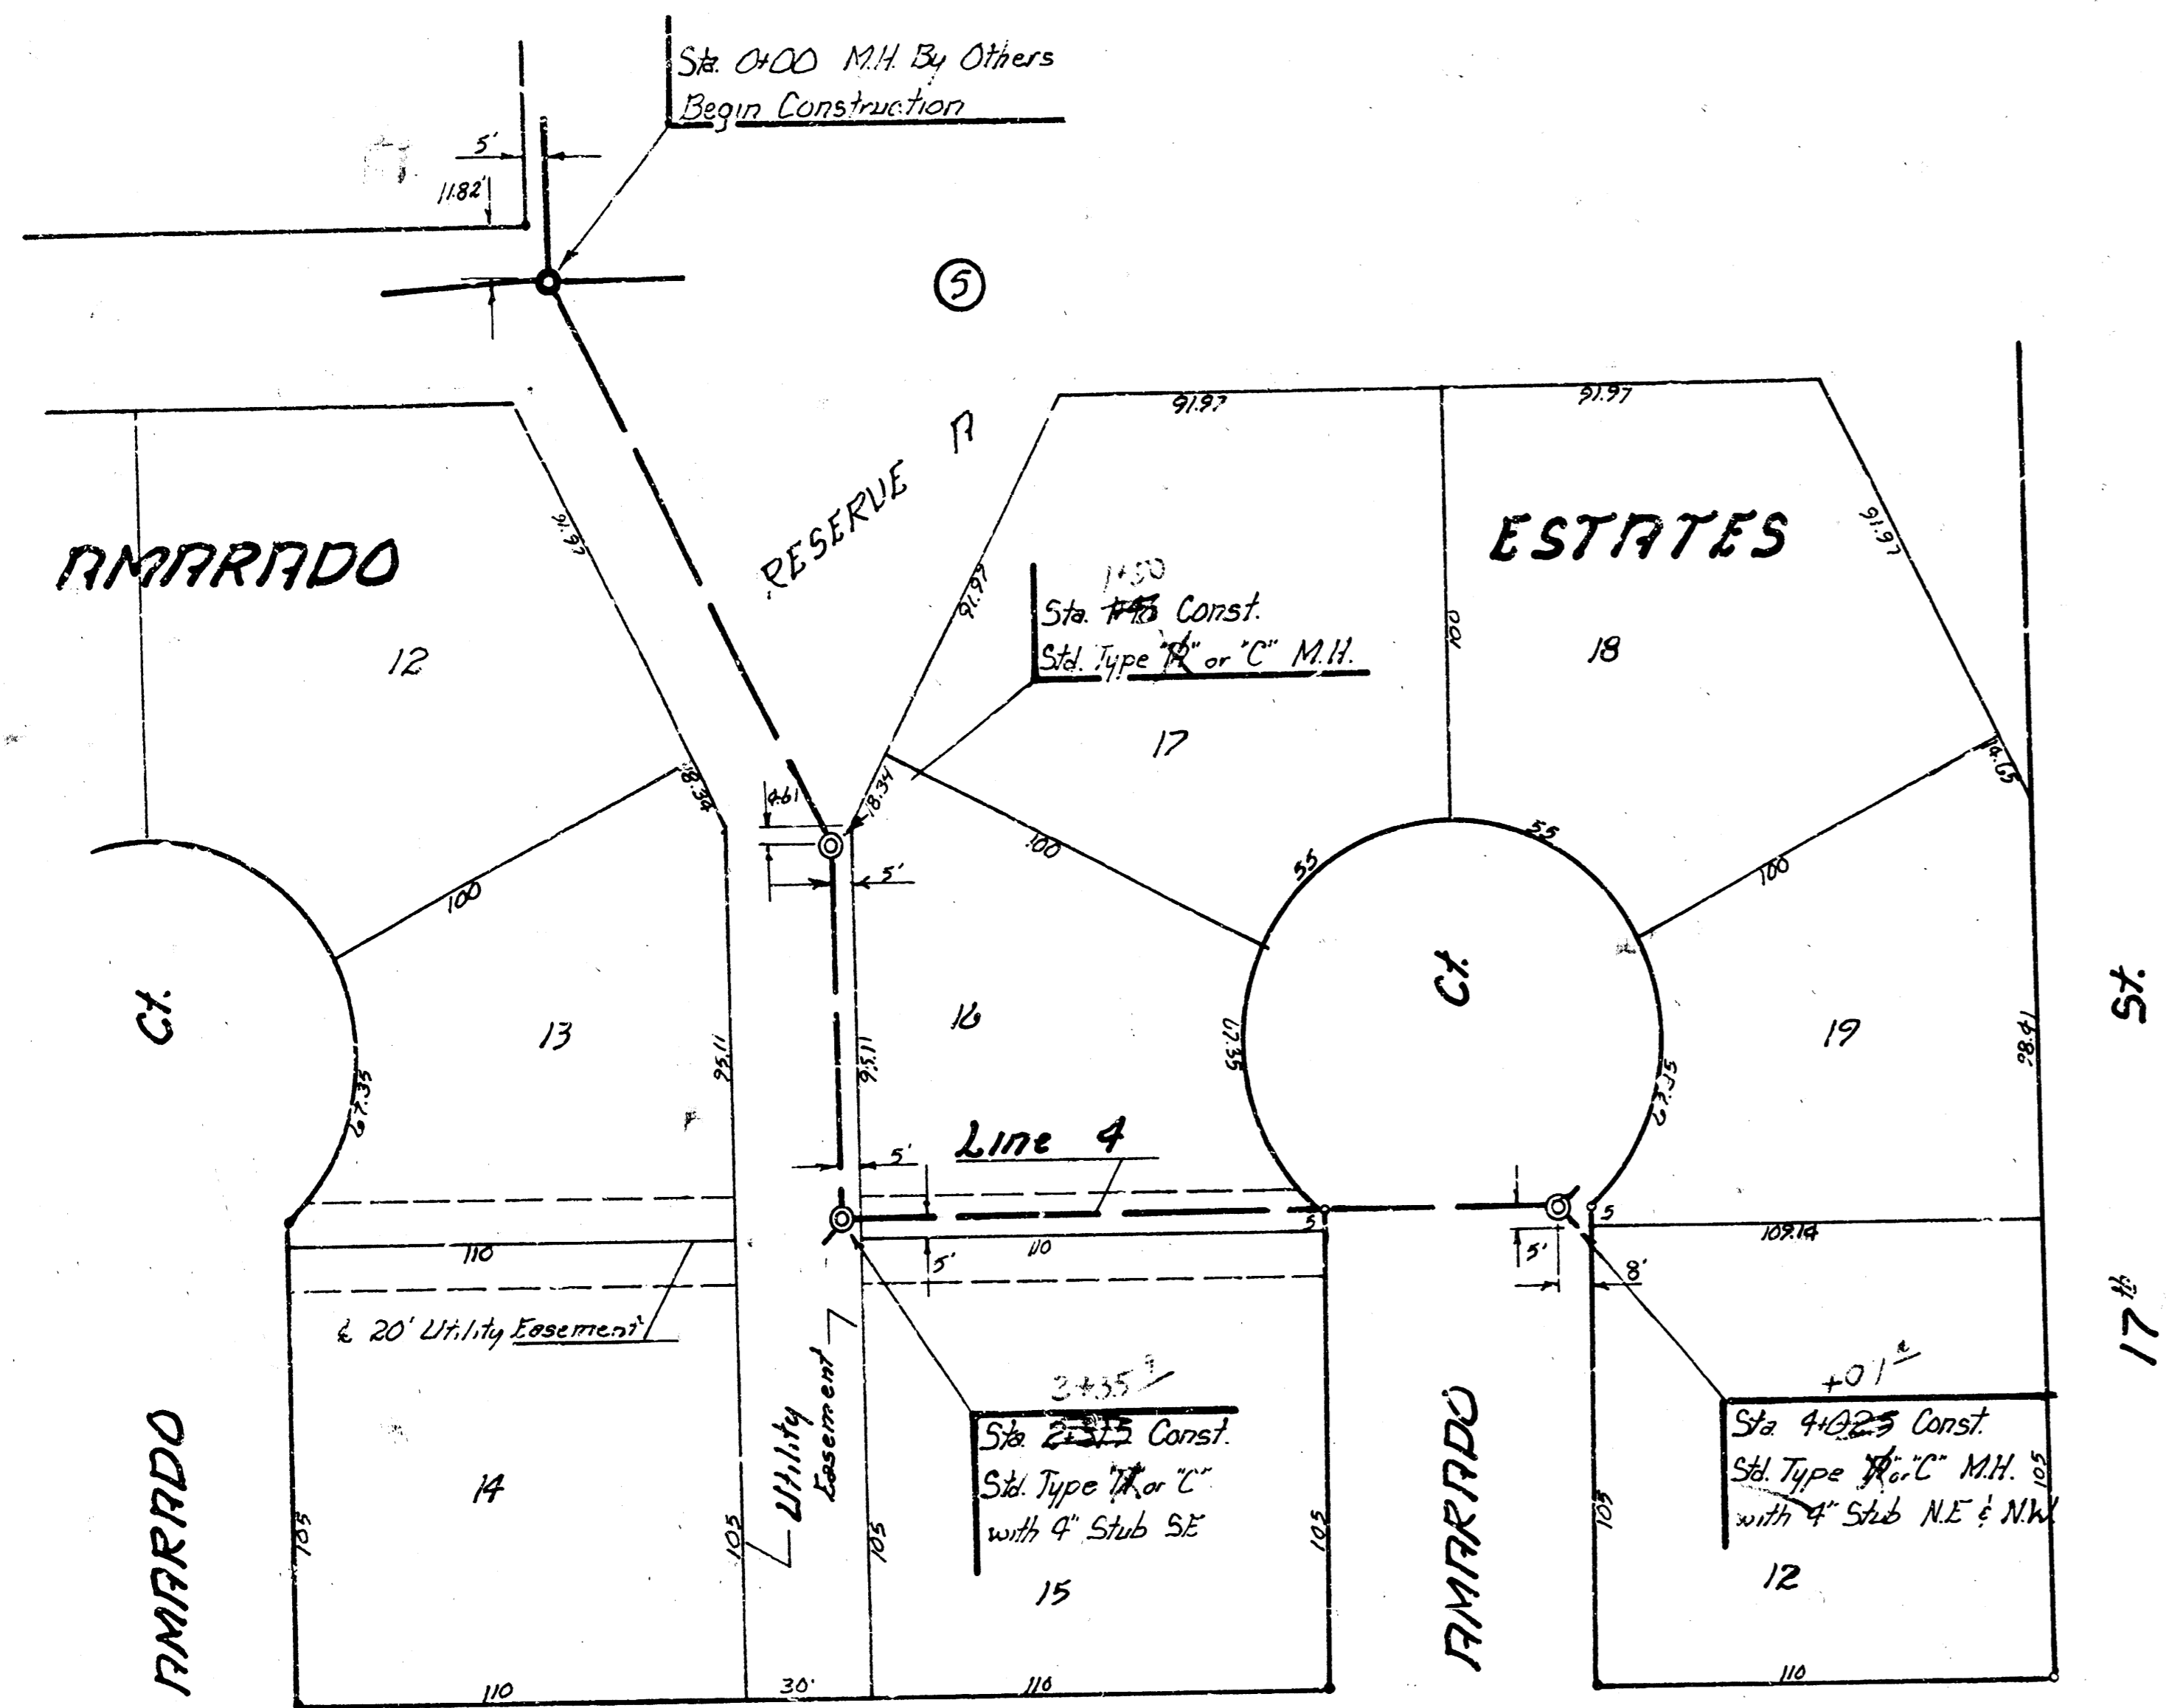


SCALE  
 Plan 1" = 20'  
 Profile 1" = 5'  
 Vert 1" = 5'  
 Horiz 1" = 20'

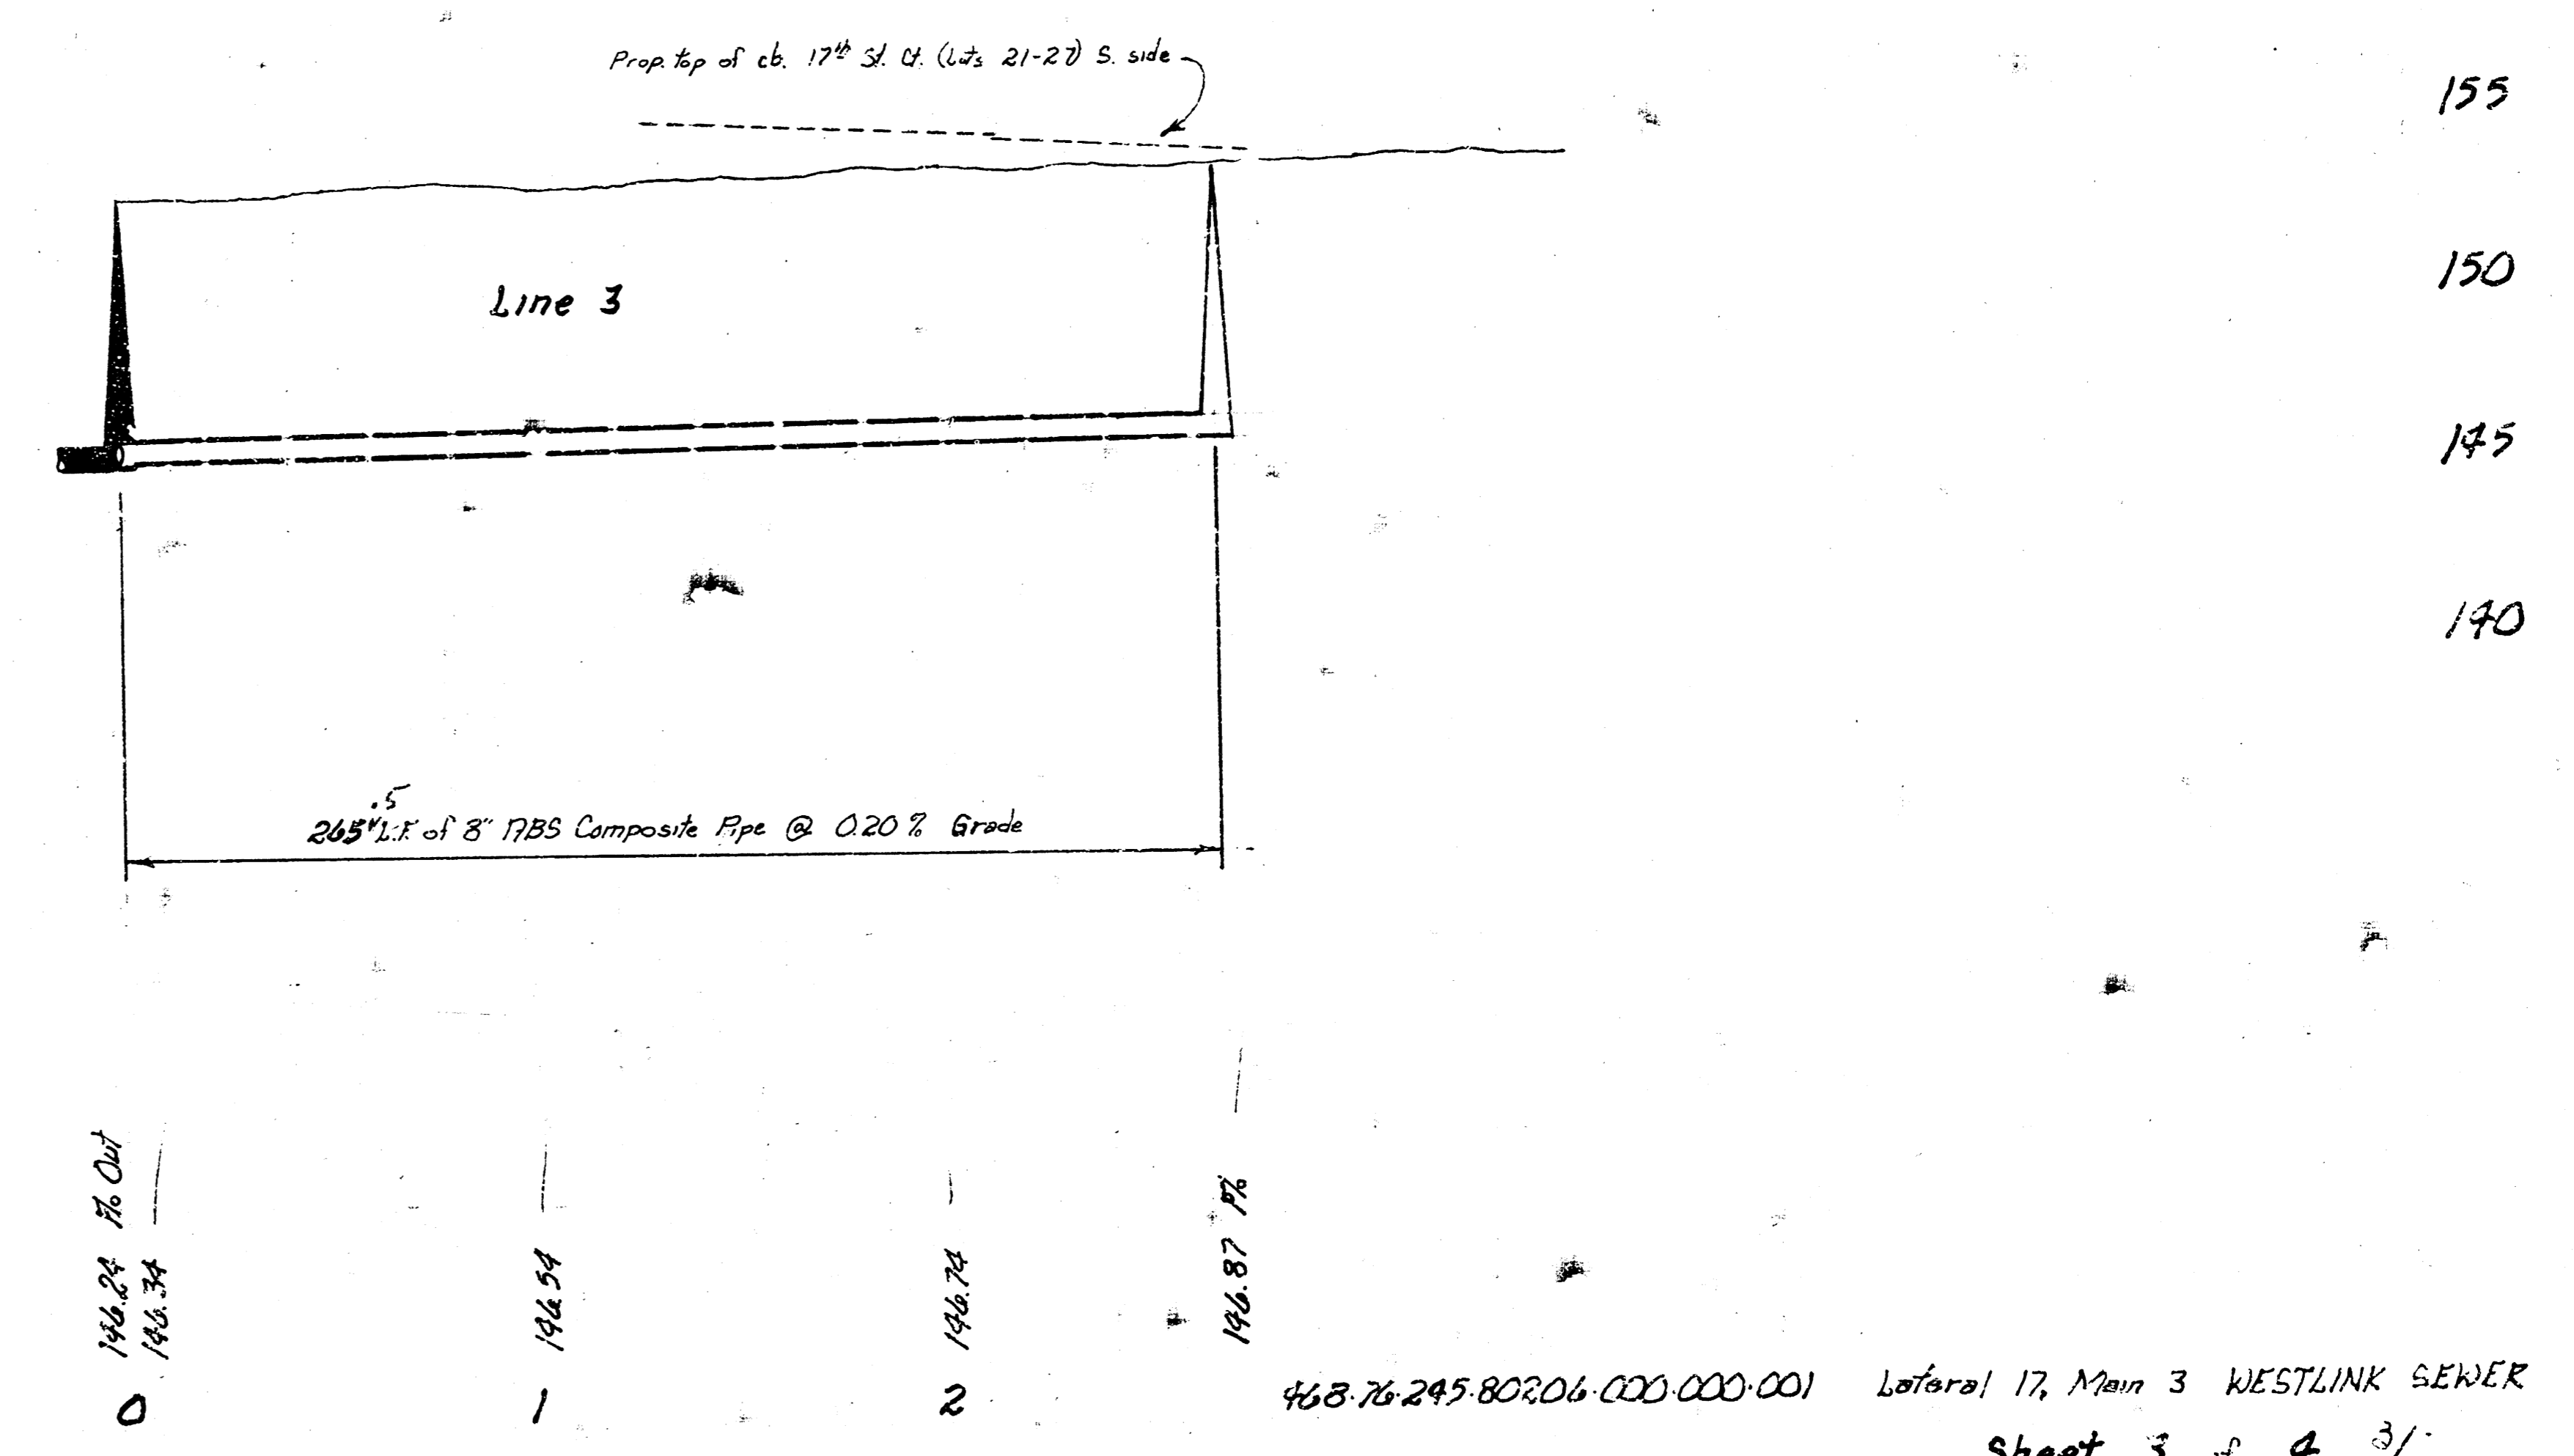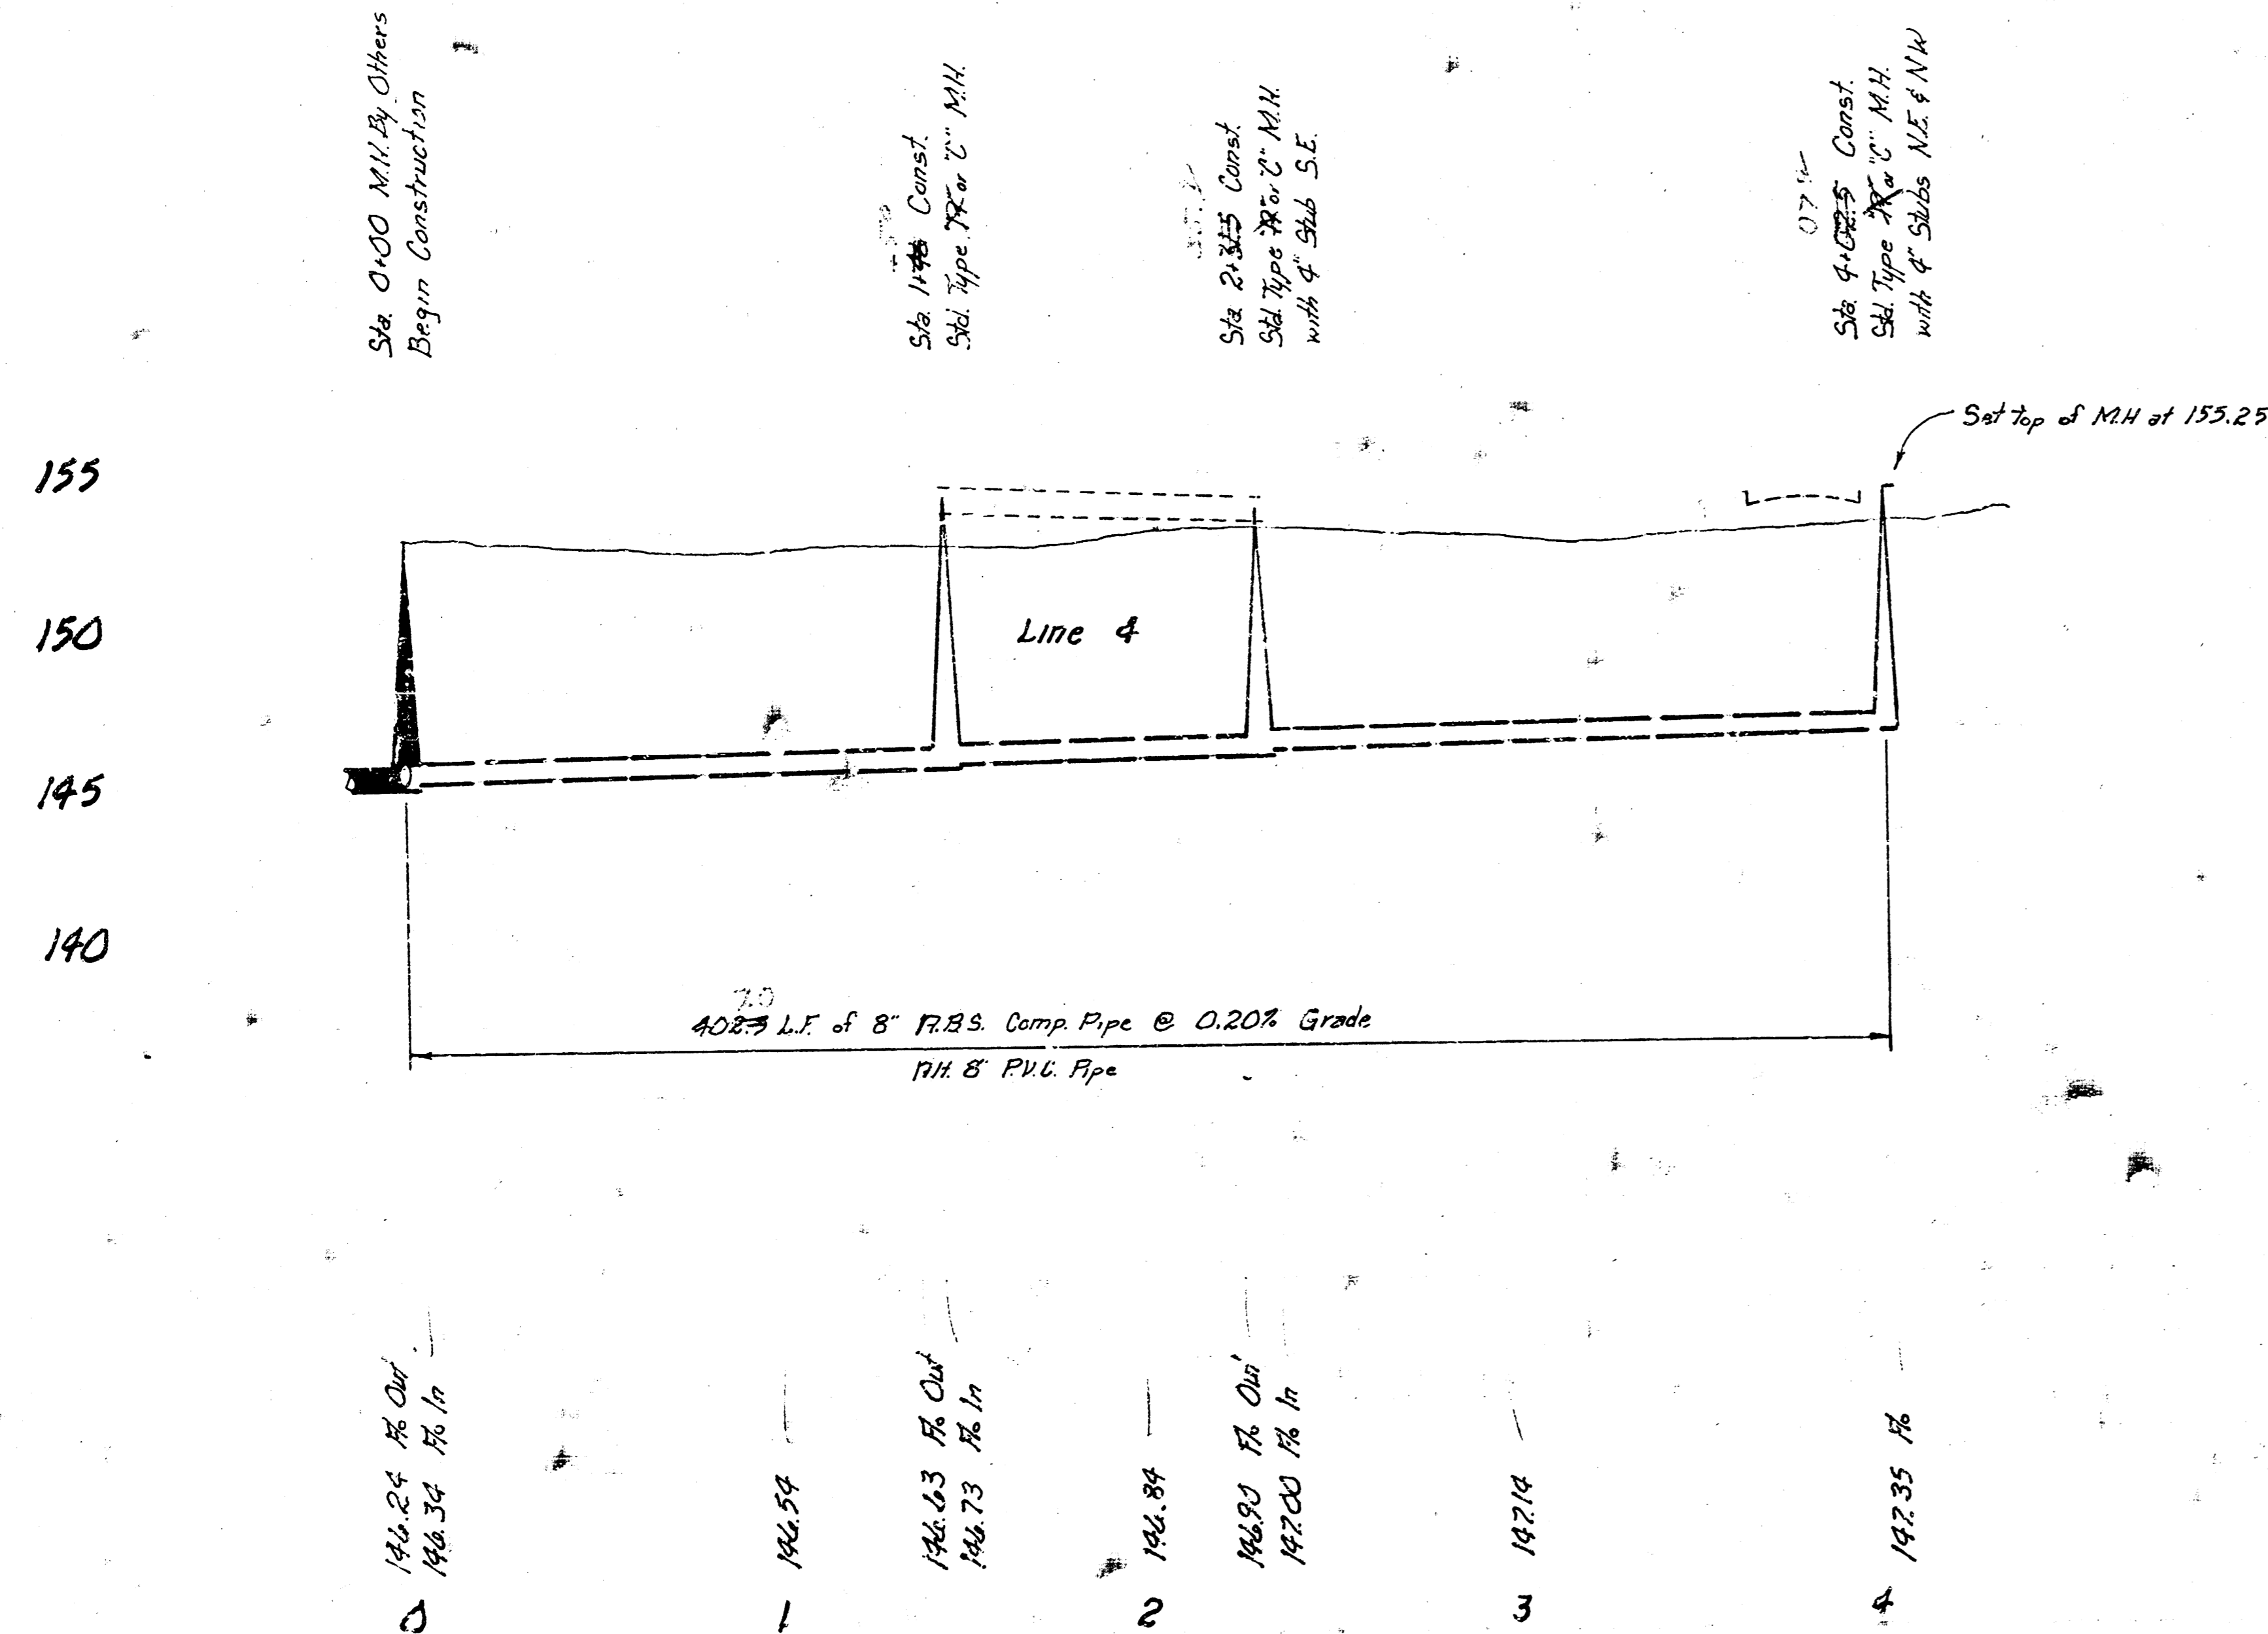

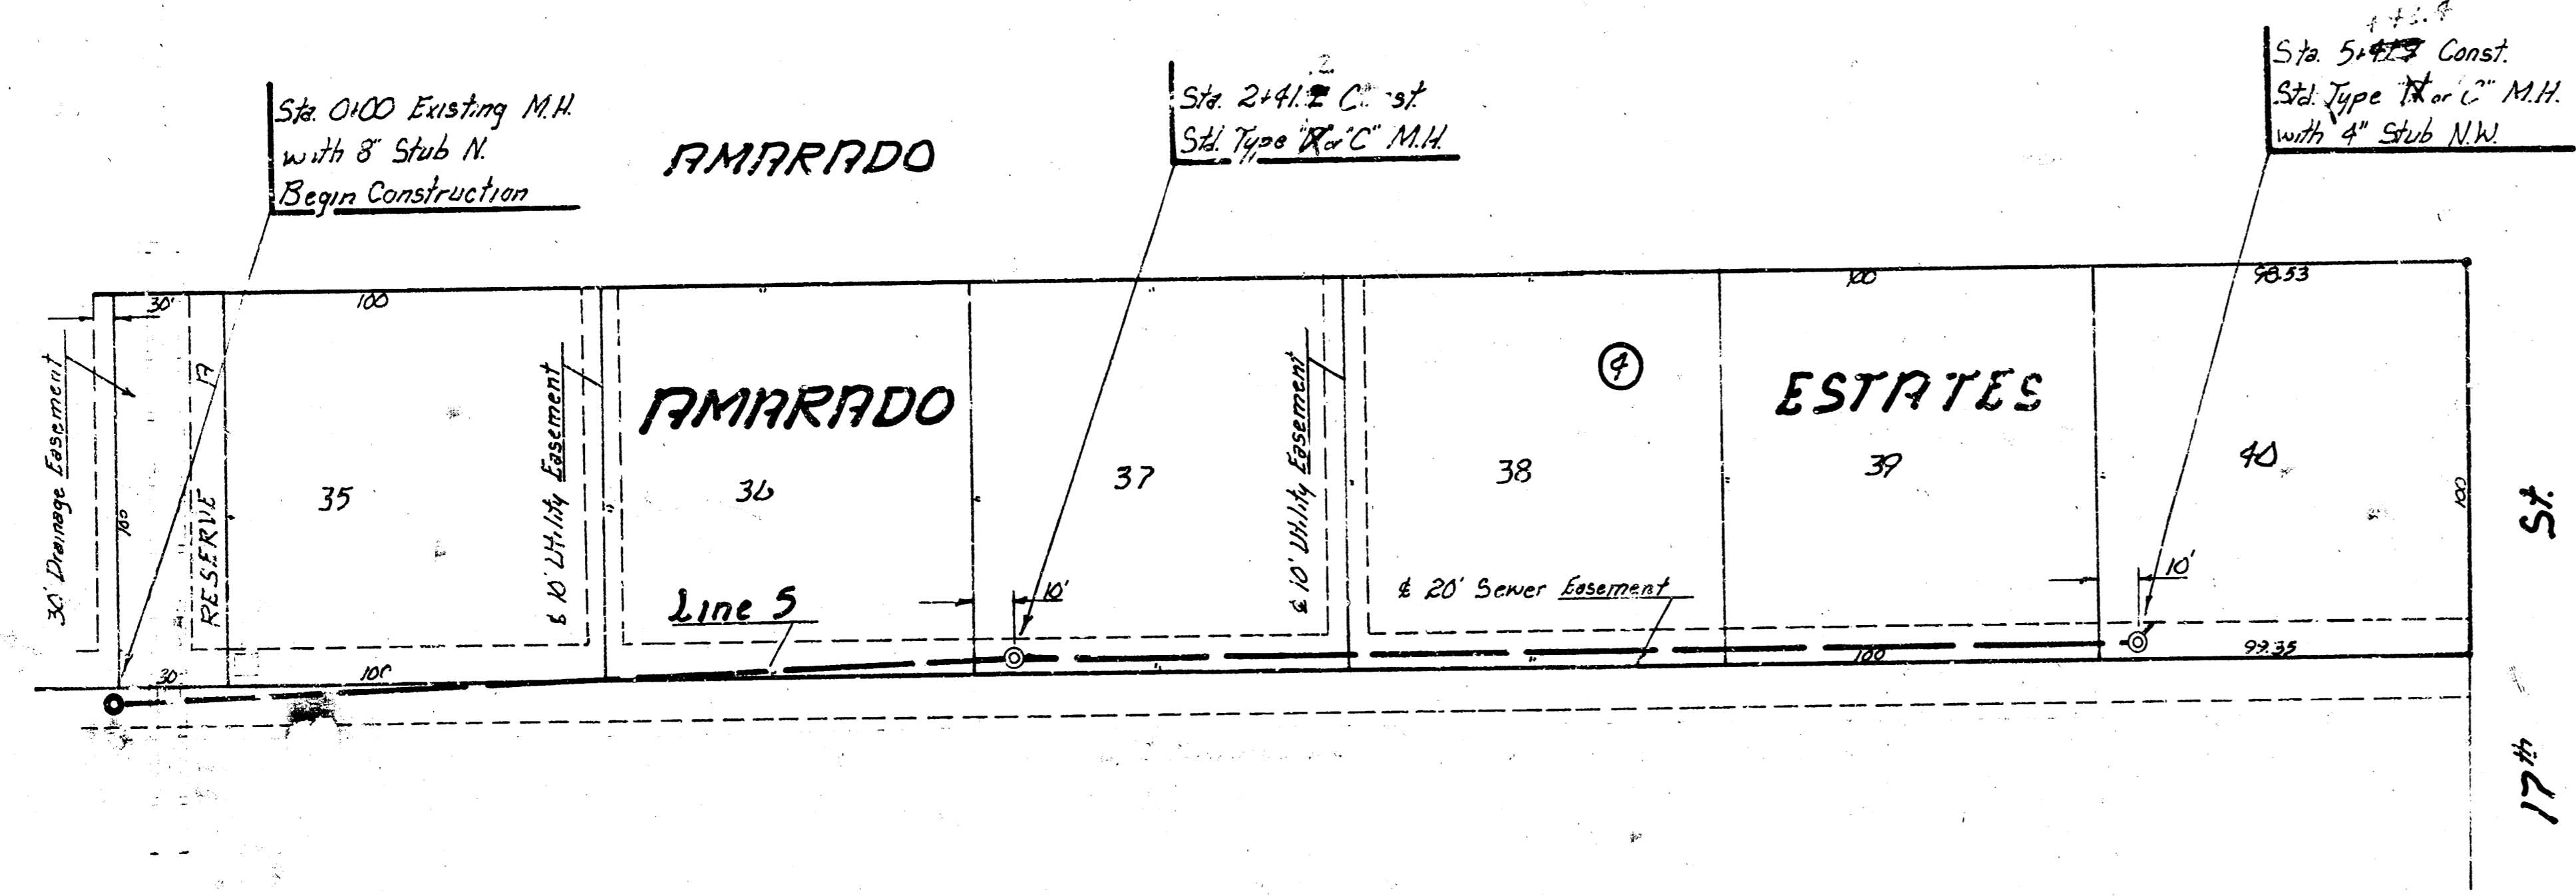

SCALE  
 Plan 1" = 20'  
 Profile 1" = 5'  
 Horiz 1" = 20'

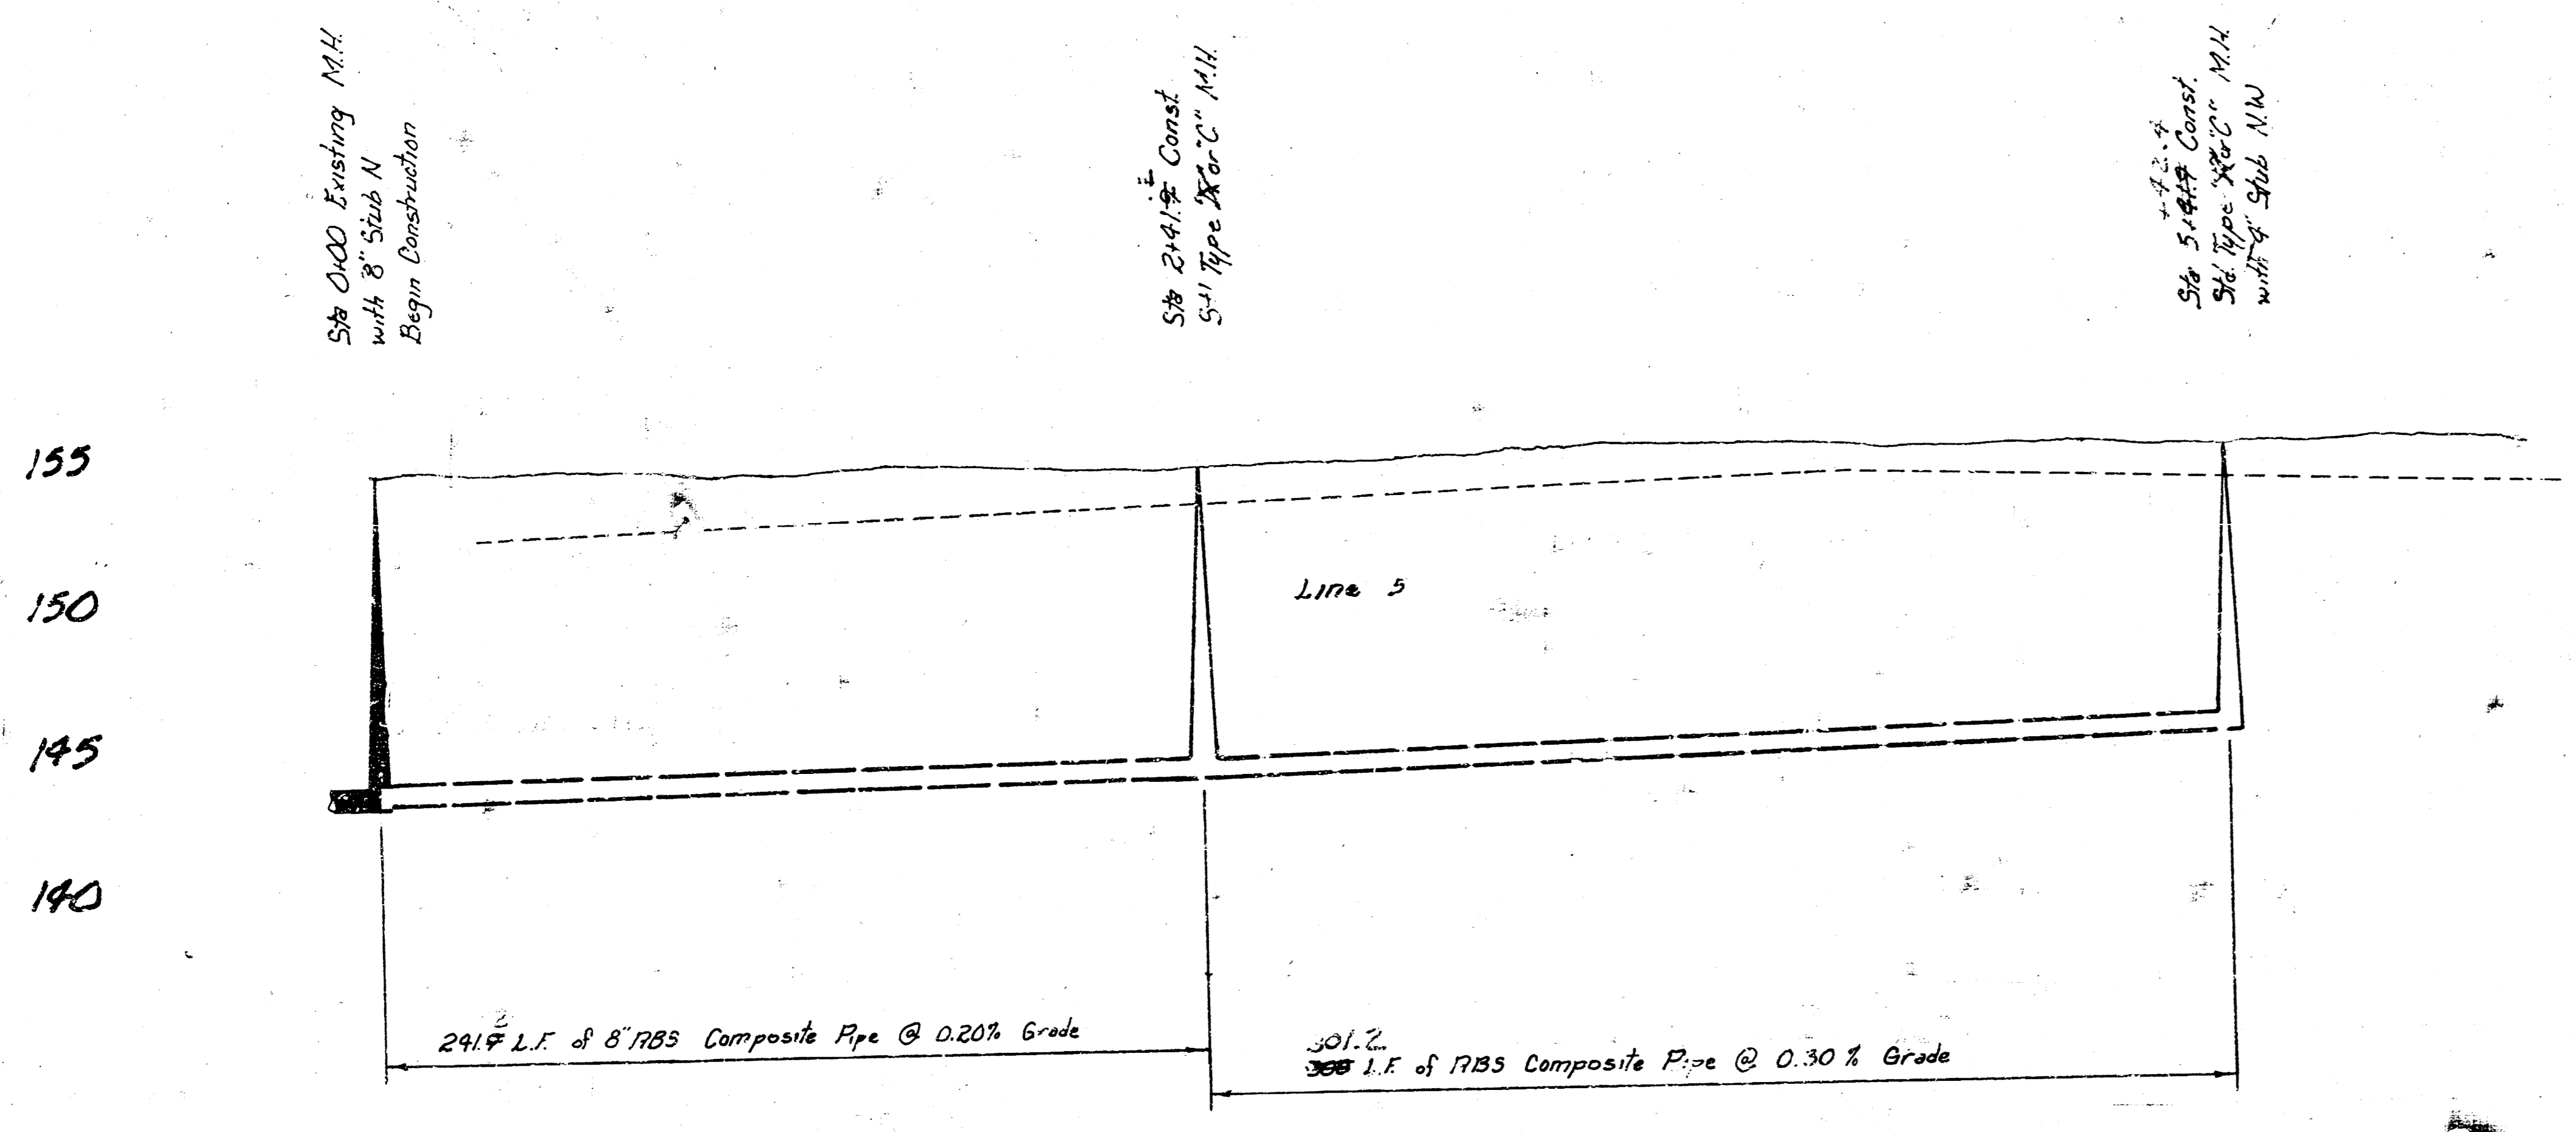

14390 R.W.  
 14401 R.W.  
 14421  
 14441  
 14449 R.  
 14466  
 14496  
 14526  
 14539 R.