


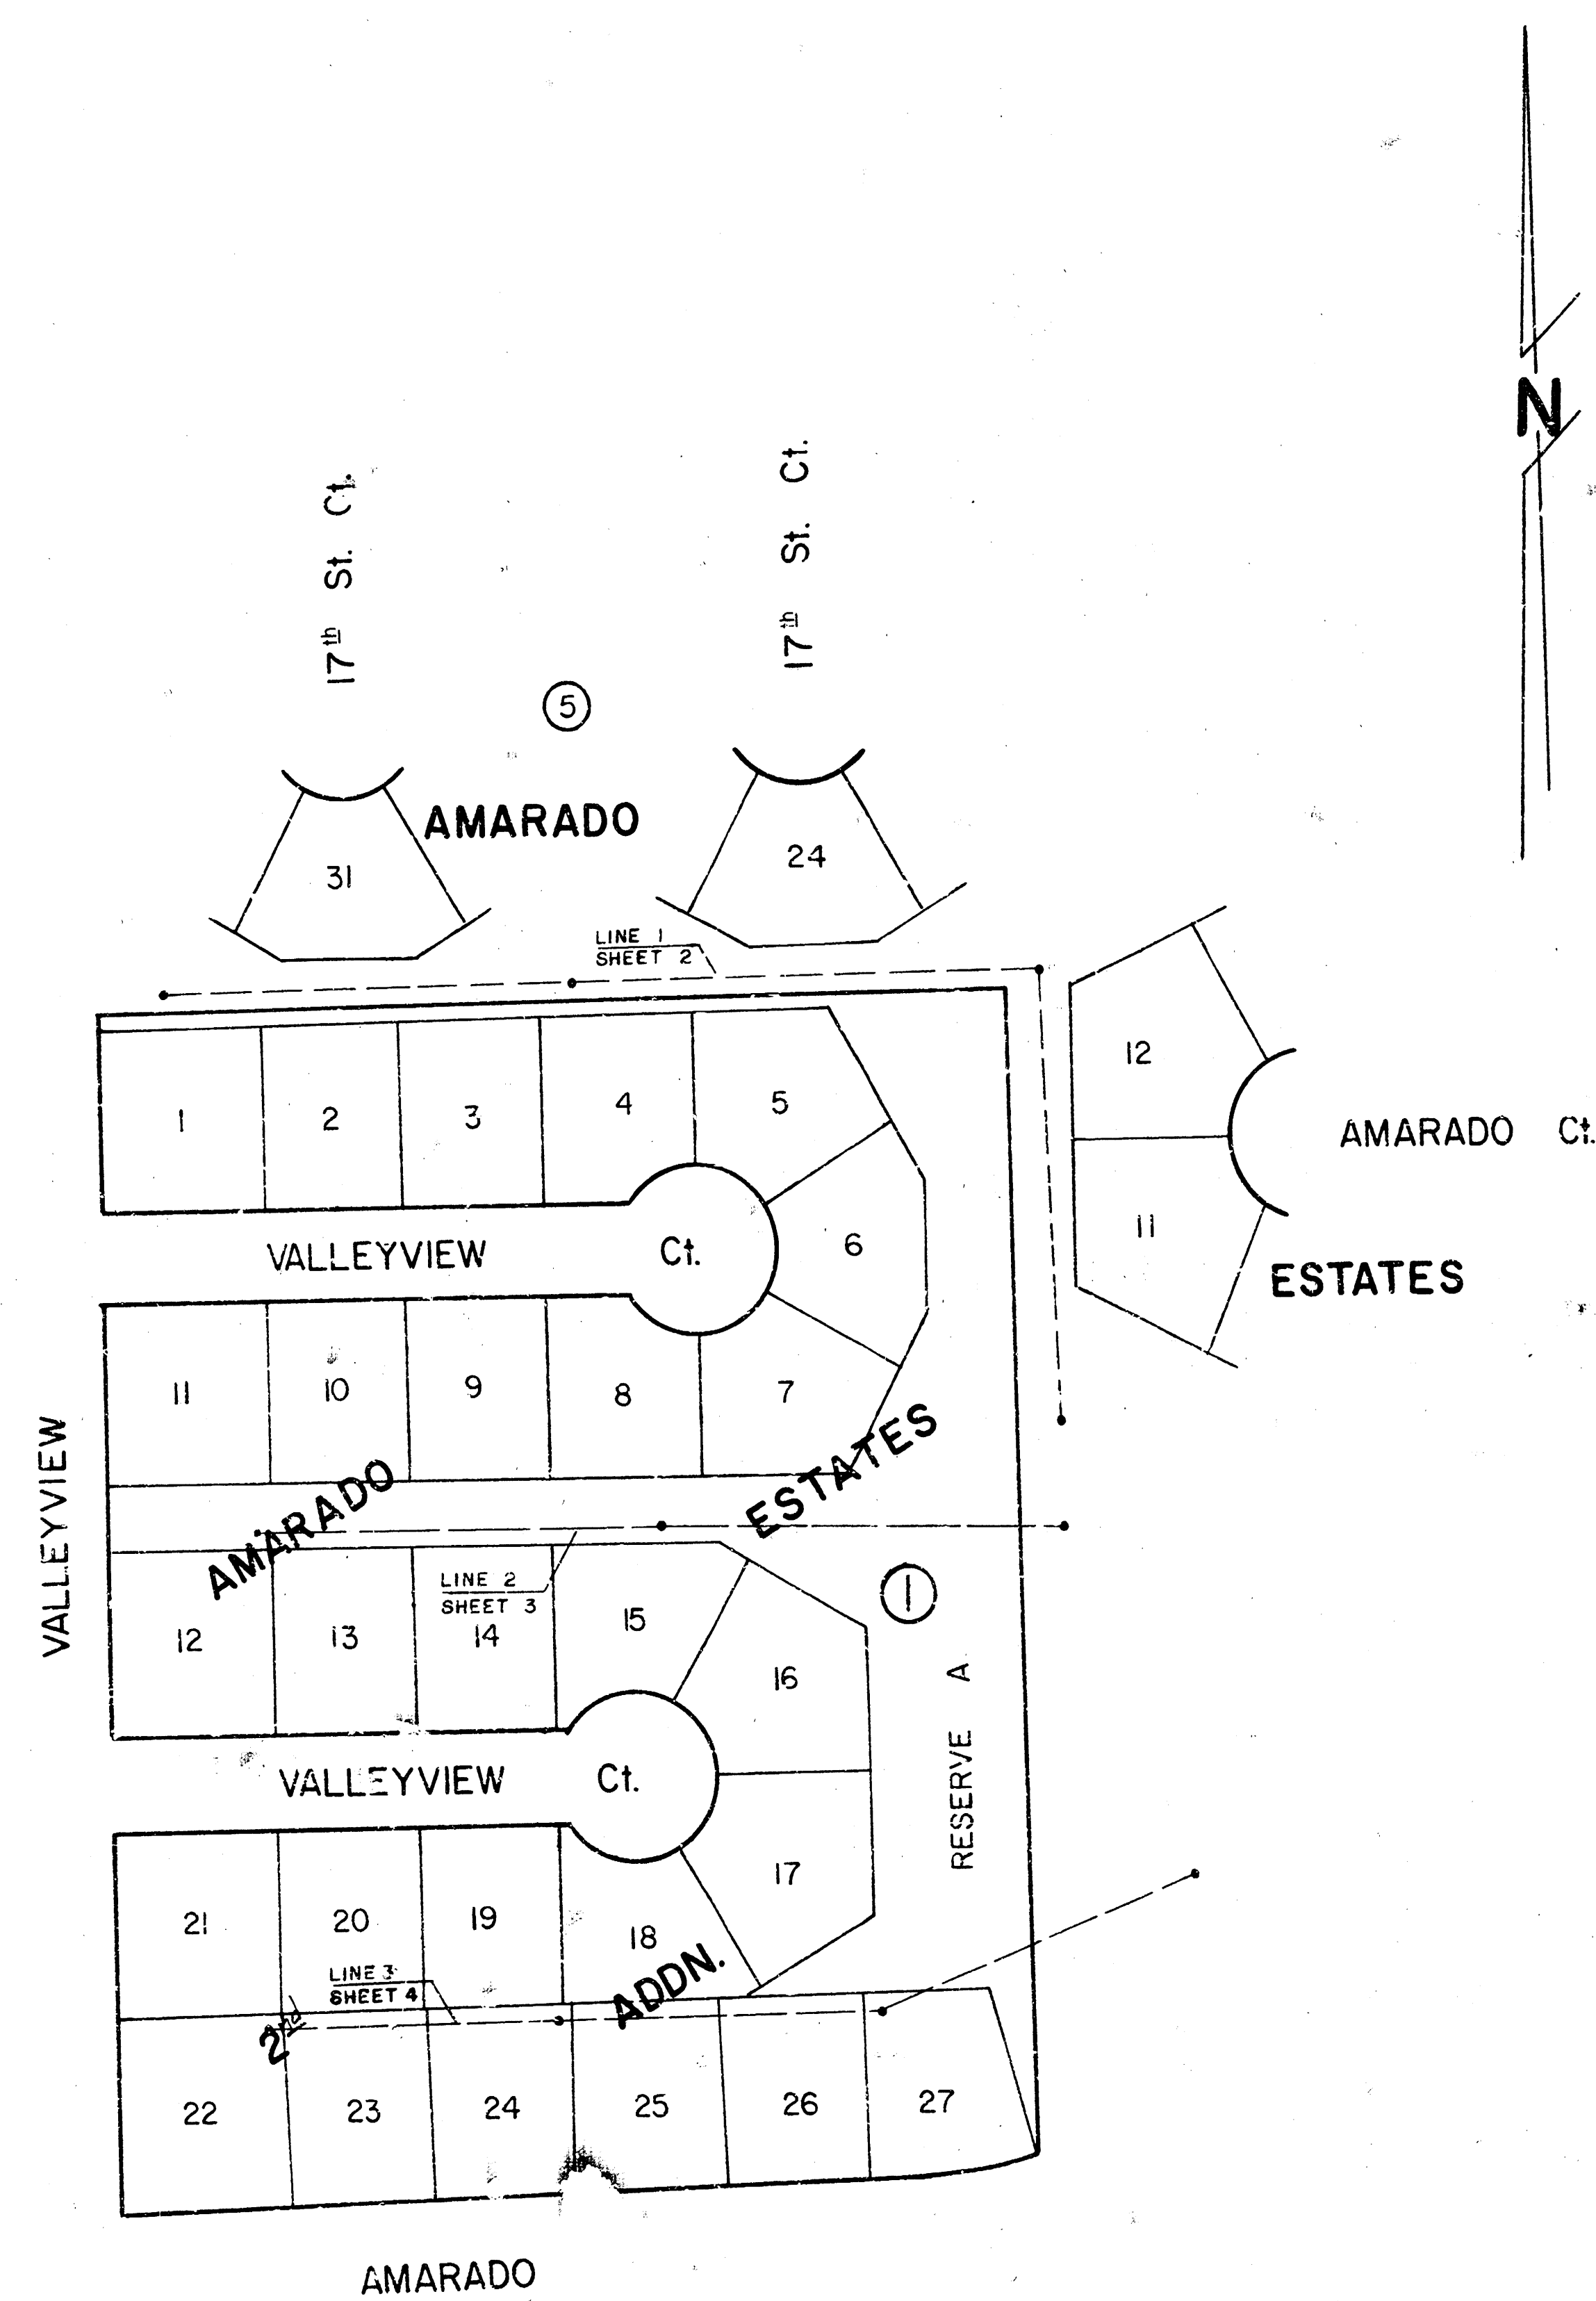



LATERAL 20, MAIN 3, WESTLINK SEWER

City of WICHITA, KANSAS Dean Sellers — City Engineer

Project No. : 468-76-245-80815-000-000-001


Date: _____

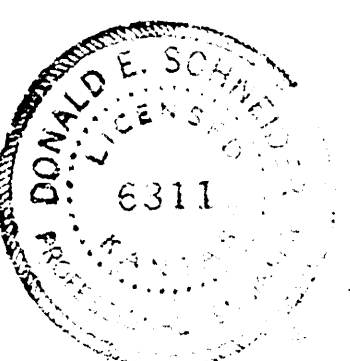

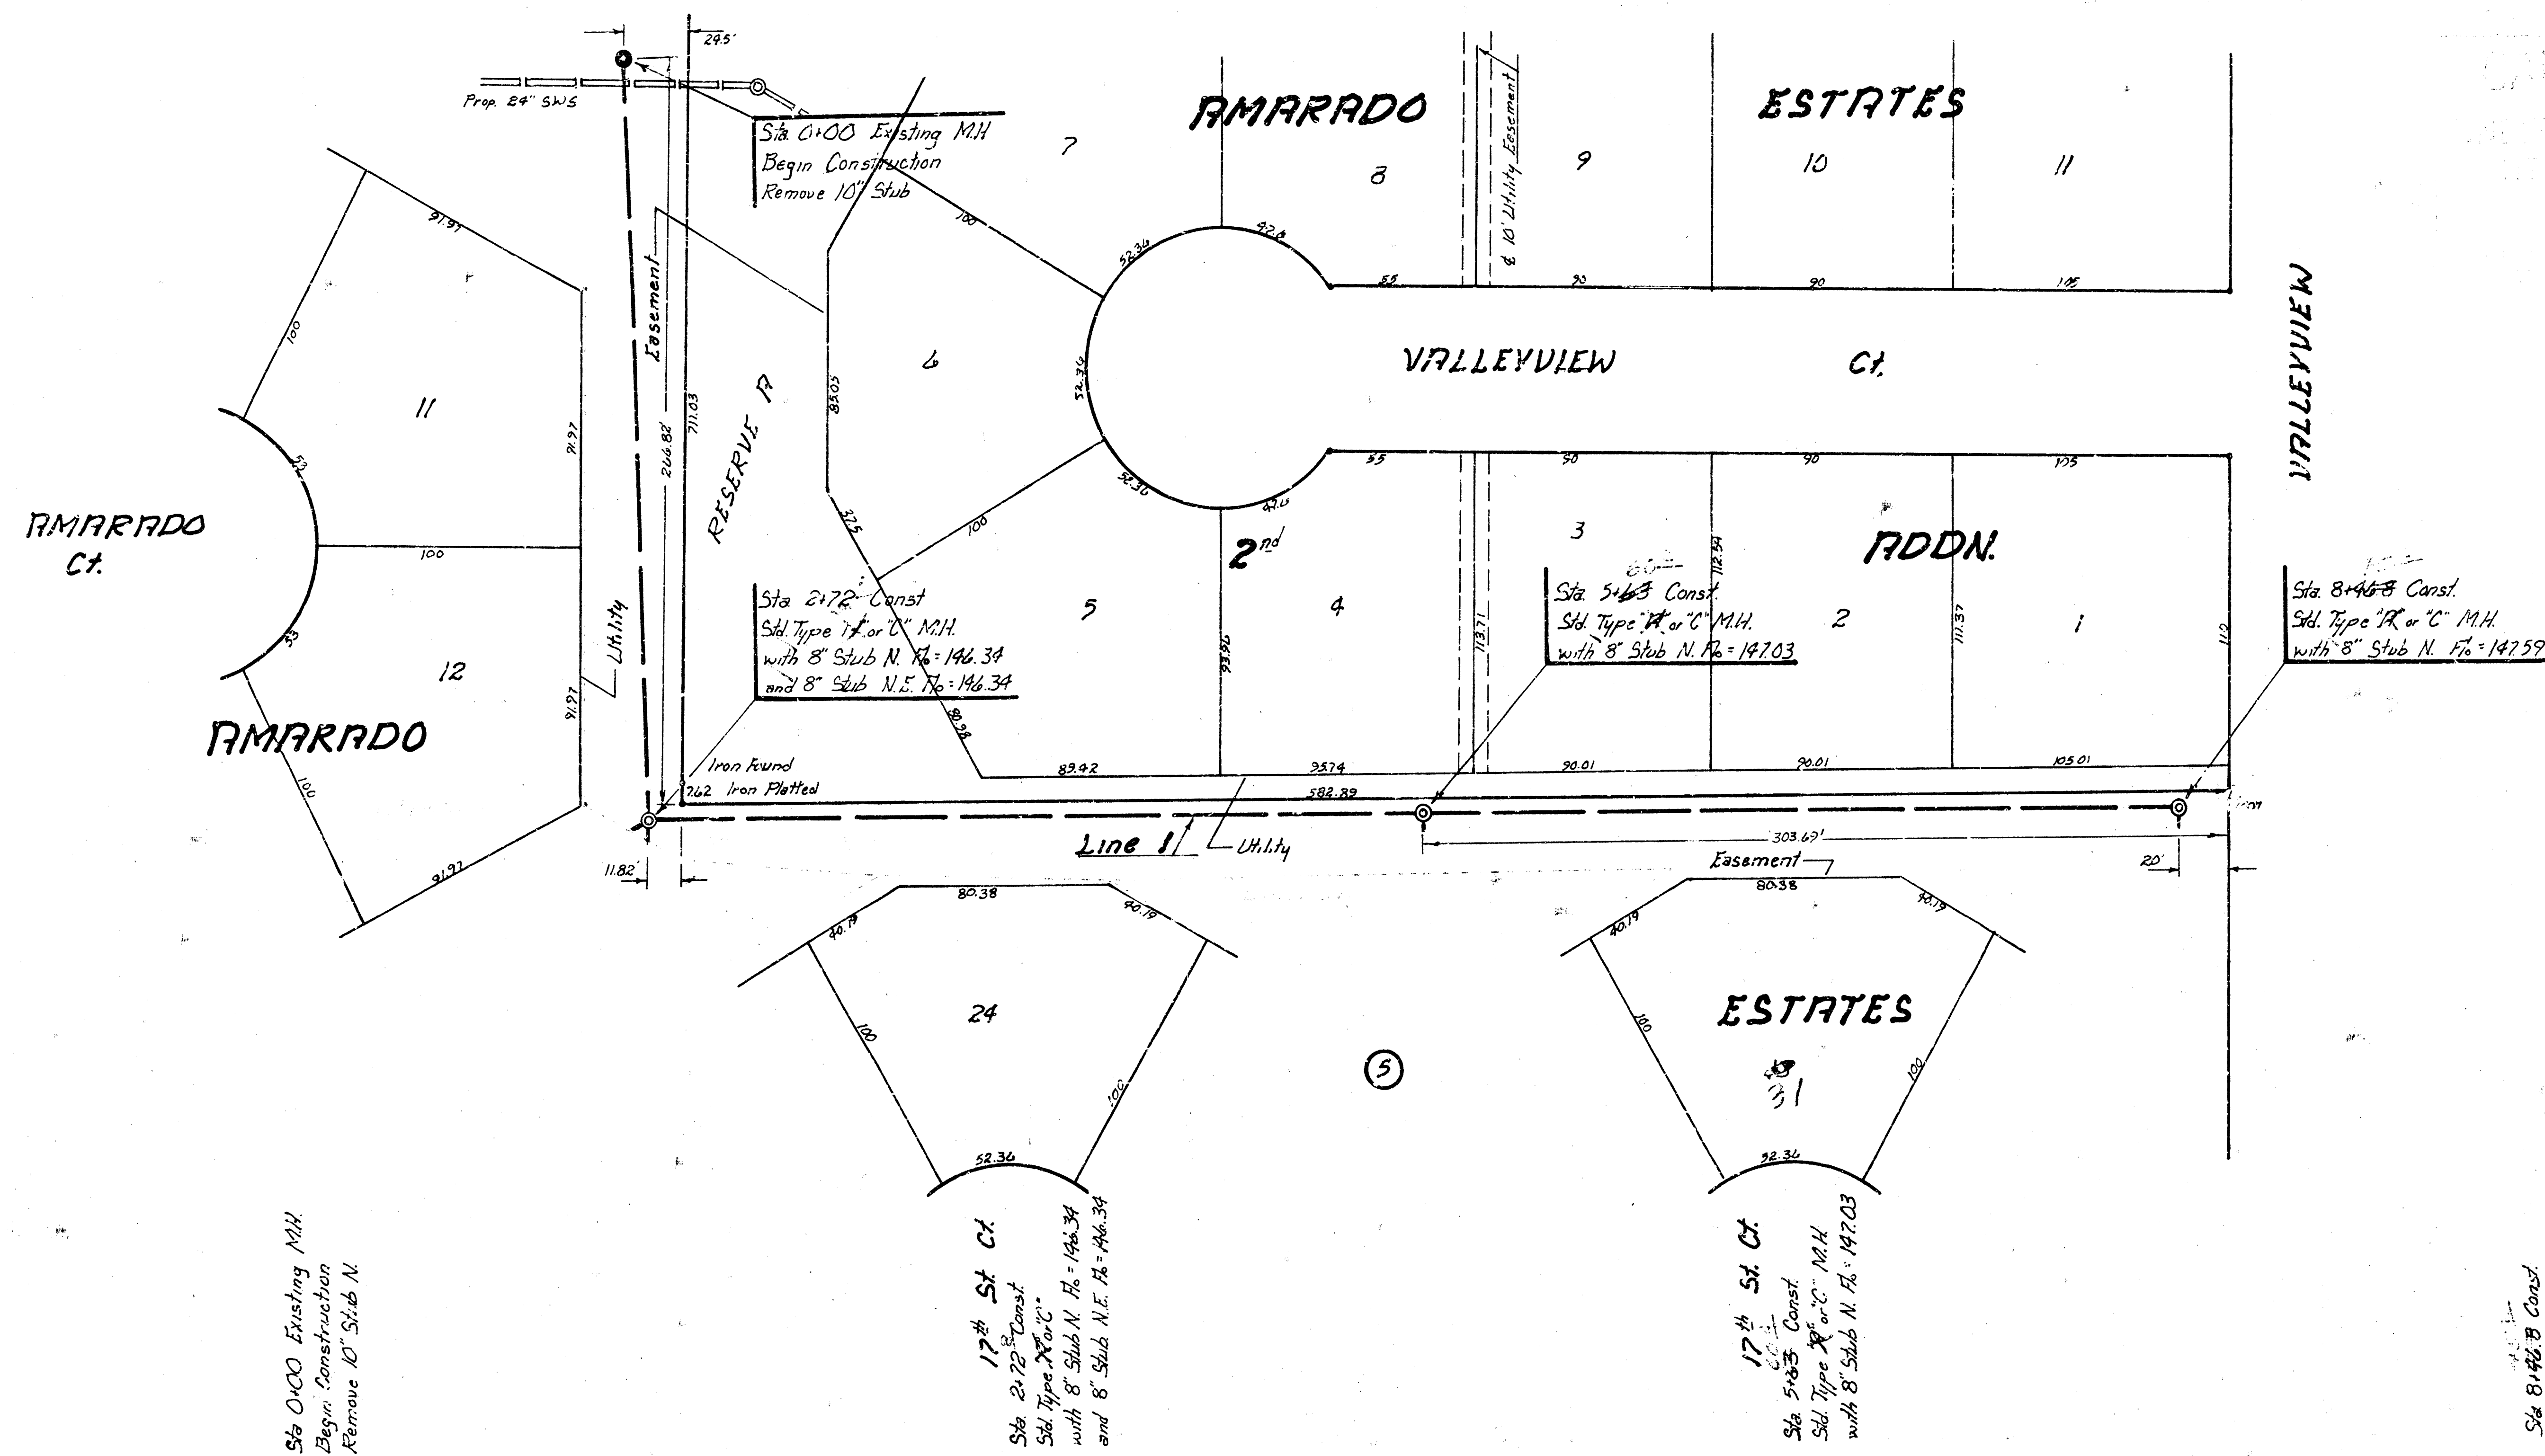


SCALE
 Plan 1" = 20'
 Profile 1" = 5'
 Vert 1" = 5'
 Horiz 1" = 20'

155
 150
 145
 140

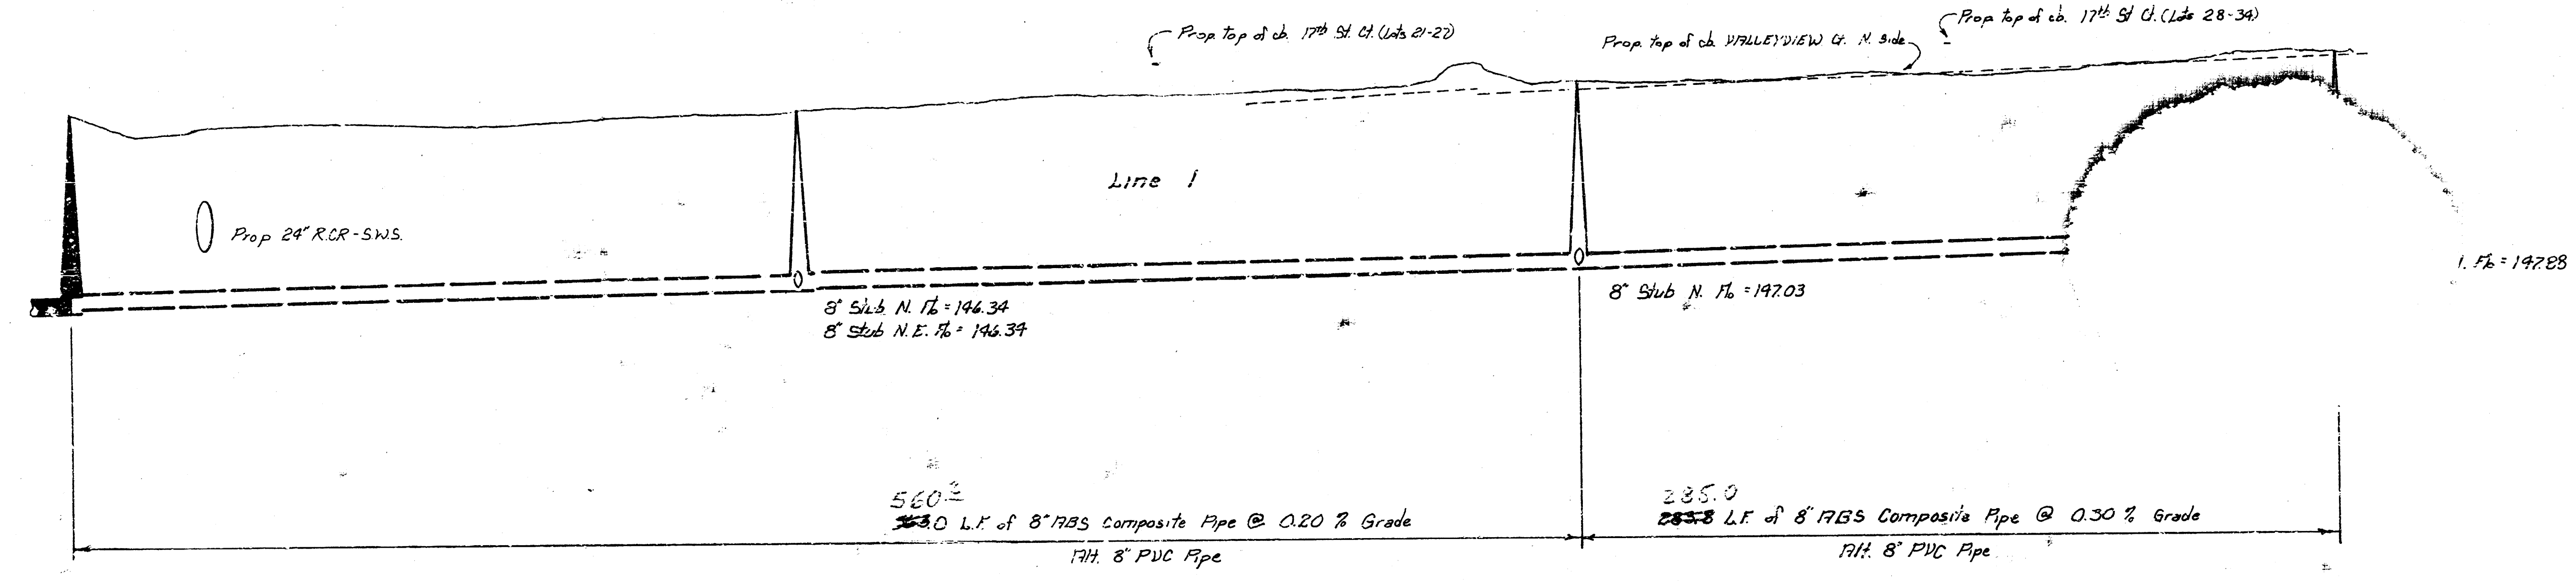


145.41 ft. Out
 145.20 ft. In
 145.90
 146.10
 146.24 ft. Out
 146.39 ft. In
 146.40
 146.60
 146.80
 146.93 ft.
 147.04
 147.34
 147.64
 147.78 ft.

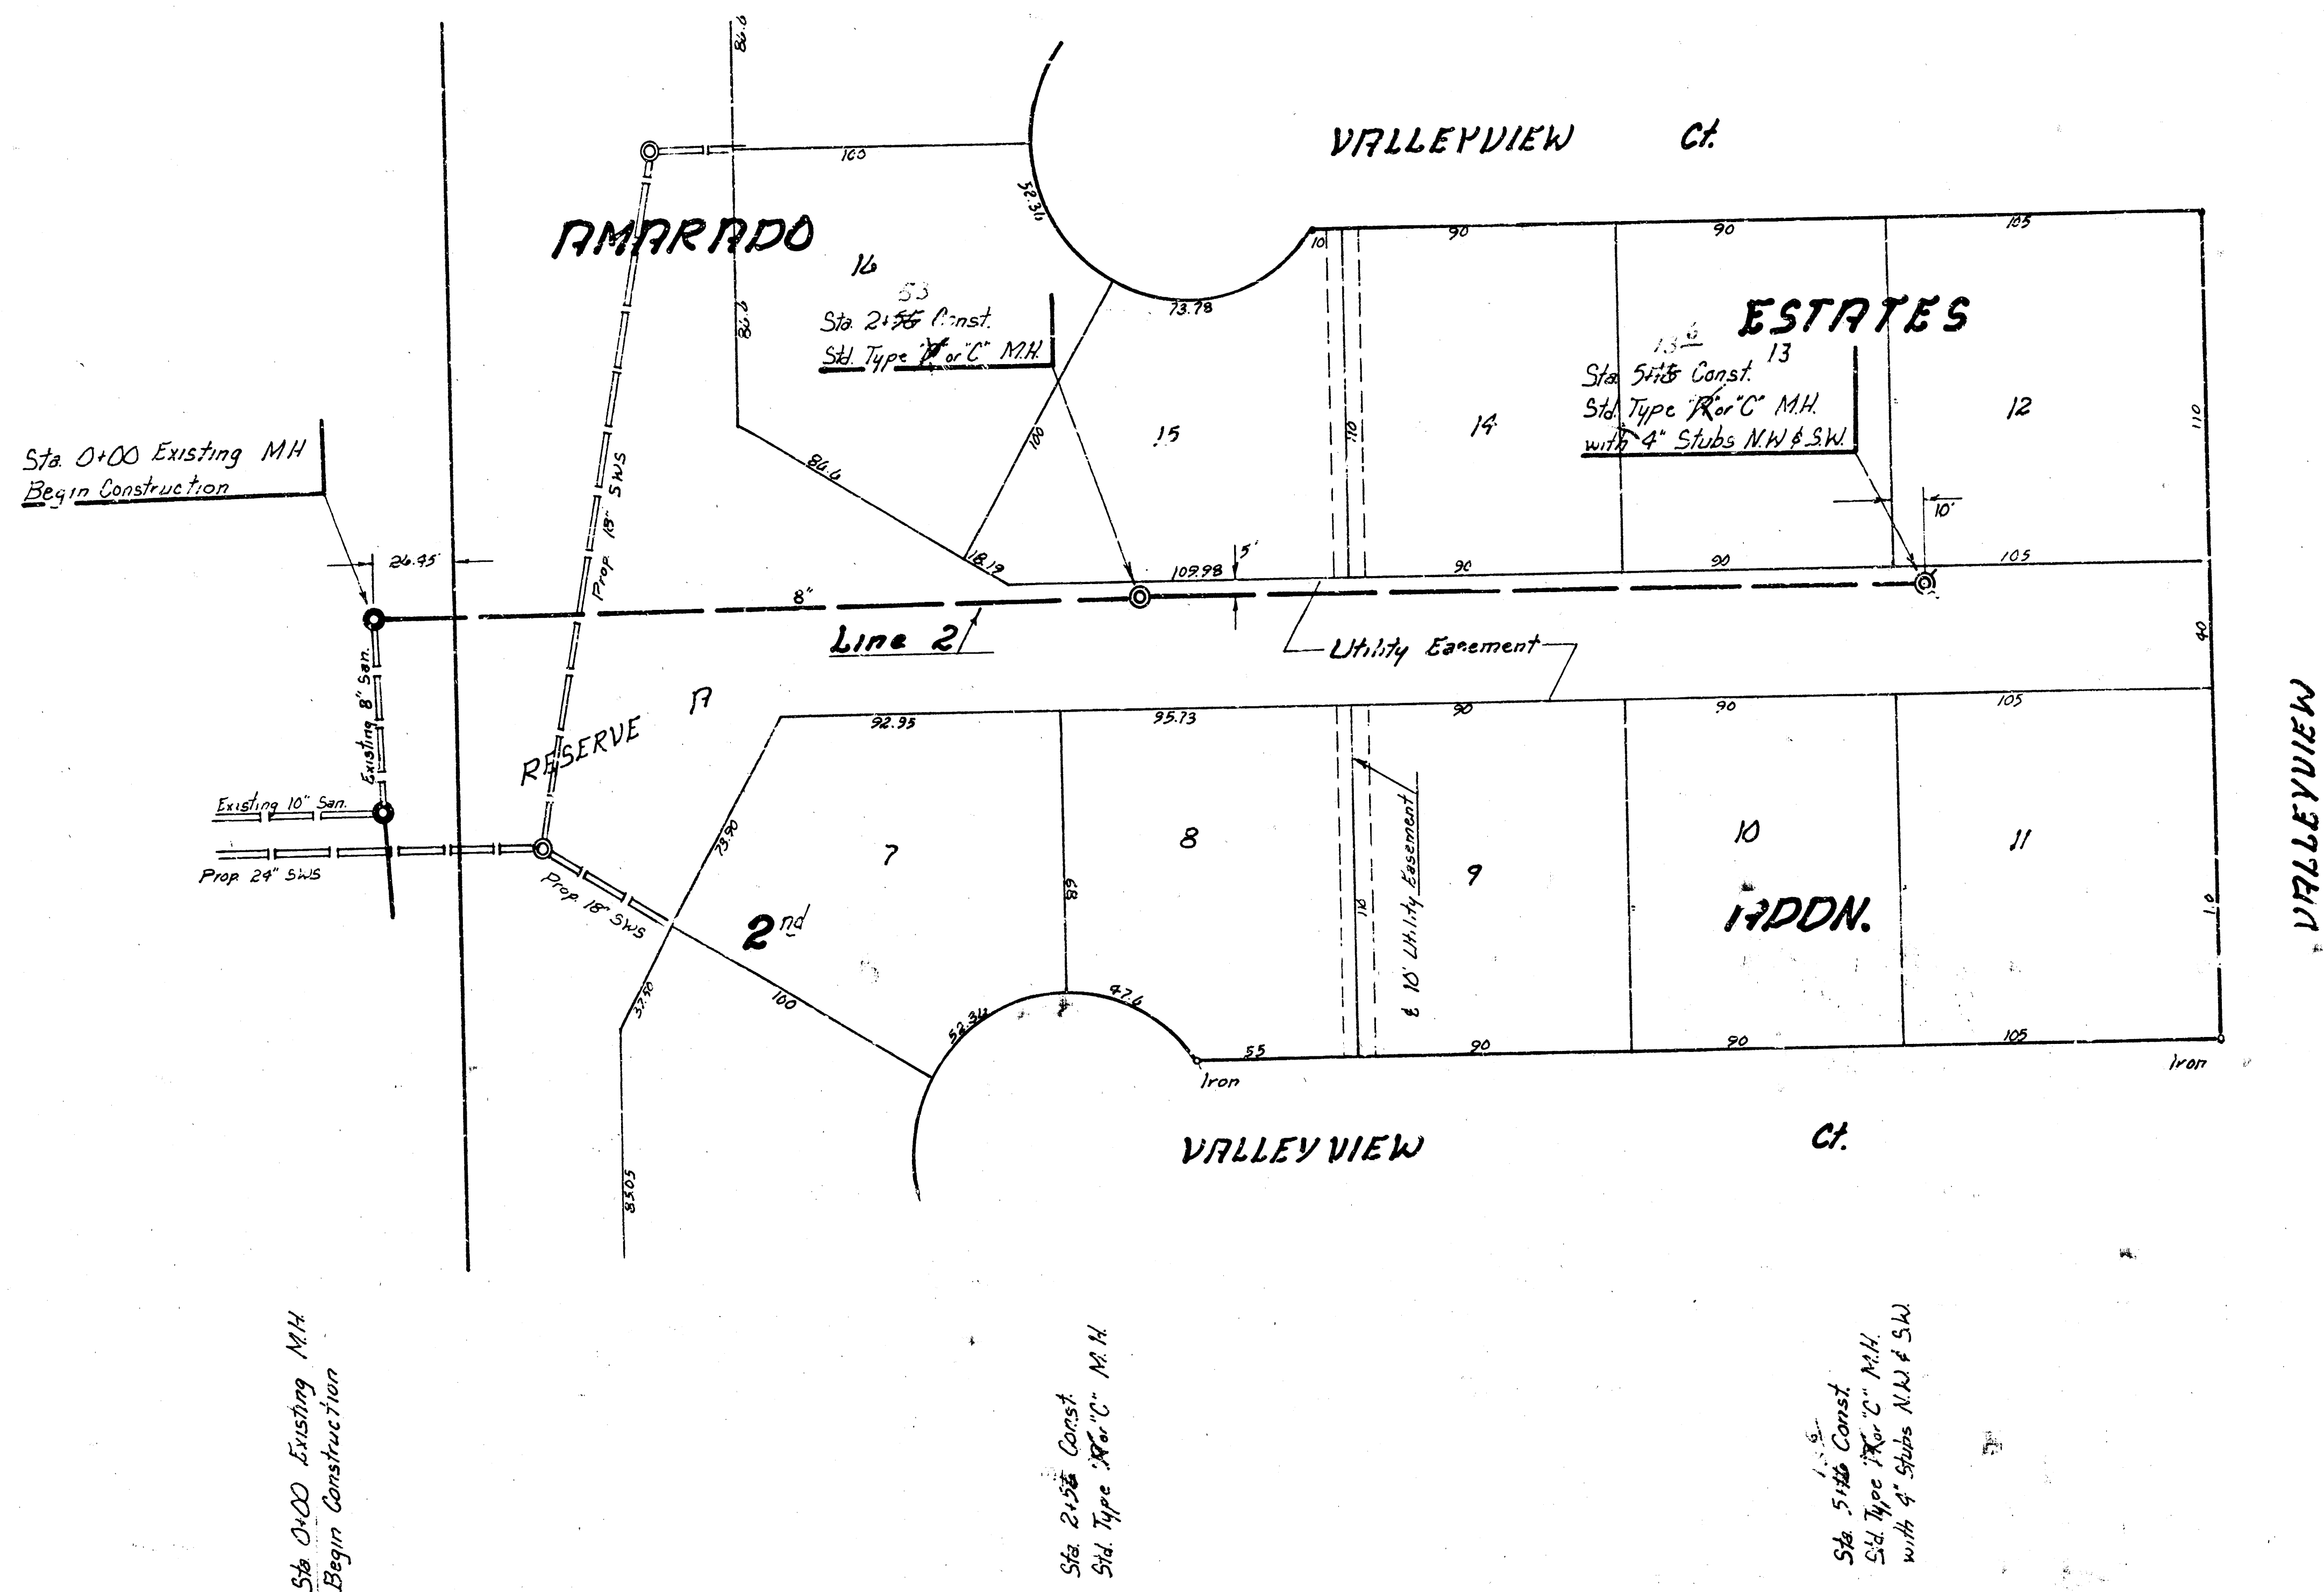


SCALE
 Plan 1" = 20'
 Profile 1" = 5'
 Area 1" = 20'

155
 150
 145
 140

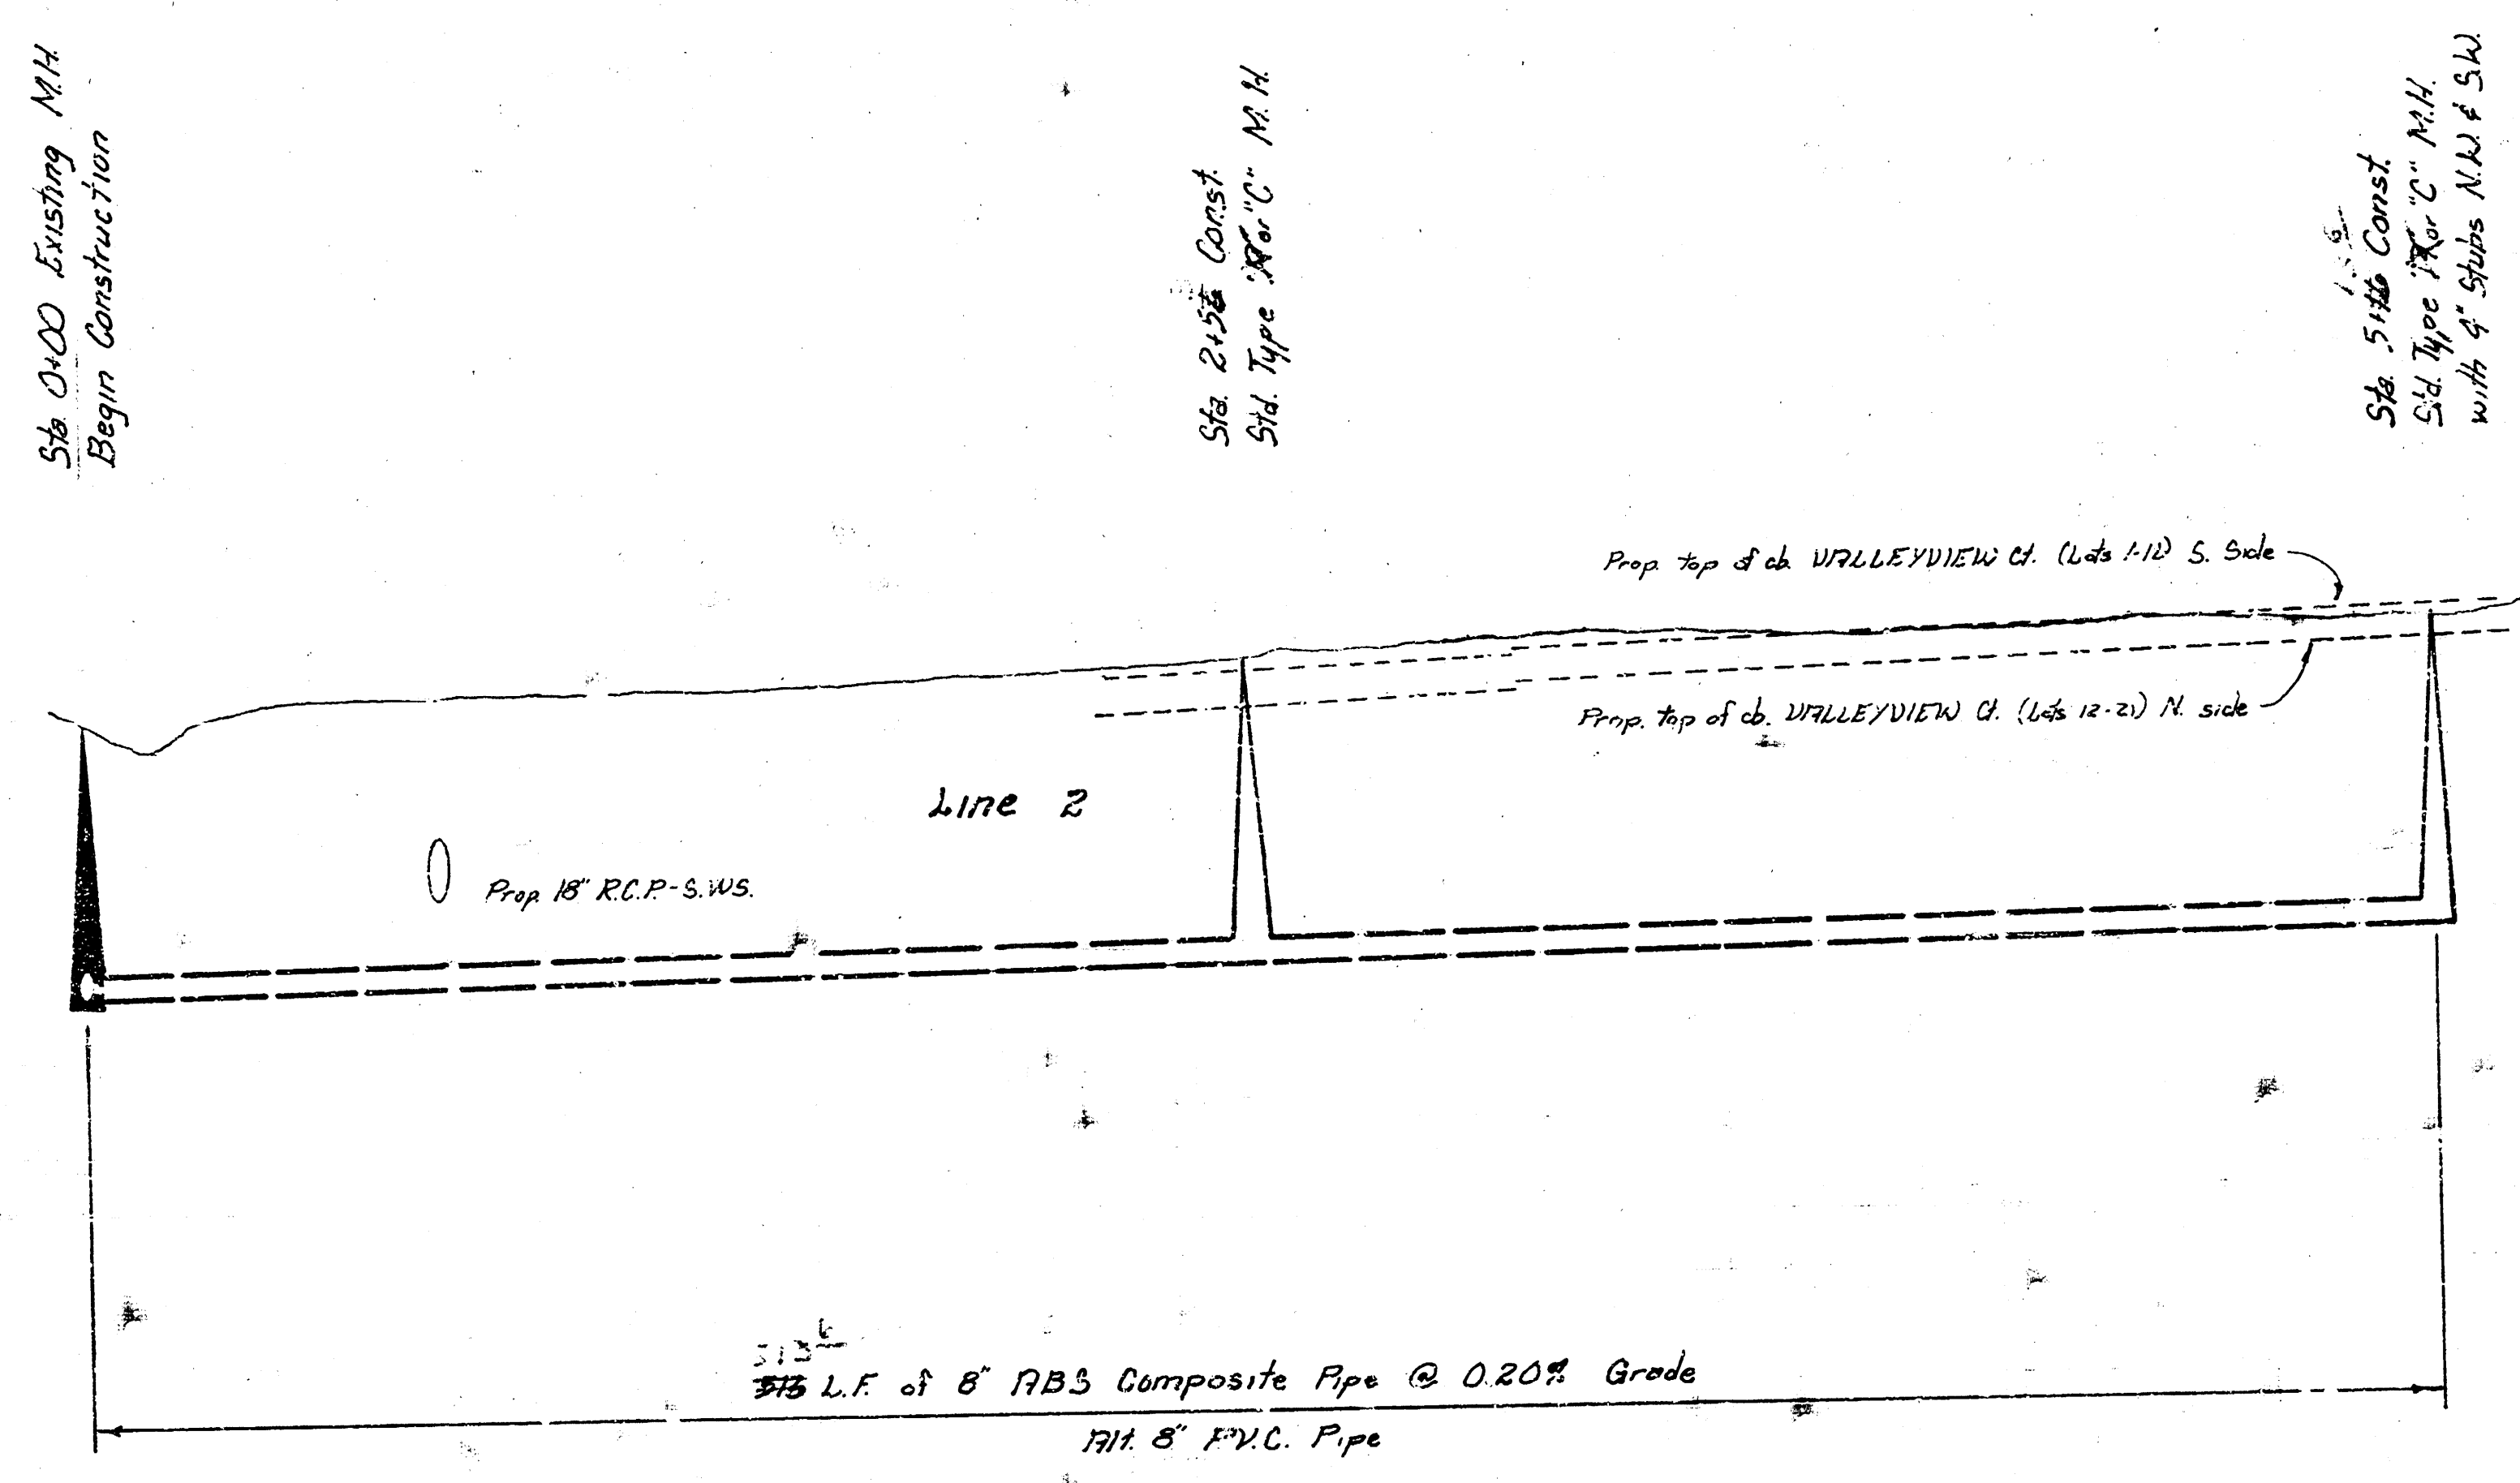


146.00 Ft Out
 146.10 Ft In
 146.30
 146.50
 146.61 Ft
 146.70
 146.90
 147.10
 147.13 Ft

NOTE: CONTRACTOR SHALL GIVE OWNERS OF LOTS 2 & 4 A MINIMUM ADVANCE NOTICE OF 48 HOURS BEFORE BEGINNING CONSTRUCTION ON LINE NO. 3. CONTRACTOR WILL BE REQUIRED TO RESTORE ANY IMPROVEMENTS OR VEGETATION DISTURBED ON THESE LOTS TO A CONDITION EQUAL TO OR BETTER THAN THE ORIGINAL CONDITION. THIS WORK WILL BE PAID FOR AT THE UNIT PRICE \$7.00 FOR SITE PREPARATION AND STORAGE.

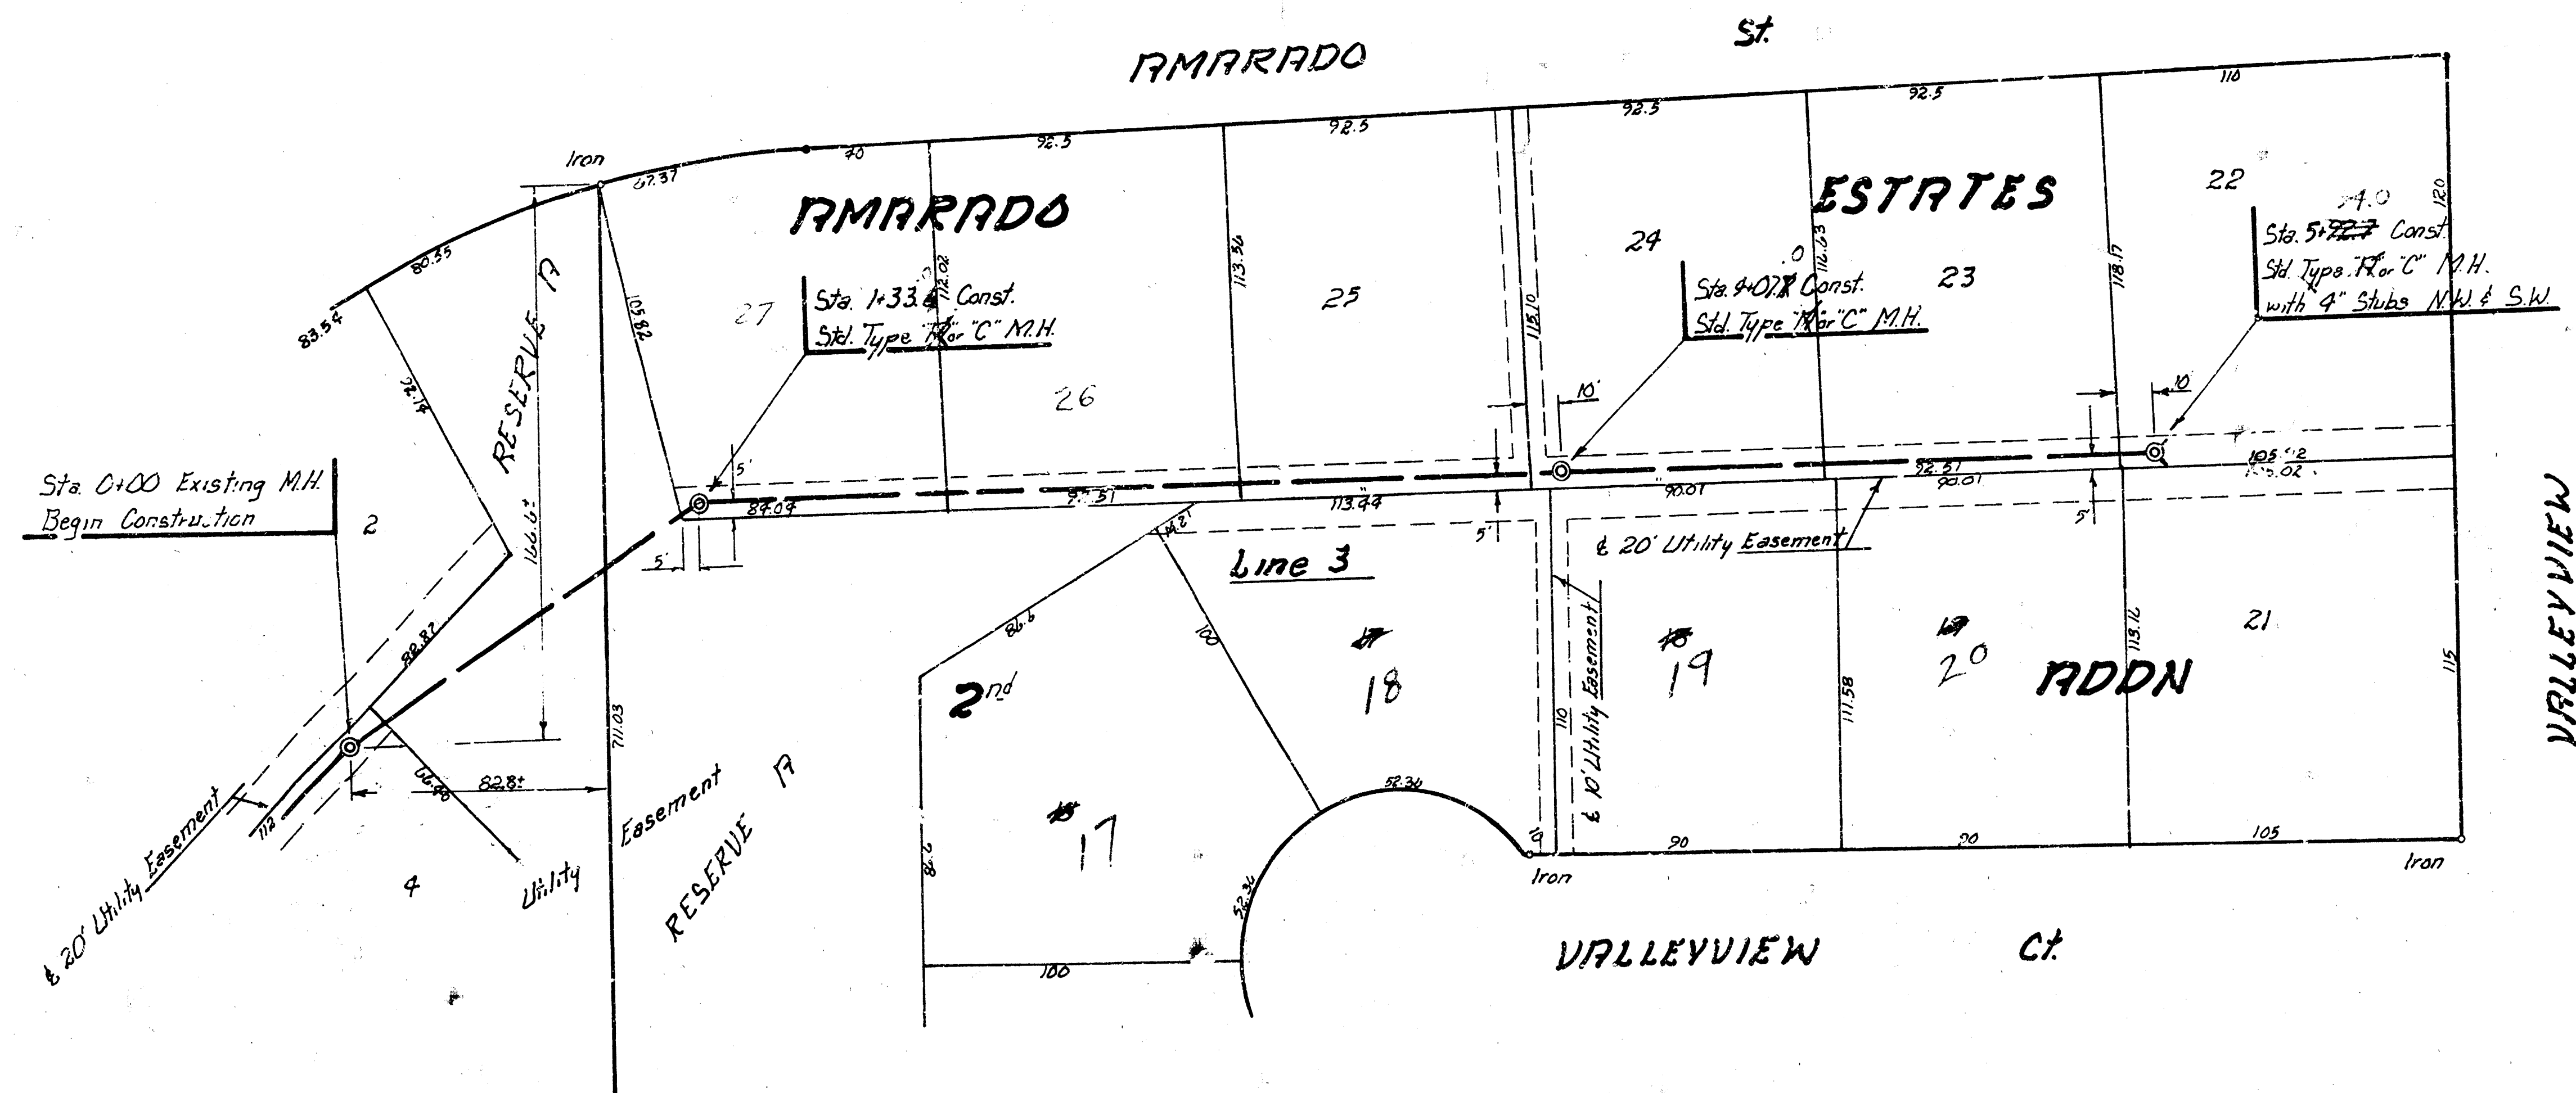

SCALE

Plan 1" = 20'
Profile 1" = 5'
Vert 1" = 5'
Horz 1" = 20'

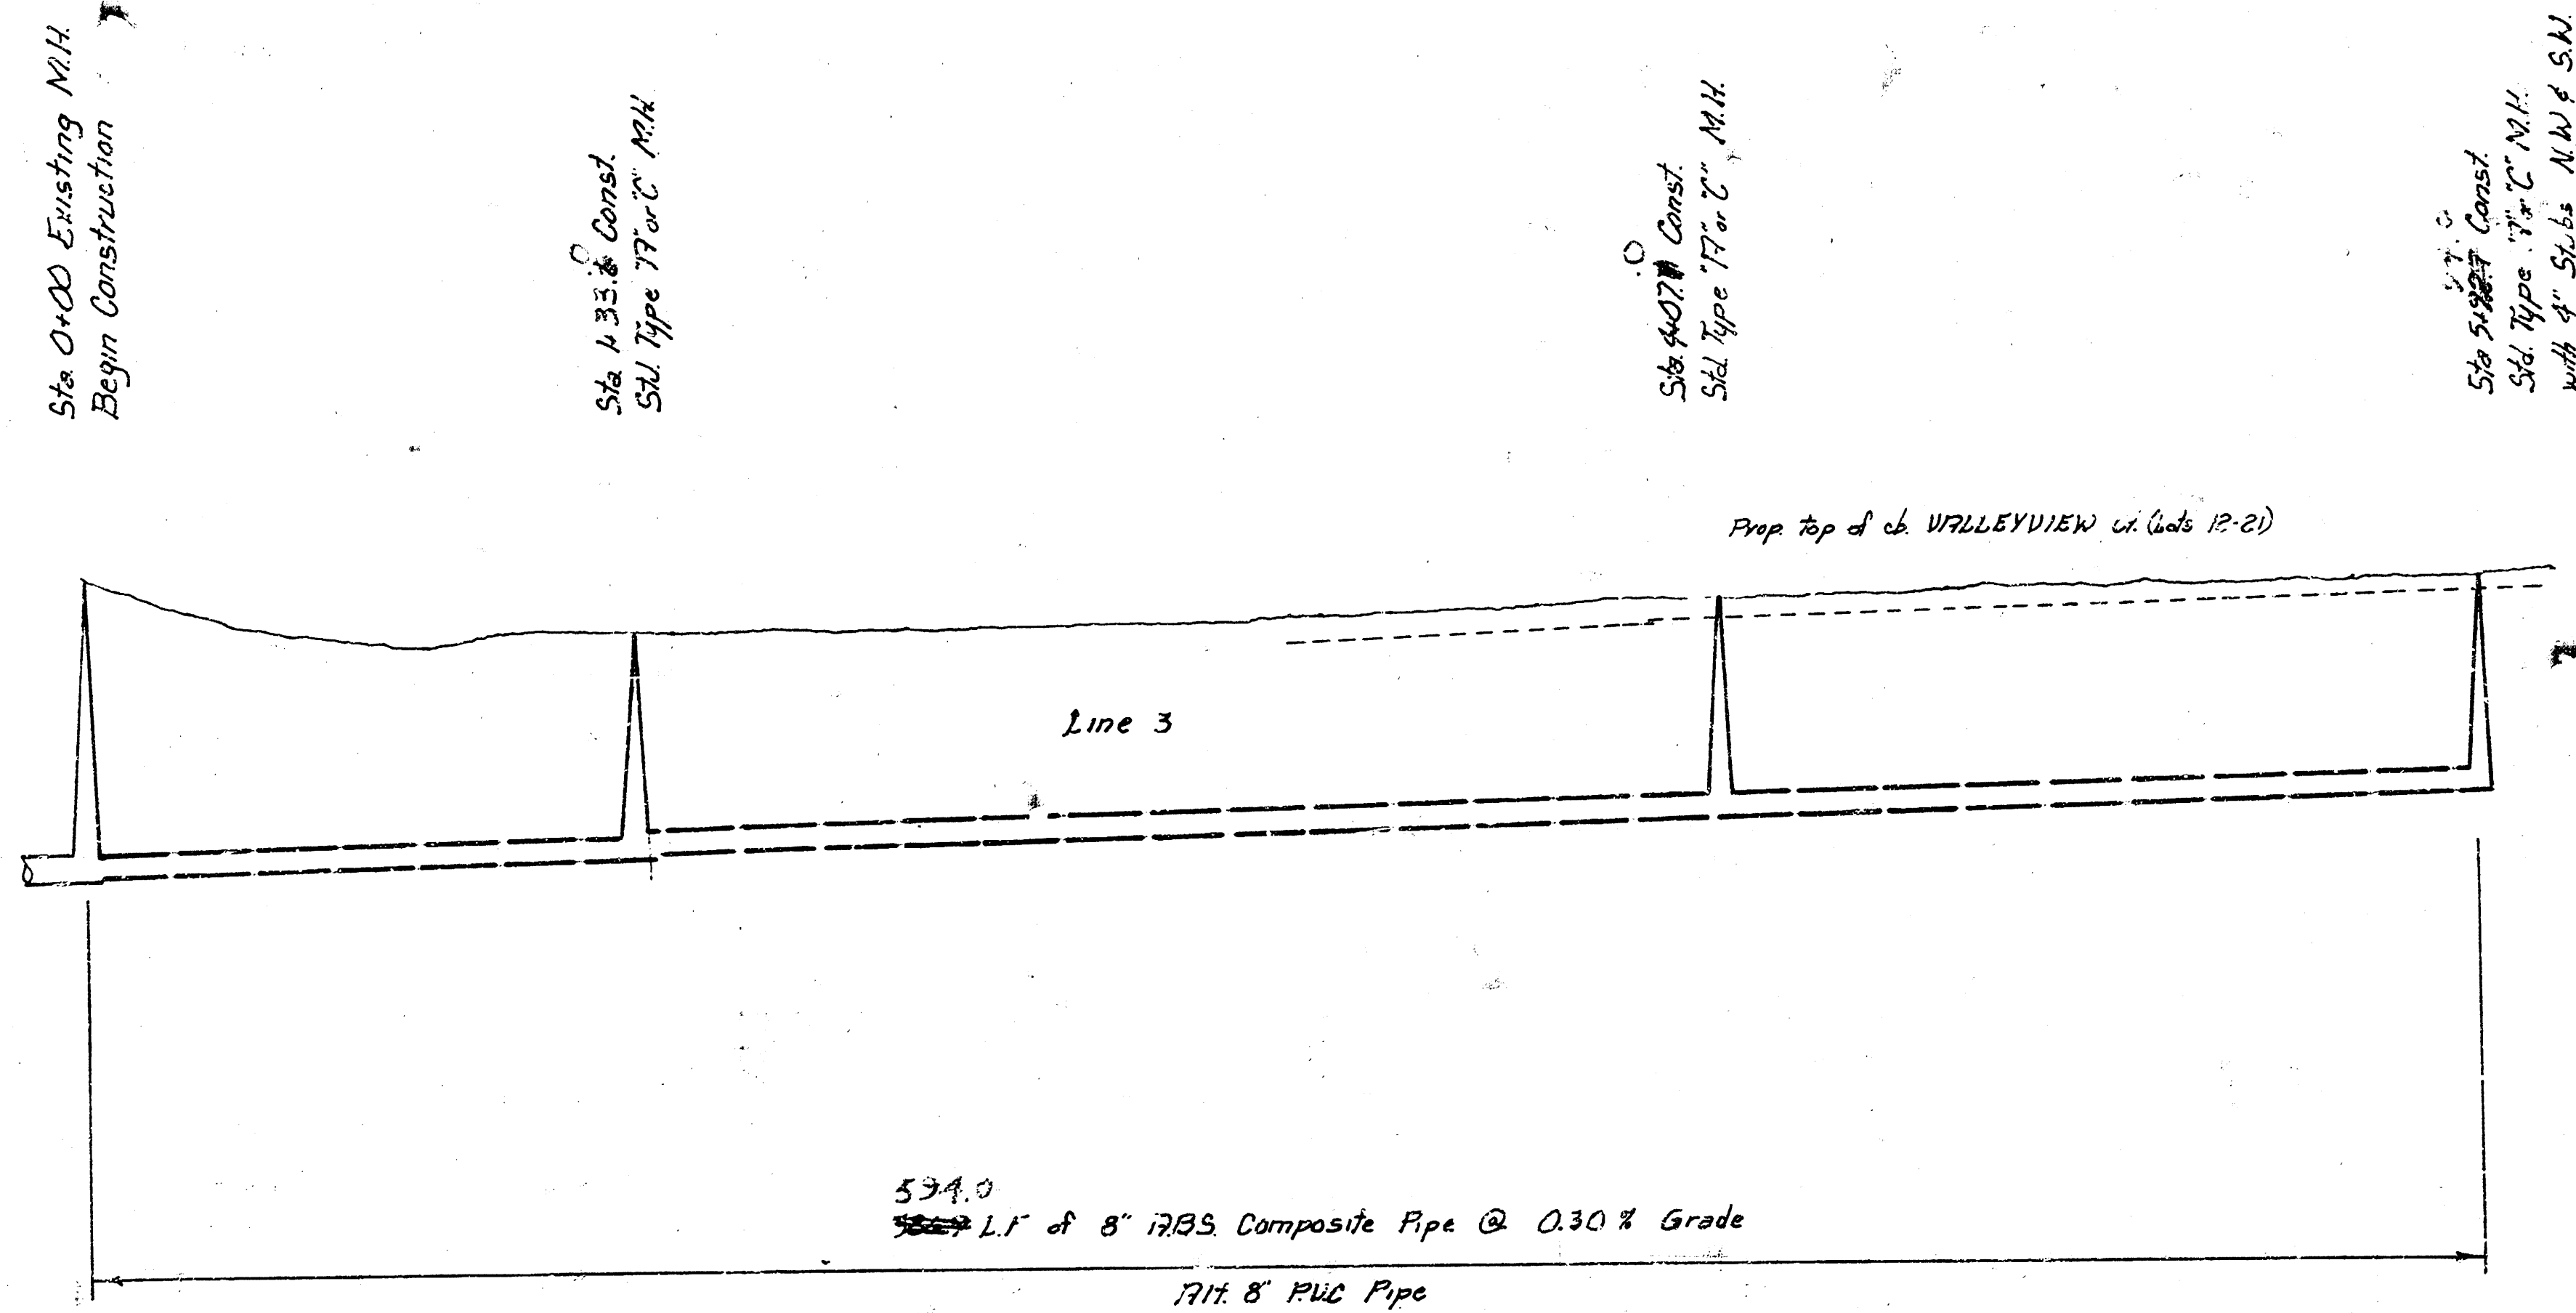

146.25 1% Out
146.65 1% In

146.95

147.05 1% Out
147.15 1% In

2

147.65

147.95

148.25

148.53