




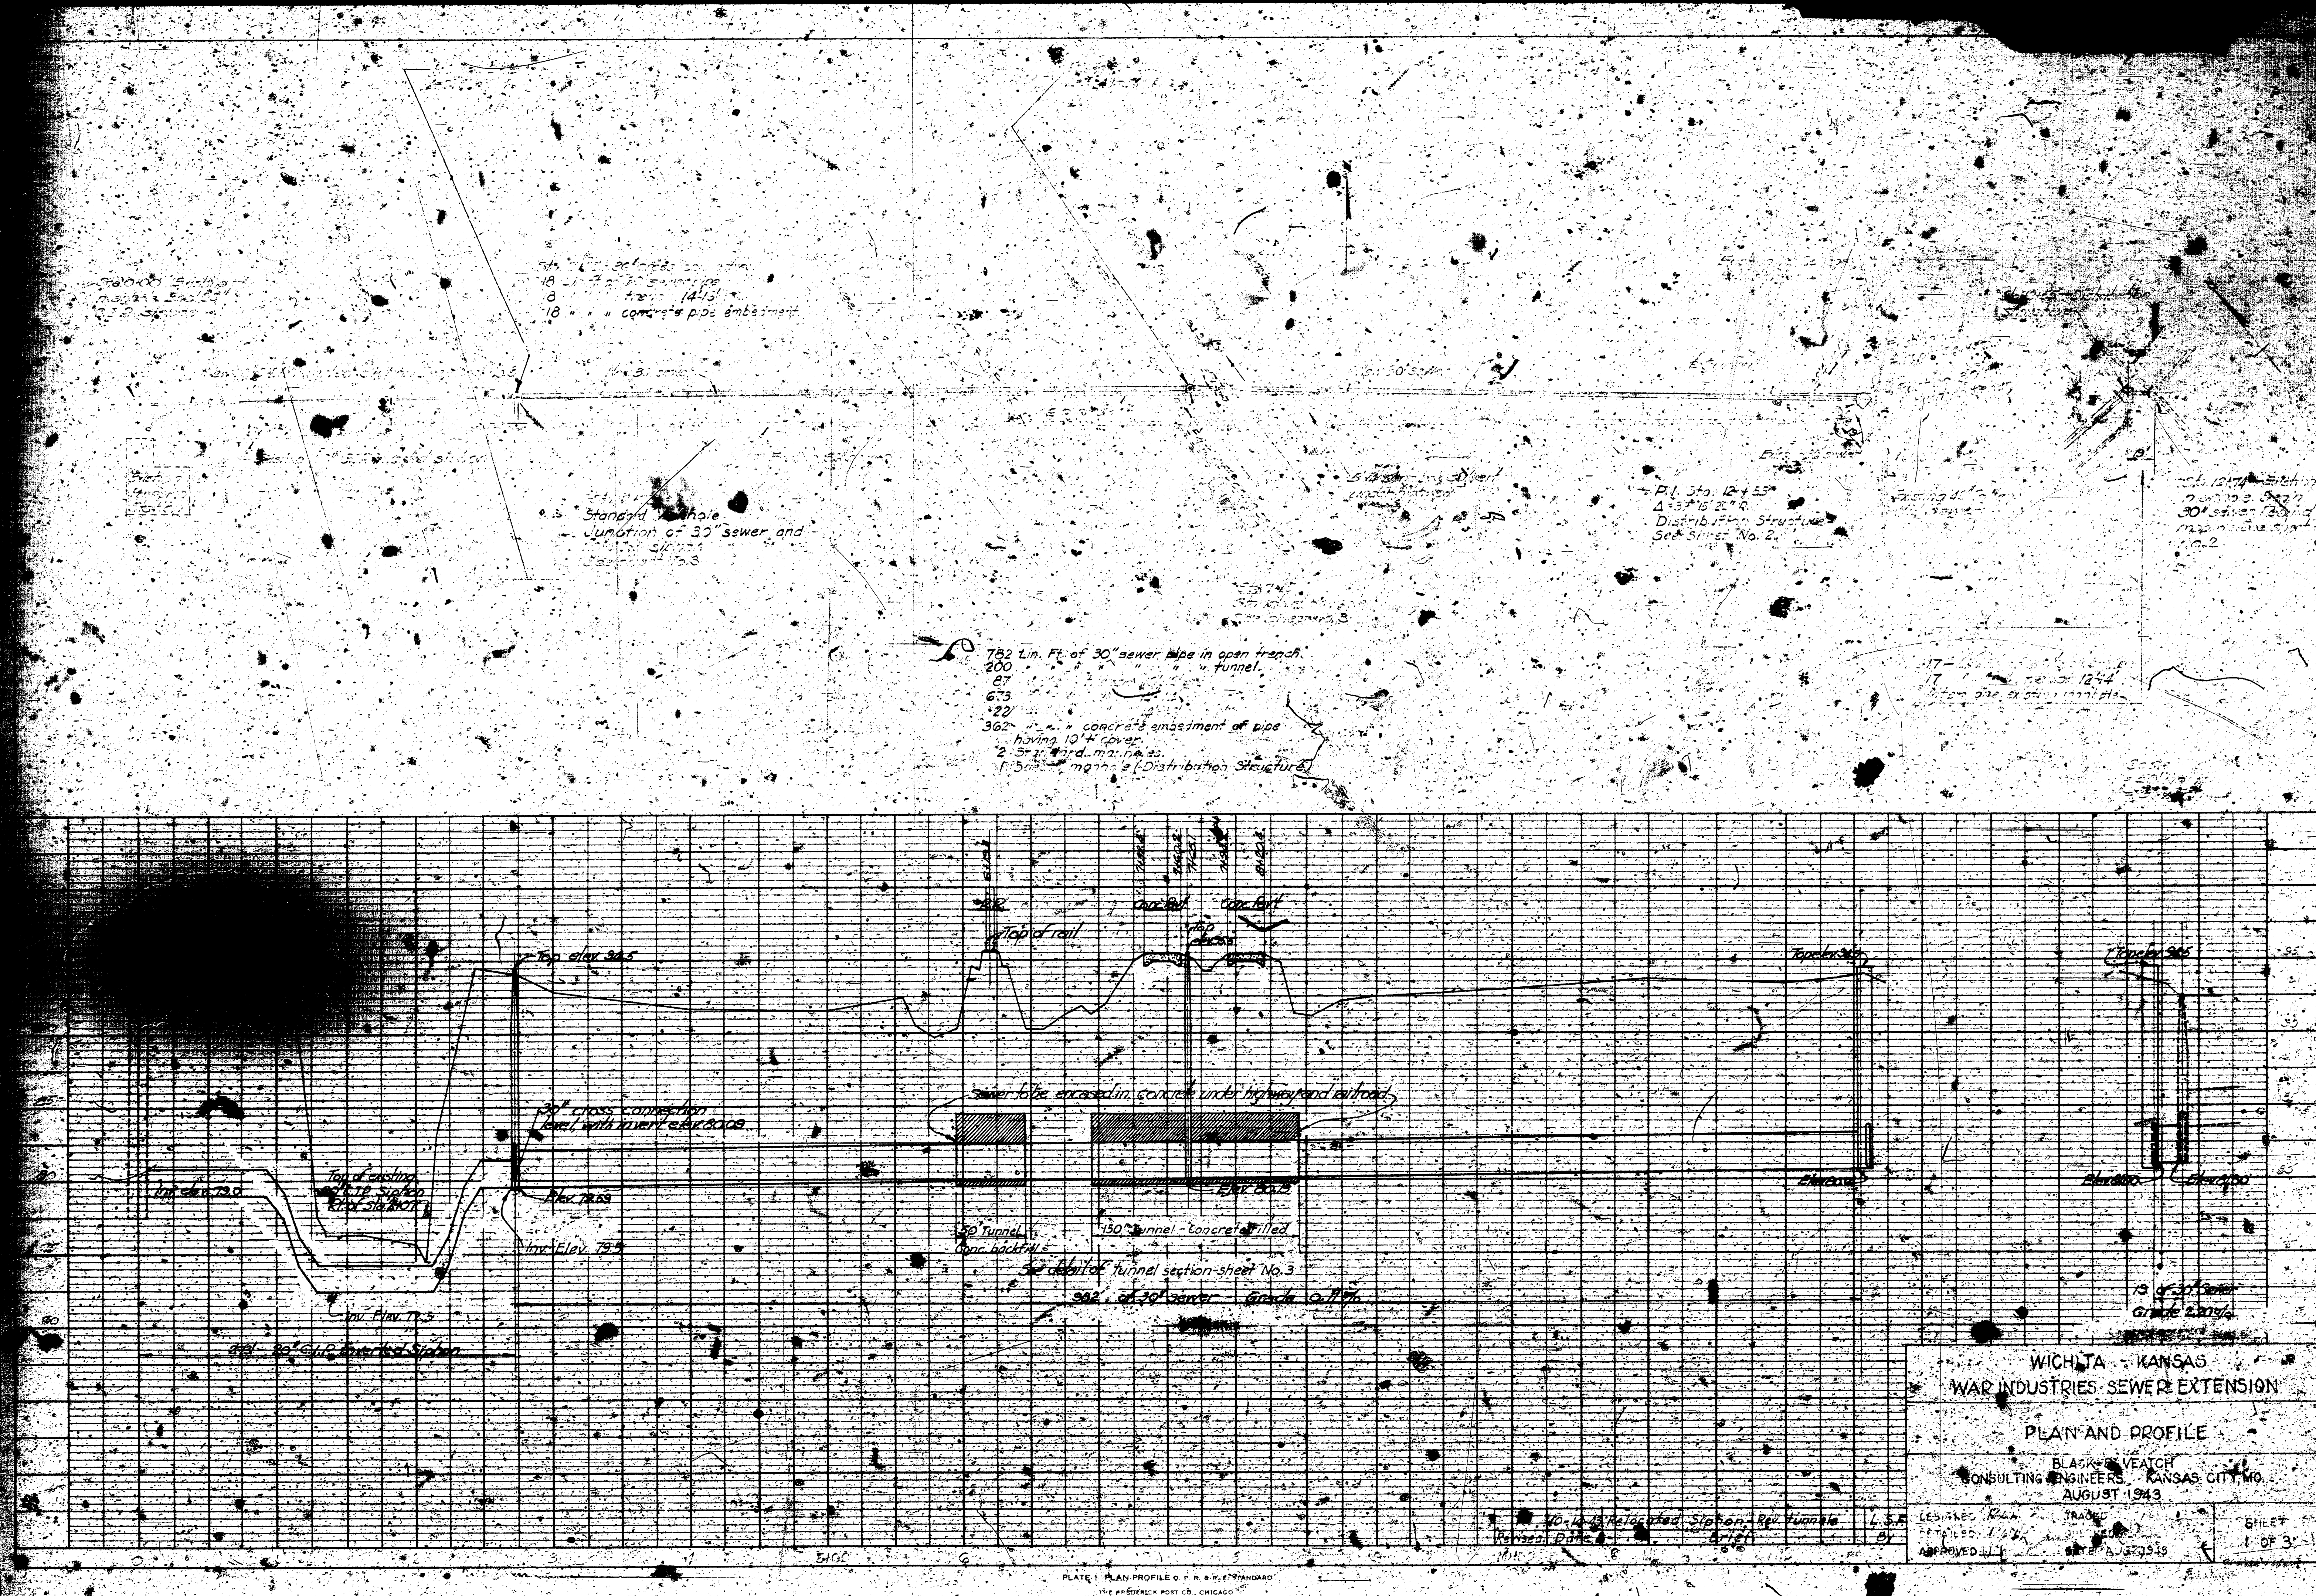

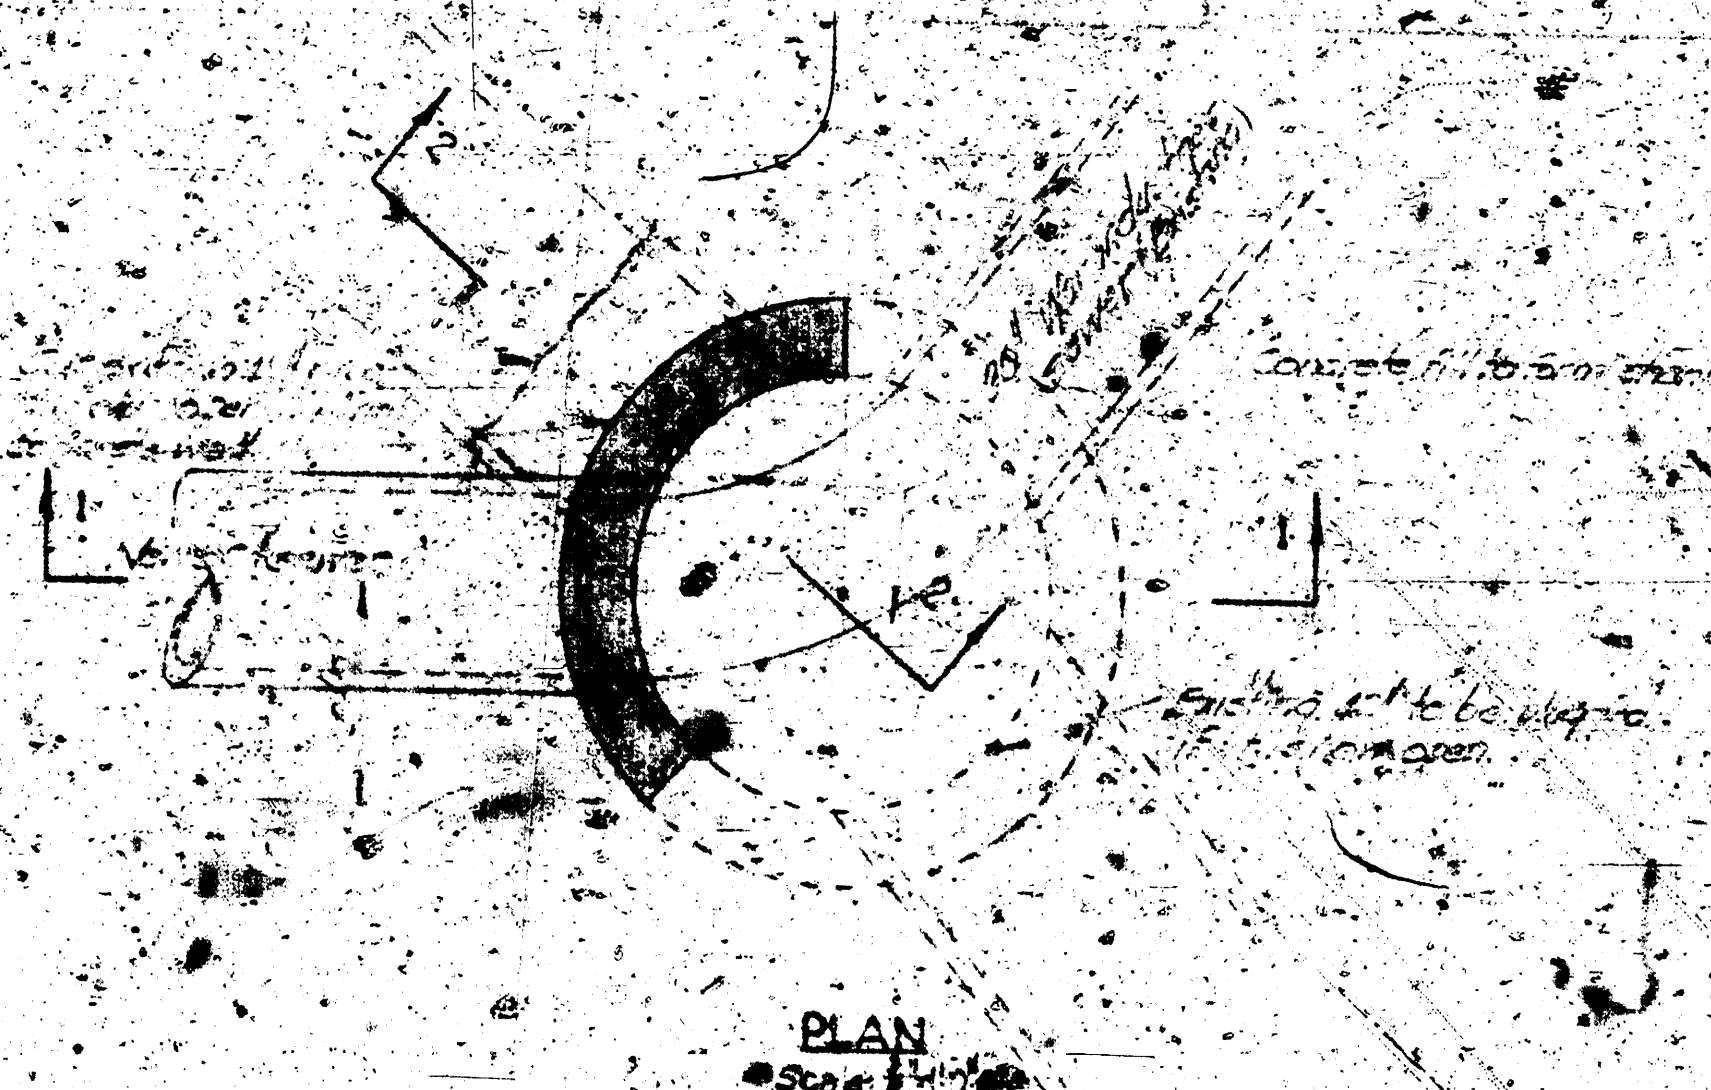


PLAN

 

SECTION: 6-8
Scale: 1" = 1'-0"

DETAILS OF 30" SEWER AT EXISTING MANHOLE - STA. 12 + 74

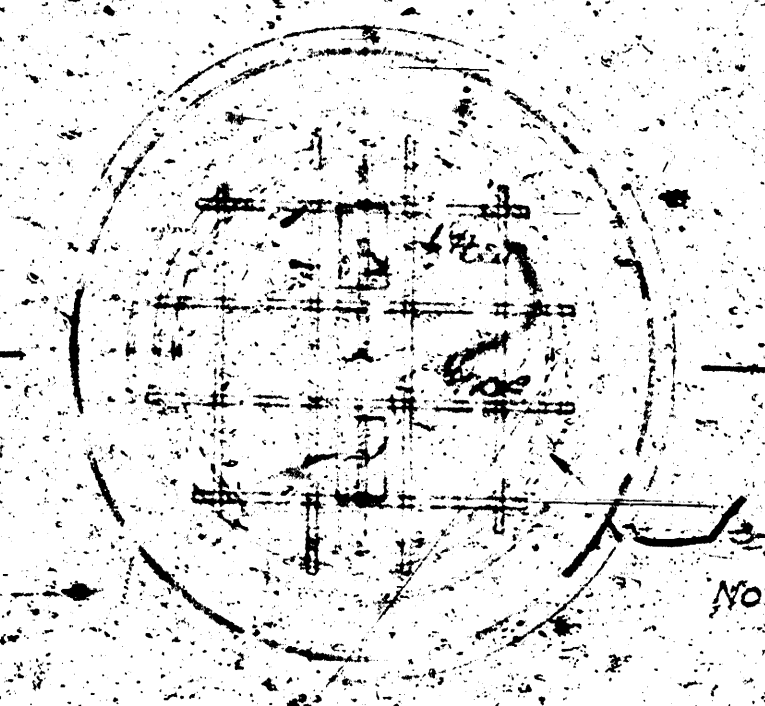


PLAN

Note: Factory built rings & covers,
A.C.S.I. Std. or equal, as per
specifications may be used in
lieu of design indicated.

SECTION
CONCRETE MANHOLE RING & COVER
Scale: 1"=1'-0"

10-14-49	Added M. Hunkle & Stationing	1	5
Revised	Date	By	
WICHITA KANSAS WAR INDUSTRIES SEWER EXTENSION DISTRIBUTION STRUCTURE AND MANHOLE DETAILS BLACK & VEATCH CONSULTING ENGINEERS KANSAS CITY, MO AUGUST 1943			
DESIGNED	TRACER	SHEET	
DETAILS	CHECKED	2 OF 3	
APPROVED	DATE AUGUST		

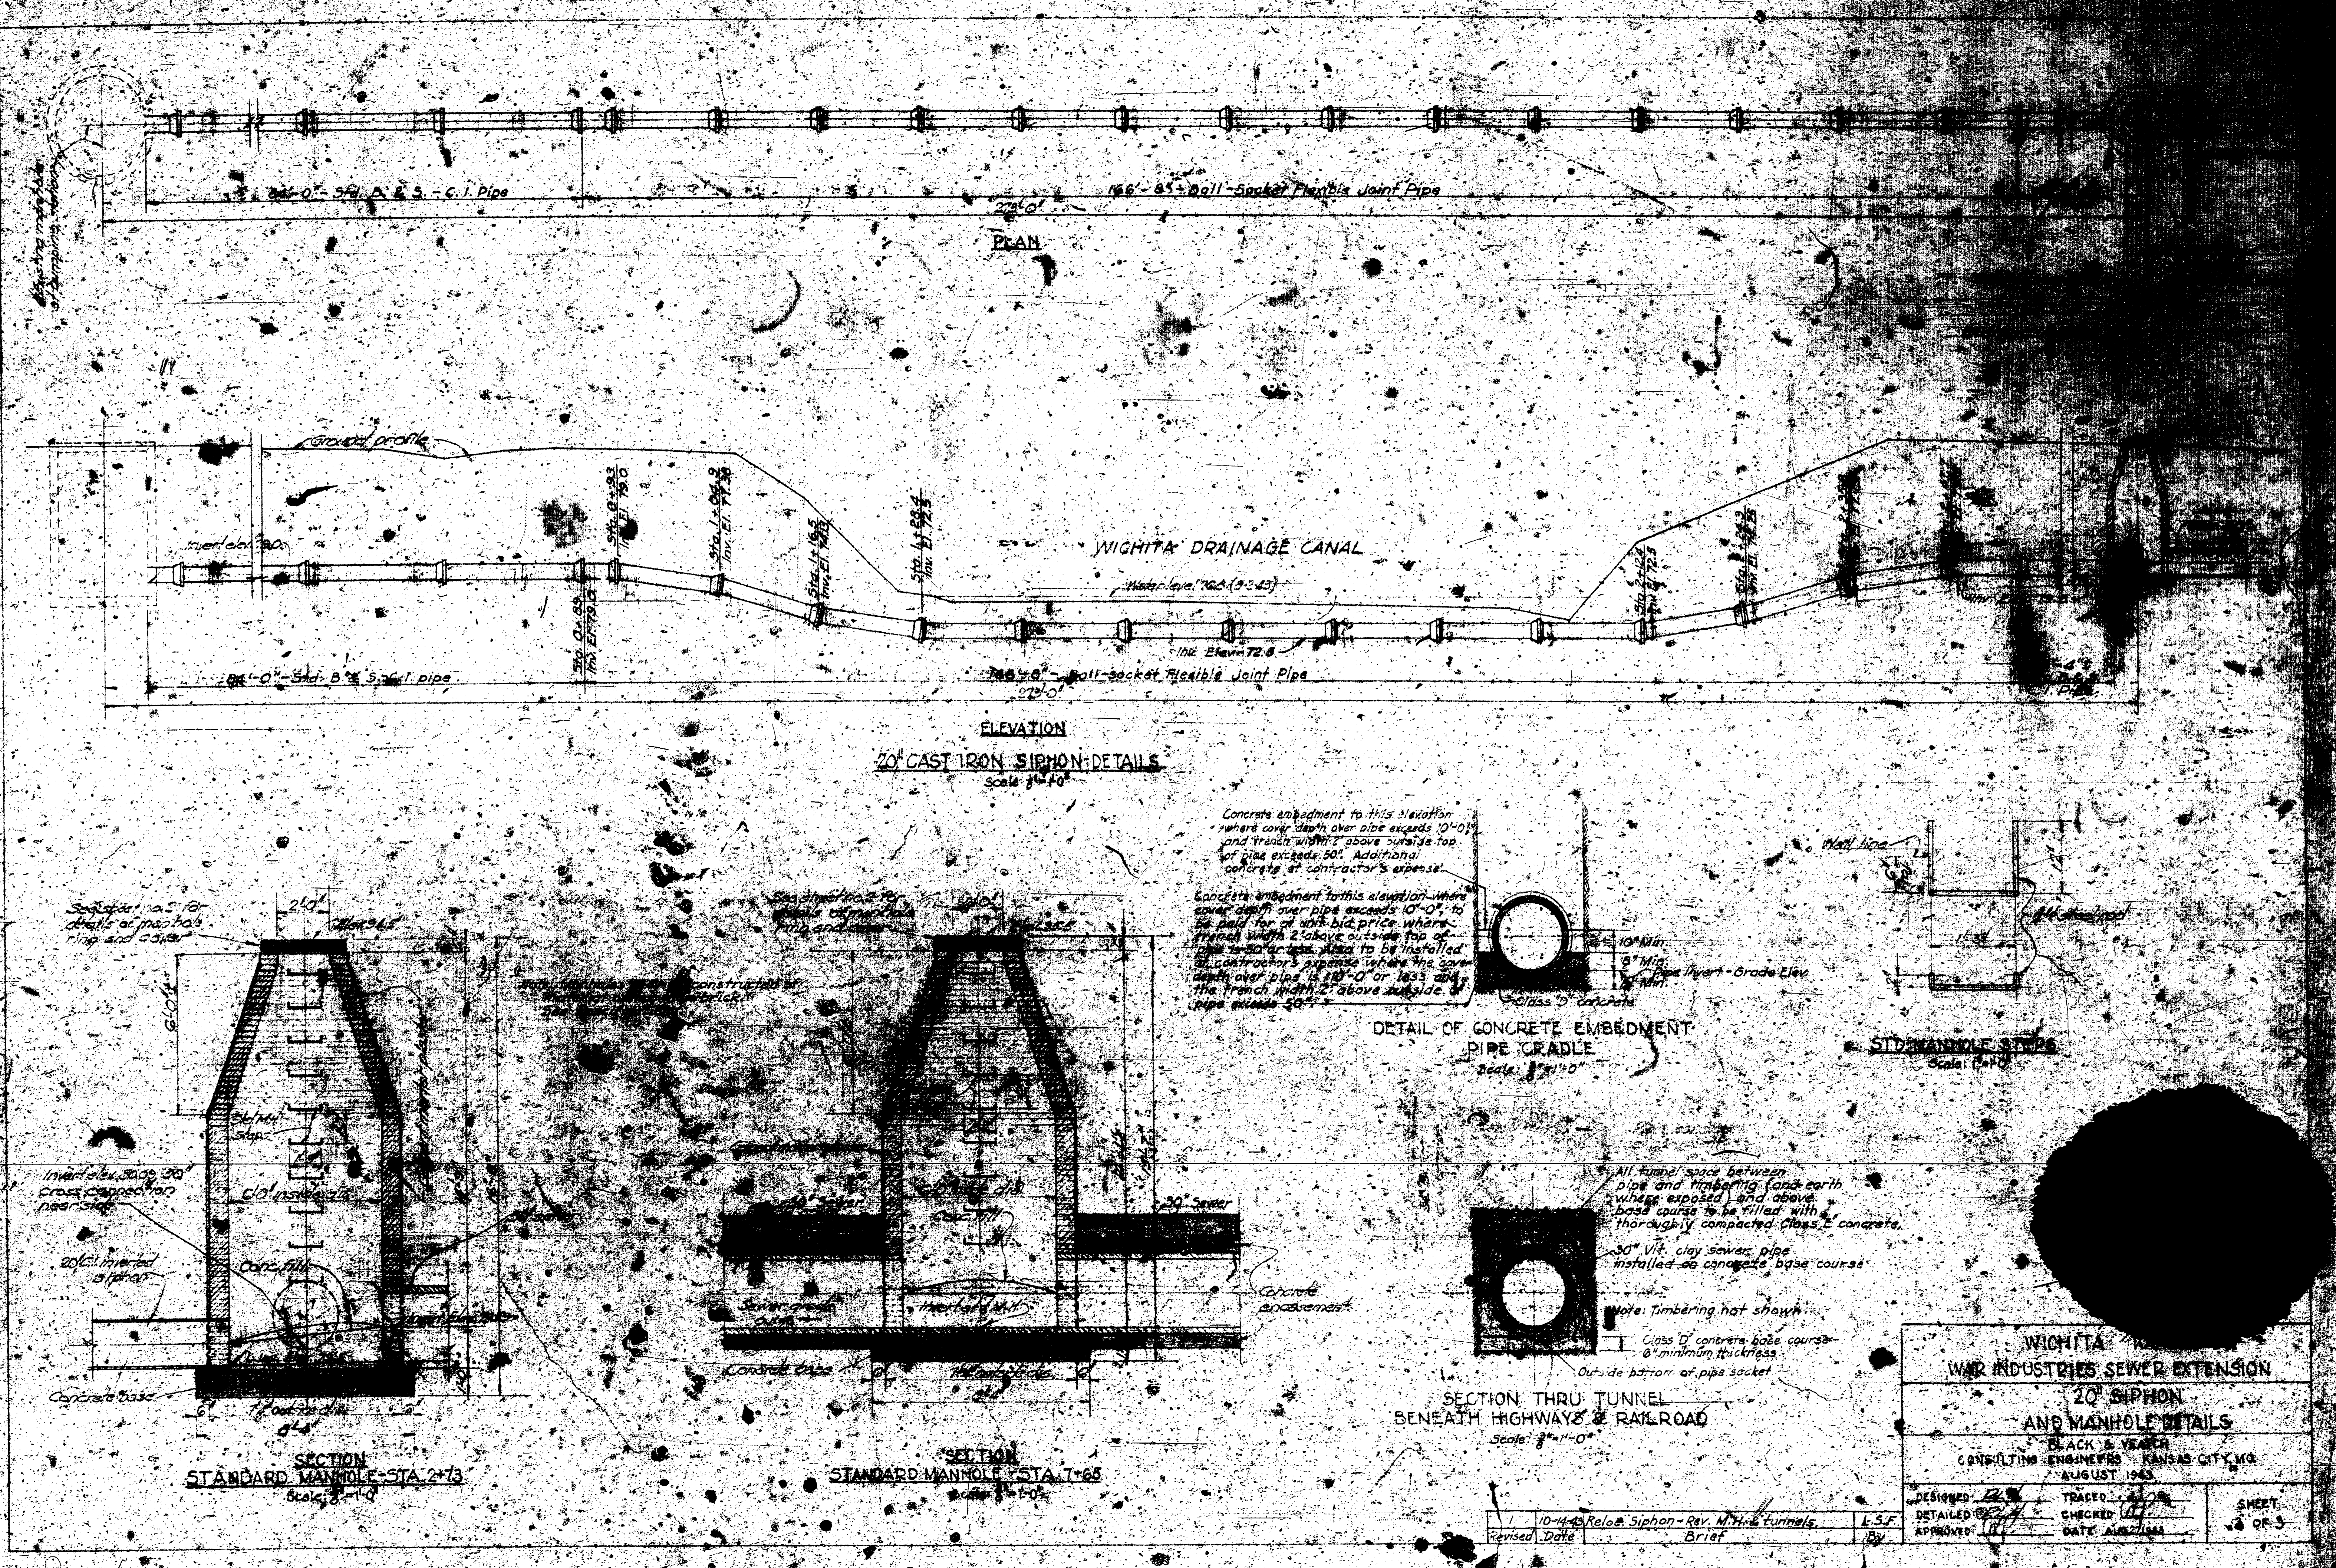

WICHITA WAR INDUSTRIES SEWER EXTENSION		
20" SIPHON AND MANHOLE DETAILS		
BLACK & VEATCH CONSULTING ENGINEERS KANSAS CITY, MO. AUGUST 1943		
DESIGNED BY [Signature]	TRACED BY [Signature]	SHEET 48 OF 5
DETAILED BY [Signature]	CHECKED BY [Signature]	
APPROVED BY [Signature]	DATE AUGUST 1943	

10-44-Reloc. Siphon - Rev. N. H. H. Tunnels. L.S.F.
Revised Date Brief